
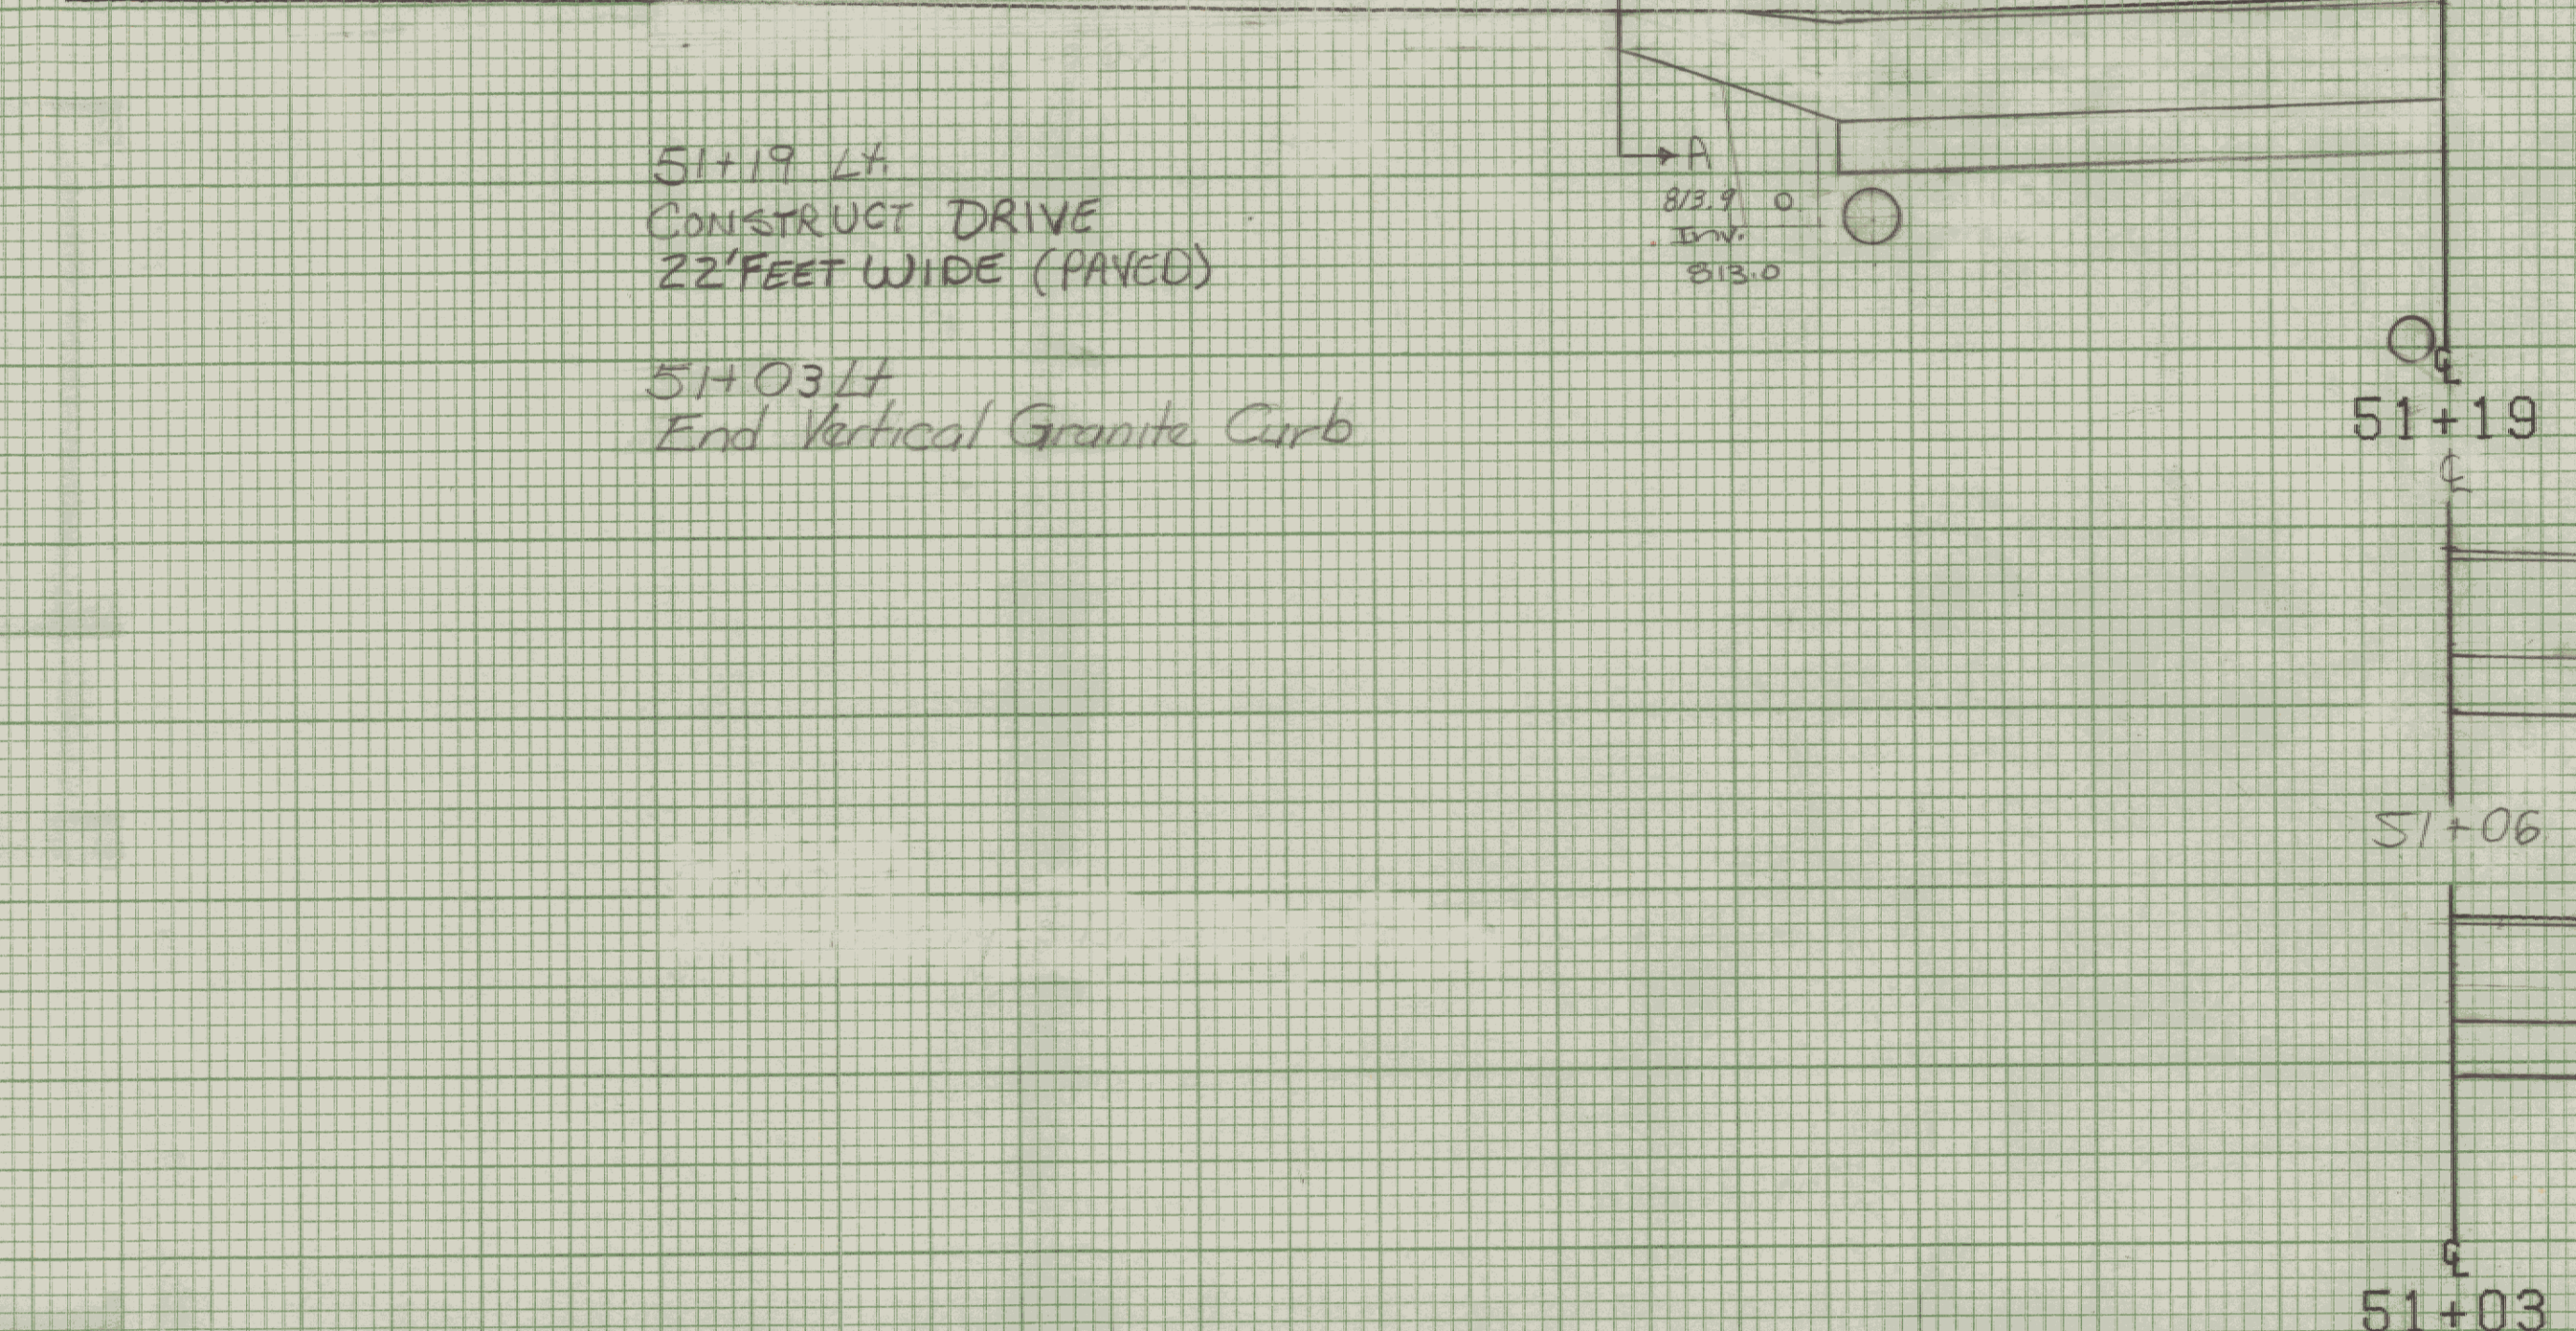


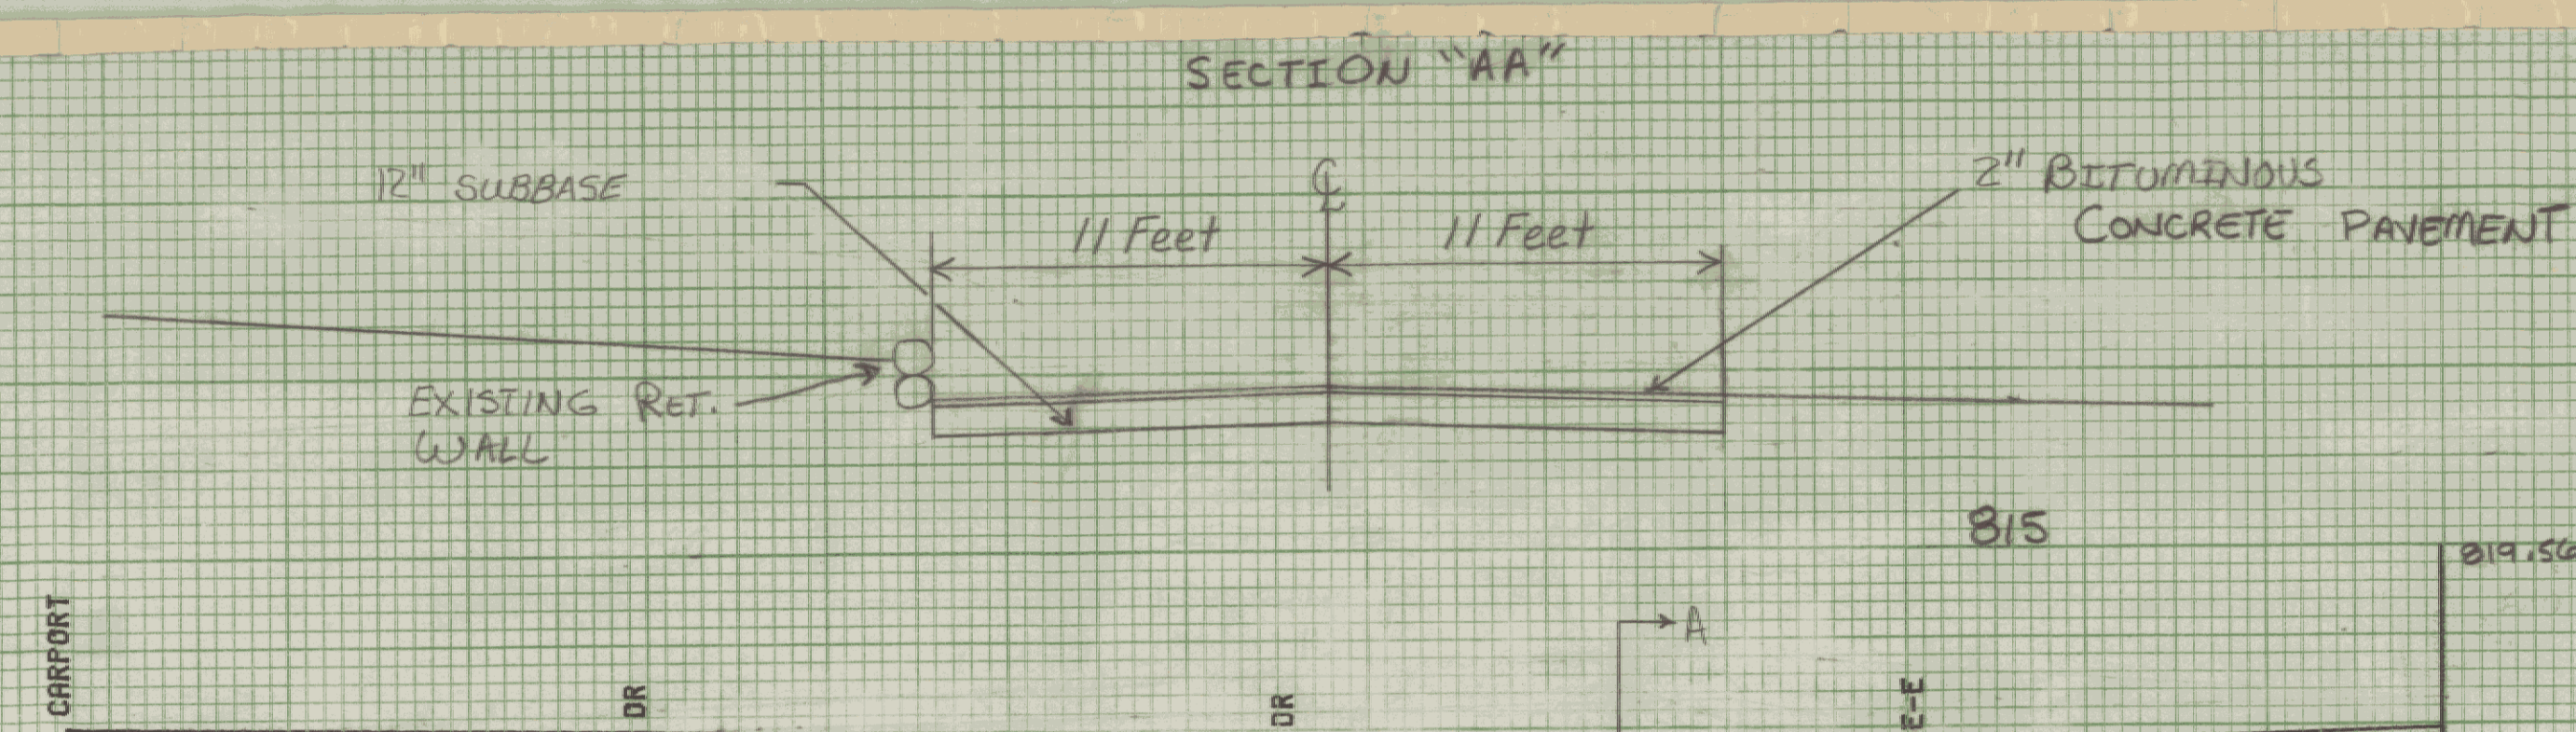

51+19 Lt  
CONSTRUCT DRIVE  
22 FEET WIDE (PAVED)


51+03 Lt  
End Vertical Granite Curb

815

51+16 Rt  
Relocate Mailbox, Multiple Support (1)

815

815

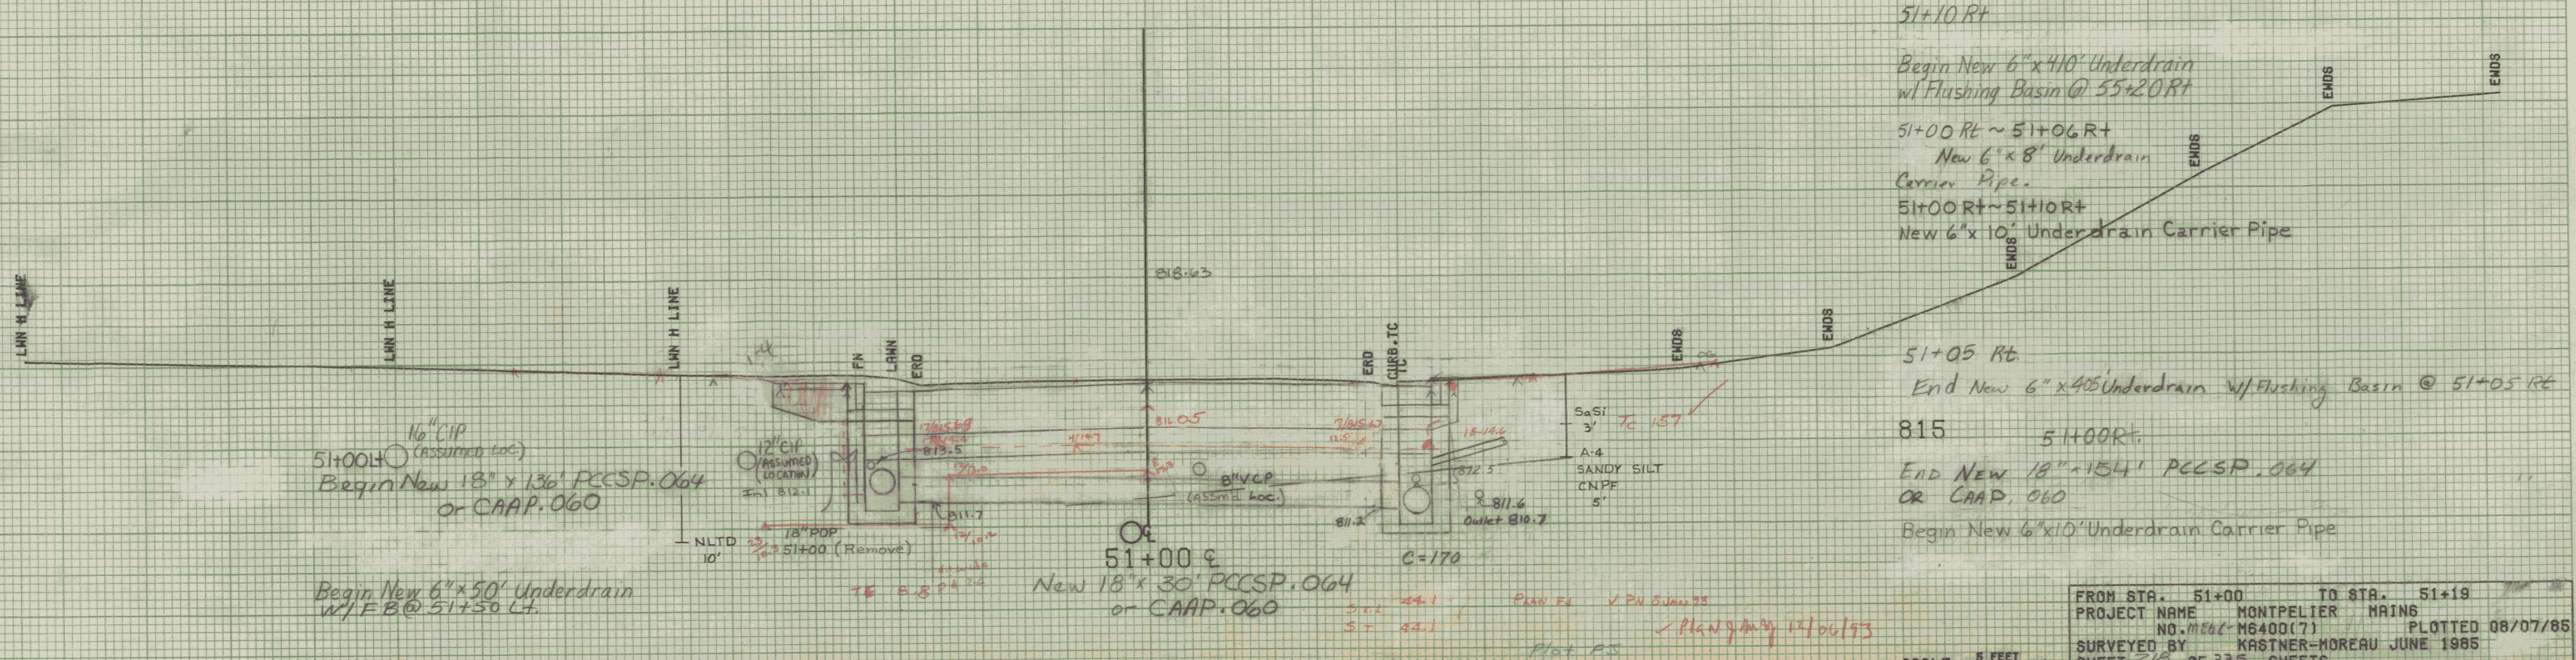

51+00 Lt  
Begin New 18" x 136' PCCSP.064  
or CAAP.060

Begin New 6" x 50' Underdrain  
w/ F.B. @ 51+50 Lt.

51+00 Lt  
New 18" x 30' PCCSP.064  
or CAAP.060

51+10 Rt

Begin New 6" x 410' Underdrain  
w/ Flushing Basin @ 51+20 Rt

51+00 Rt ~ 51+06 Rt  
New 6" x 8' Underdrain  
Carrier Pipe.  
51+00 Rt ~ 51+10 Rt  
New 6" x 10' Underdrain Carrier Pipe

51+05 Rt

End New 6" x 405' Underdrain w/ Flushing Basin @ 51+05 Rt

815

51+00 Rt  
End New 18" x 154' PCCSP.064  
or CAAP.060  
Begin New 6" x 10' Underdrain Carrier Pipe

|              |                |           |          |
|--------------|----------------|-----------|----------|
| FROM STA.    | 51+00          | TO STA.   | 51+19    |
| PROJECT NAME | MONTPELIER     | MAINS     |          |
| NO.          | M6400(7)       | PLOTTED   | 06/07/85 |
| SURVEYED BY  | KRSTNER-MOREAU | JUNE 1985 |          |
| SHEET        | 215            | OF 335    | SHEETS   |

SCALE 5 FEET