


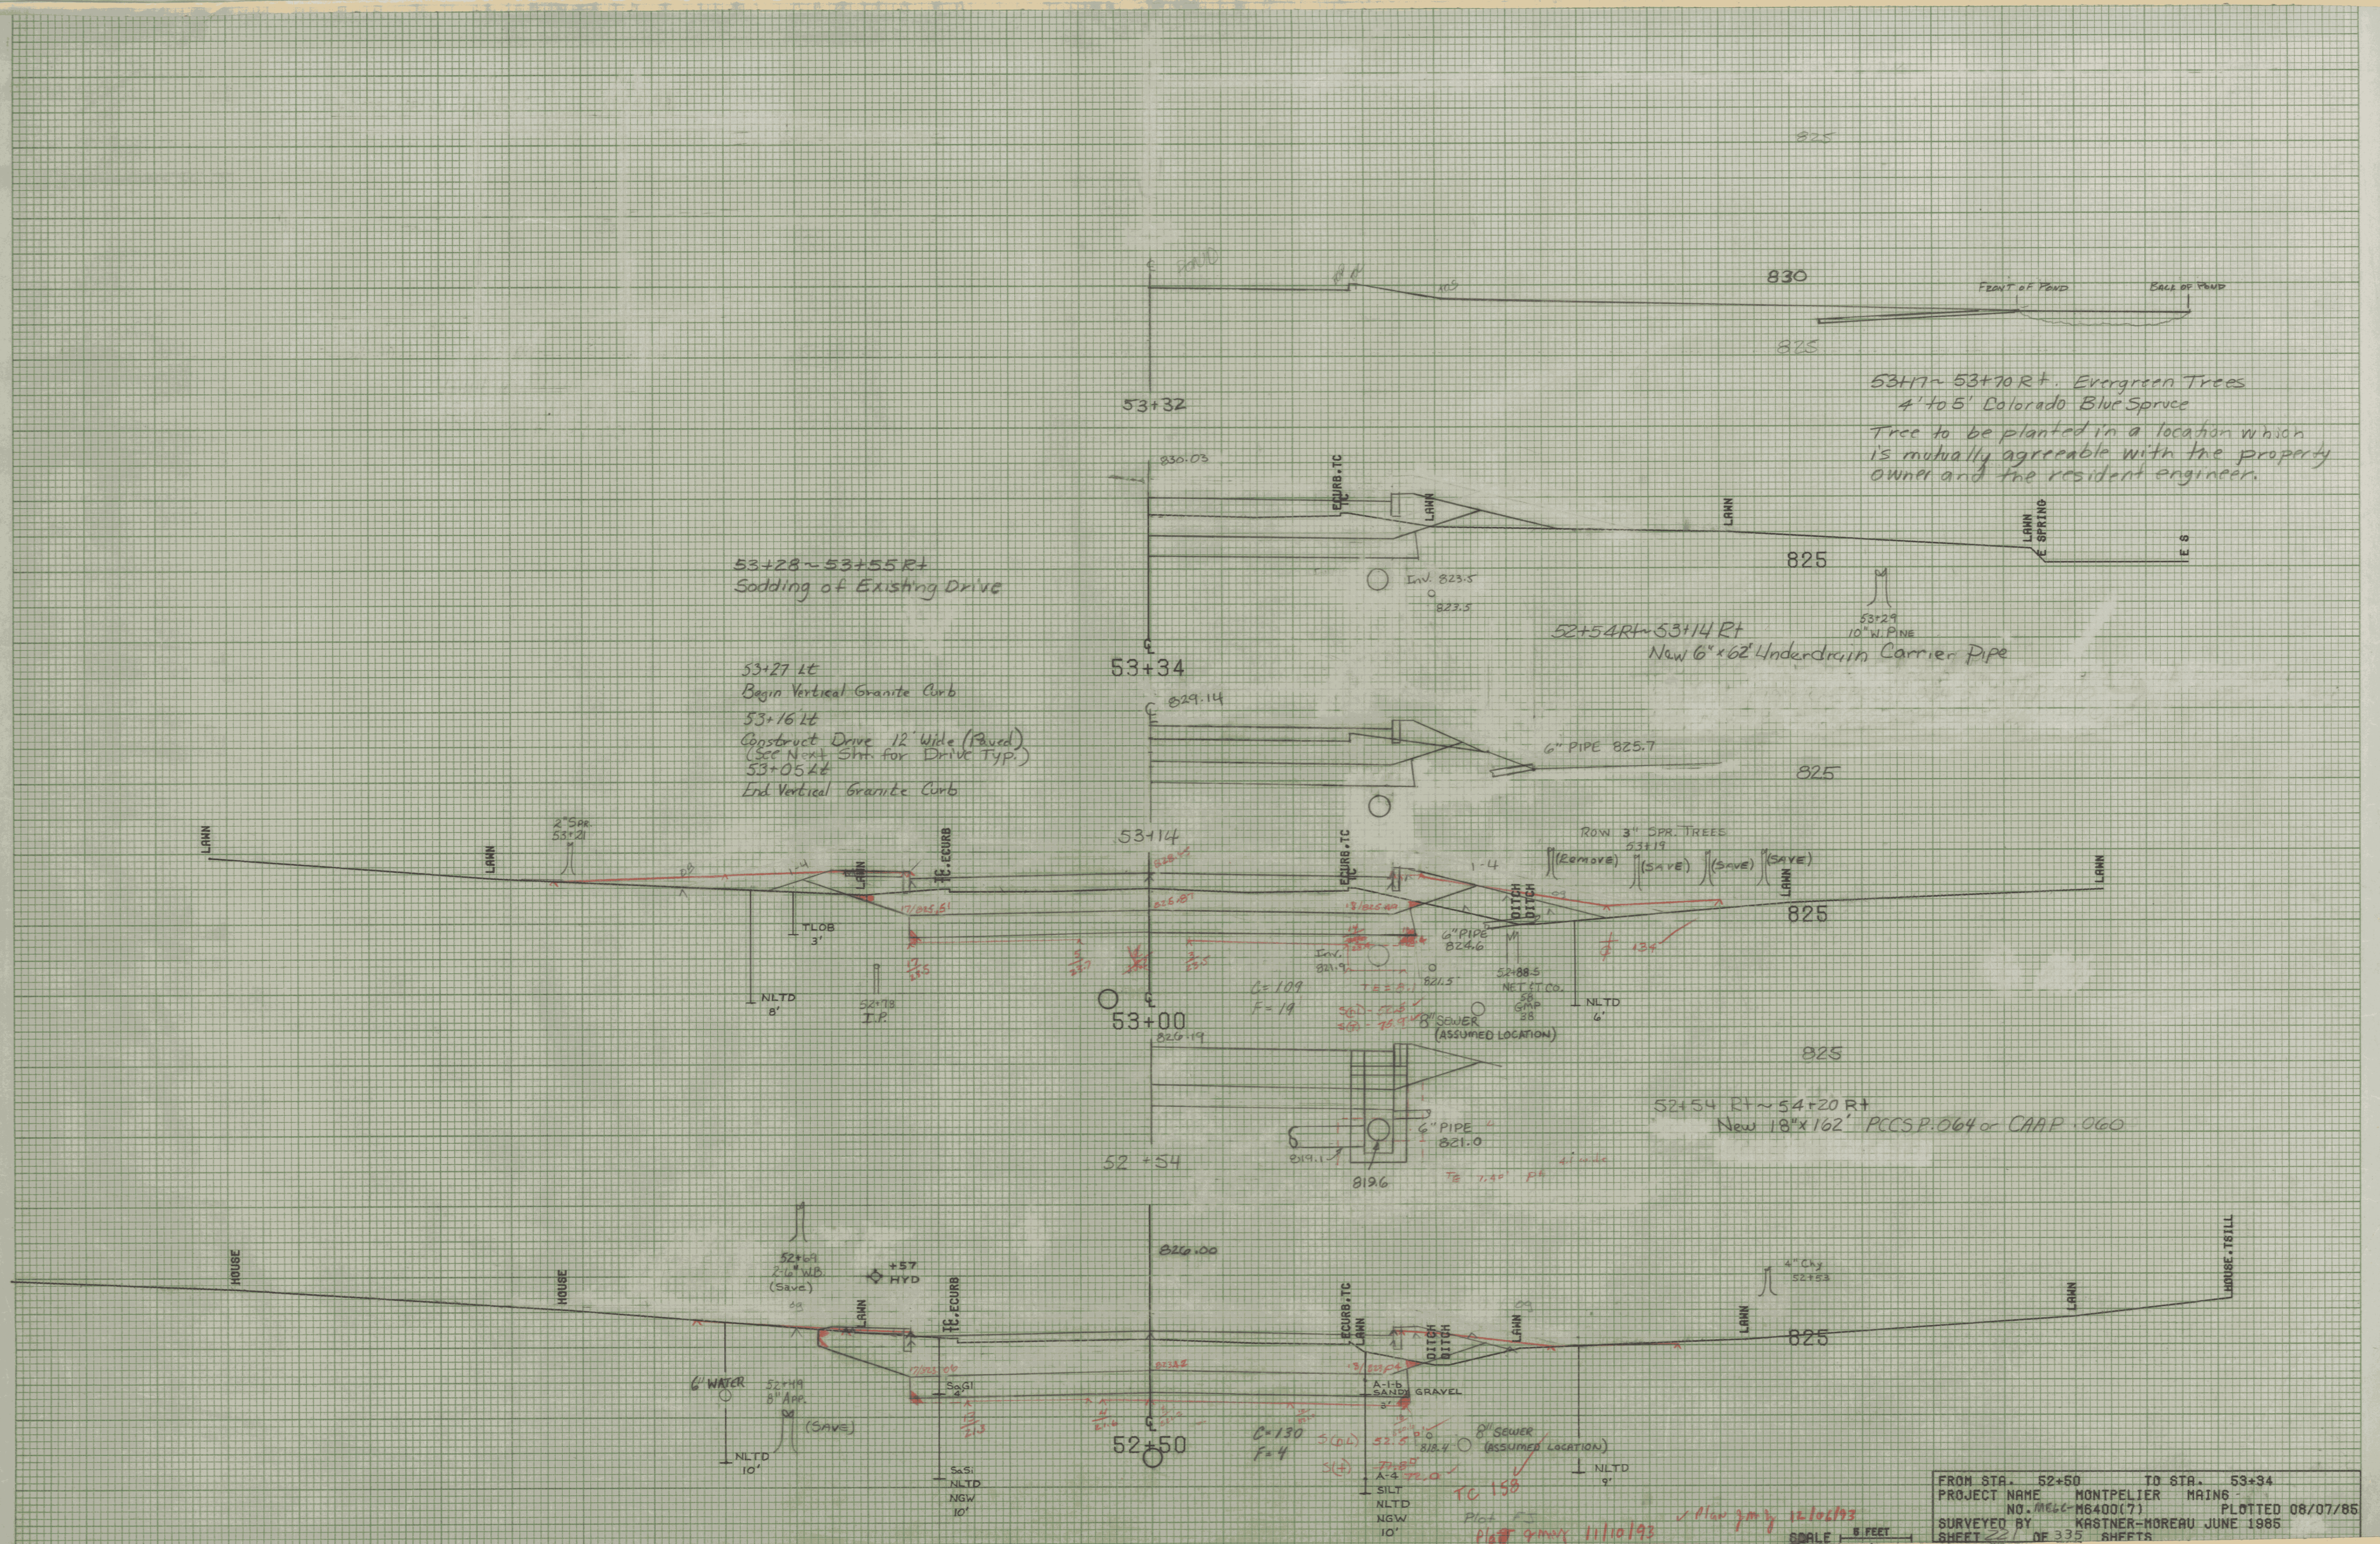

FROM STA.	52+50	TO STA.	53+34
PROJECT NAME	MONTPELIER MAINS		
NO.	ME66-M6400(7)	DATE	08/07/85
SURVEYED BY	KASTNER-MOREAU JUNE 1985		
SHEET	21	OF	335 SHEETS