

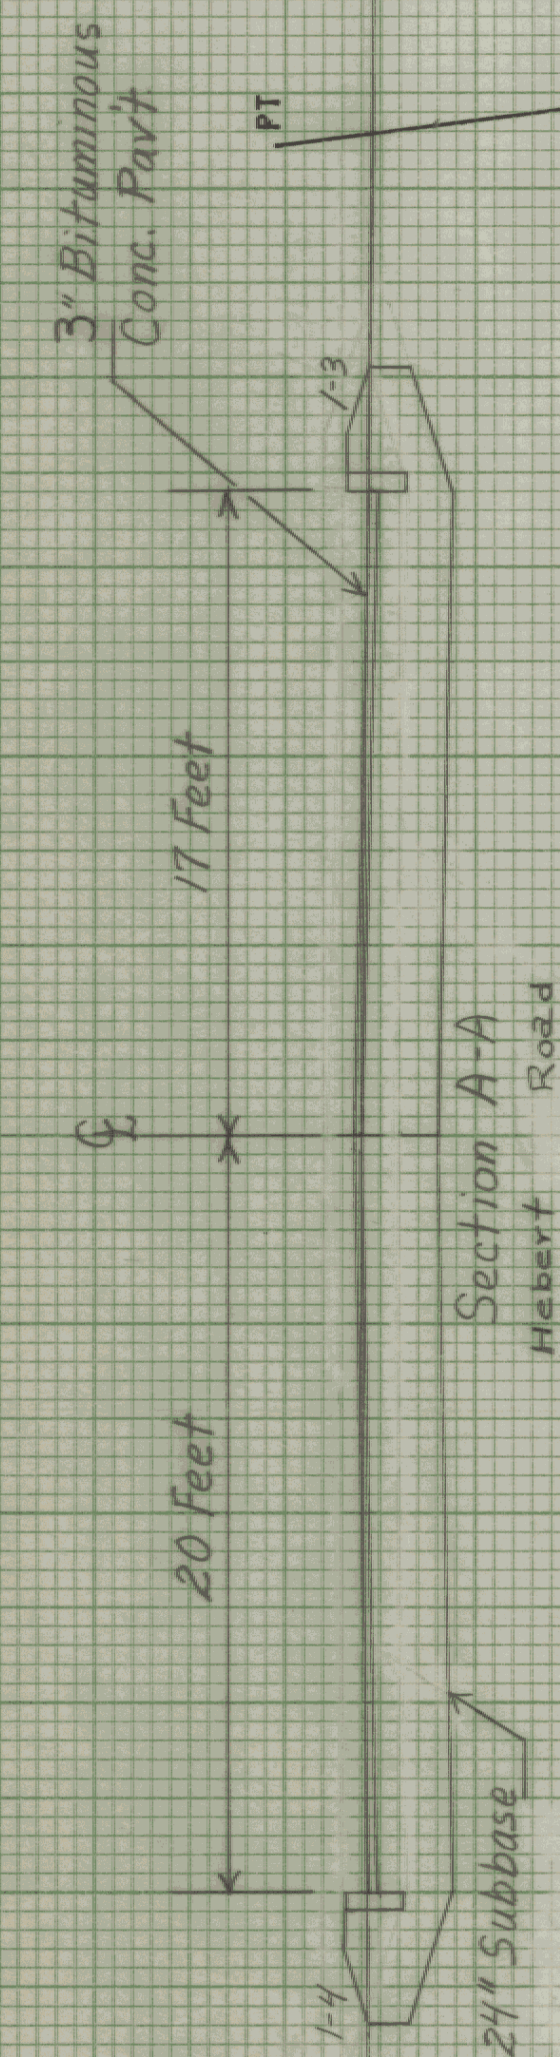


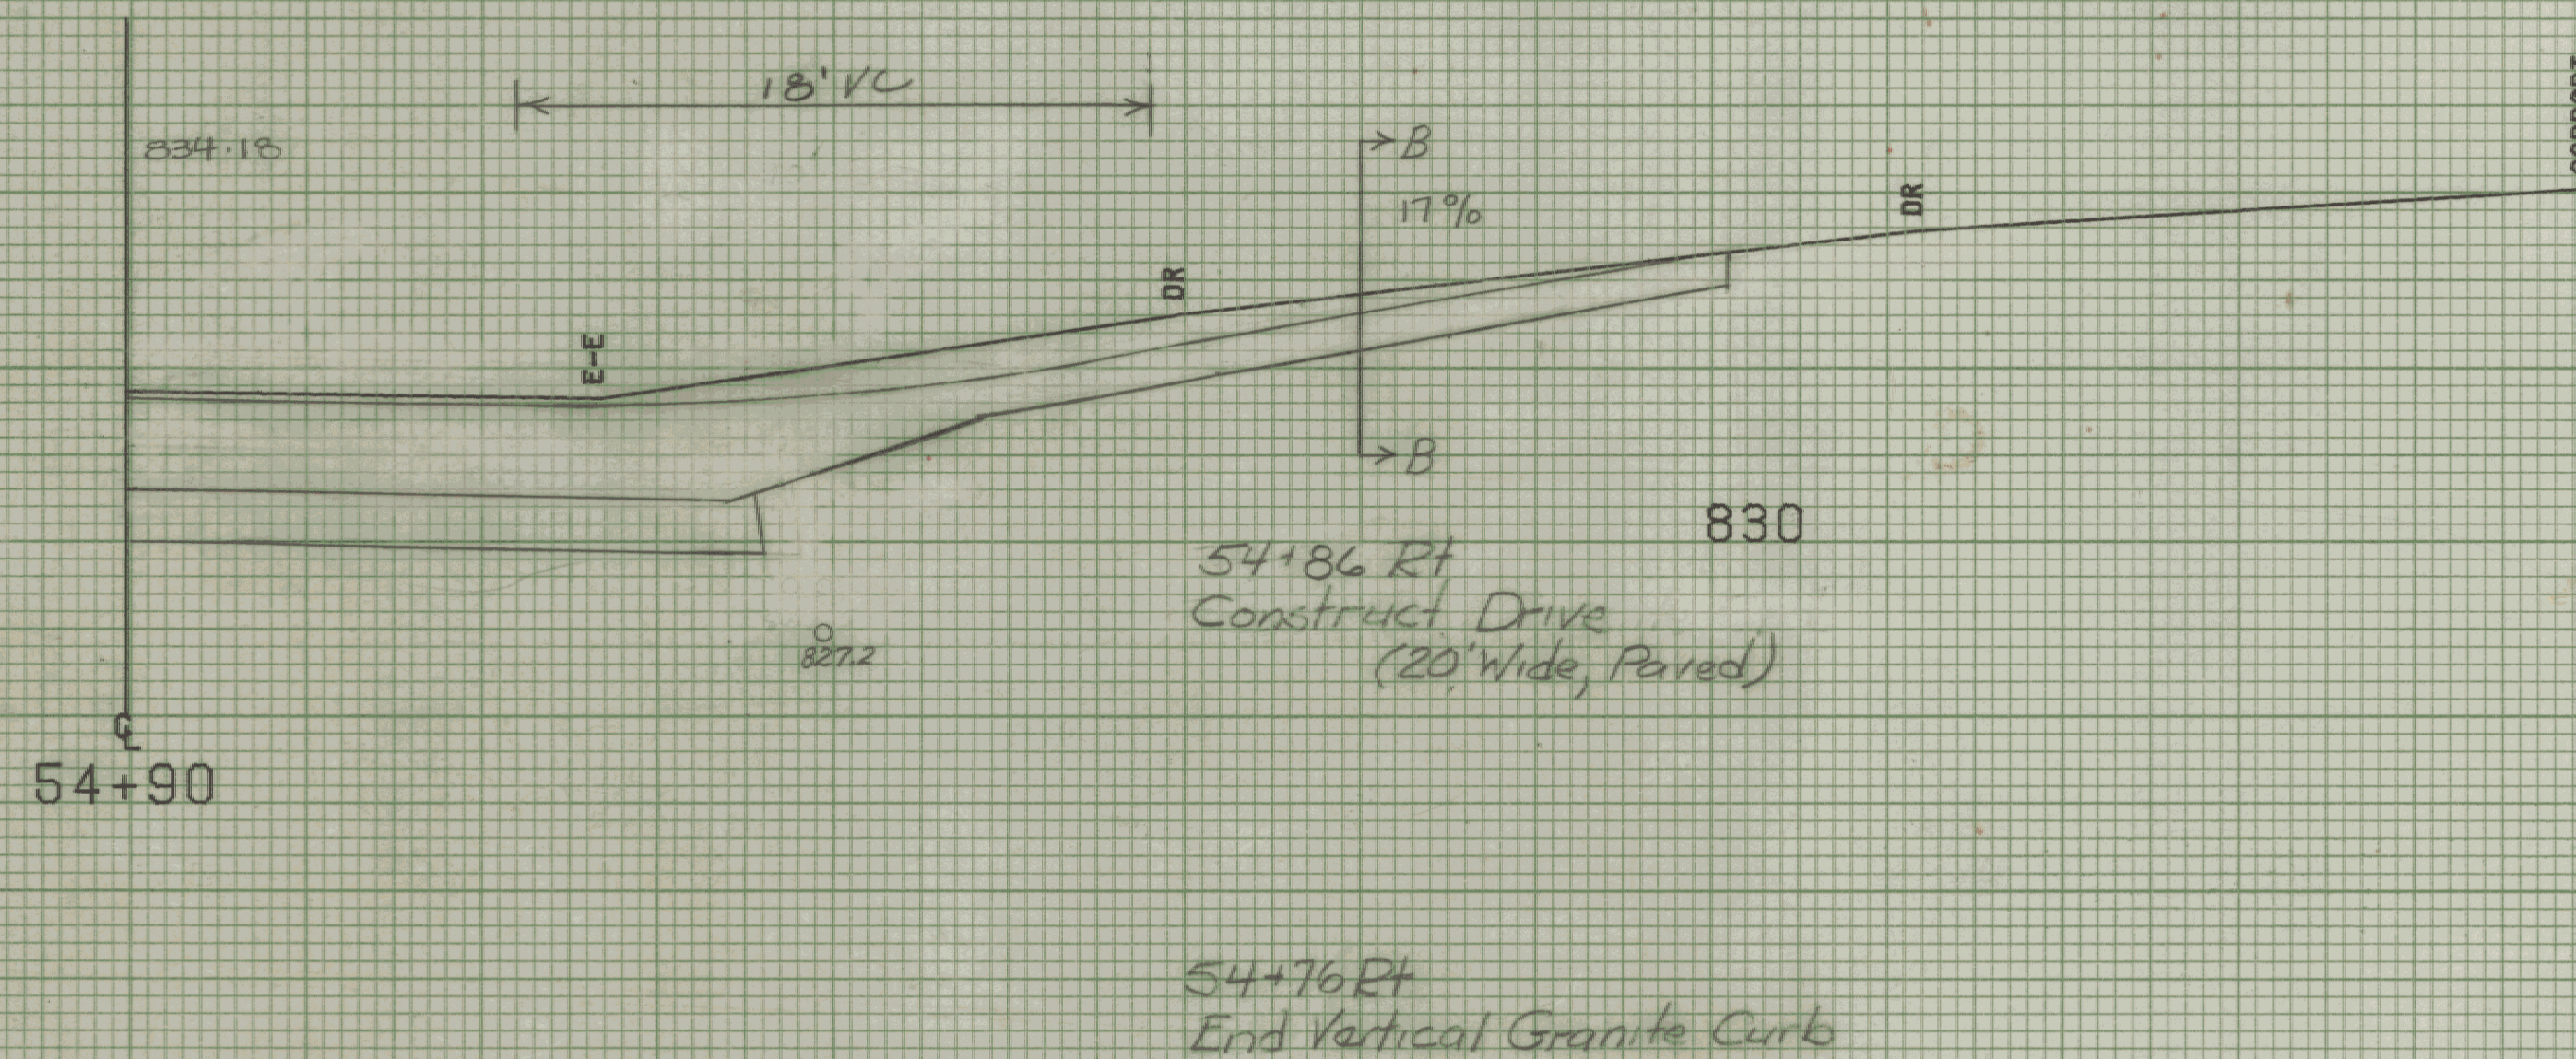


PT 55+20.49
 Dc 12° 00" Rt
 N.C.
 55+20 Rt
 End New 6" Underdrain
 w/ Flushing Basin @ 55+20 Rt
 55+03 R6
 Relocate Mailbox, Single Support (1)

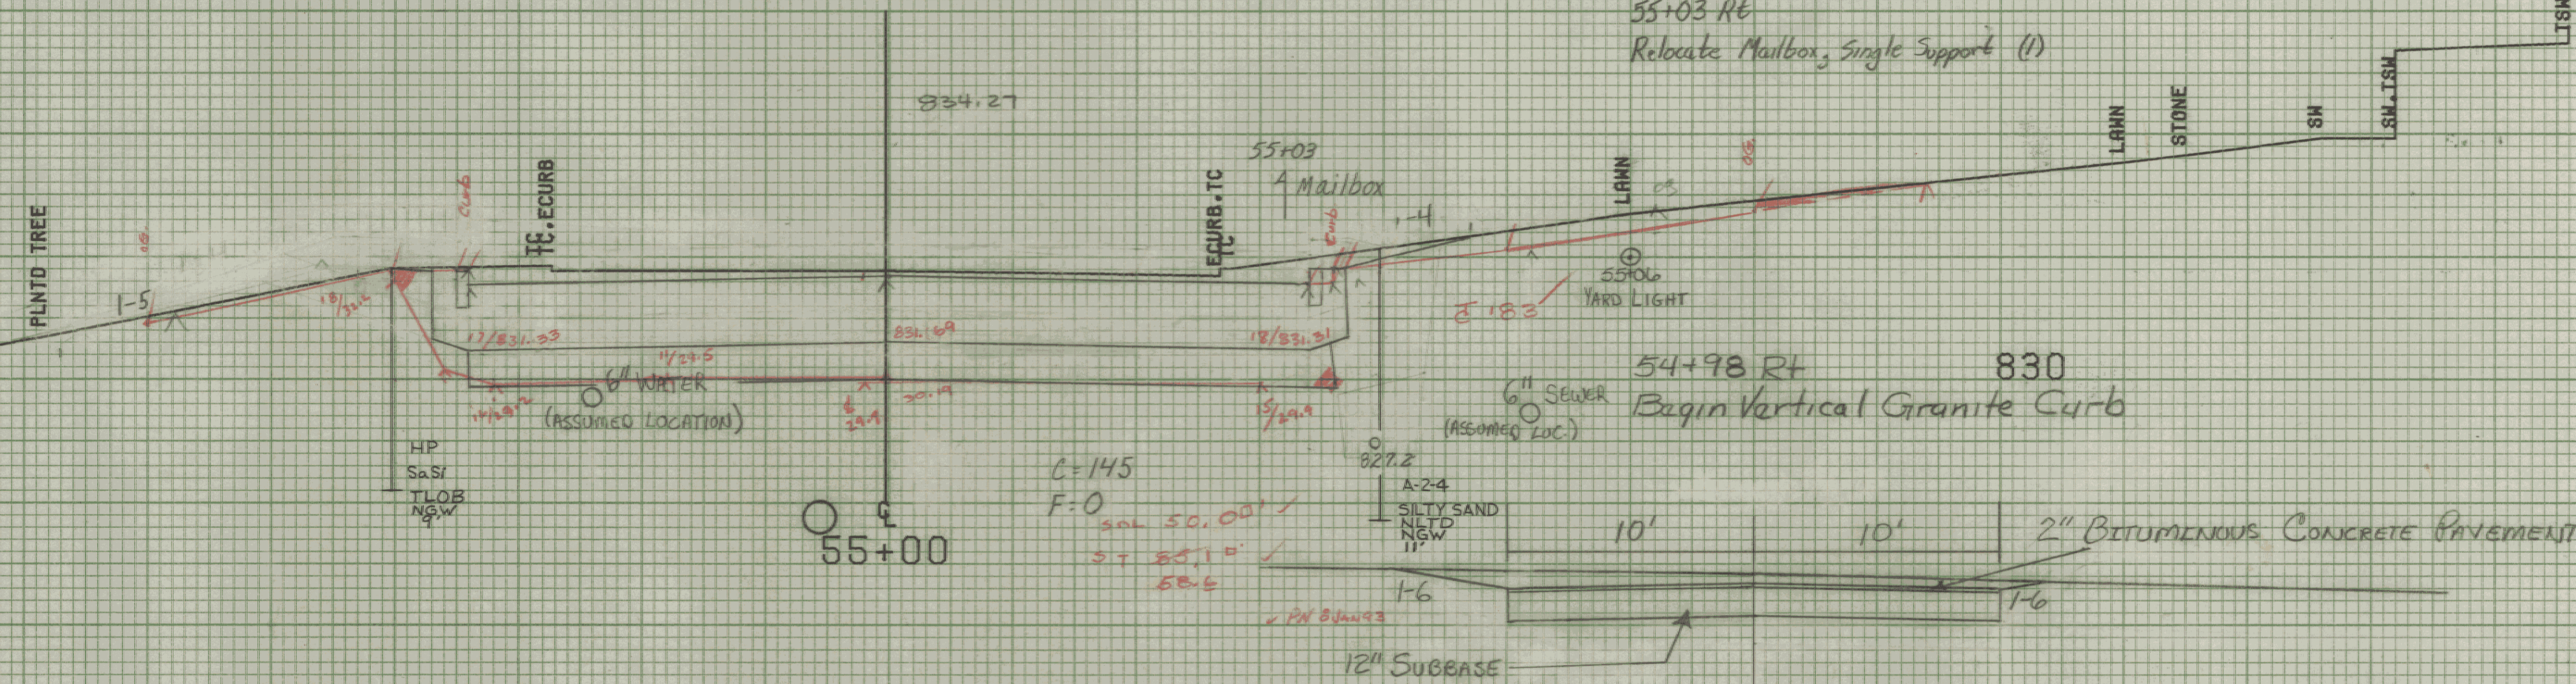

54+59 Lt
 Begin Vertical Granite Curb

54+51.70 Lt
 Construct Hebert Road Approach

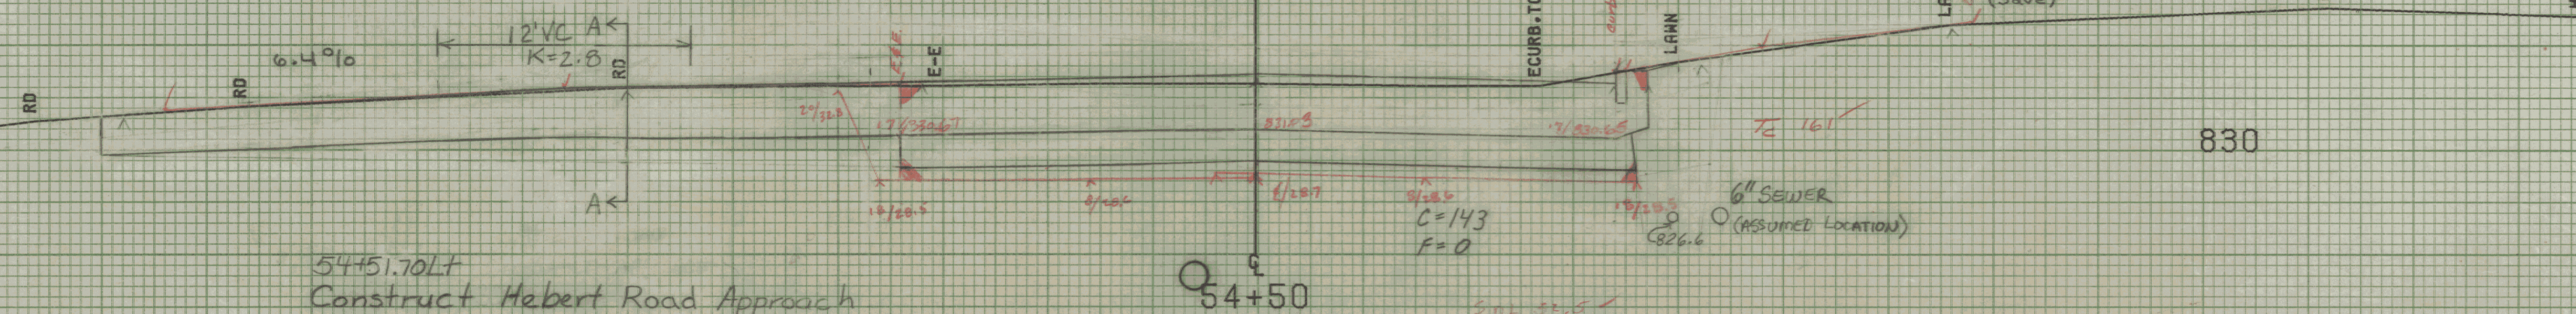

FROM STA. 54+50 TO STA. 55+00
 PROJECT NAME MONTPELIER MAINE
 NO. ME6C-6400(7) PLOTTED 08/07/85
 SURVEYED BY KASTNER MOREAU JUNE 1985
 SHEET 223 335 SHEETS

SCALE 5 FEET

FINALS - C.B. LAMR 11-15-93

✓ Plan 8/10/93
 ✓ Plan 8/10/93