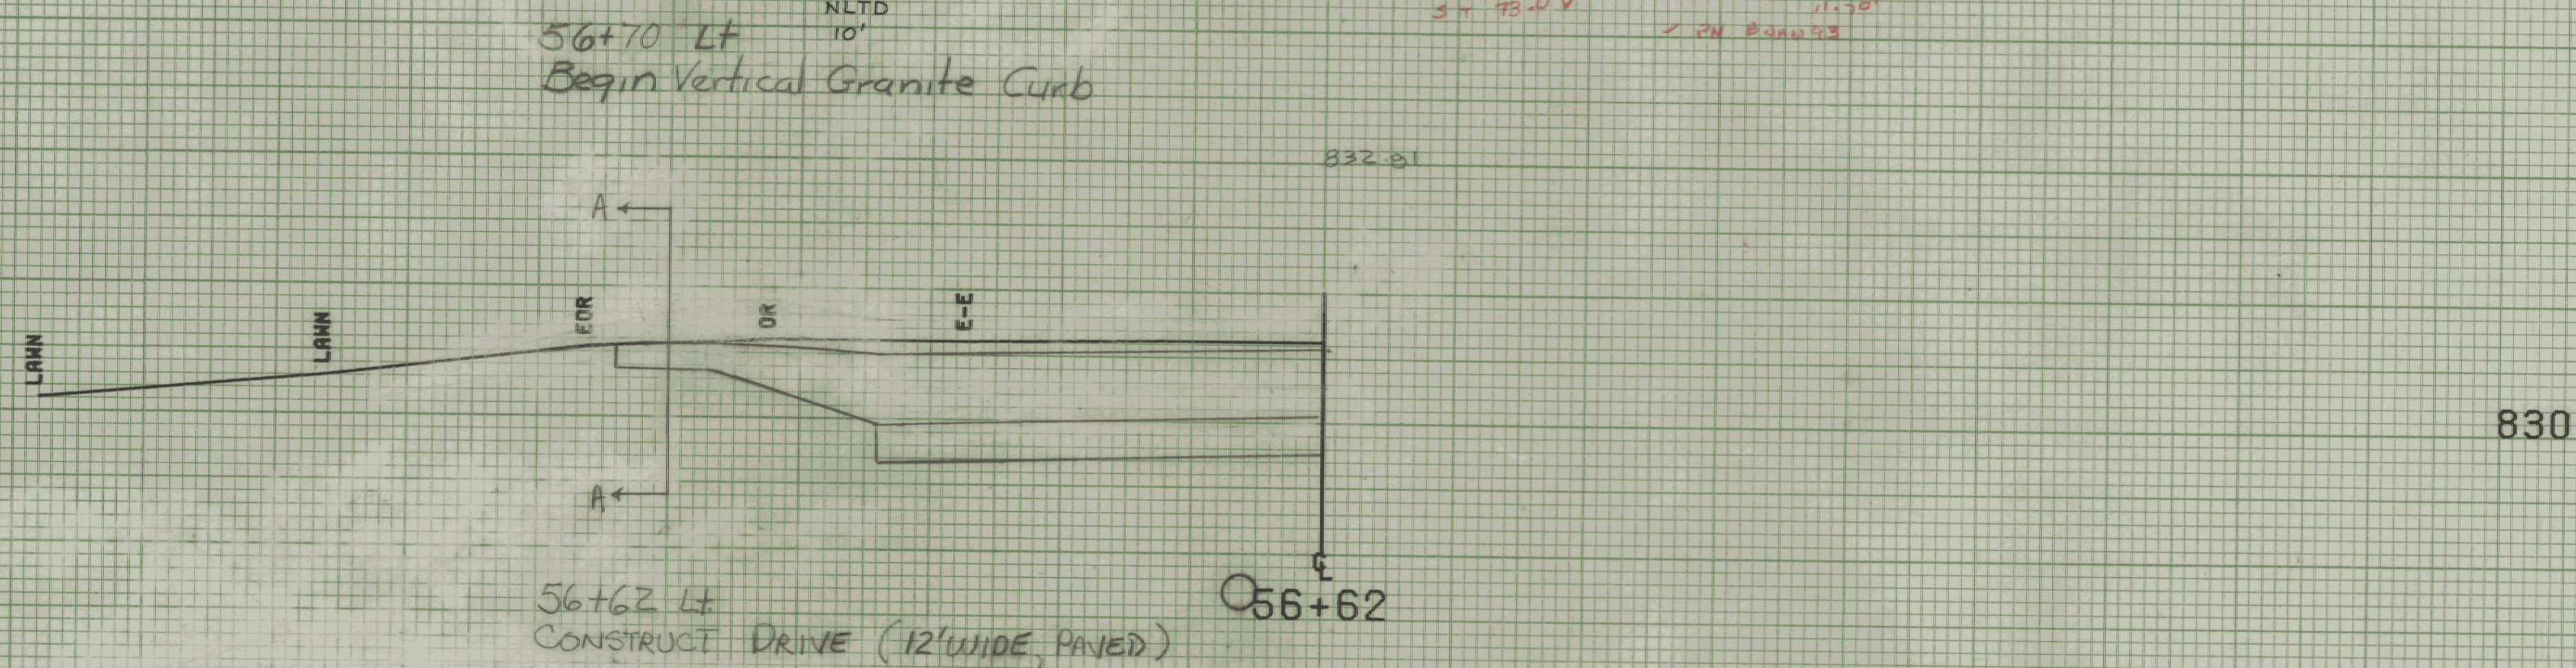
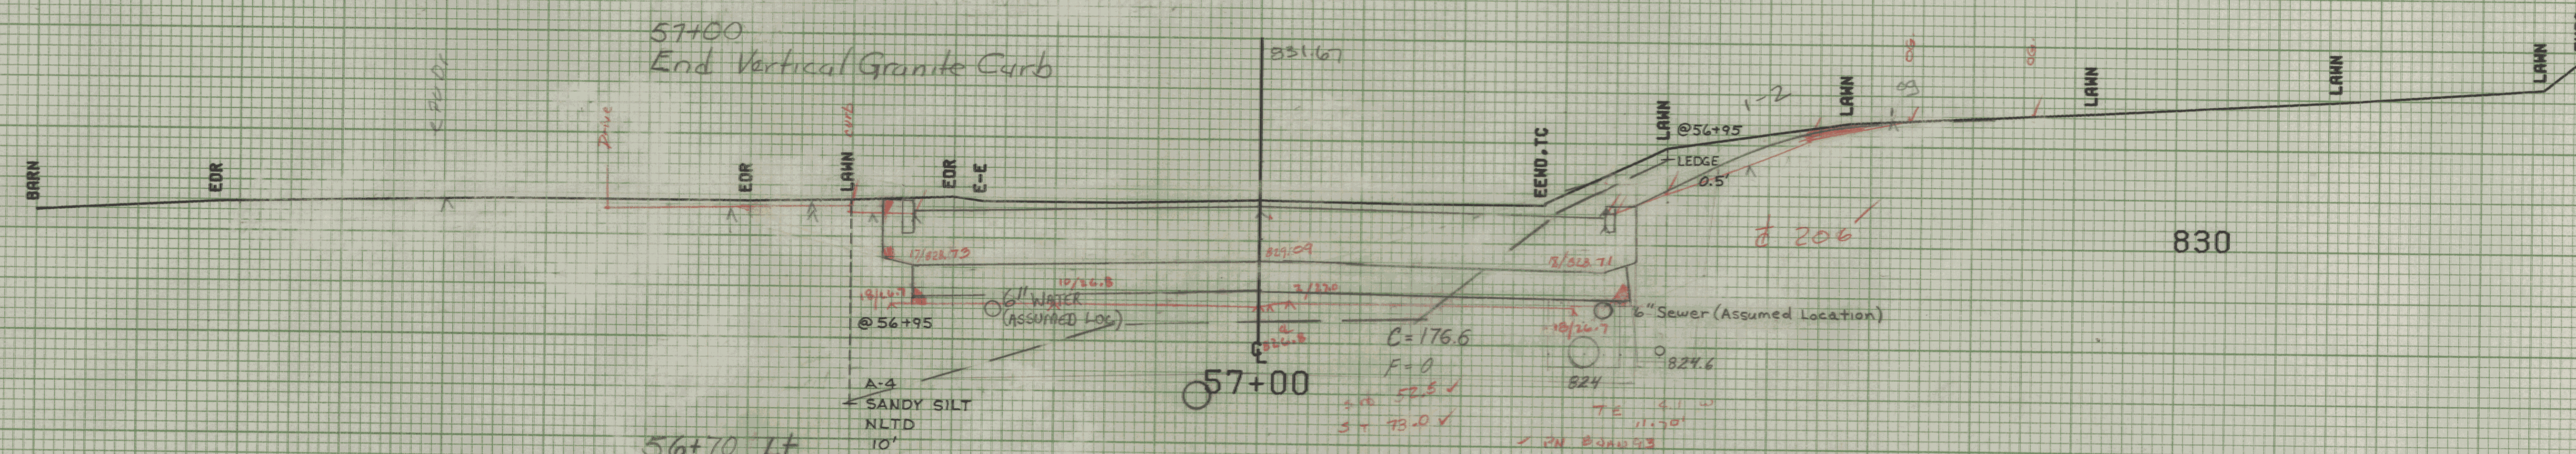


✓ Plan 8m y. 12/06/93

FROM STA. 56+50 TO STA. 57+00
PROJECT NAME MONTPELIER MAIN7
NO. ~~0660~~ M6400(7) PLOTTED 08/07/85
SURVEYED BY KASTNER-MOREAU JUNE 1985
SHEET ~~223~~ OF 335 SHEETS

SCALE $\overline{\hspace{1.5cm}}$ 5 FEET