
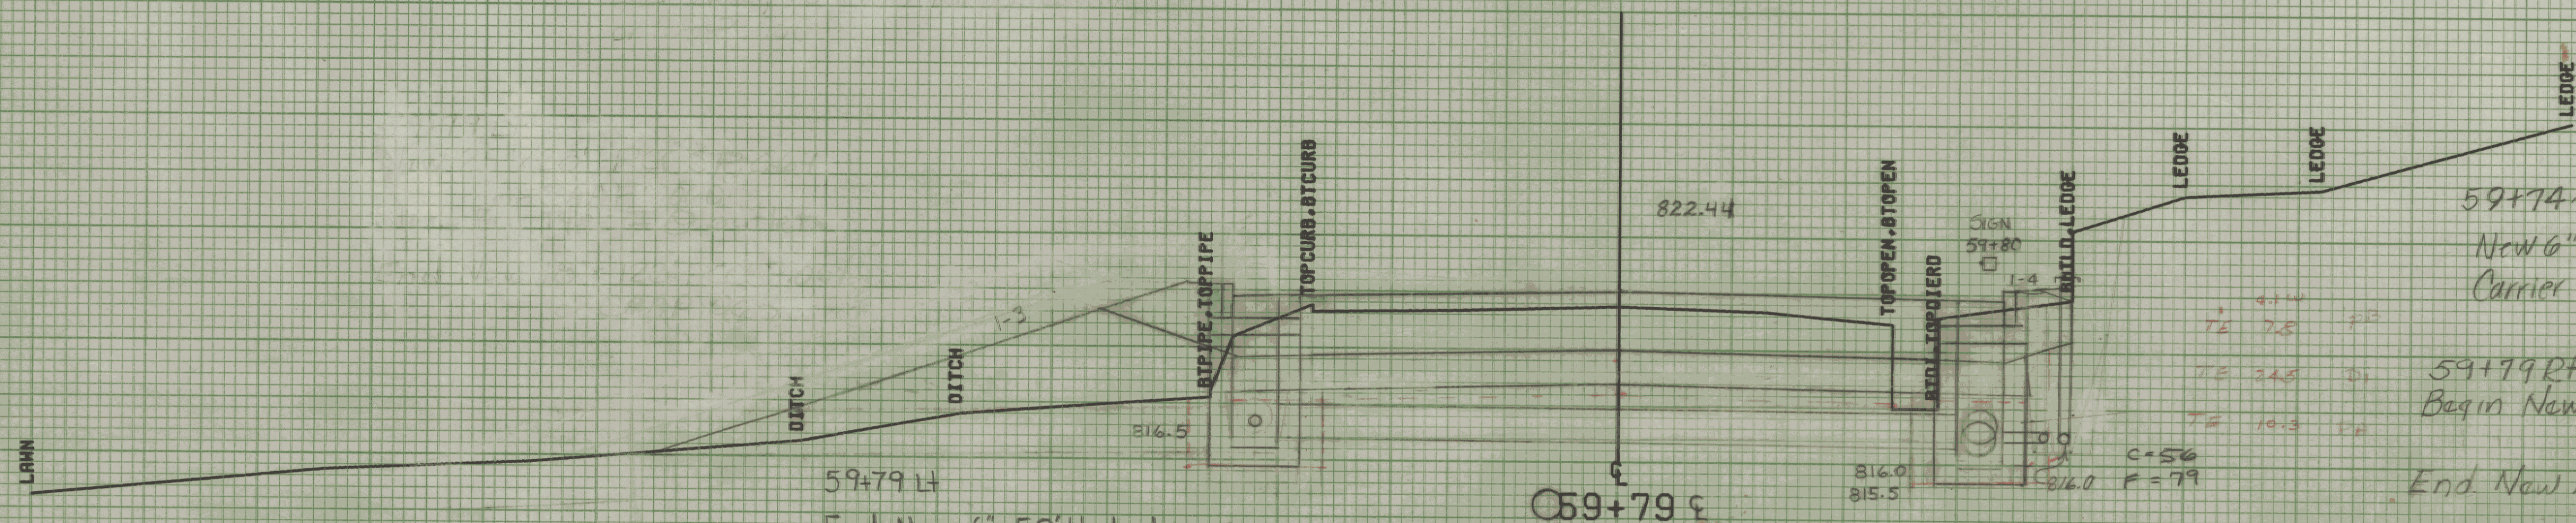


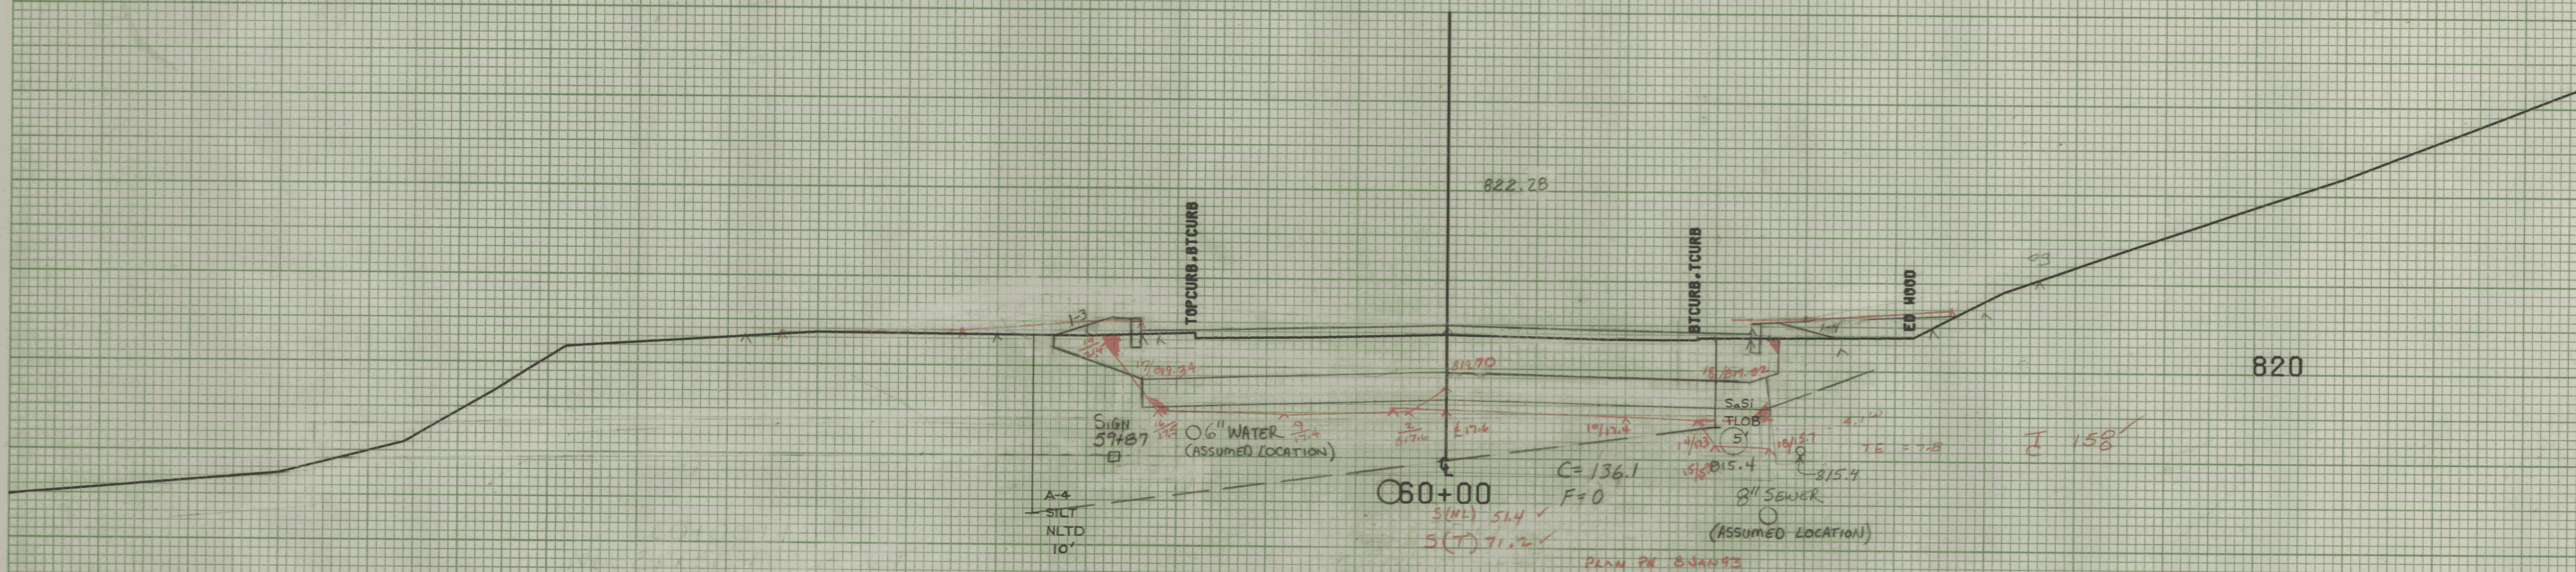

59+79 LT
End New 6"x50' Underdrain
w/ F.B. @ 59+30 LT.

Remove Existing 15" Conc. Pipe
With 2'x2' DI
New 10"x30' PCCSP. 064
or CAAP. 060

59+74 ~ 59+79 RT.
New 6"x6' Underdrain
Carrier Pipe
820
59+79 RT
Begin New 18"x204' PCCSP. 064
or CAAP. 060
End New 18"x232' PCCSP. 064
or CAAP. 060
Begin New 6"x300' Underdrain w/ F.B. @ 59+79 RT.
59+74 RT.
End 6"x444' Underdrain
w/ F.B. @ 55+30 RT

FROM STA. 59+79 TO STA. 60+00
PROJECT NAME MONTPELIER MAIN
NO. 16400(7) PLOTTED 08/07/85
SURVEYED BY KASTNER-MOREAU JUNE 1985
SHEET 29 OF 335 SHEETS

SCALE 5 FEET