


820.96

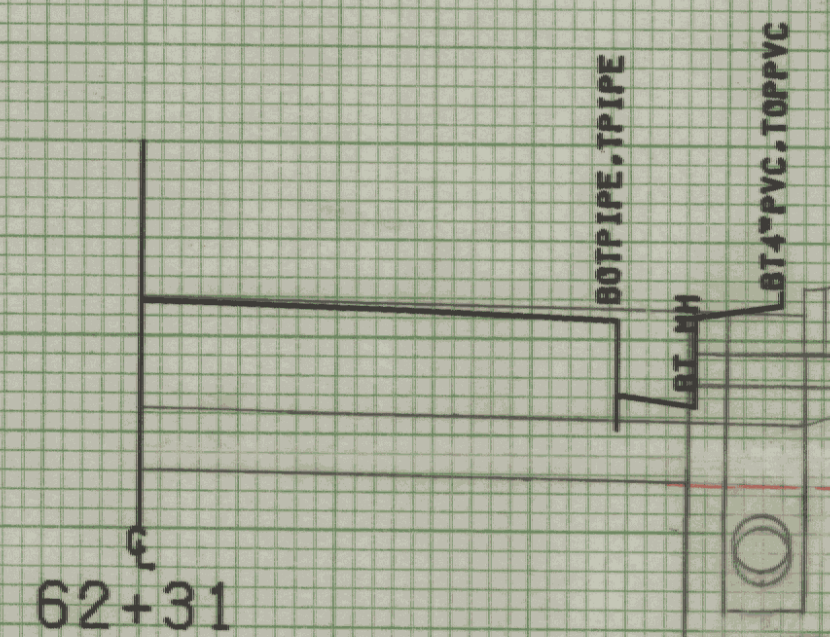

Inlet 814.0
outlet 813.7

62+31 RT
Begin Vertical Granite Curb

820

End New 18" x 46" PCCSP.064

or CAAP.060

Begin New 18" x 56" PCCSP.064

or CAAP.060

Connect Existing 4" PVC Underdrain
to Near Drop Inlet

TE 9.0 PD
TE 16.0 D1
TE 10.3 PA


62+40 Lt. Removing and Resetting Yard Light

The light shall be relocated outside the City's R.O.W. Limits at a location mutually agreeable with the resident engineer and the property owner. The cost of work and necessary materials shall be paid as Item 679.25 (MOD) Removing and Resetting Light Pole and shall be Non-Govt. Participating.

+22
2" APPLE
(Save)

62+06

Begin Vertical Granite Curb

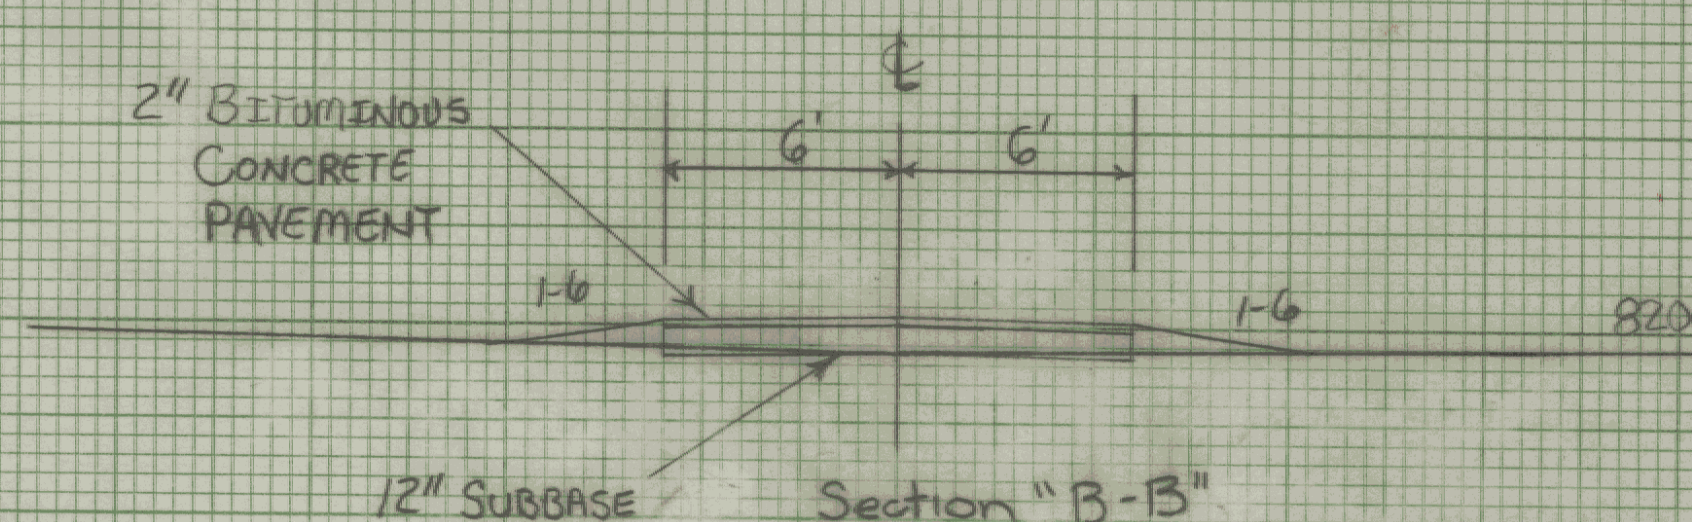

Section "B-B"

62+00 Lt.

CONSTRUCT DRIVE 12' WIDE (PAVED)

62+19

821.02

18' VC

ED-ED

DRIVE

+15.50%

820

814.1

10'

10'

2" BIT. CONC. PAVT.
12" SUBBASE

820

Section "A-A"

62+19 Rt.

CONSTRUCT DRIVE 20' WIDE (PAVED)

62+11 Rt.

End Vertical Granite Curb

821.13

ST CURB TOP CURB

LANE

820

RIGHT L. 18" TRAIL

OK ED DR

DRIVE

DRIVE

DRIVE

PV DR

END ED DR

62+96
B-BALL HOOP

61+92 Lt.

End Vertical Granite Curb

A-4

SILT

6"

A-4

SANDY SILT

NLTD

10'

62+00

3.00

52.5

3.7

63.3

C=149.7
F=2

SEWER
(ASSUMED LOC.)

8"

10'

814.21

HP

Q 814.1

HP

Q 814.1

HP

FROM STA. 62+00 TO STA. 62+31
PROJECT NAME MONTPELIER MAIN7
NO. MREGC-M6400(7) PLOTTED 08/07/85
SURVEYED BY KASTNER-MOREAU JUNE 1985
SHEET 231 OF 335 SHEETS

SCALE 5 FEET

Plot P3