


63+39 Rt
Construct 16' Gravel Drive
63+31 Rt
End Vertical Granite Curb

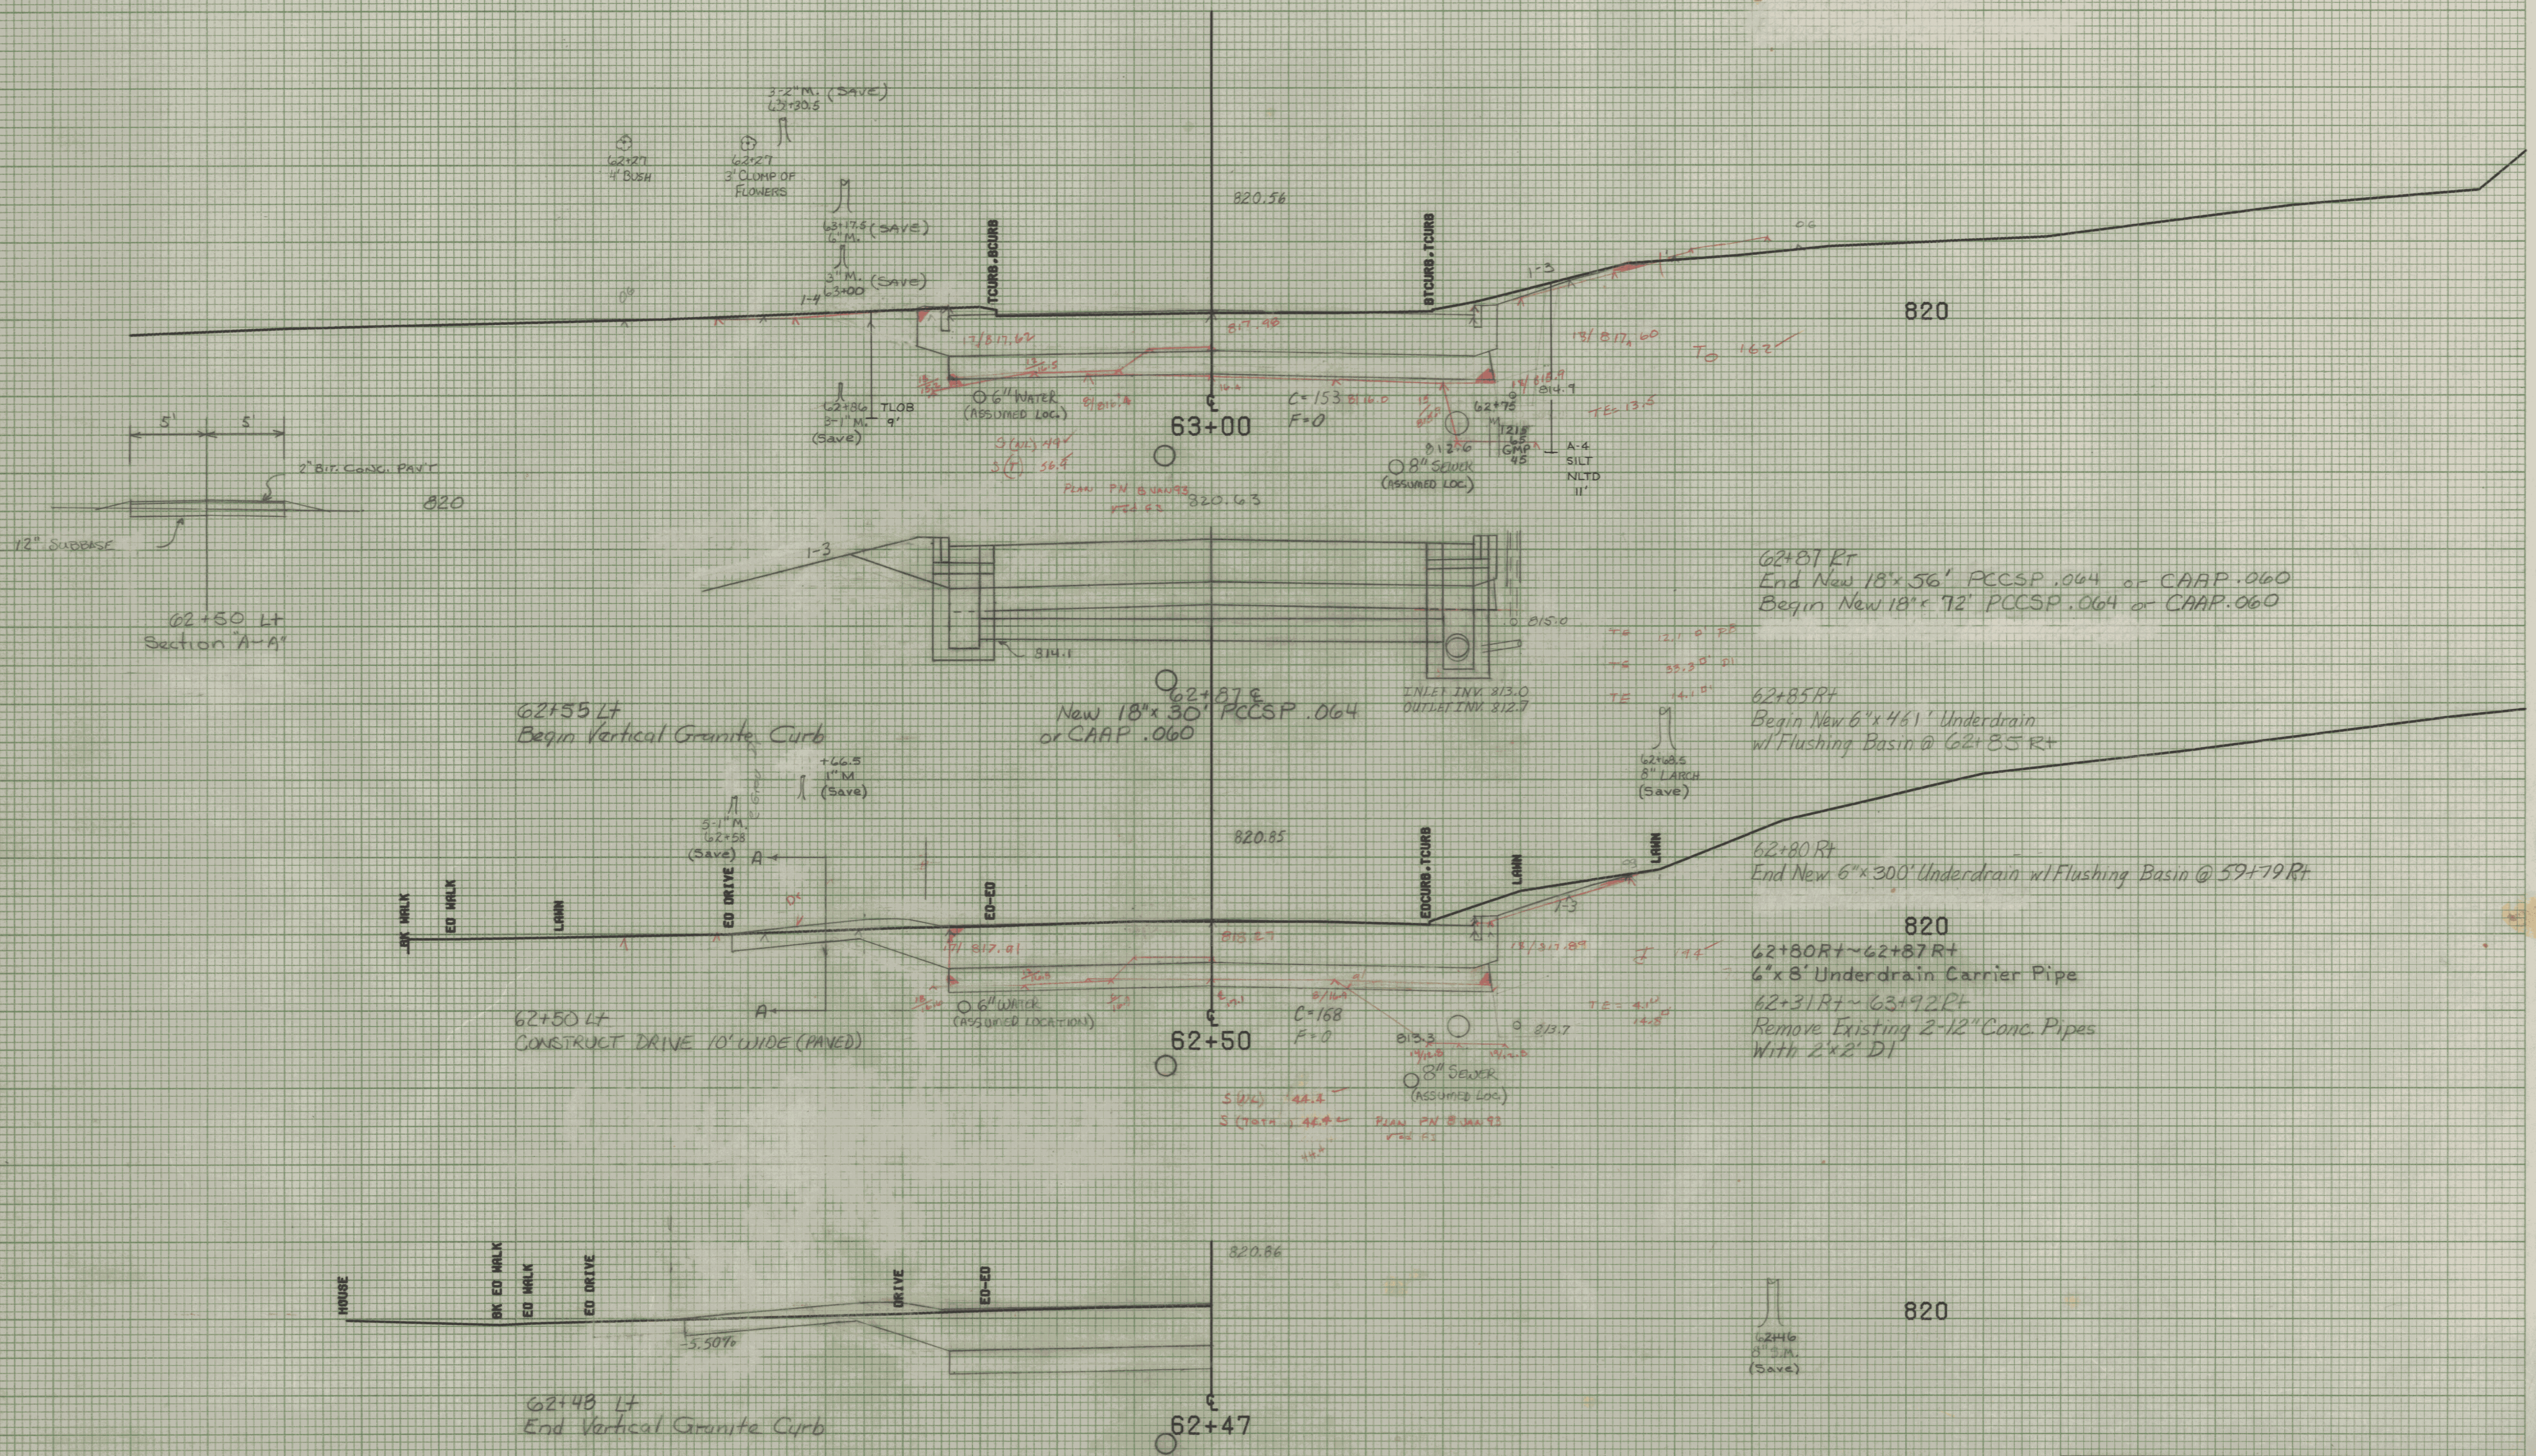

FROM STA. 62+47 TO STA. 63+00
PROJECT NAME MONTPELIER MAIN
NO. MEGG-M6400(71)
SURVEYED BY KASTNER-MOREAU
SHEET 22 OF 335 SHEETS
PLOTTED 06/07/85
JUNE 1985

SCALE 5 FEET

Flow 2nd 12/17/93