
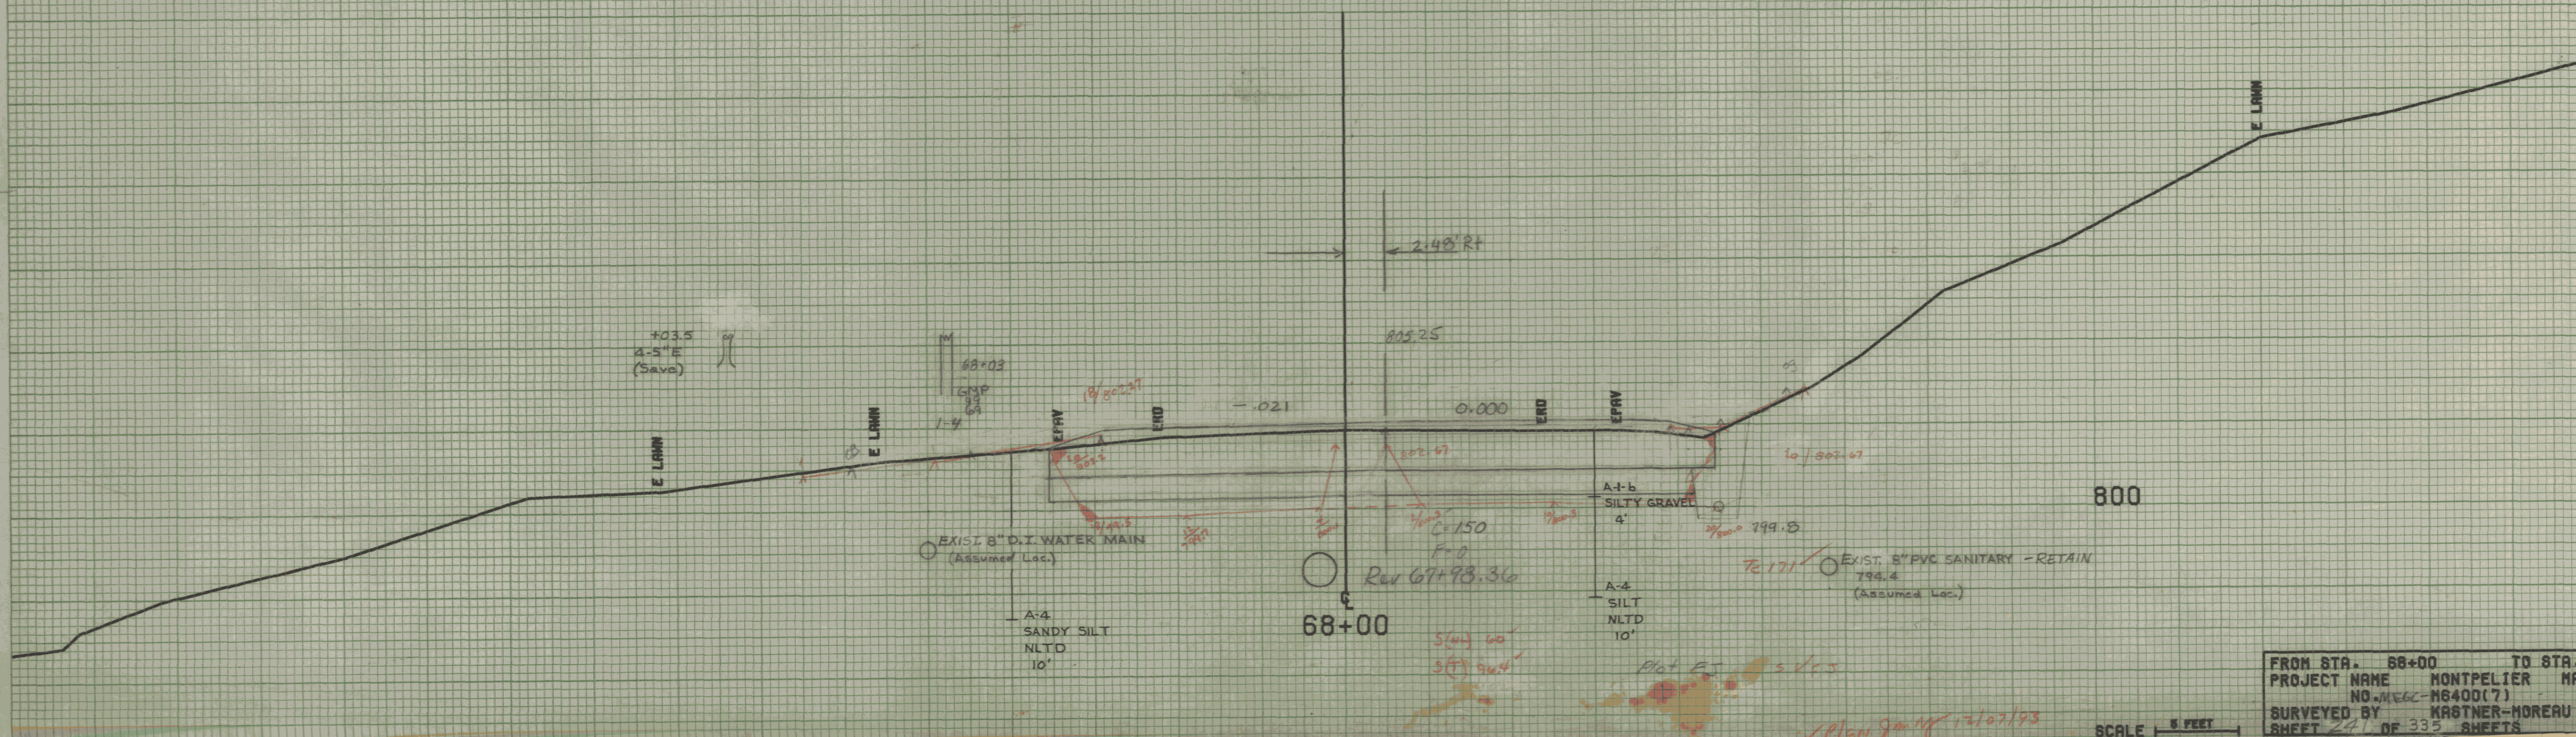
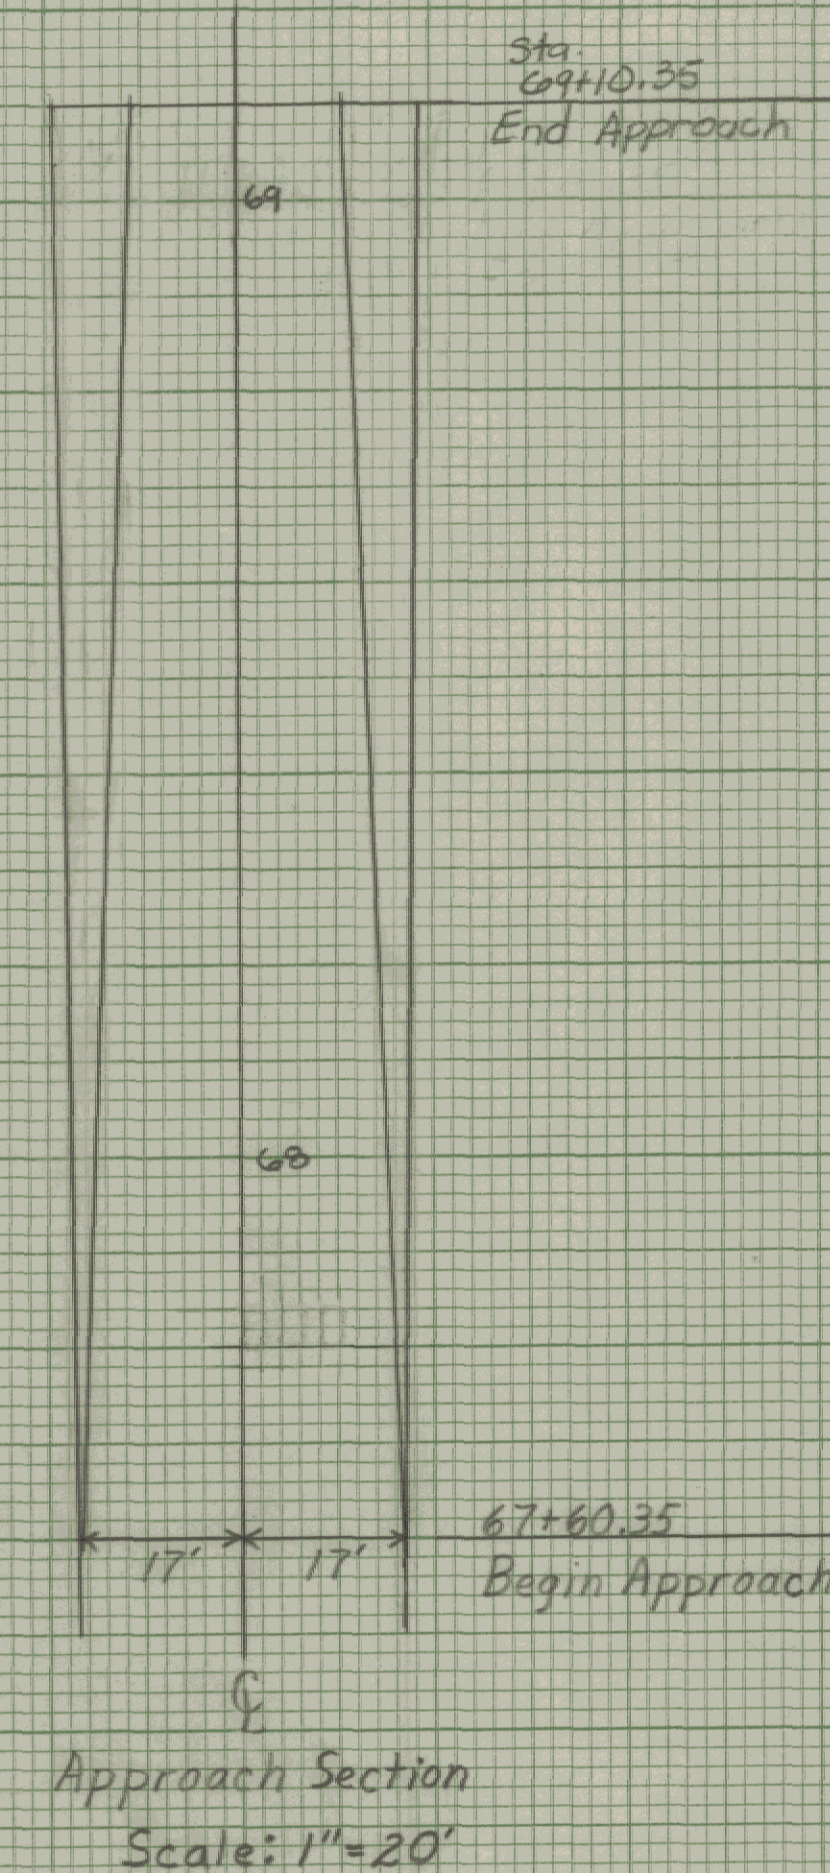
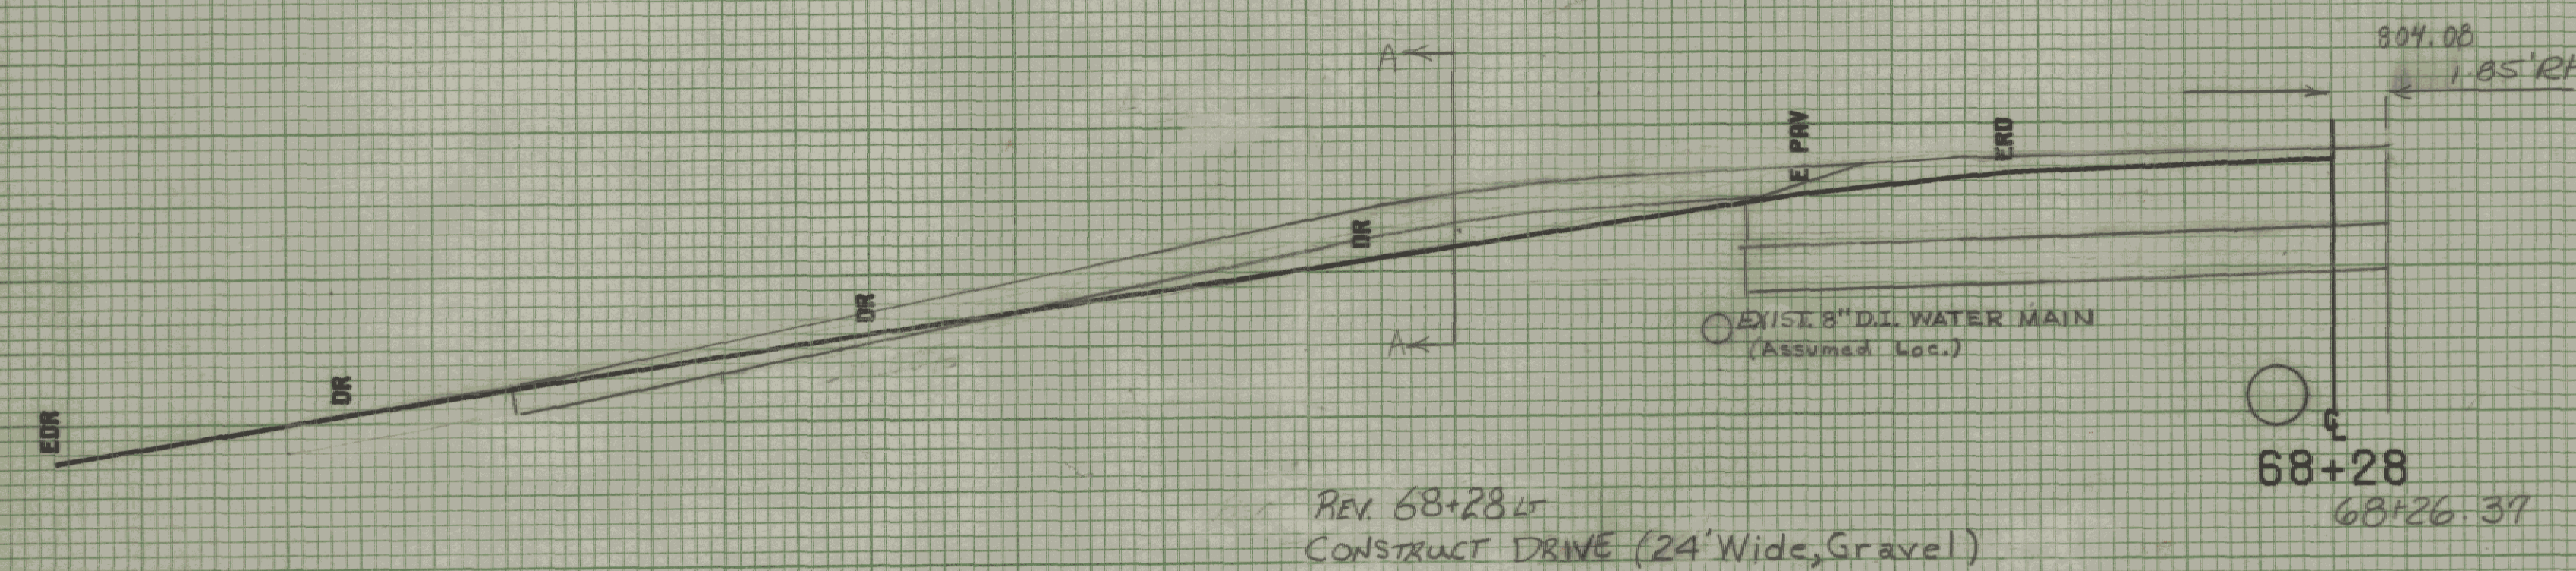


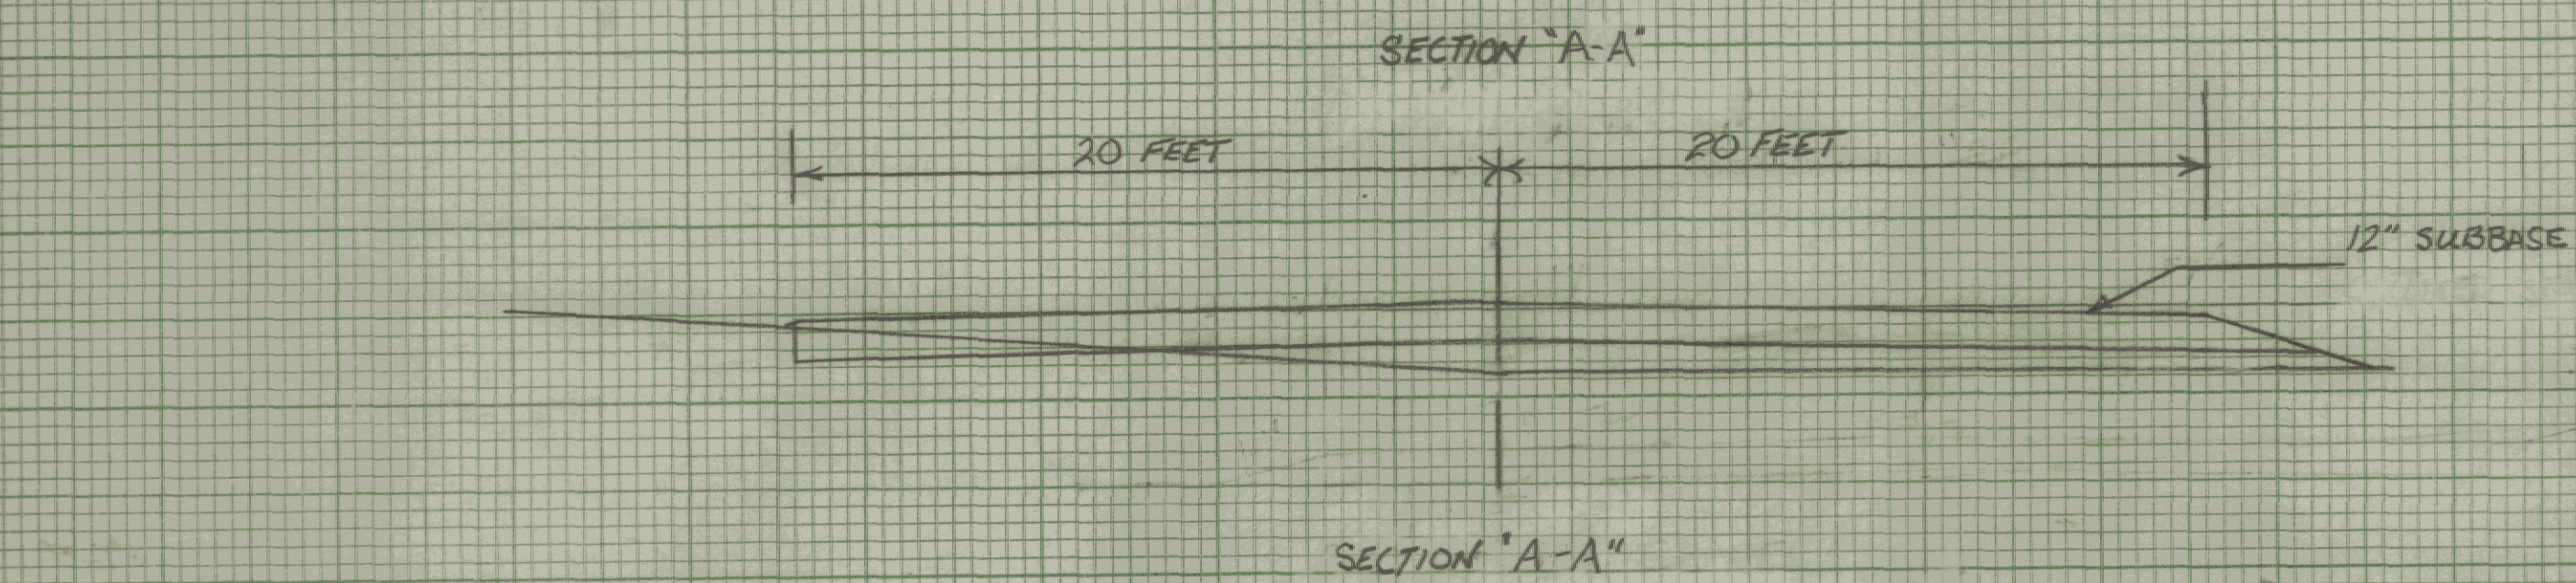

FROM STA. 68+00 TO STA. 68+28  
PROJECT NAME MONTPELIER MAIN  
NO. M-6400(7) PLOTTED 08/07/85  
SURVEYED BY KASTNER-MOREAU JUNE 1985  
SHEET 241 OF 335 SHEETS

SCALE 1"=20'