


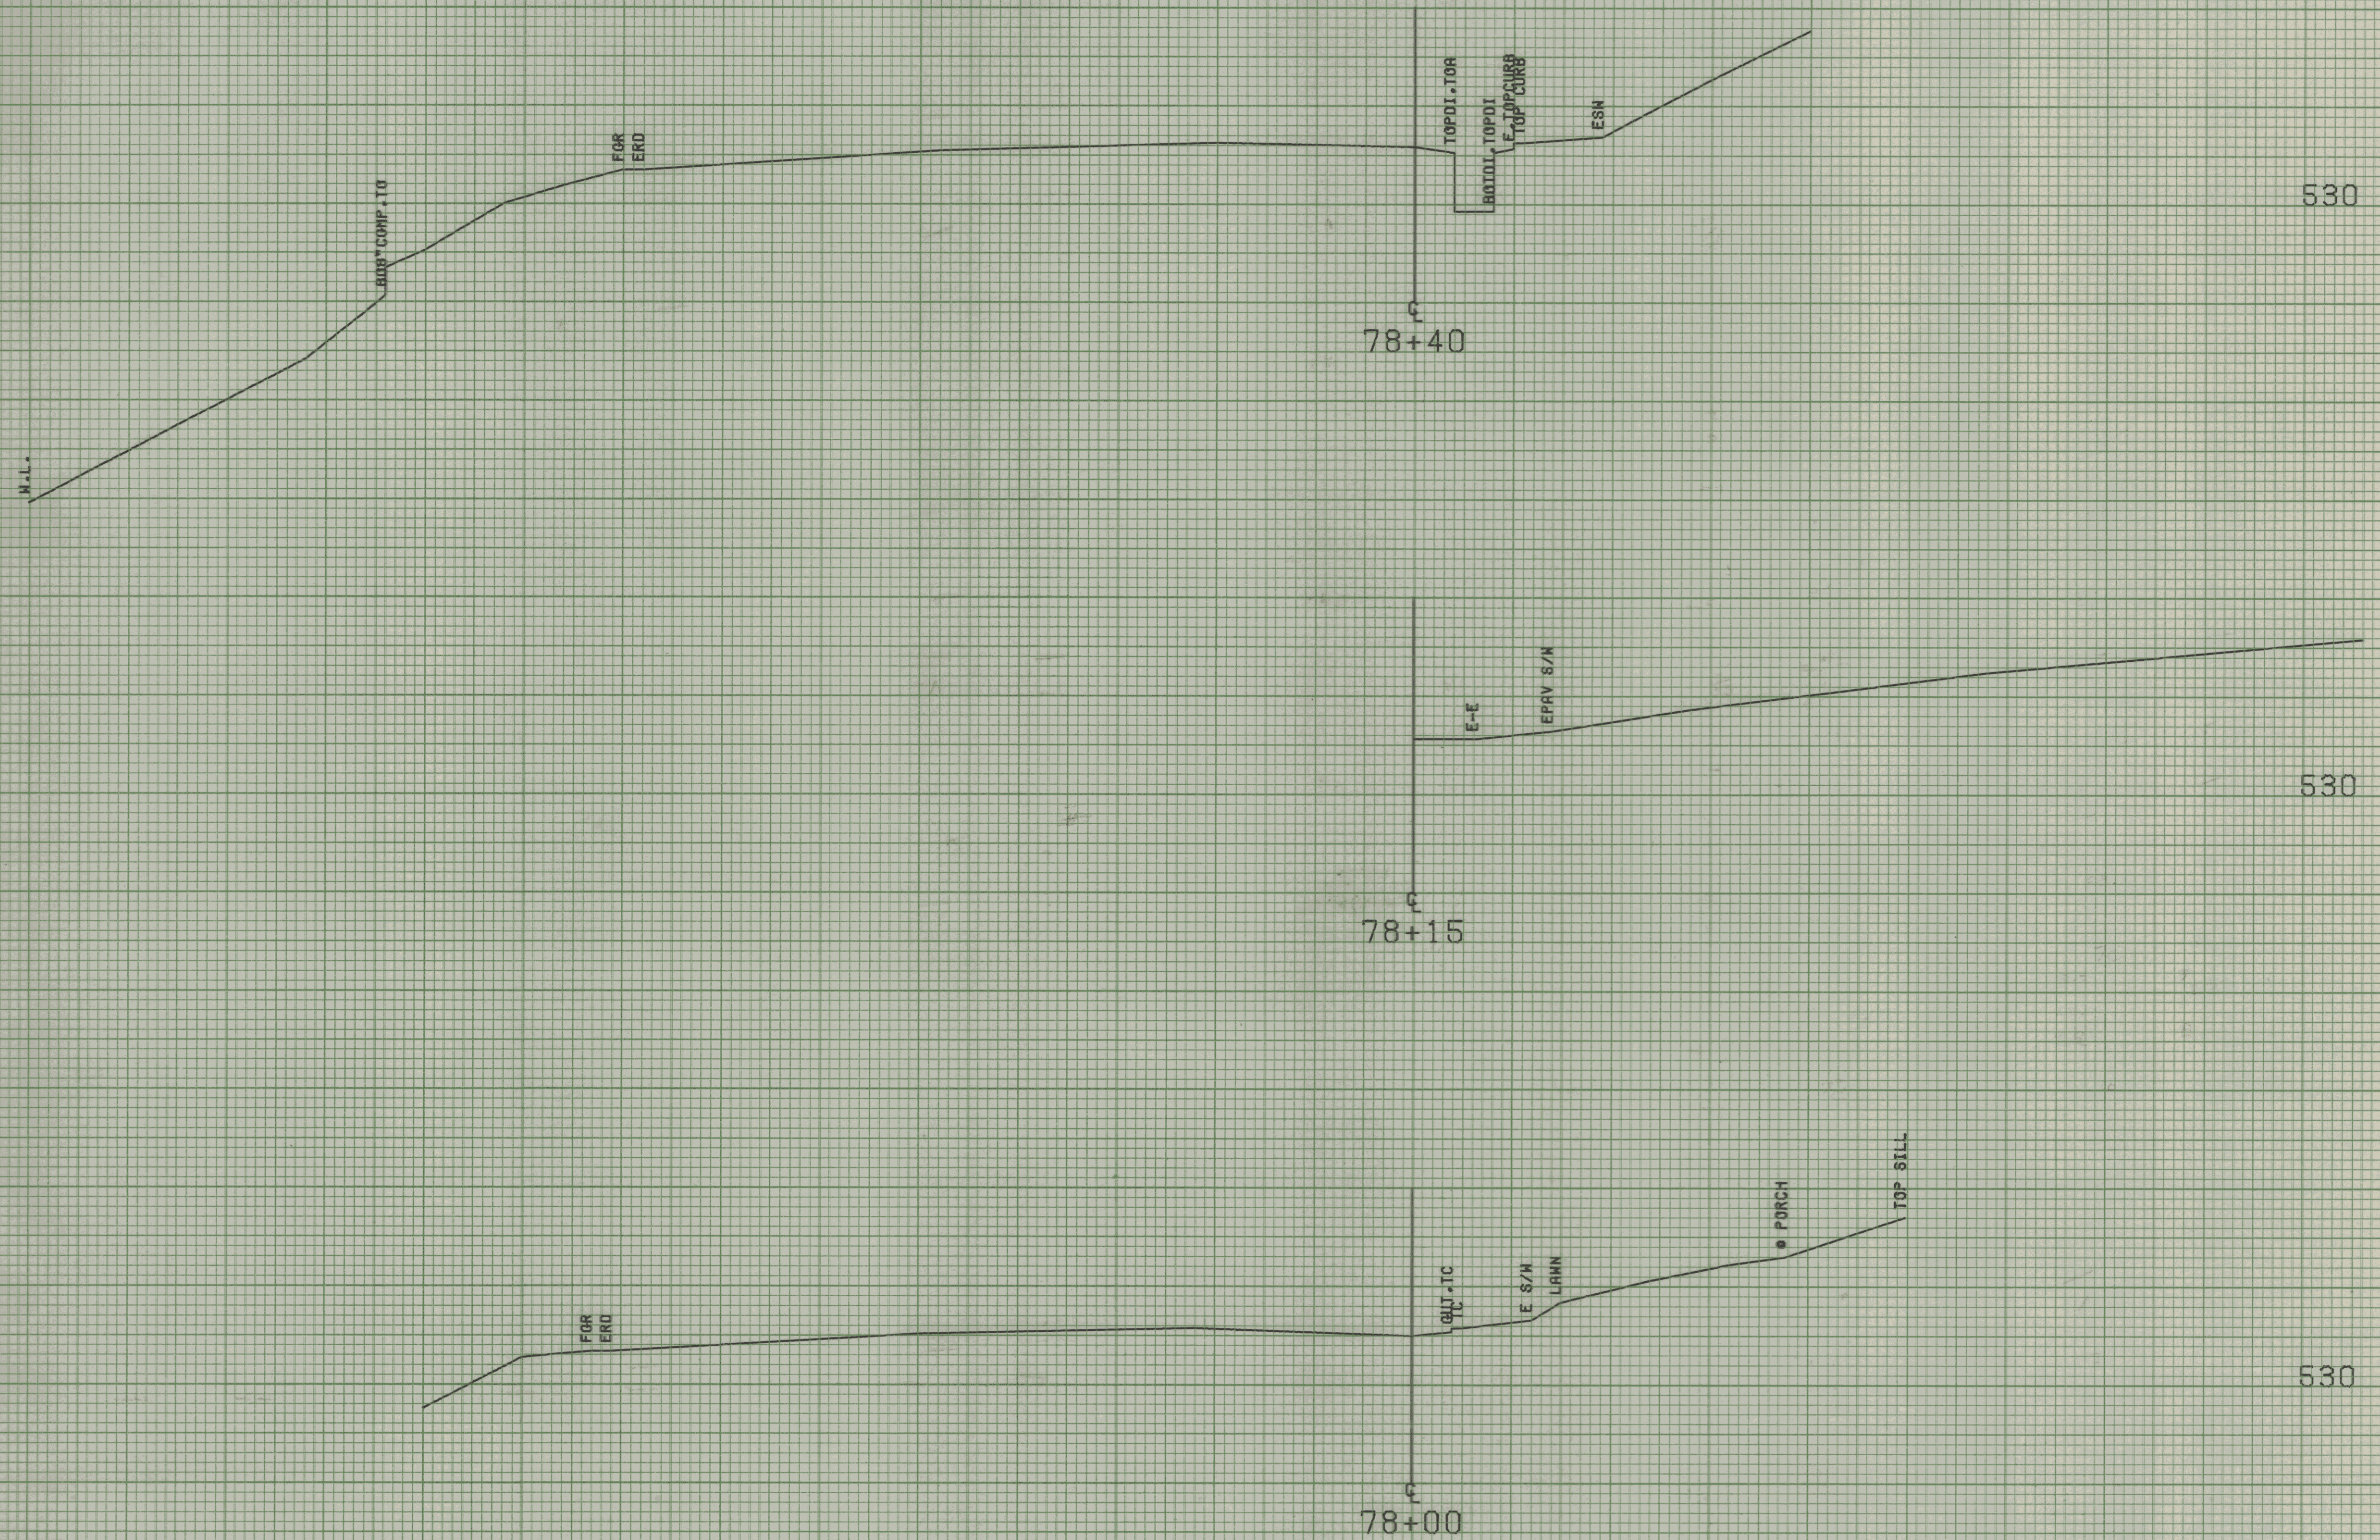

River St Traverse

FROM STA.	78+00	TO STA.	78+40
PROJECT NAME	MONTPELIER		
NO.	M6400(7)	PLOTTED 08/07/85	
SURVEYED BY	KASTNER-MOREAU JUNE 1985		
SHEET	244	OF	335 SHEETS

SCALE 5 FEET