


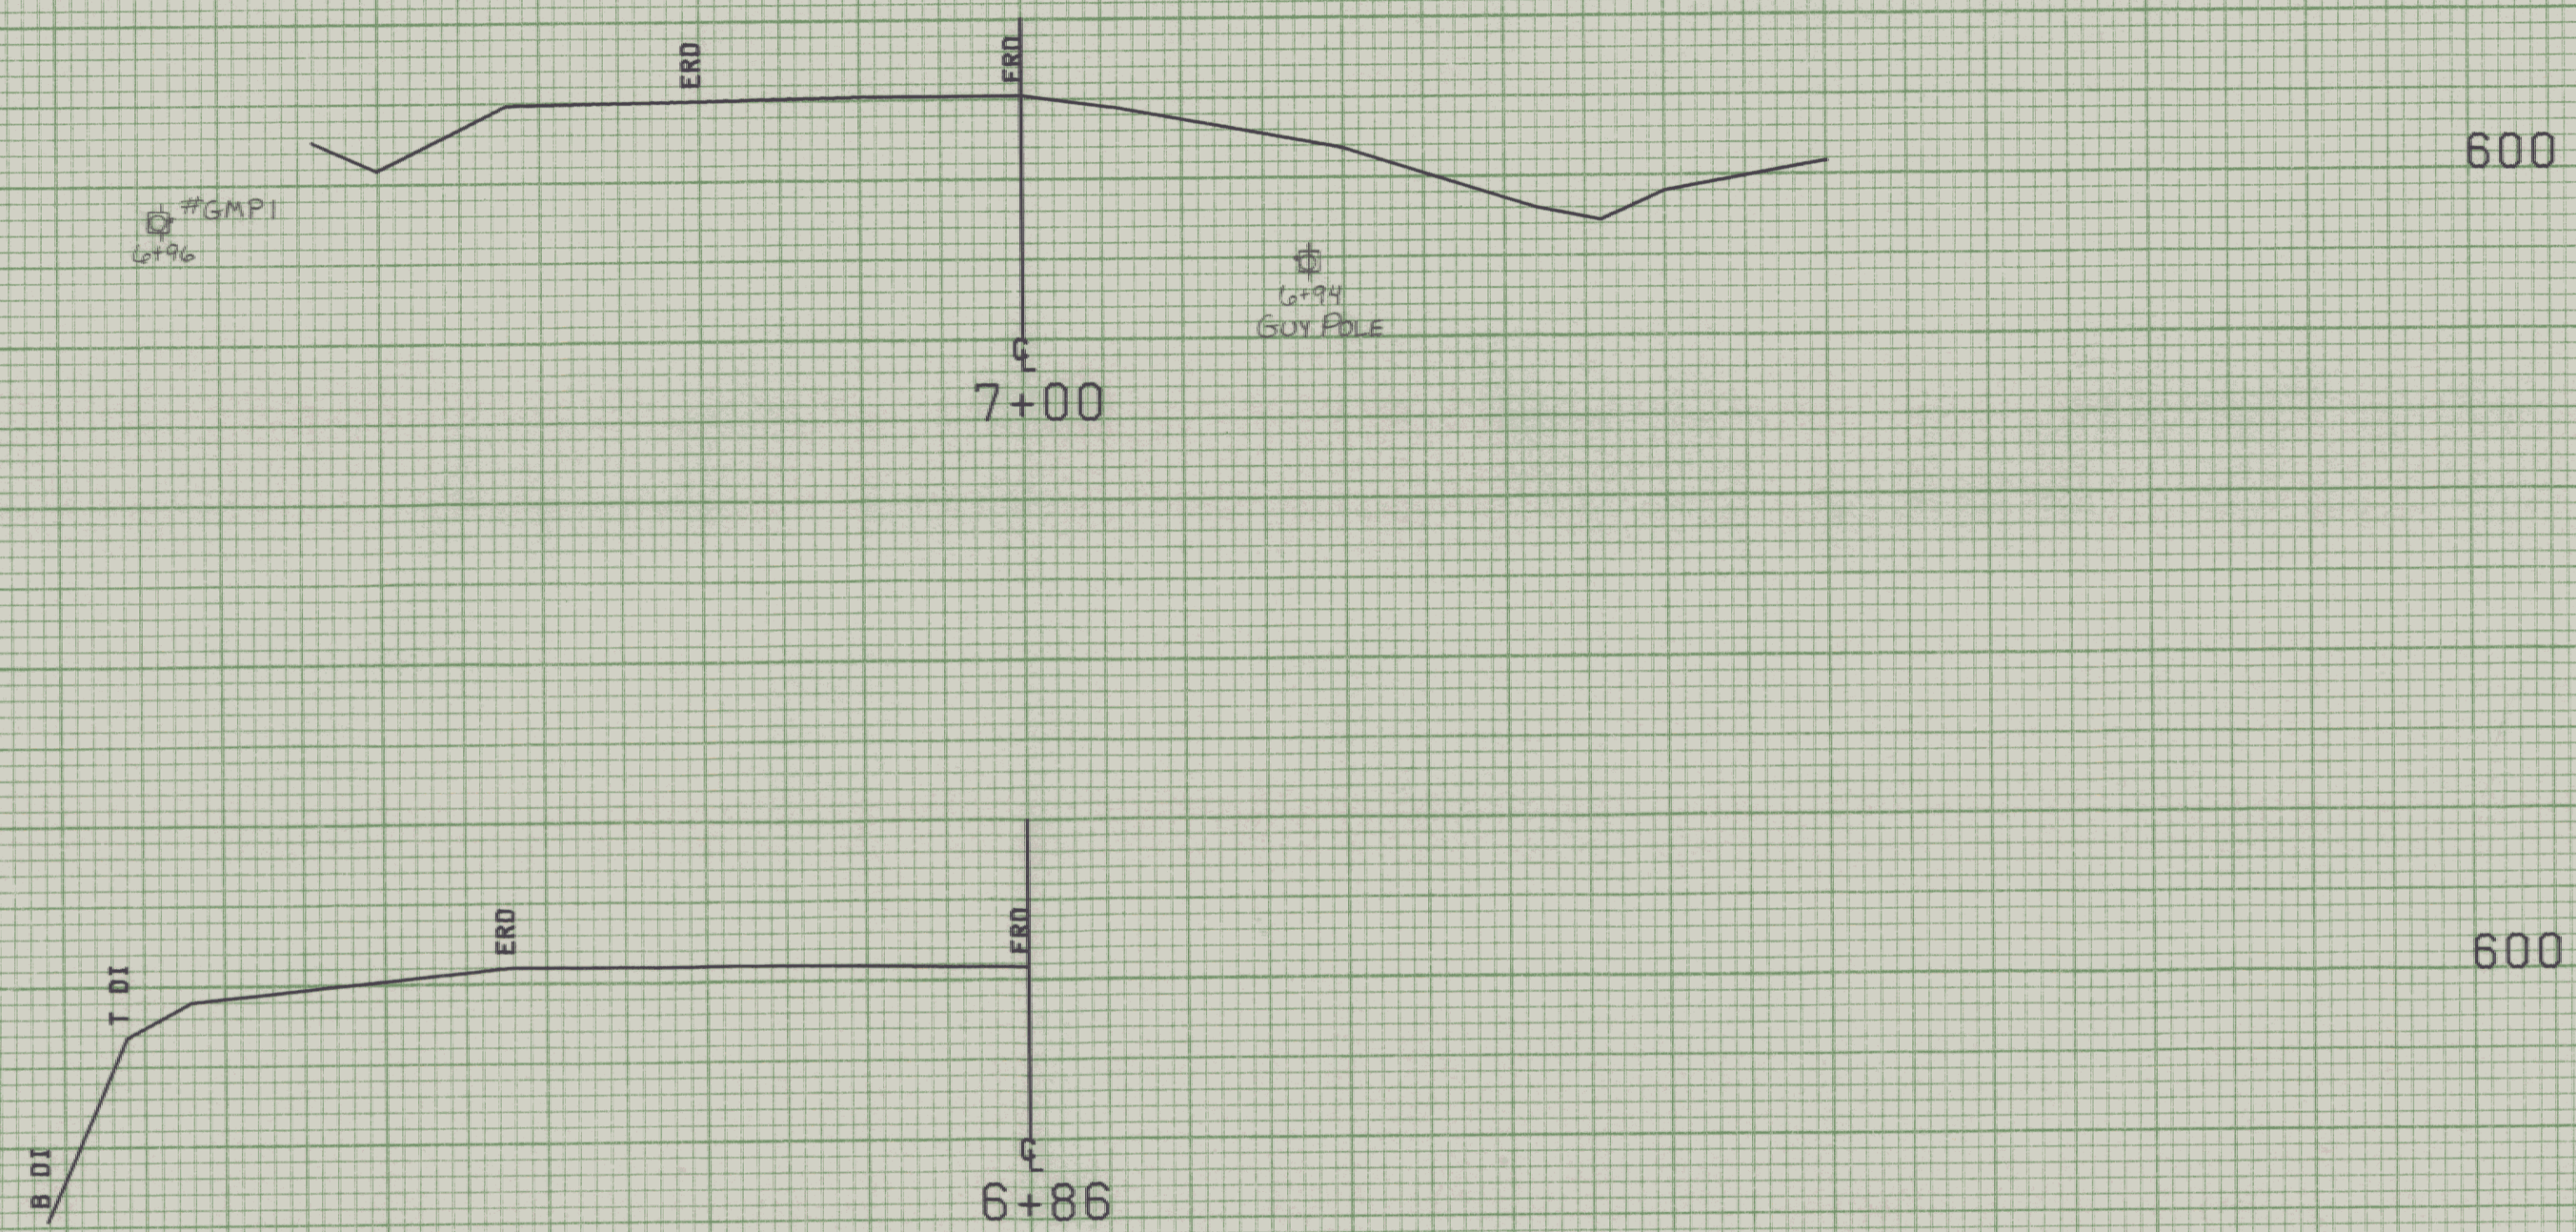

FROM STA. 6+86	TO STA. 7+00
PROJECT NAME	MONTPELIER OCTOBER
NO.	M6400(7)
SURVEYED BY	KASTNER-MOREAU JUNE 1985
SHEET 251 OF 335	SHEETS

SCALE 5 FEET