


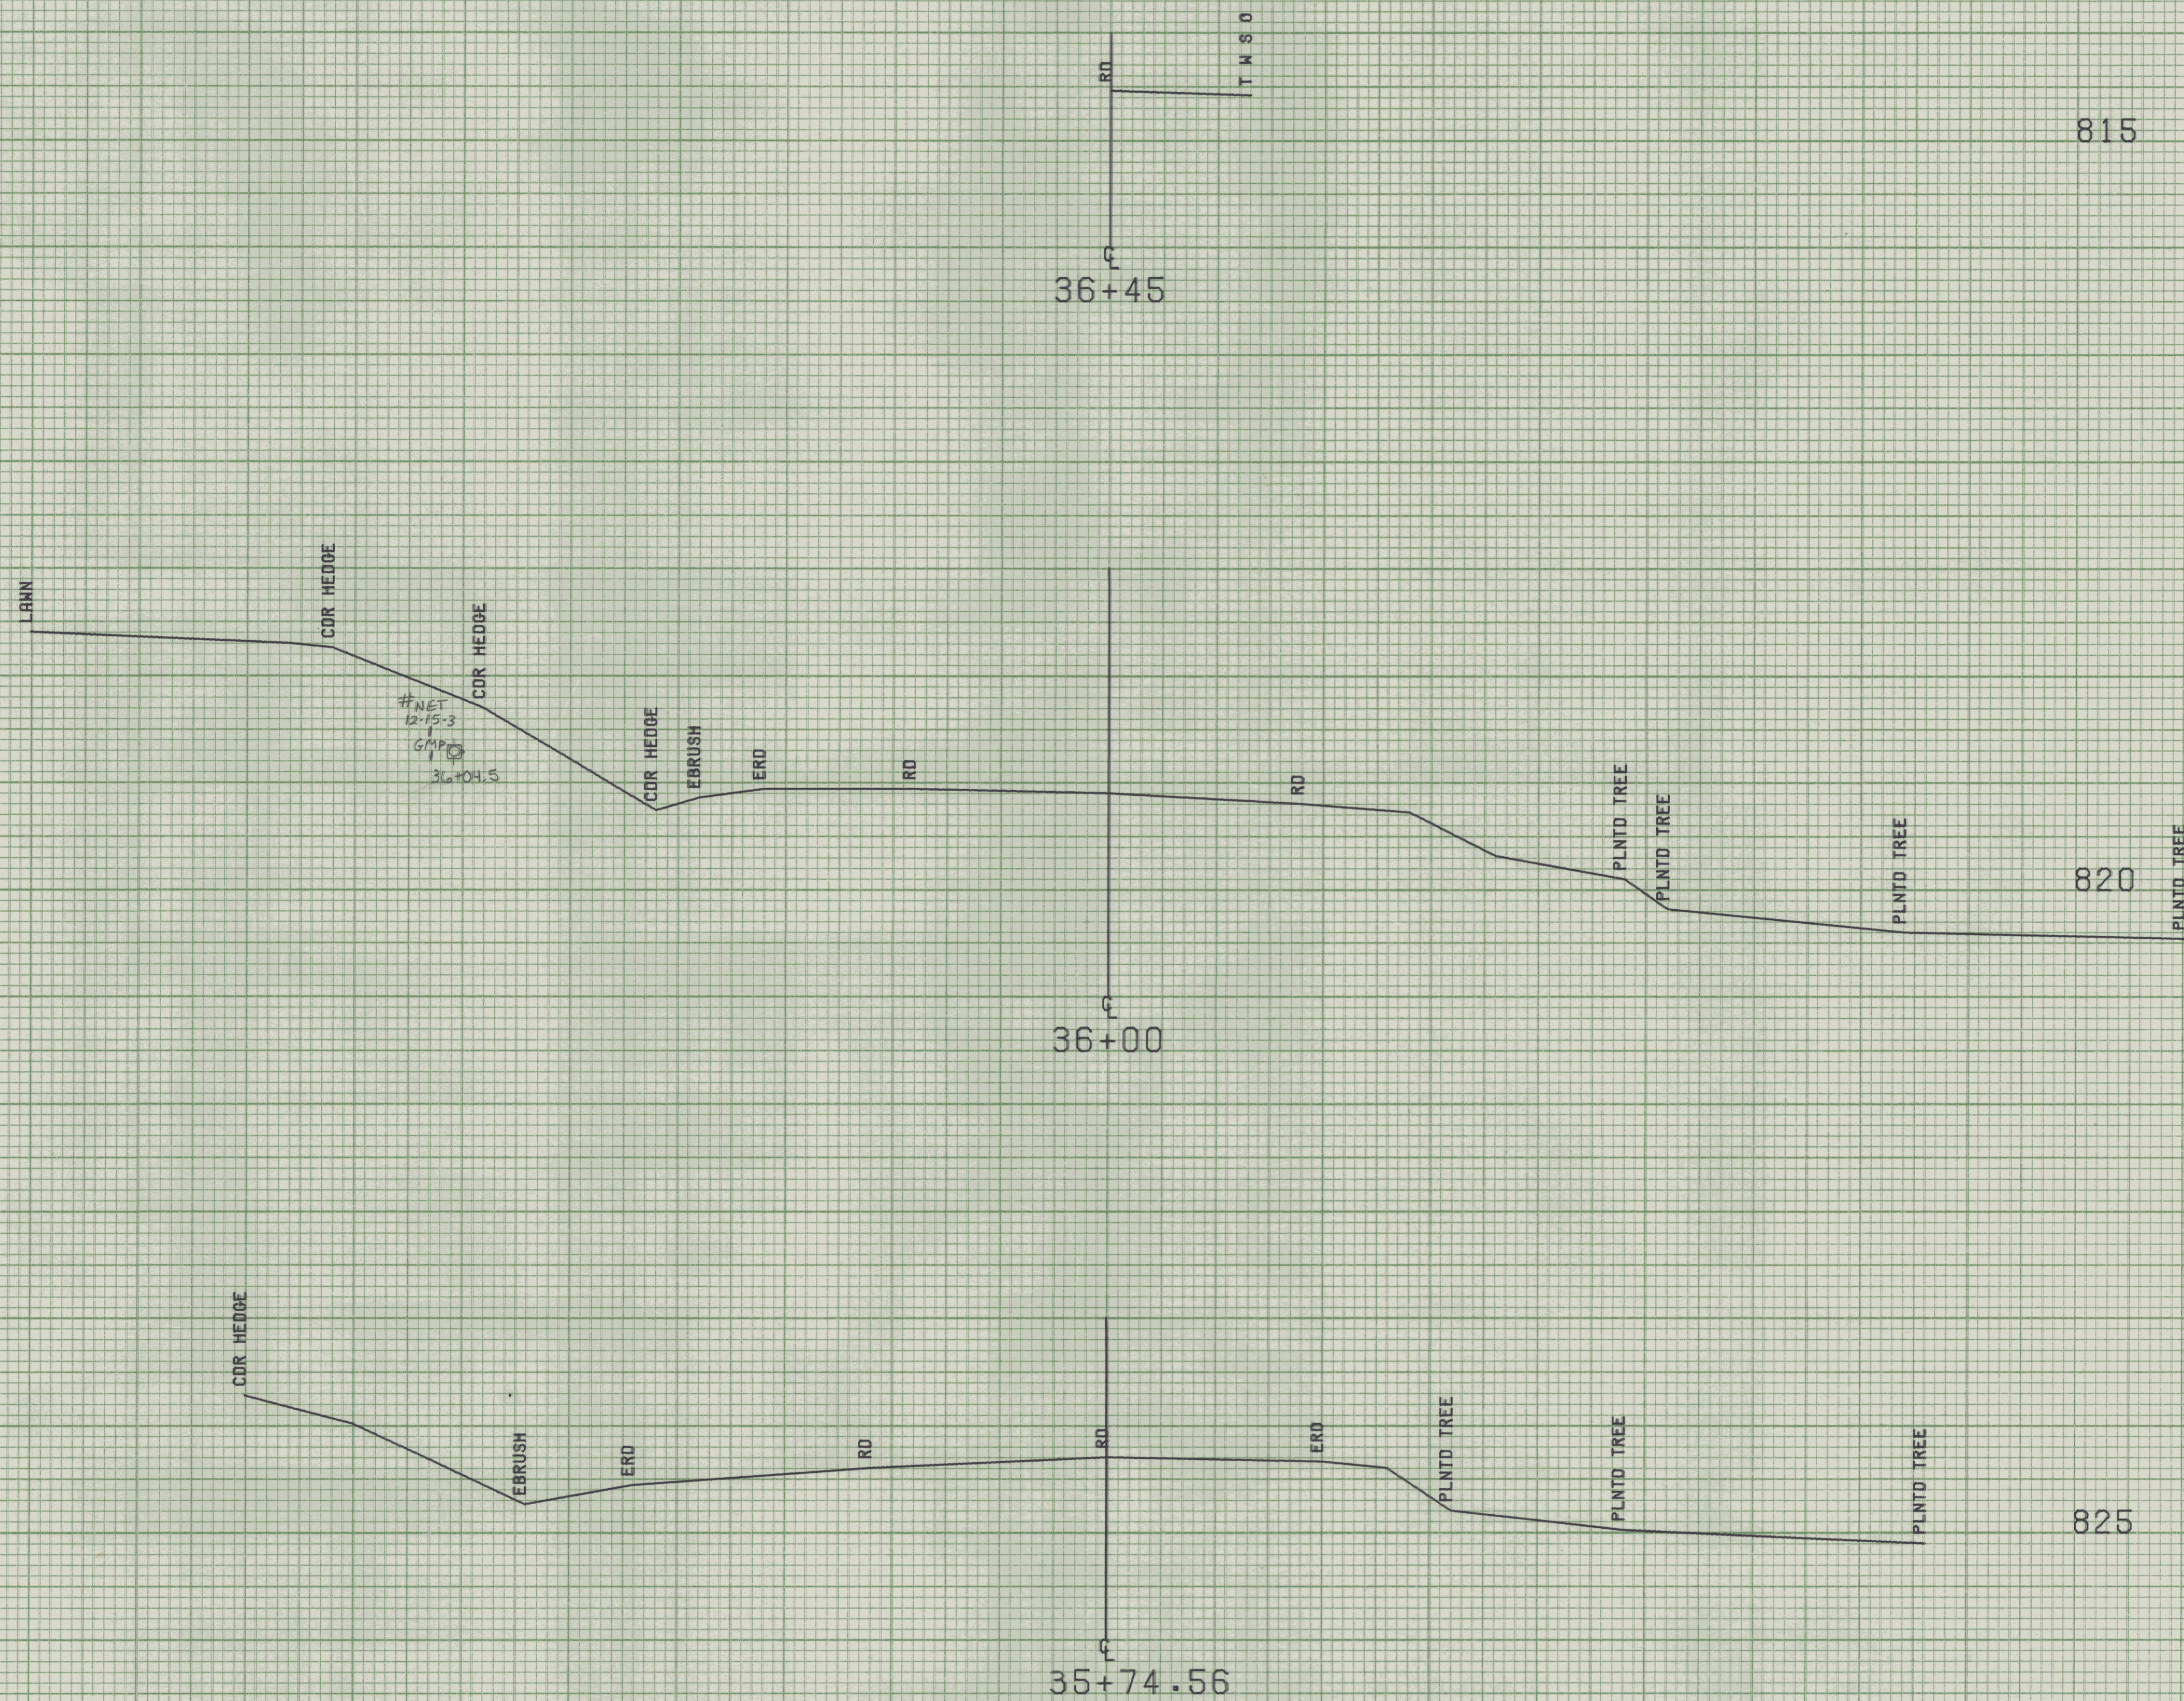

FROM STA. 35+74.56 TO STA. 36+45
 PROJECT NAME MONTPELIER HEBERT
 NO. M6400(7) P. OTTED 08/05/86
 SURVEYED BY JASTIER-MOREAU JULY 1985
 SHEET 214 OF 335 SHEETS

SCALE 5 FEET