

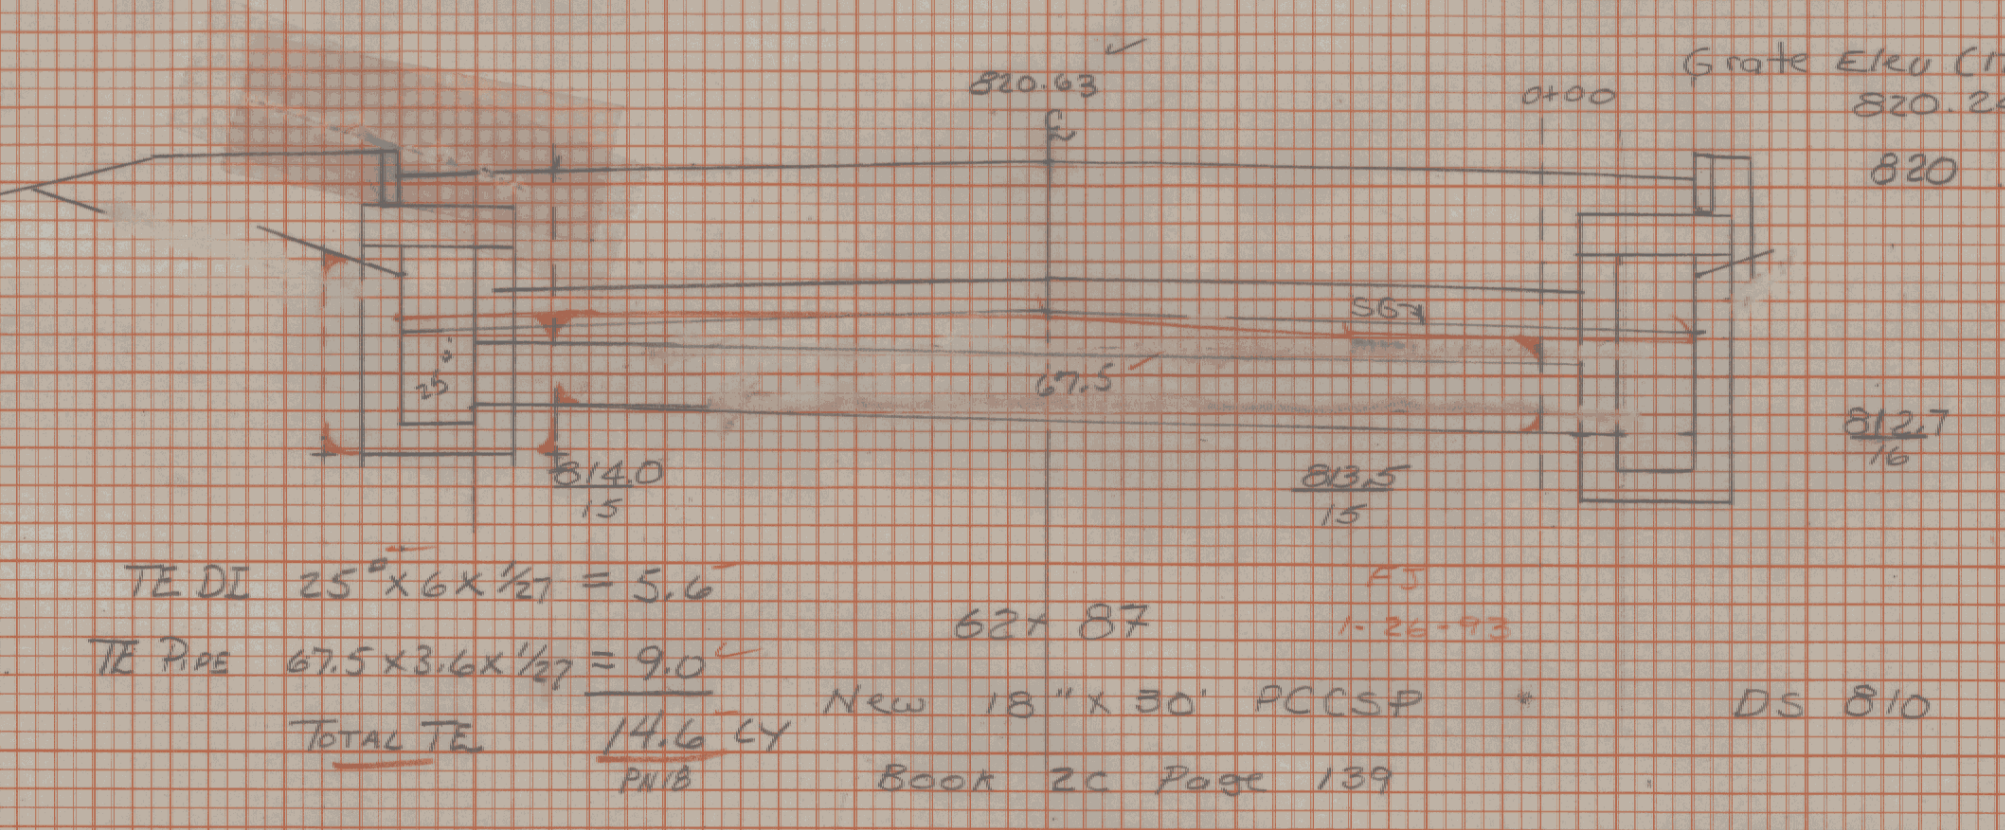


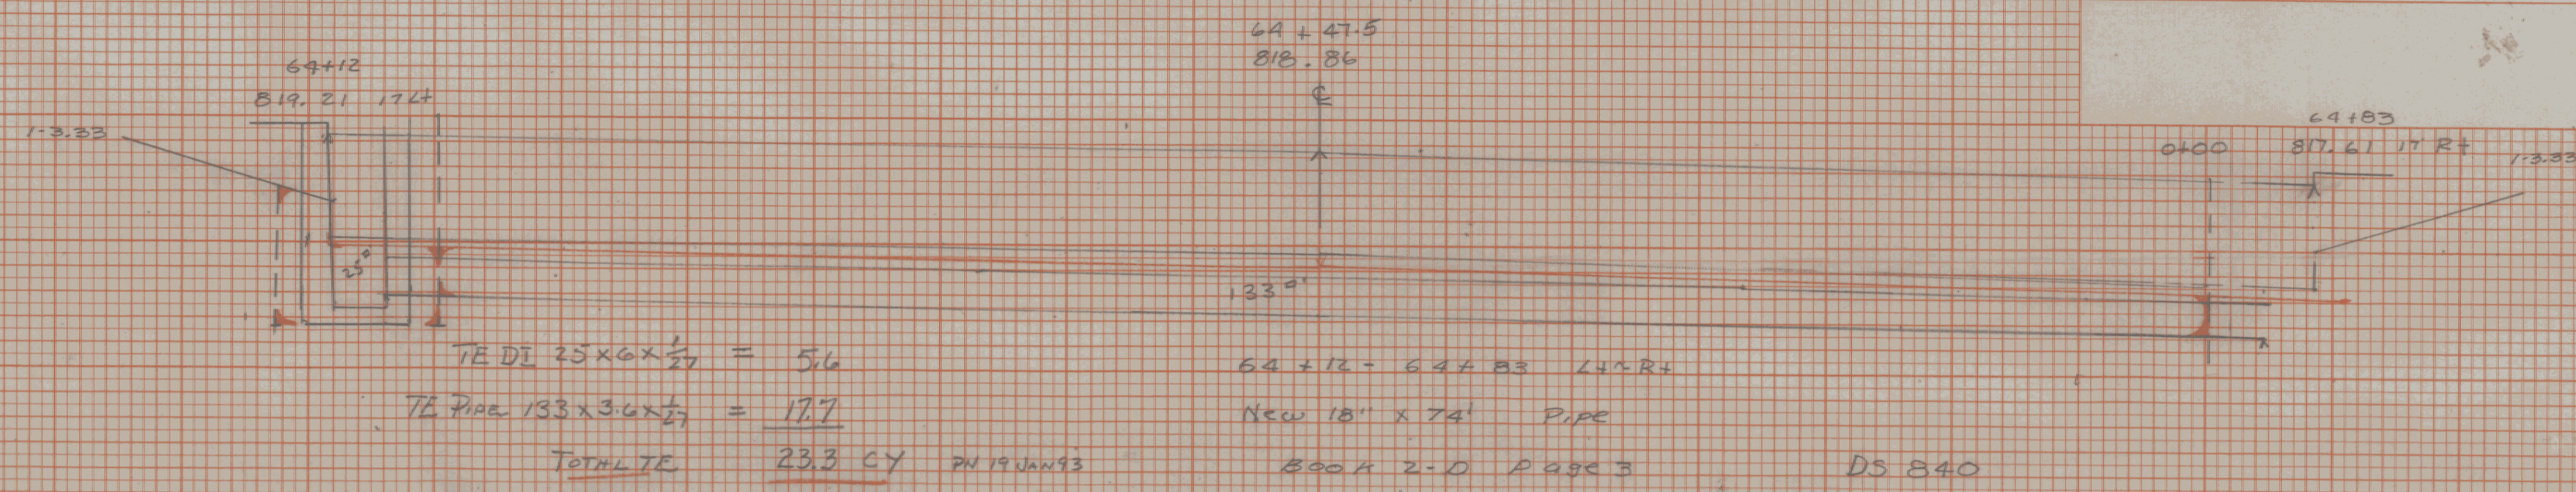


0+00	9.90	4.81
0+12	10.08	4.85
0+26	7.56	
0+26	20.90	
0+30	19.80	2.98
0+30	28.80	
0+32	33.60	2.31

FS 11-04-92
14.35 CY
FS 11-04-92

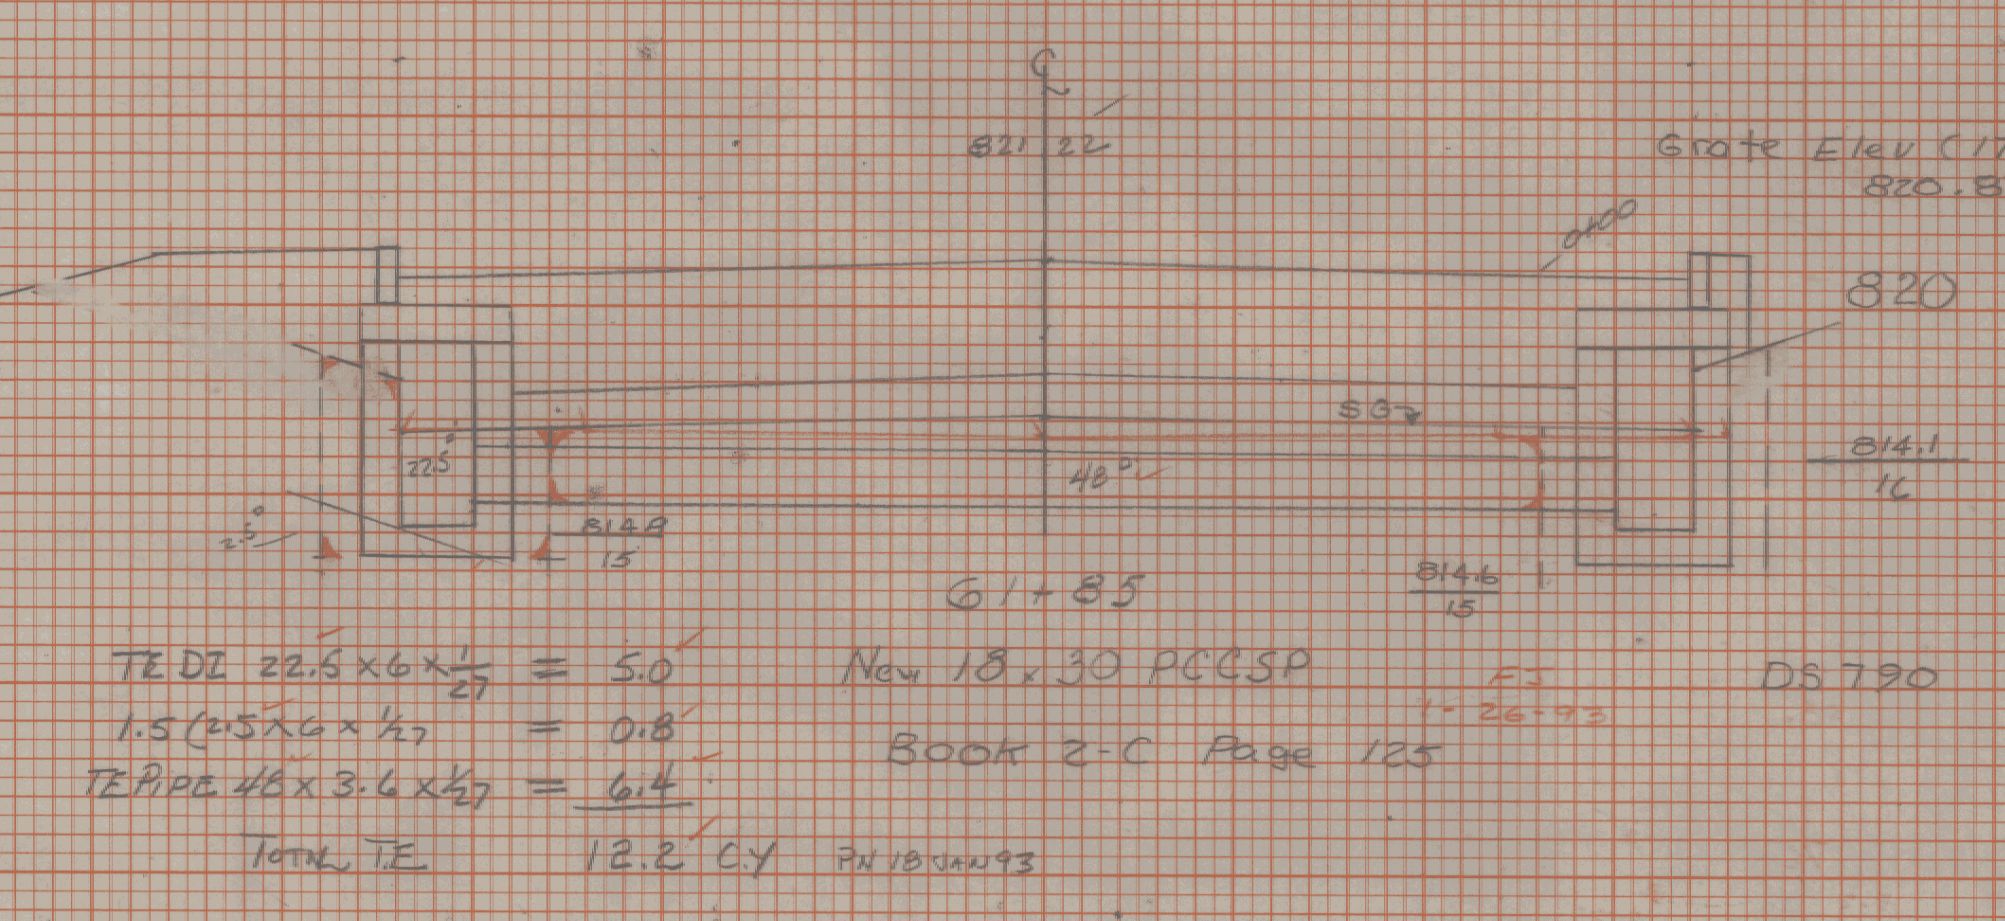


0+00	7.74	3.90
0+12	8.46	3.81
0+26	7.38	
0+26	21.30	
0+30	17.80	3.04
0+30	27.90	
0+32	33.15	2.26

FS 11-04-92
13.01 CY
FS 11-04-92

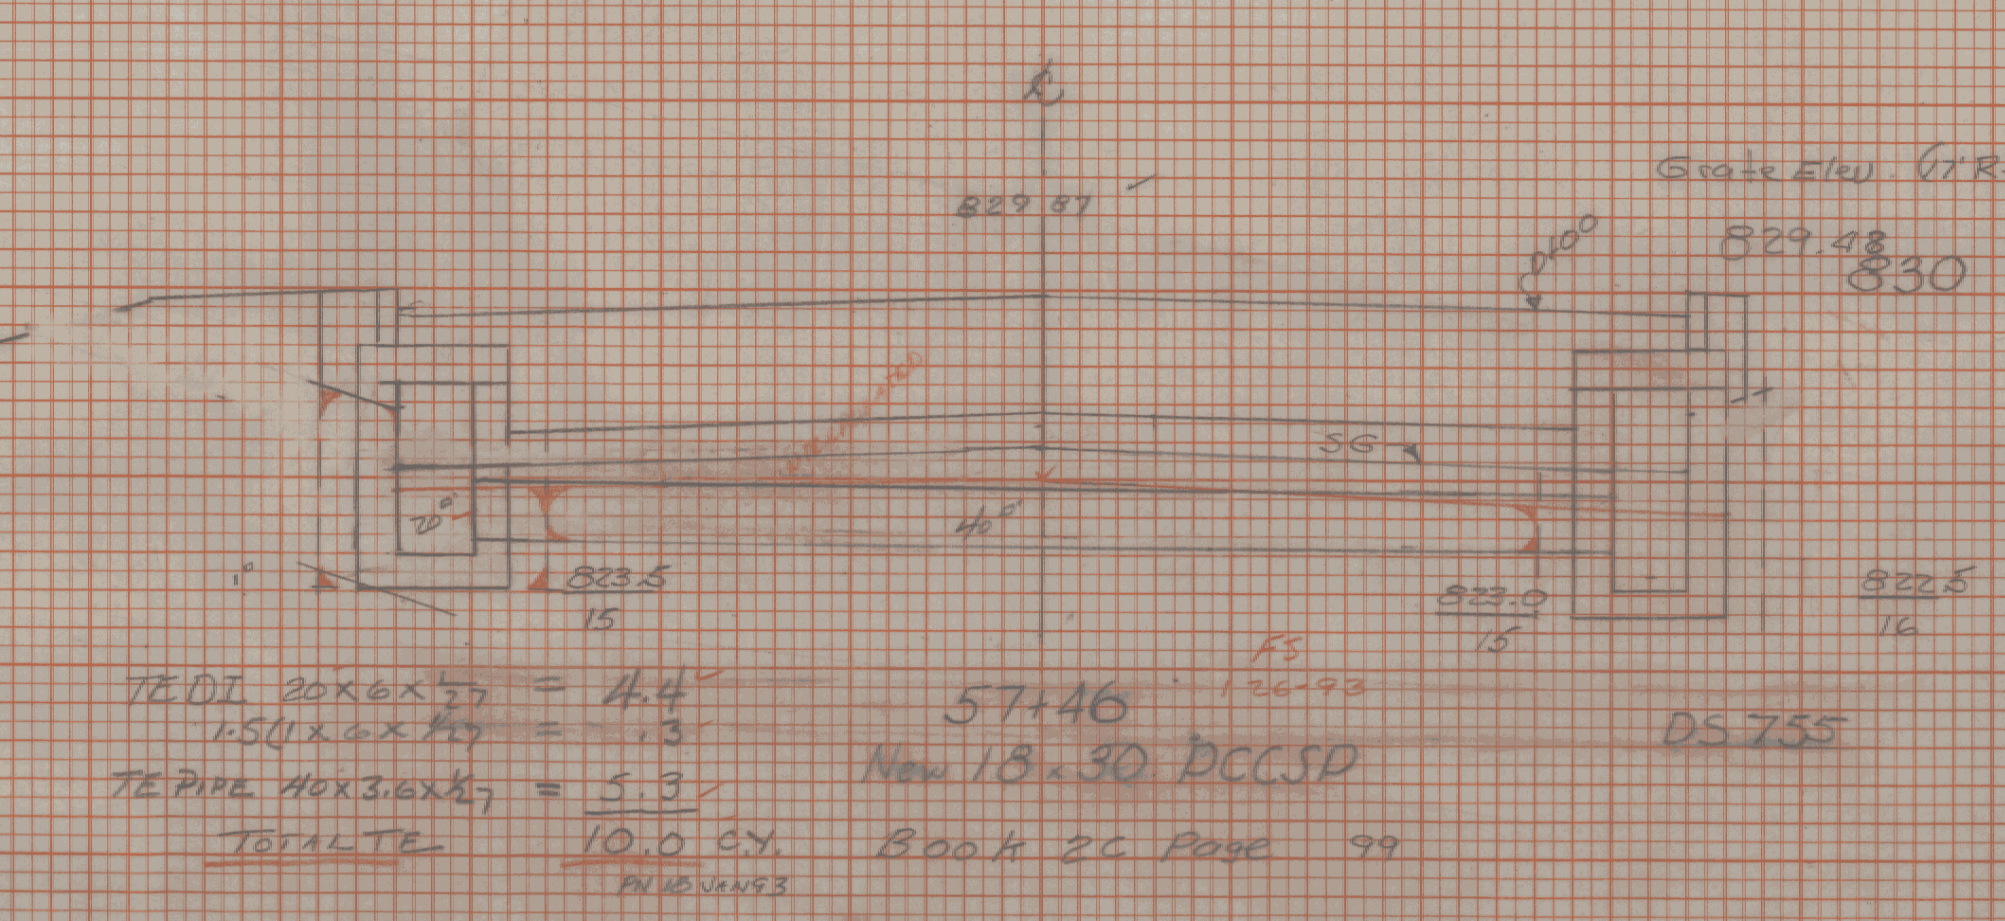


0+00	7.74	4.12
0+12	9.36	5.11
0+26	11.88	
0+26	20.10	
0+30	19.80	2.96
0+30	28.80	
0+32	32.70	2.28
0+32	32.70	2.28
FS 11-04-92
14.47 CY
FS 11-04-92

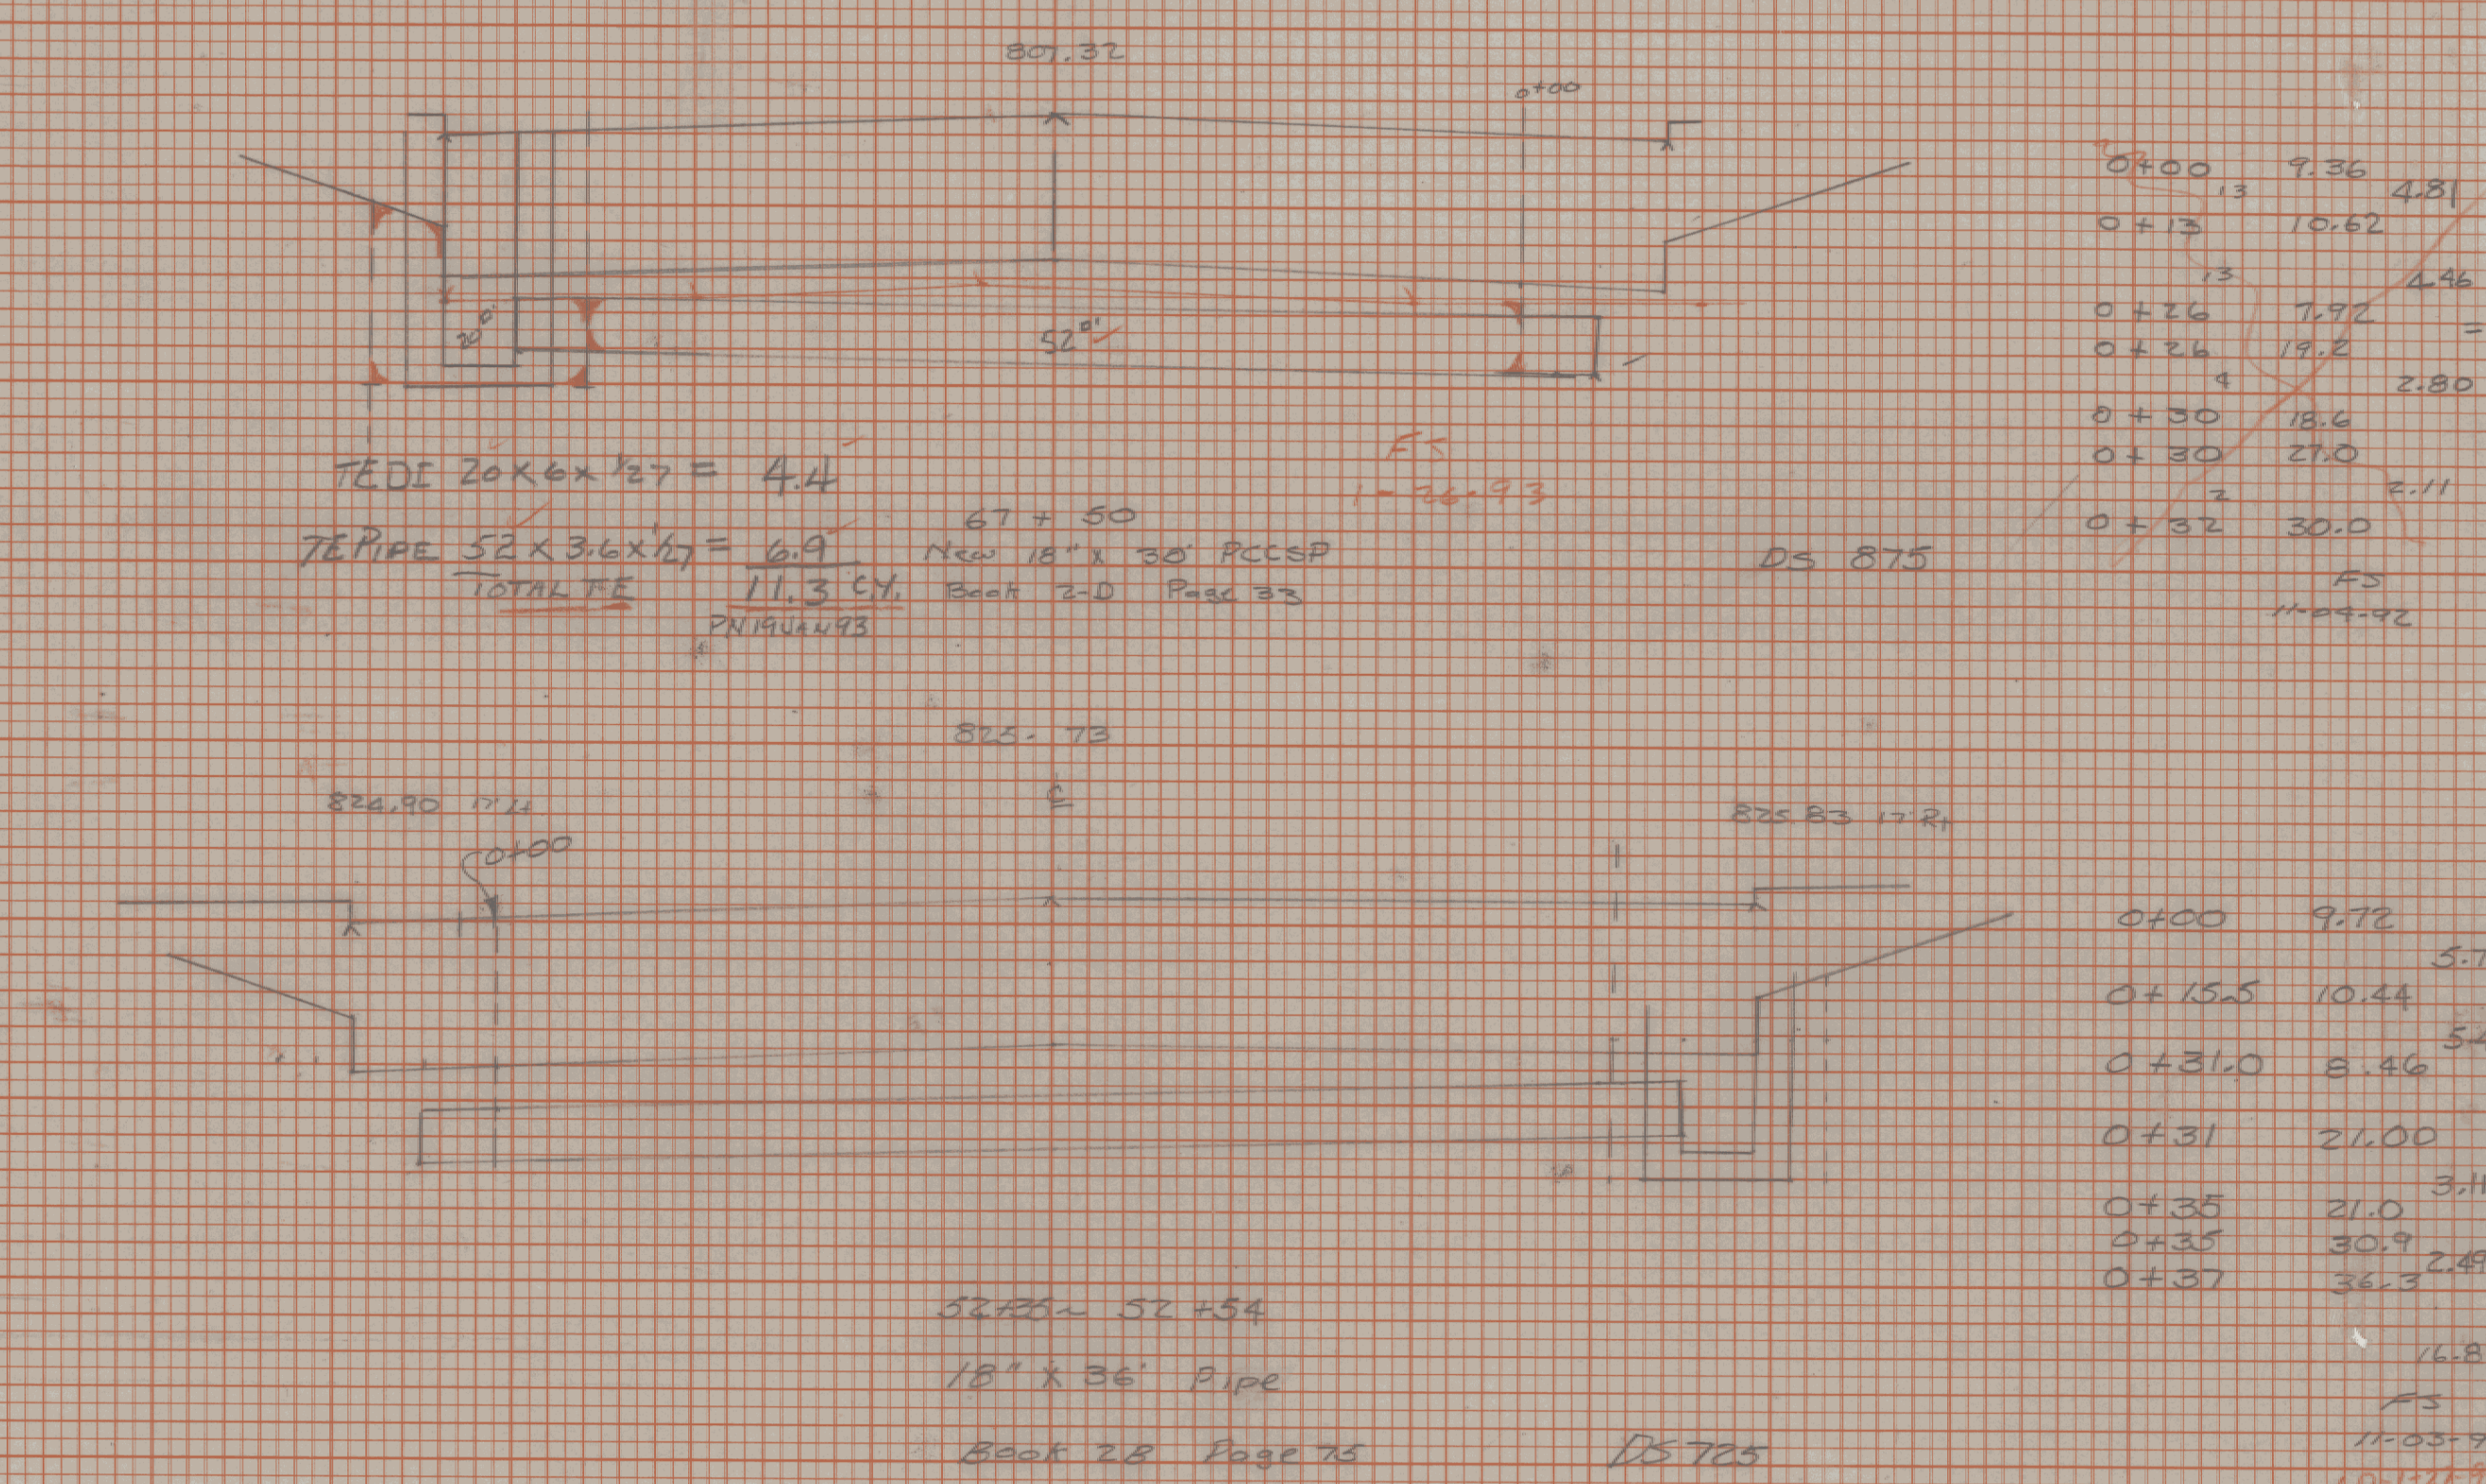

0+00	9.36	4.81
0+12	10.62	4.46
0+26	7.92	
0+26	19.80	
0+30	18.6	2.80
0+30	27.0	
0+32	30.0	2.11

FS 11-04-92
14.11 CY
FS 11-04-92

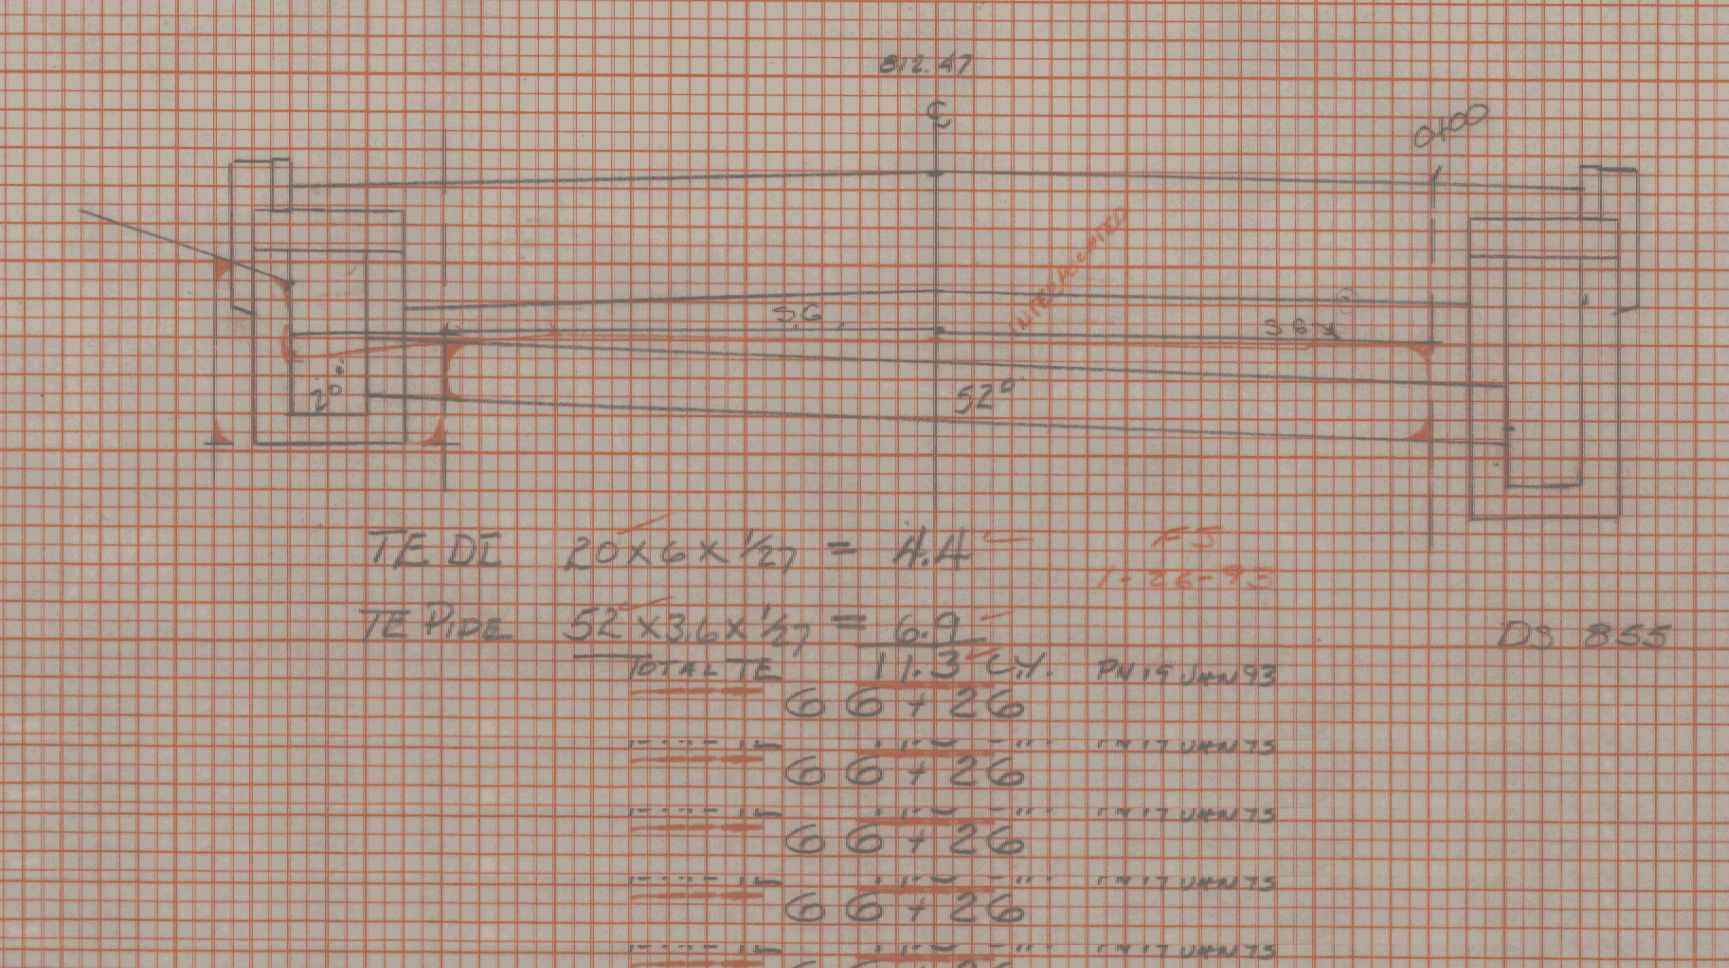

0+00	9.18	4.25
0+12	8.46	3.64
0+26	6.66	
0+26	18.00	
0+30	18.00	3.67
0+30	27.0	
0+32	30.0	2.11

FS 11-04-92
10.11 CY
FS 11-04-92

MONTPELIER
MEGCM 6400(7)
11/11/11 07:11 11
11/11/11 07:11 11
