


ORIGINAL SURVEY NOTE BOOK No. _____	SURVEYED	BY	DATE
	PLOTTED		
	TEMPLATE		
	AREAS		
	AREAS CHECKED		

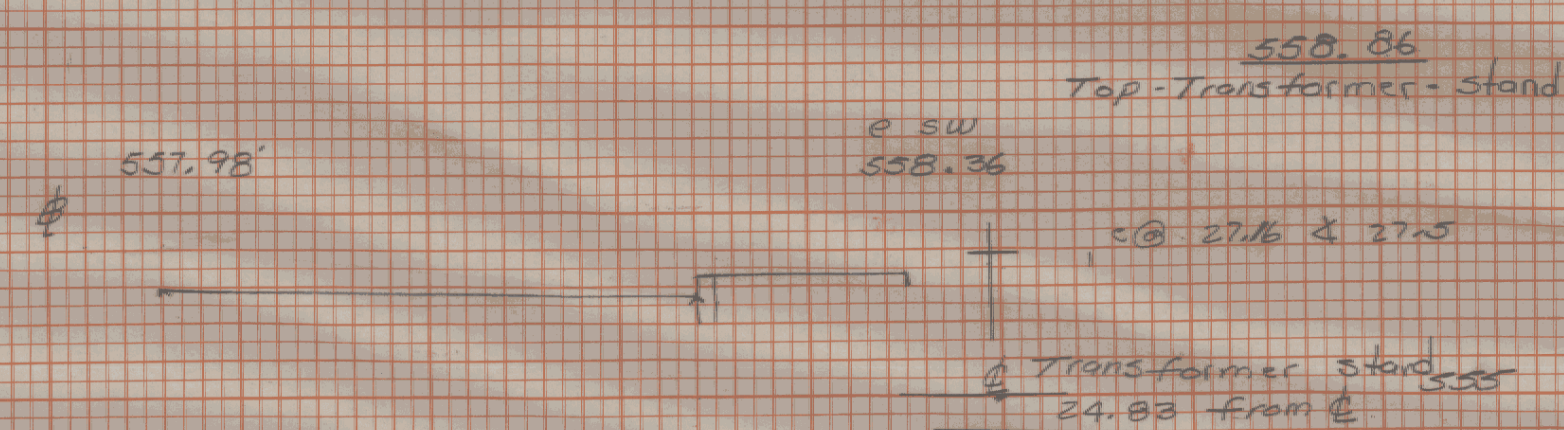

Montpelier MEGCM6400 (G)
Sheet Gm P#1 & only