


ORIGINAL SURVEY	BY		DATE
SURVEYED			
PLOTTED			
TEMPLATE			
AREAS			

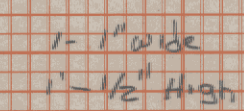

Montpelier