


|                                     |      |    |        |        |        |        |        |        |        |        |        |        |
|-------------------------------------|------|----|--------|--------|--------|--------|--------|--------|--------|--------|--------|--------|
| FINAL<br>SURVEY<br>NOTE BOOK<br>No. | DATE | BY | NO. 2  | NO. 1  | NO. 3  | NO. 4  | NO. 5  | NO. 6  | NO. 7  | NO. 8  | NO. 9  | NO. 10 |
|                                     | DATE | BY | NO. 11 | NO. 12 | NO. 13 | NO. 14 | NO. 15 | NO. 16 | NO. 17 | NO. 18 | NO. 19 | NO. 20 |

|                                        |      |    |        |        |        |        |        |        |        |        |        |        |
|----------------------------------------|------|----|--------|--------|--------|--------|--------|--------|--------|--------|--------|--------|
| ORIGINAL<br>SURVEY<br>NOTE BOOK<br>No. | DATE | BY | NO. 2  | NO. 1  | NO. 3  | NO. 4  | NO. 5  | NO. 6  | NO. 7  | NO. 8  | NO. 9  | NO. 10 |
|                                        | DATE | BY | NO. 11 | NO. 12 | NO. 13 | NO. 14 | NO. 15 | NO. 16 | NO. 17 | NO. 18 | NO. 19 | NO. 20 |

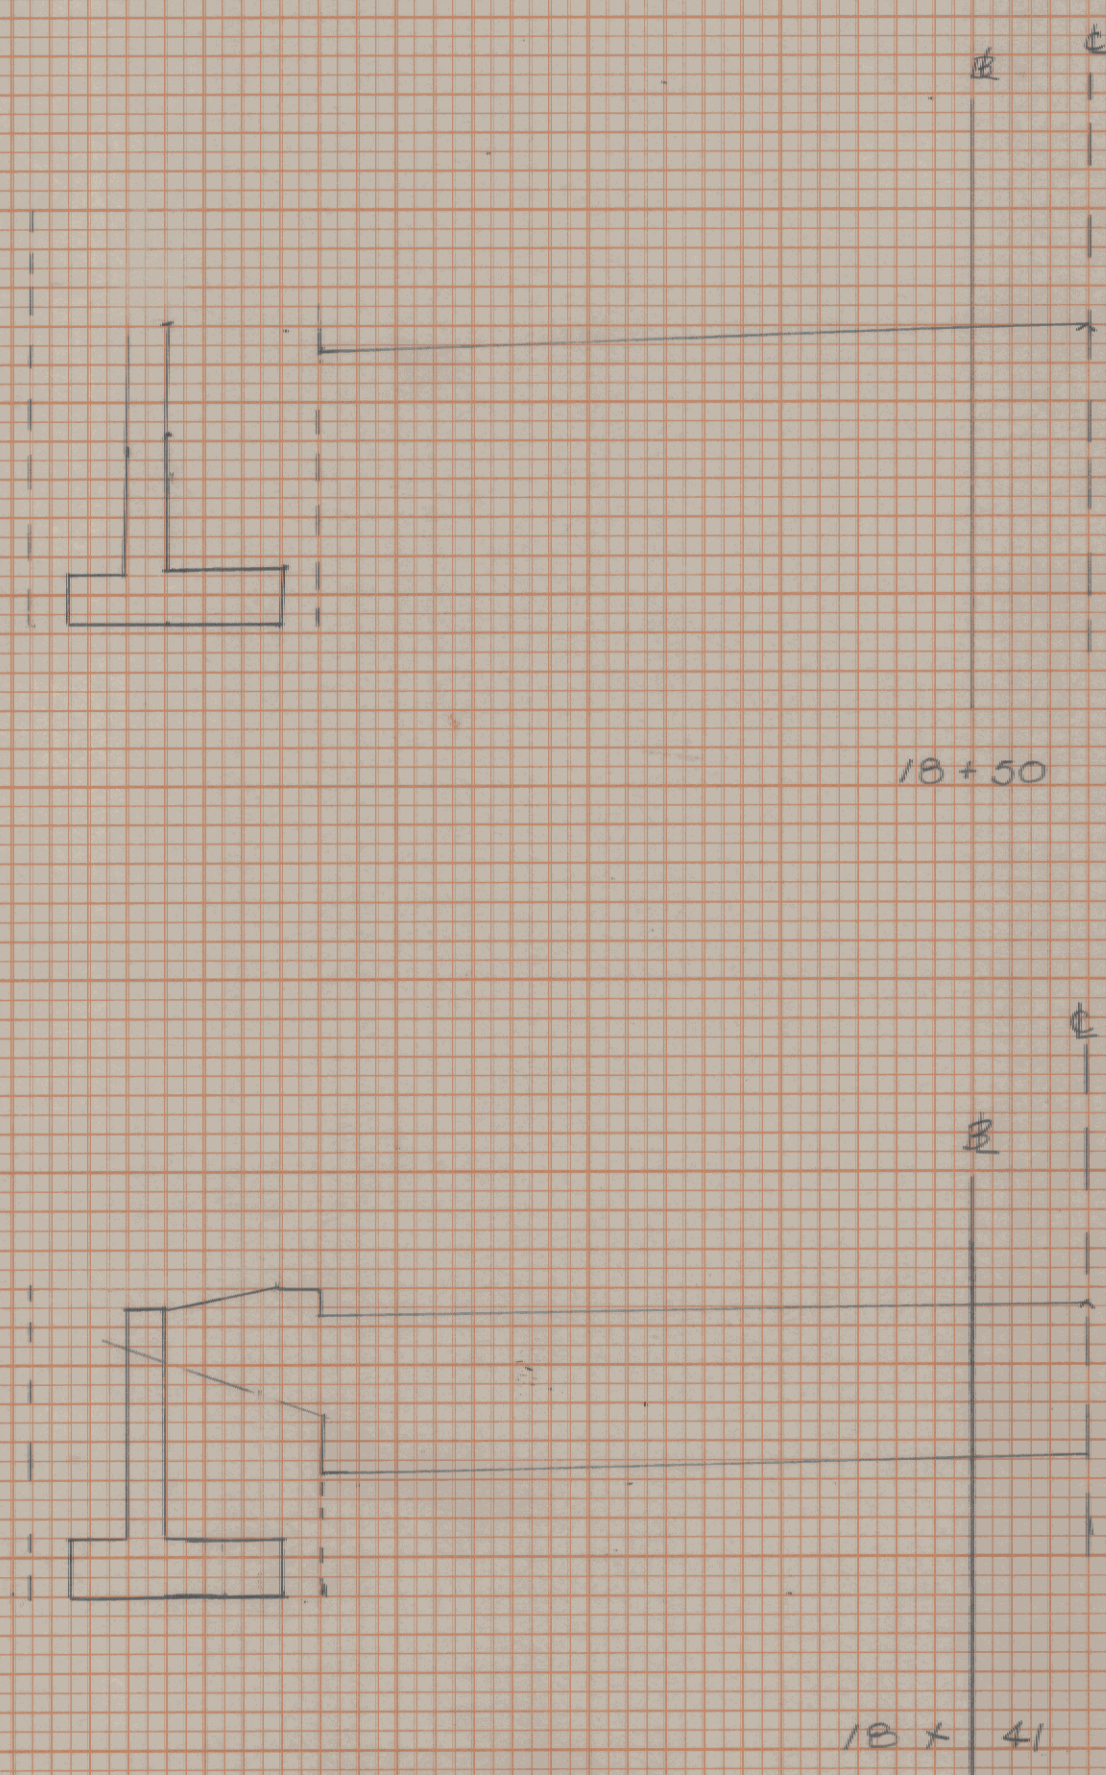

570

570

570

Montpelier ME6CM6400G1  
Structure sections  
Wall #5