


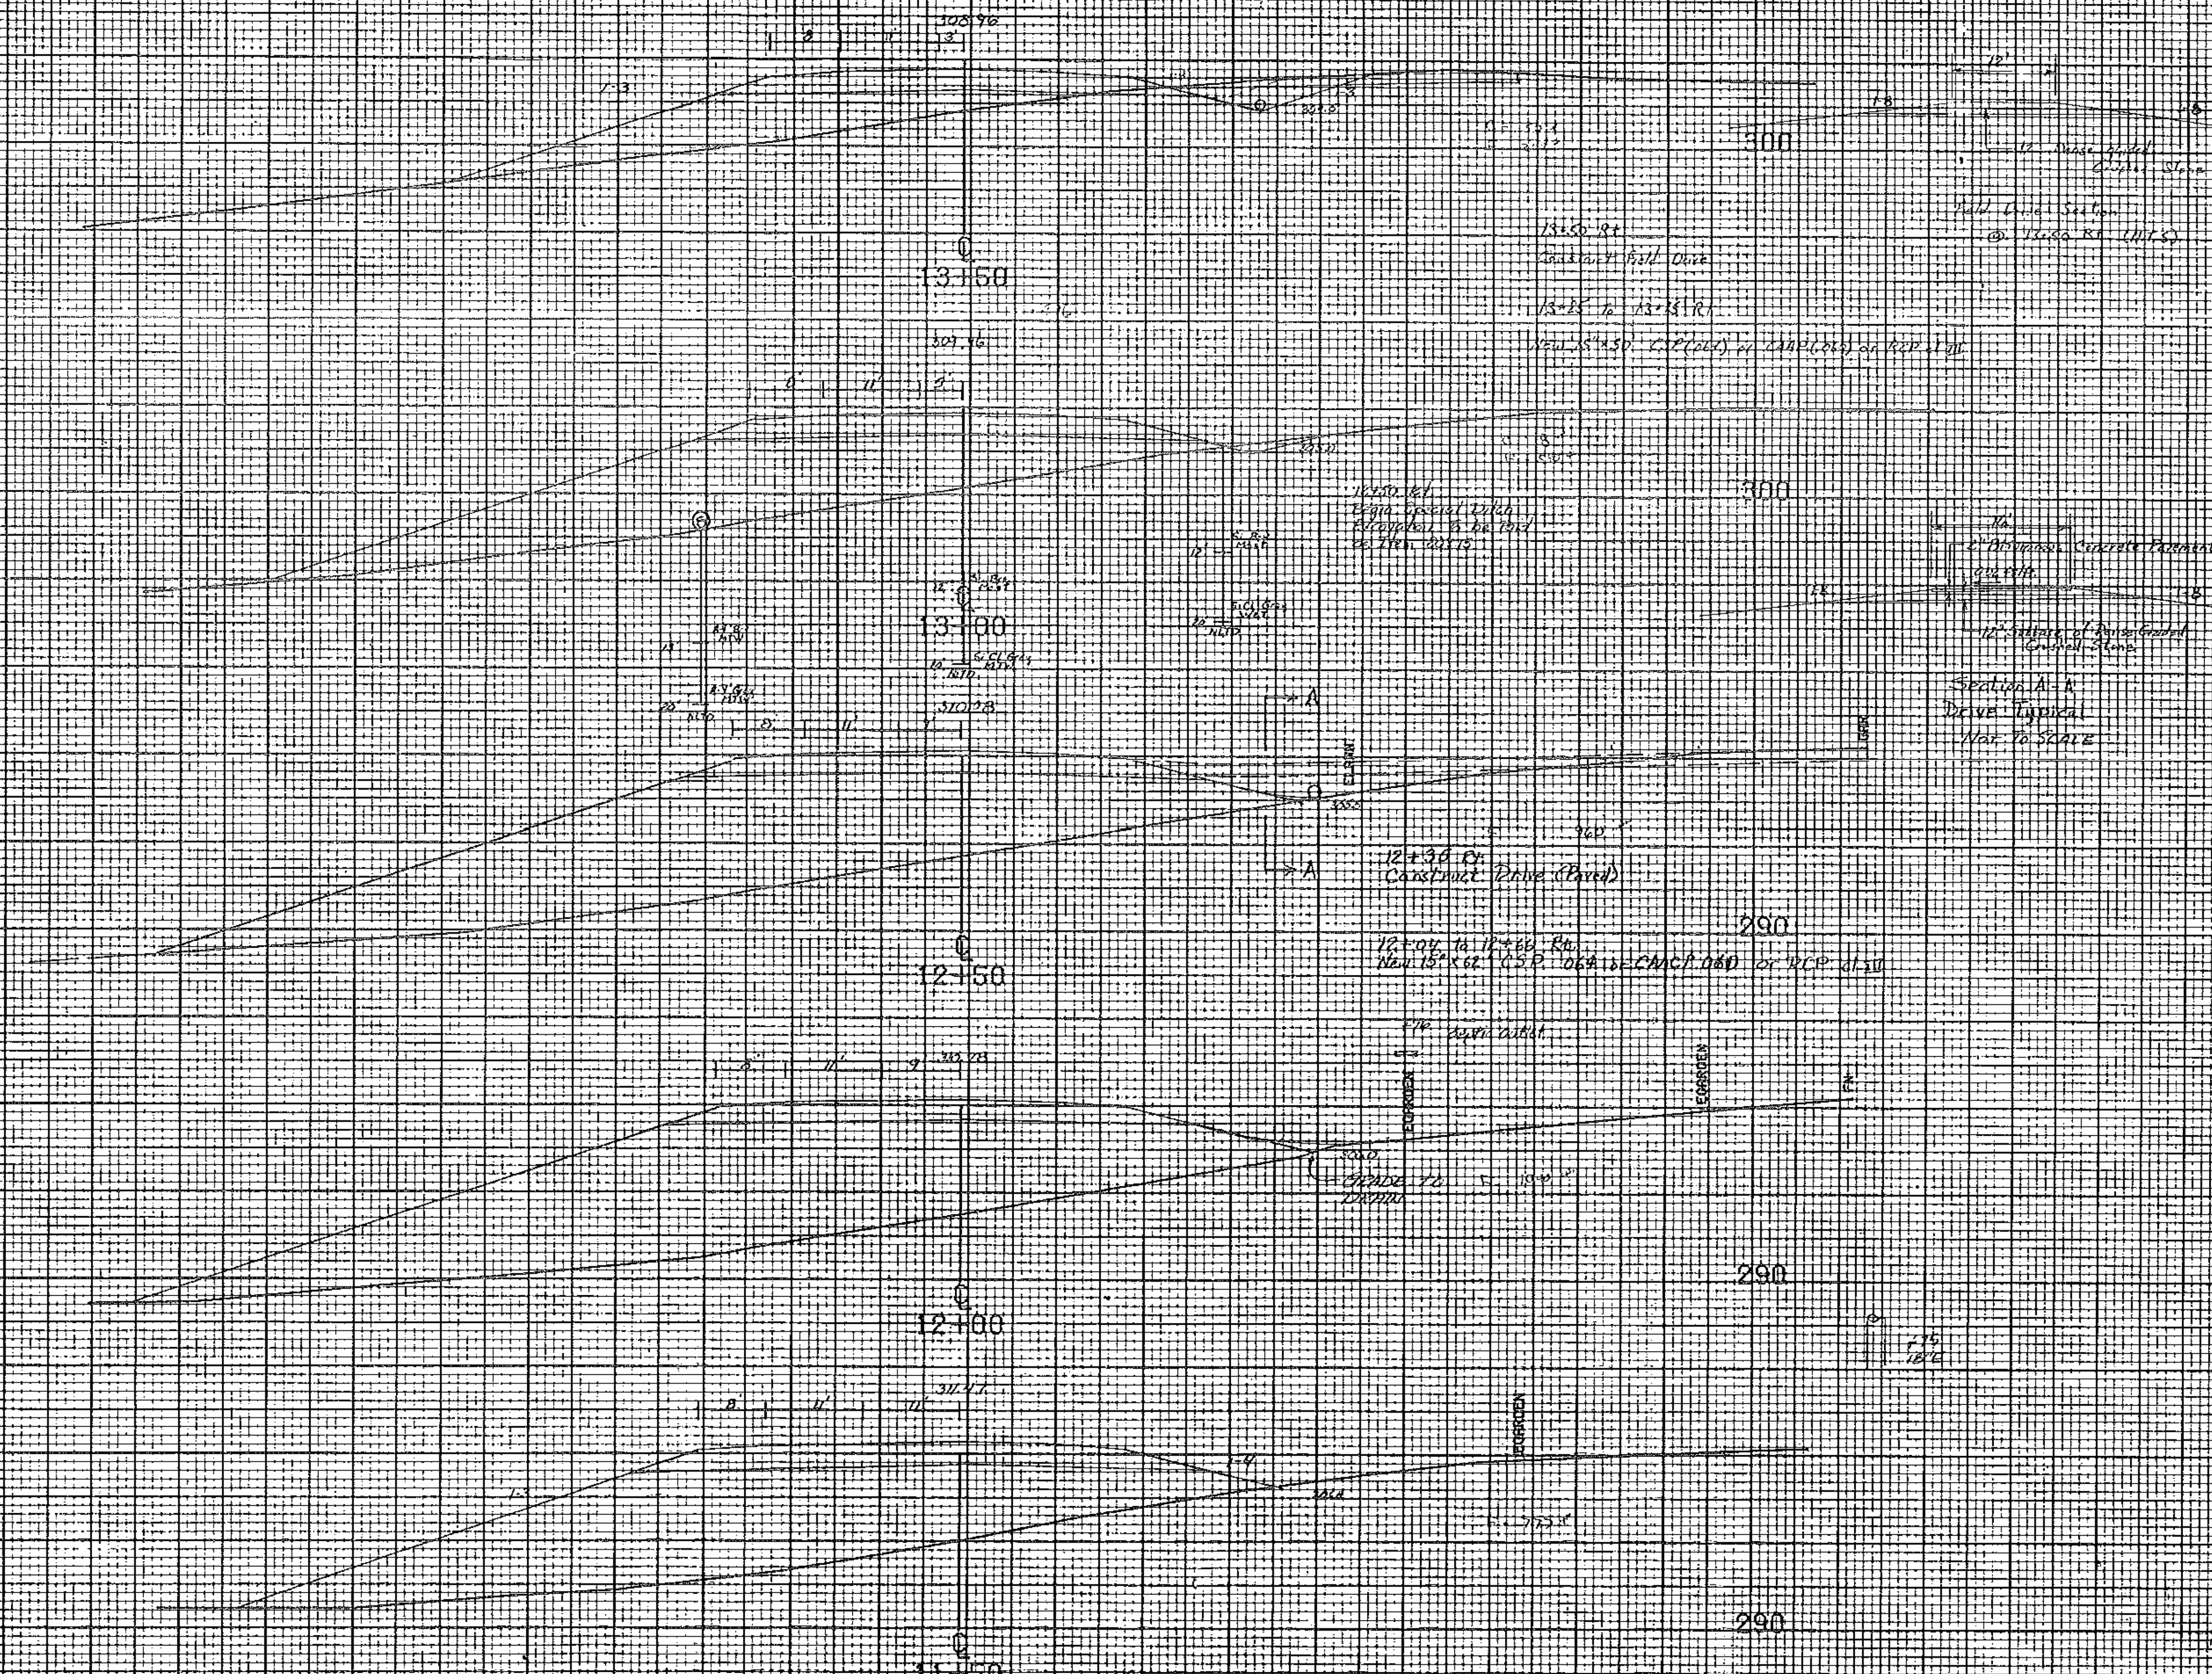

FROM STA. 11+50 TO STA. 13+50
PROJECT NAME COL. ONEYER 119
NO. 100200153
SURVEYED BY FALU
SHEET 12 OF 13
PLOTTER 11/20/00
OCT 1900