



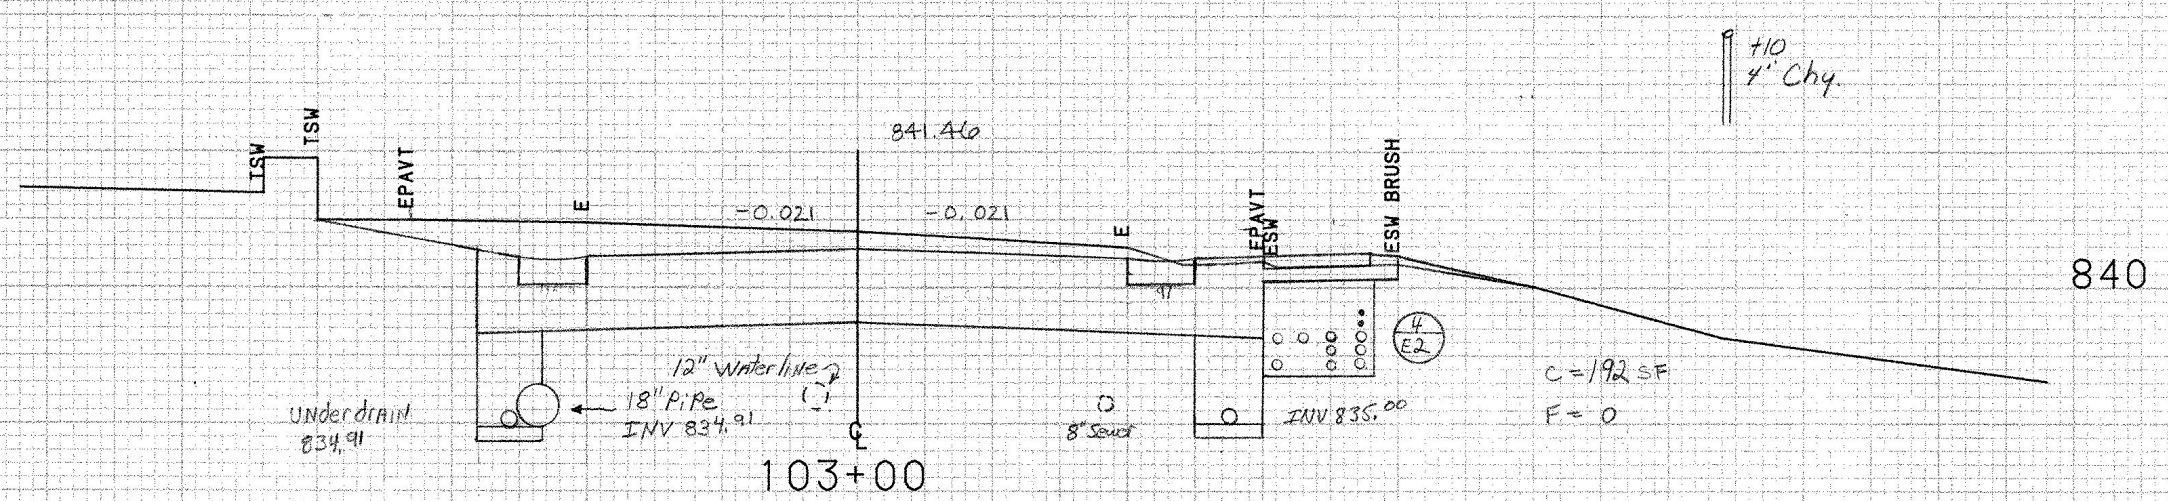

102+98LT
Remove & Reset Marble Walk
Relocation will be Directed by the
Engineer as agreed to by the
Affected Property Owner
To be Subsidiary to Common Elevation.

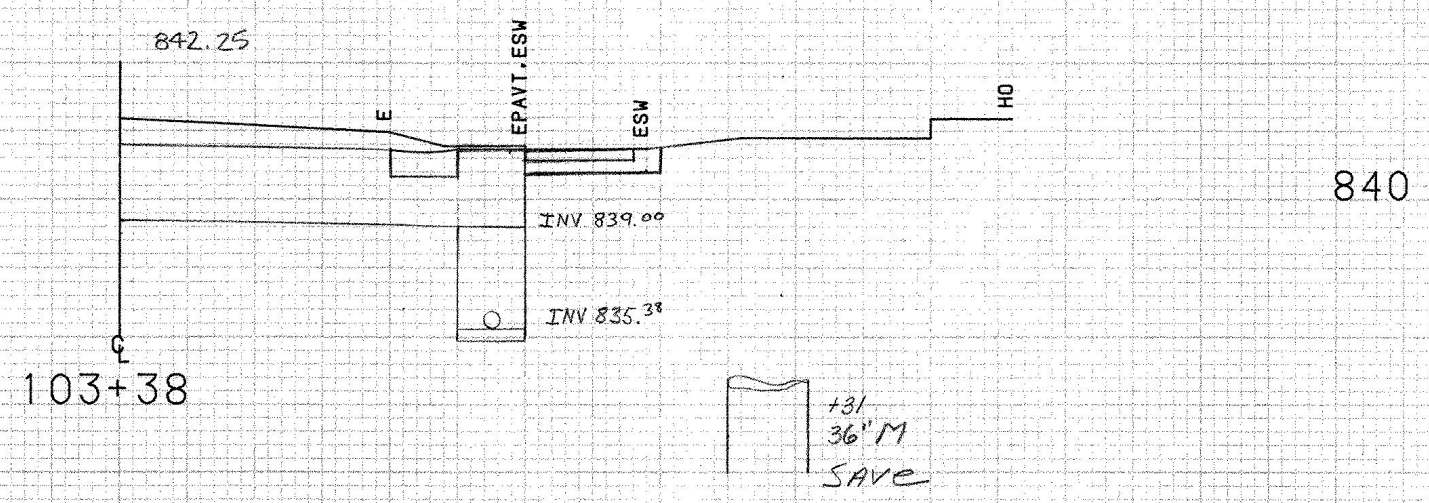