




179
36" M
SAVE

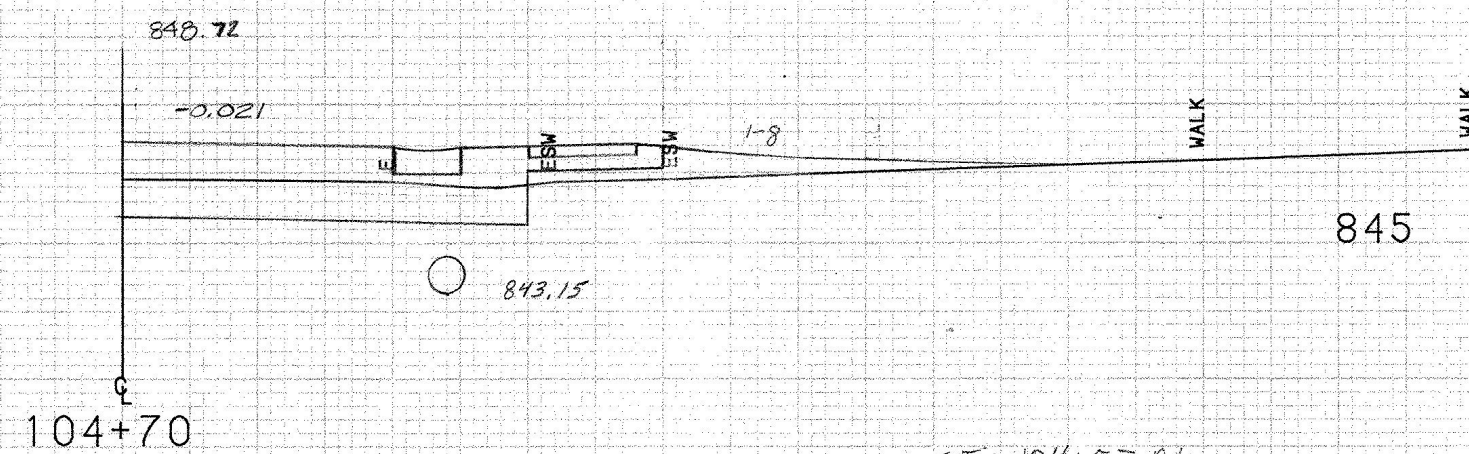

STA 104+57 RT.
Remove ~~the~~ Marble Walk
AS Directed by the Engineer
AS Agreed to by the Property
Owner.
Payment Subsidiary to Common
Excavation.

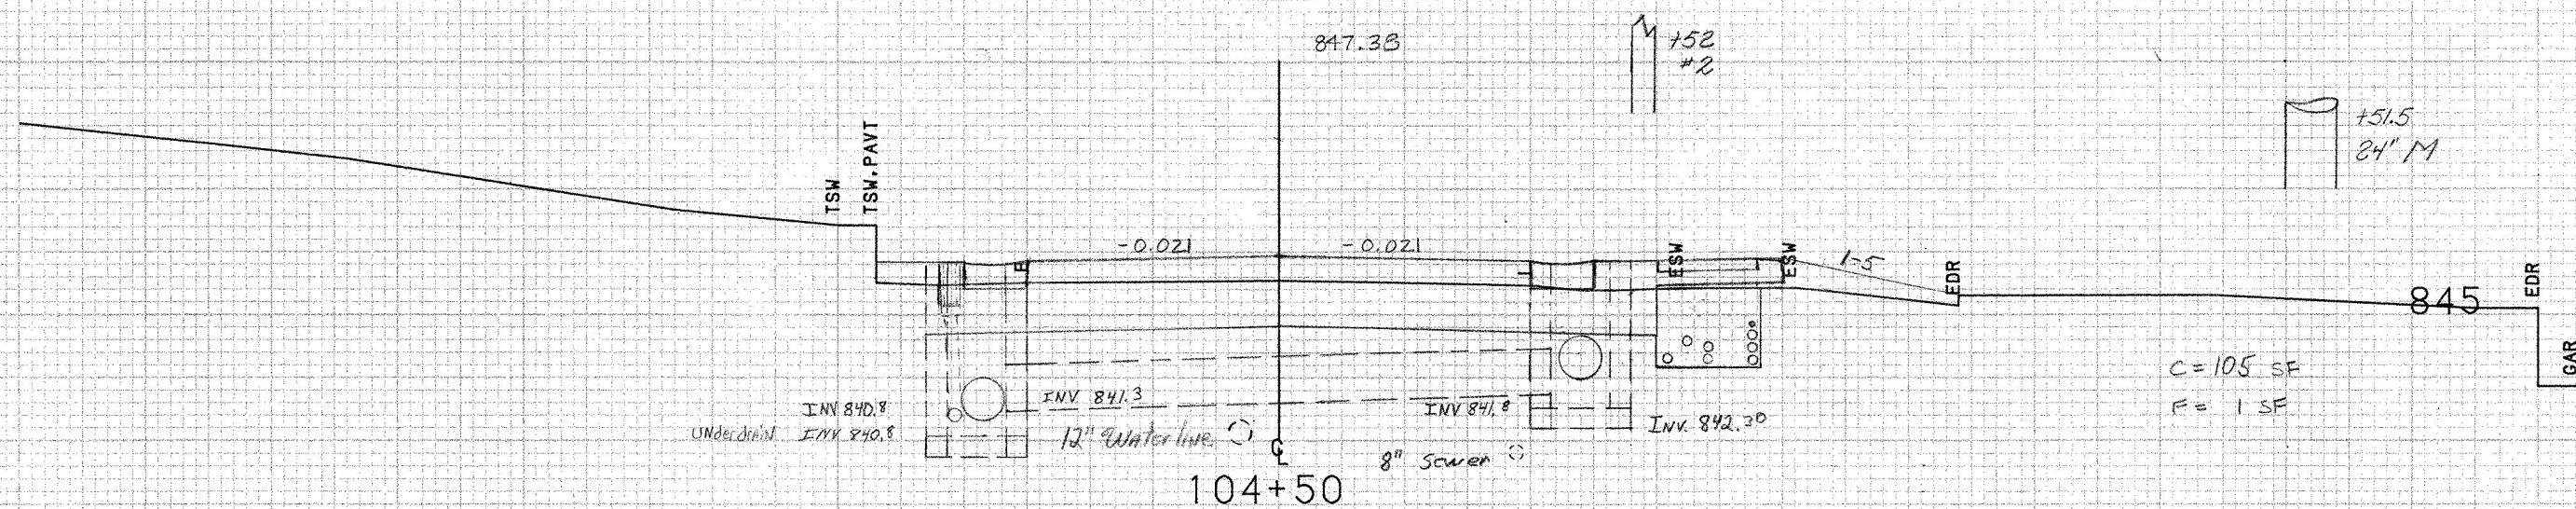

145
30" Chestnut

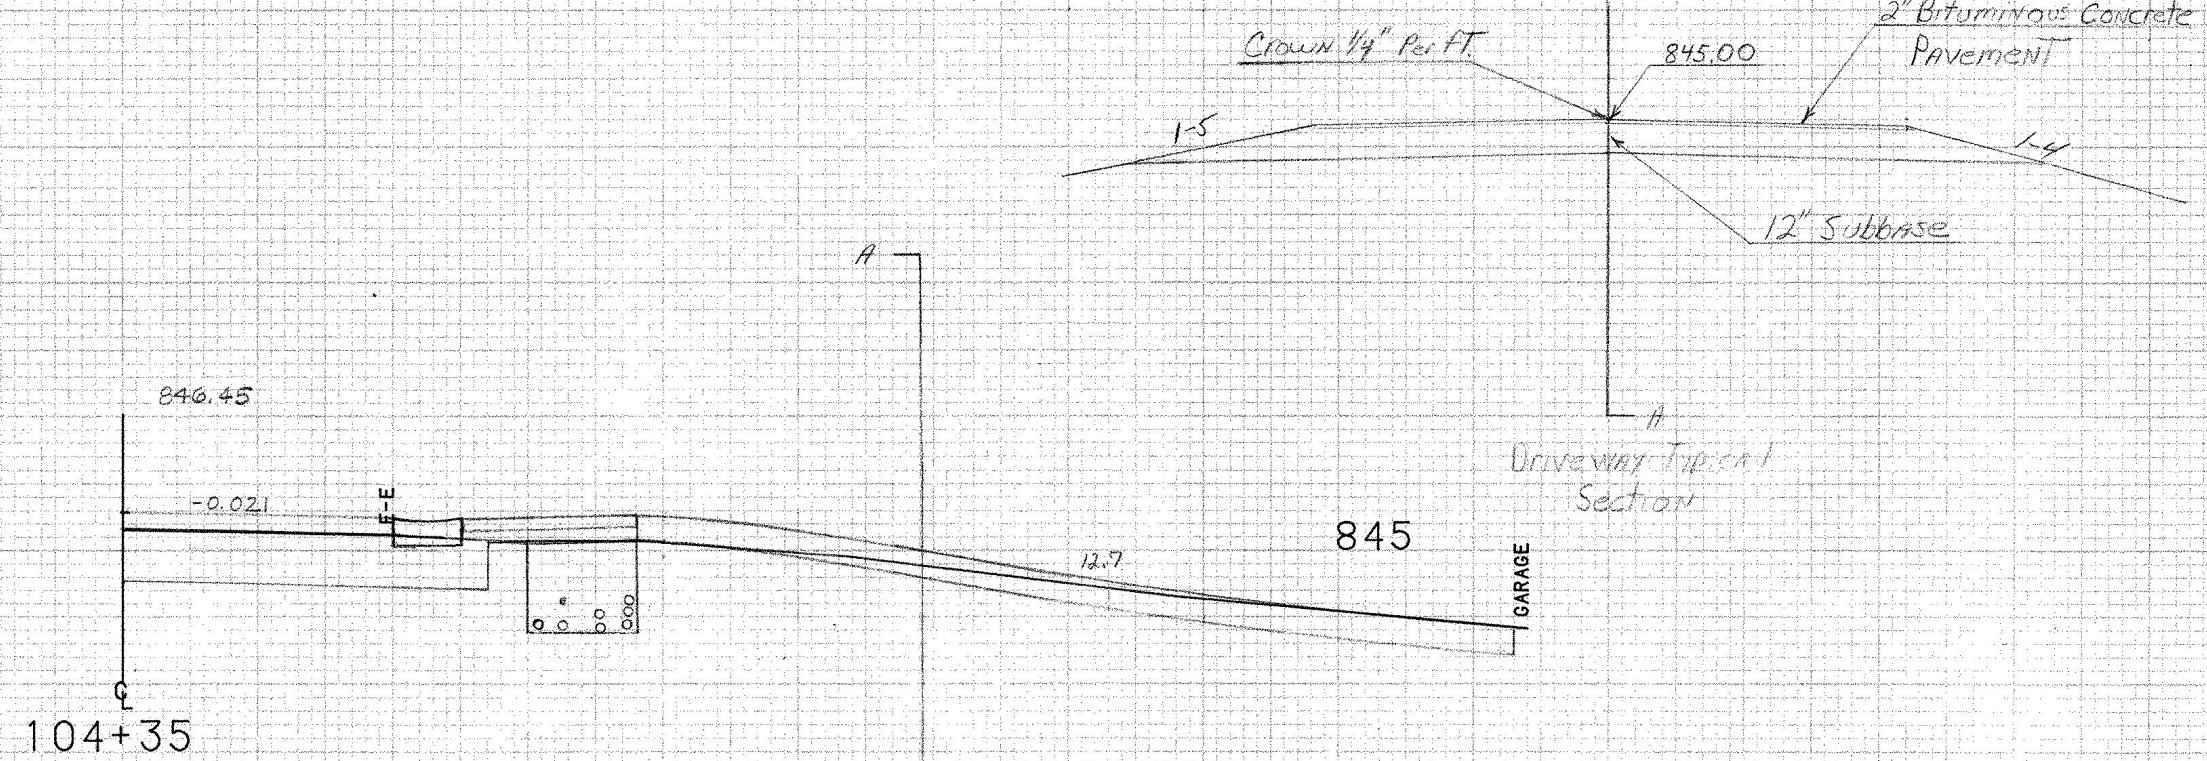

FROM STA. 104+35 TO STA. 104+70
PROJECT NAME OLD BENNINGTON
NO. M1400 (4) S
SURVEYED BY MOREAU
SHEET 52 OF 63 SHEETS
PLOTTED 02/24/86
JAN. 1986

SCALE 1" = 5 FEET