



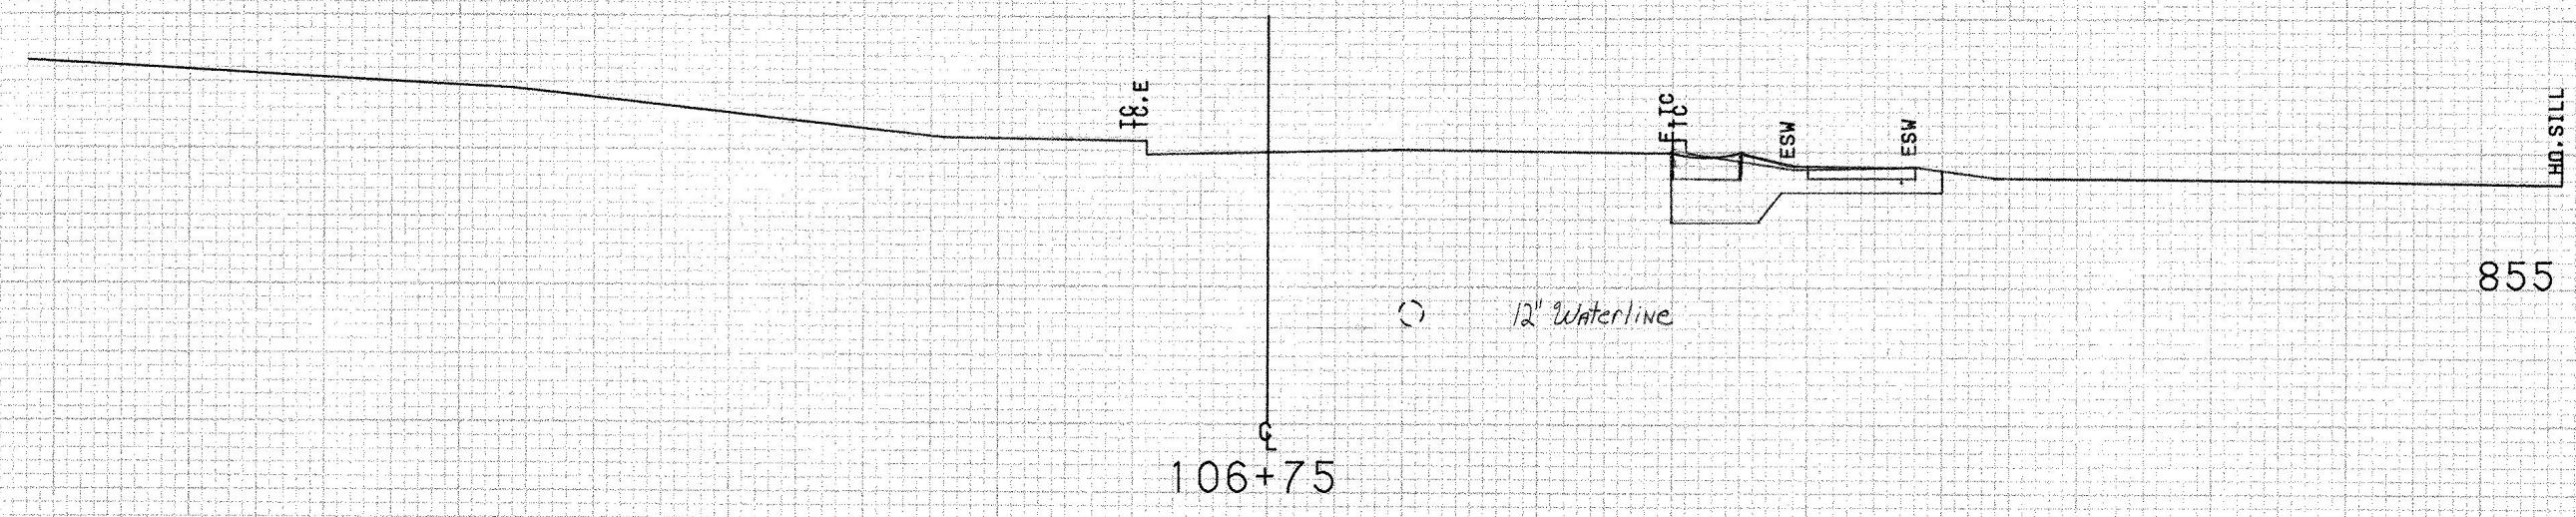


106+75

855

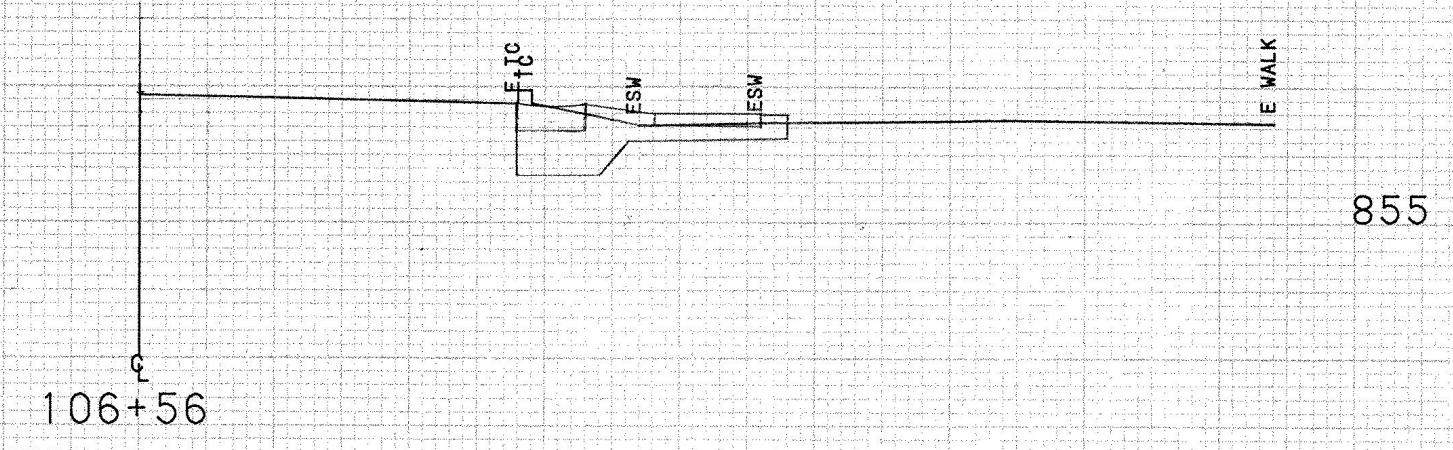

106+56

855

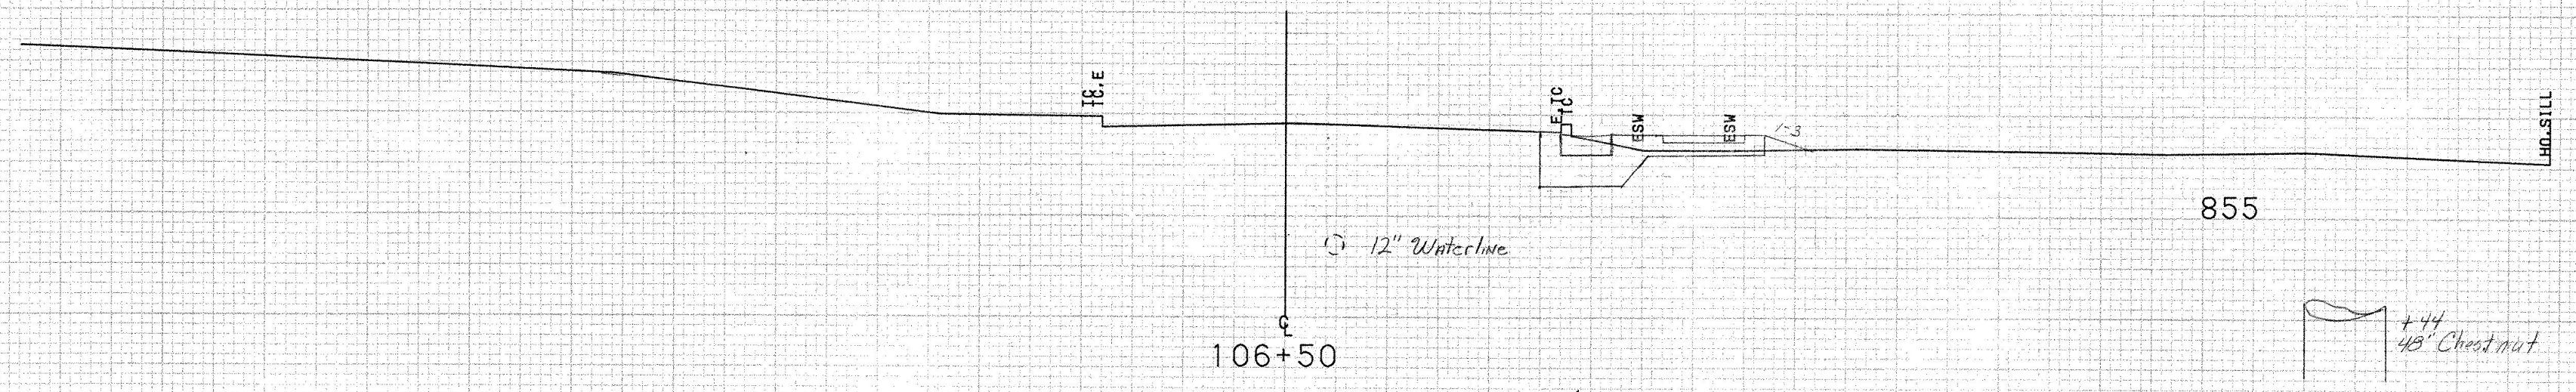

106+50

855

+38.5
#15

+44
48" Chestnut

SCALE 5 FEET

FROM STA.	106+50	TO STA.	106+75
PROJECT NAME	OLD BENNINGTON		
NO.	M1400 (4) S		
SURVEYED BY	MOREAU		
SHEET	56 OF 63	SHEETS	
		PLOTTED	02/24/86
		JAN.	1986