



CONSTRUCT DRIVE
STA I+080.000 RT GRAVEL
STA I+085.000 LT GRAVEL
STA I+115.000 RT GRAVEL
STA I+136.000 LT PAVED
STA I+160.000 RT GRAVEL
STA I+194.000 LT GRAVEL
STA I+220.000 RT GRAVEL

CONSTRUCT SPECIAL DITCH
STA I+050.000 TO STA I+079.750 LT
STA I+050.000 TO STA I+074.520 RT
STA I+085.750 TO STA I+109.750 RT

RELOCATE MAIL BOX, SINGLE SUPPORT
STA I+079.760 LT
STA I+131.760 LT

EXCAVATION OF SURFACES AND PAVEMENTS
STA I+000.000 TO STA I+080.941 LT

EXCAVATION OF SURFACES AND PAVEMENTS
APPLY 100mm TOPSOIL, AND SEED & MULCH

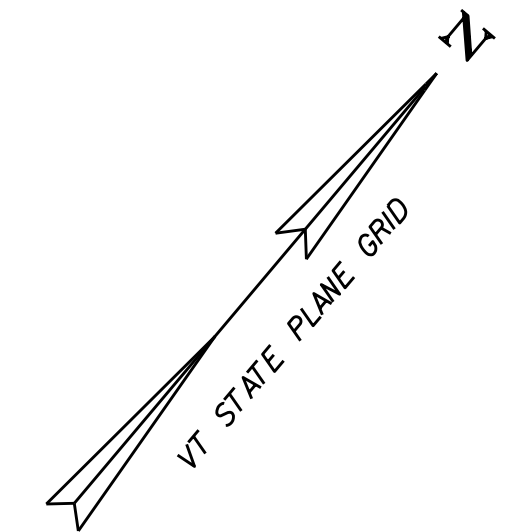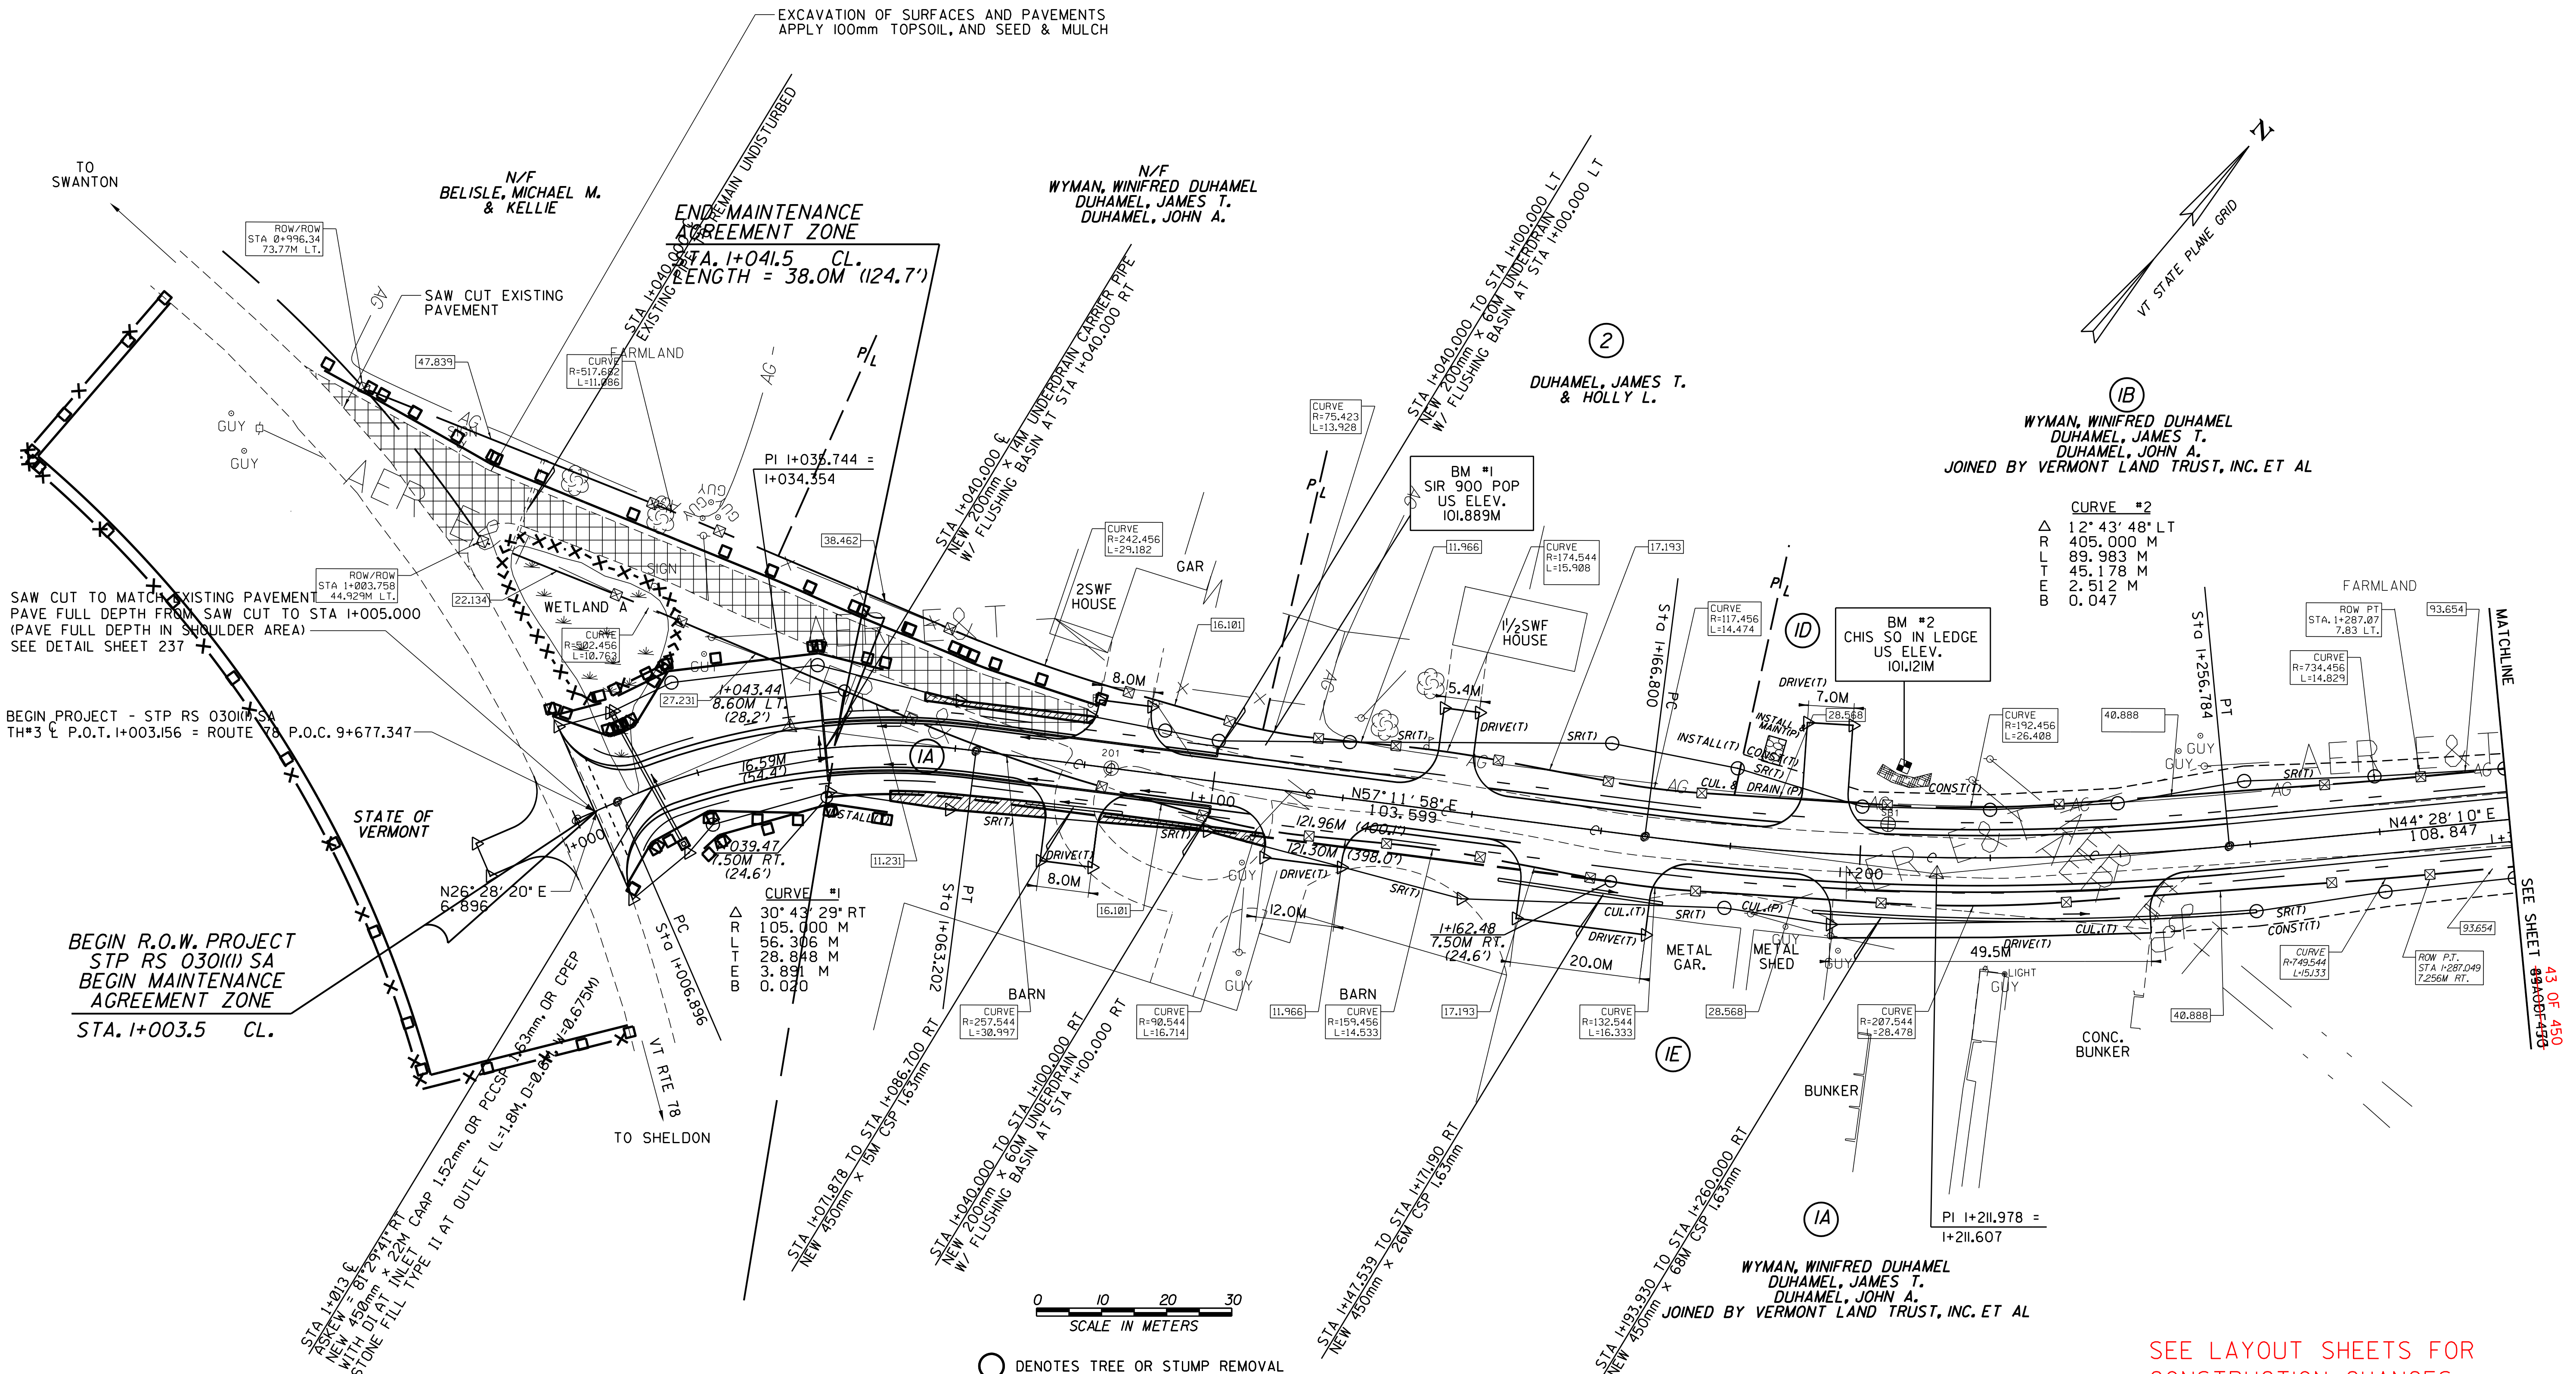


○ DENOTES TREE OR STUMP REMOVAL

LINES SHOWN ON THIS PLAN AS EXISTING
PROPERTY LINES P/L ARE BELIEVED TO
BE ACCURATE BUT SHOULD NOT BE RELIED
UPON FOR PURPOSES UNRELATED TO THE
STATE OF VERMONT'S ACQUISITION OF LAND
AND RIGHTS FOR THIS PROJECT.

**FOR R.O.W.
USE ONLY**

- NOTES:
1. ALL SIDE ROAD RADII SHALL BE 11M UNLESS OTHERWISE NOTED. REFER TO STD B-12M
 2. ALL DRIVE RADII SHALL BE 6M UNLESS OTHERWISE NOTED. REFER TO STD B-7M

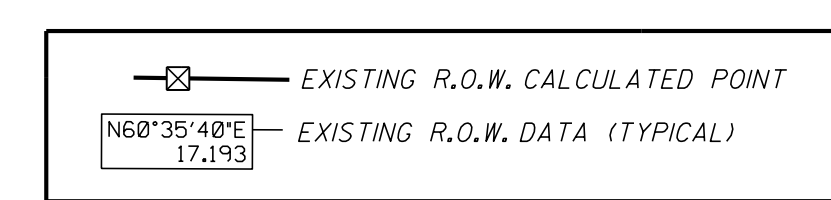

SEE LAYOUT SHEETS FOR
CONSTRUCTION CHANGES

(R.O.W. AS BUILT)

PROJECT NAME:	HIGHGATE-FRANKLINAS-BUILT
PROJECT NUMBER:	STP RS 030(1) SA
FILE NAME:	ARC000 design/dc060bdr.dgn
PROJECT LEADER:	DELA SANTIA
DESIGNED BY:	SOLARDO B
CHECKED BY:	HSU
DATE:	12-FEB-2014
PLANT DATE:	12-FEB-2014
DATE:	12-FEB-2014
DATE:	12-FEB-2014