

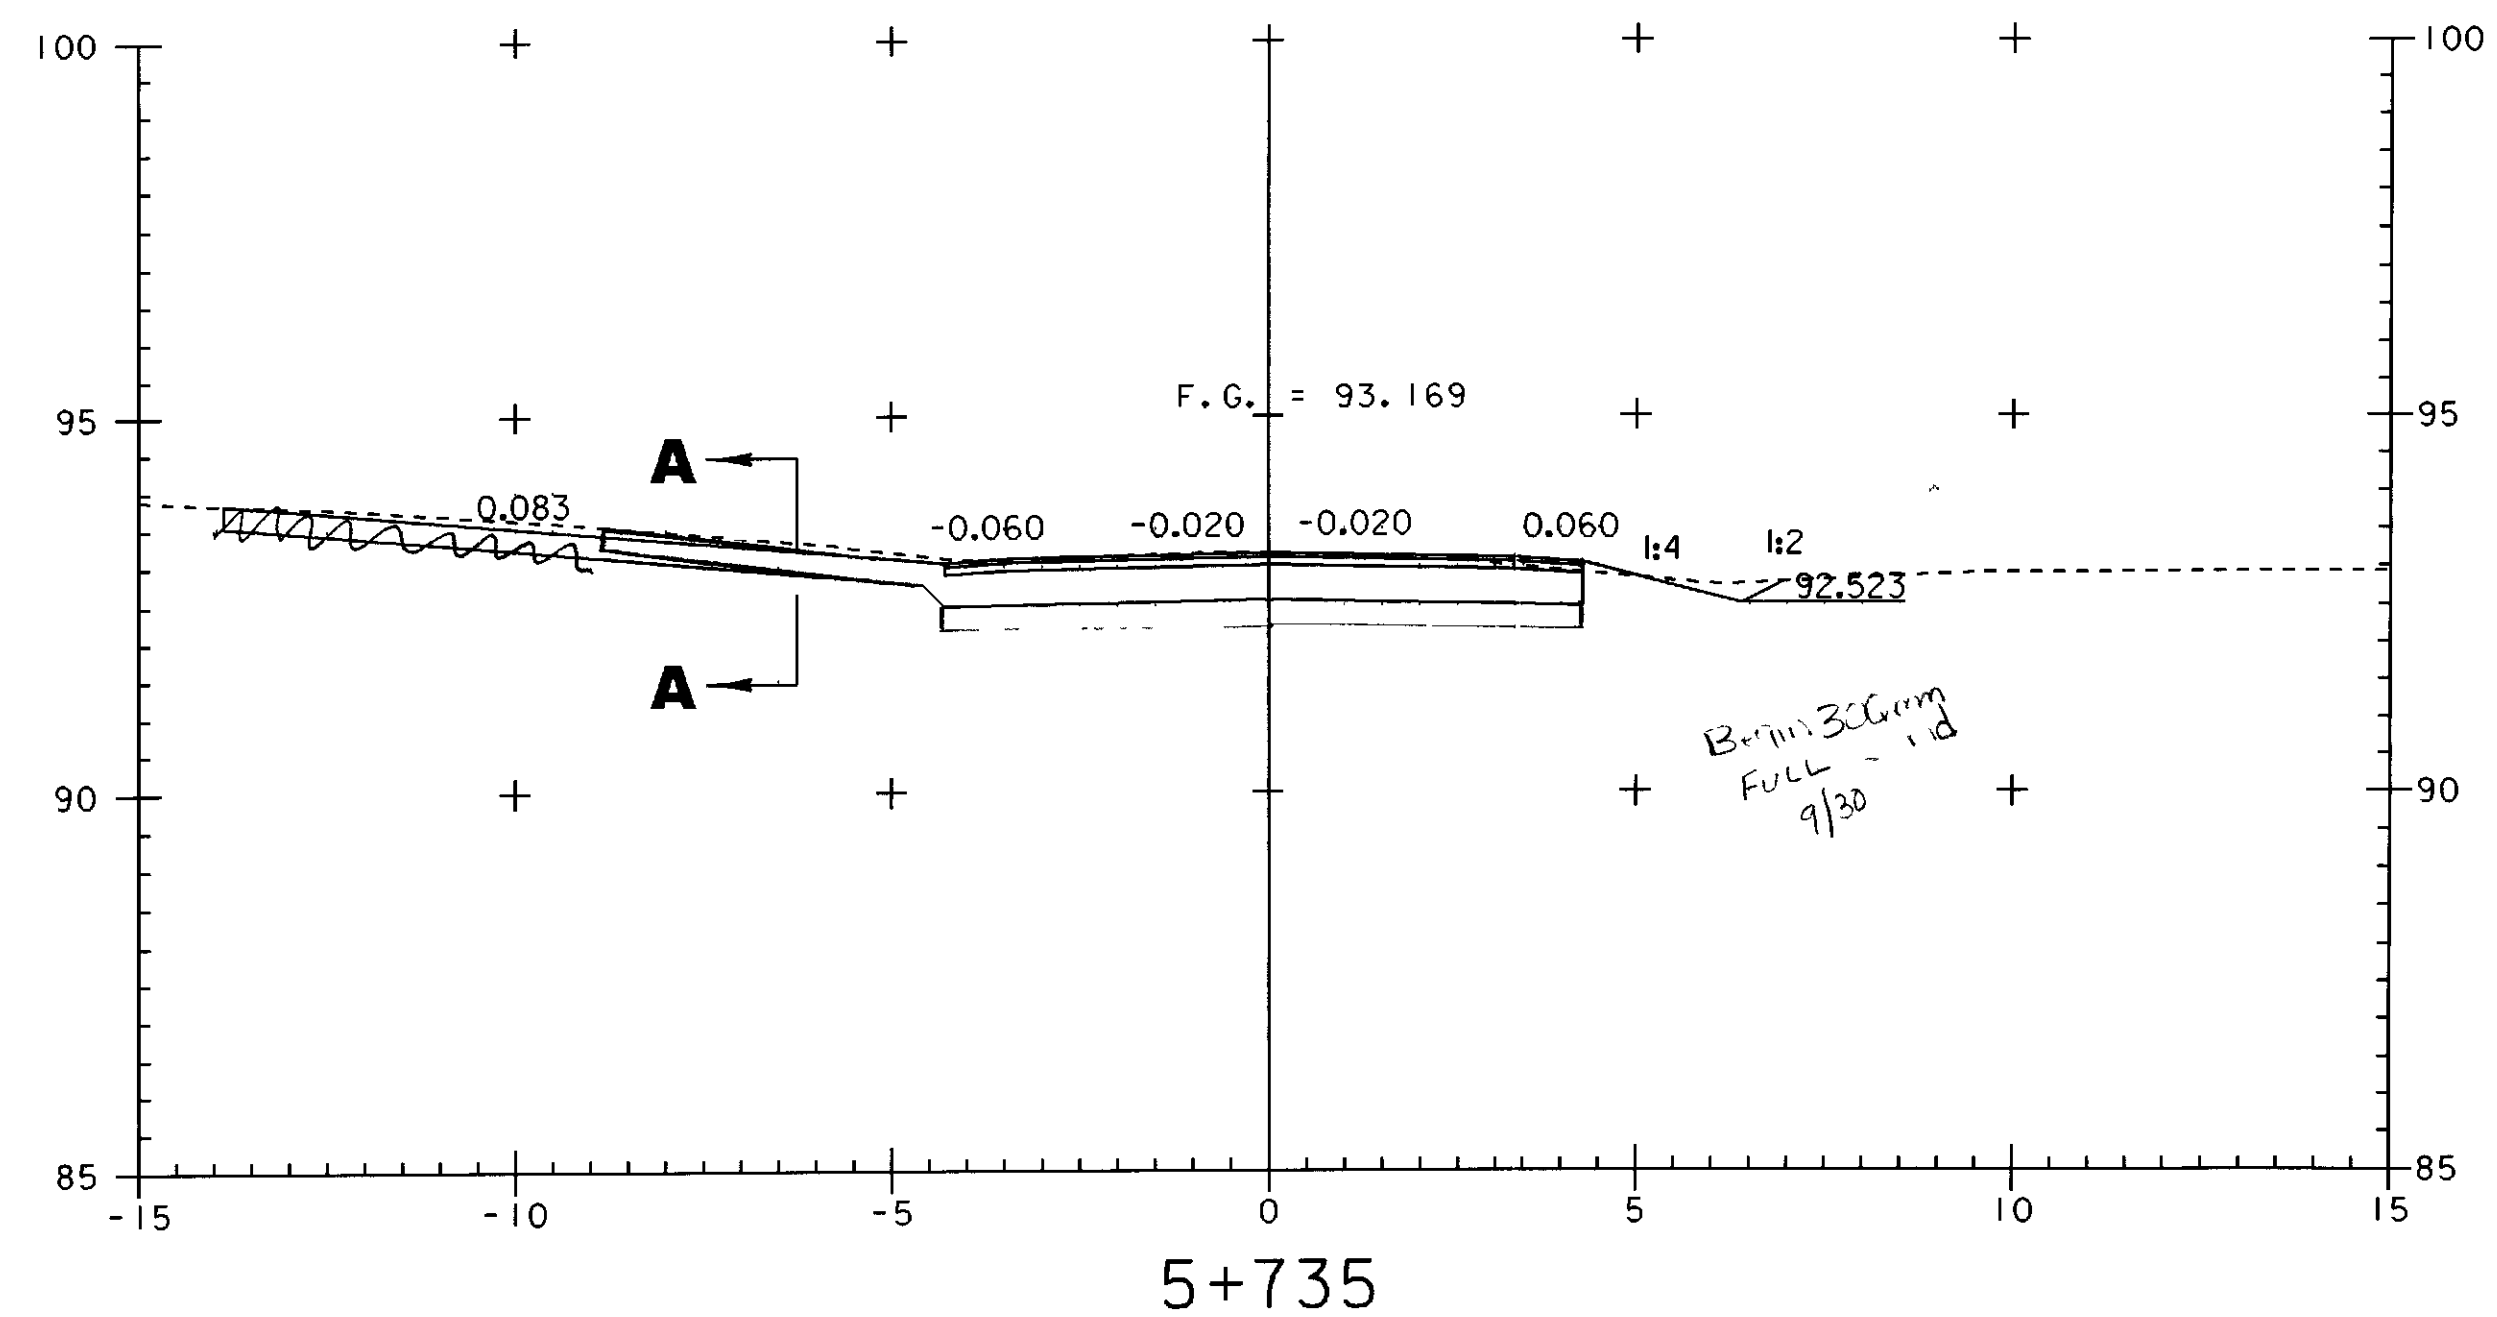
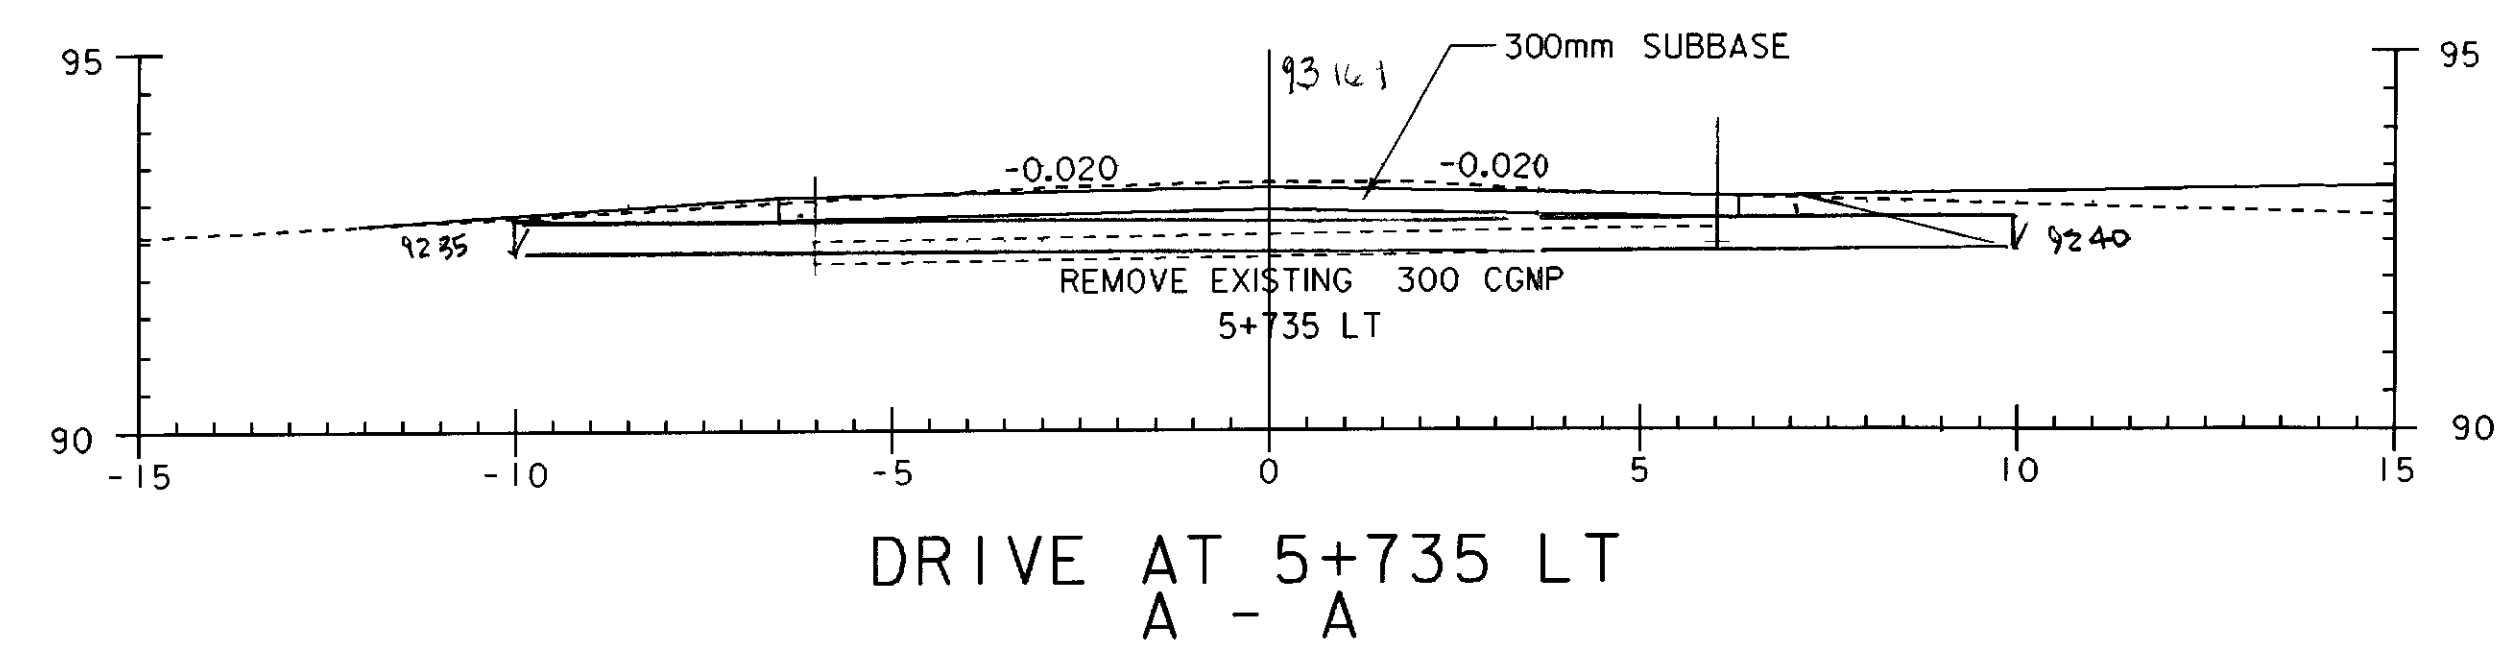
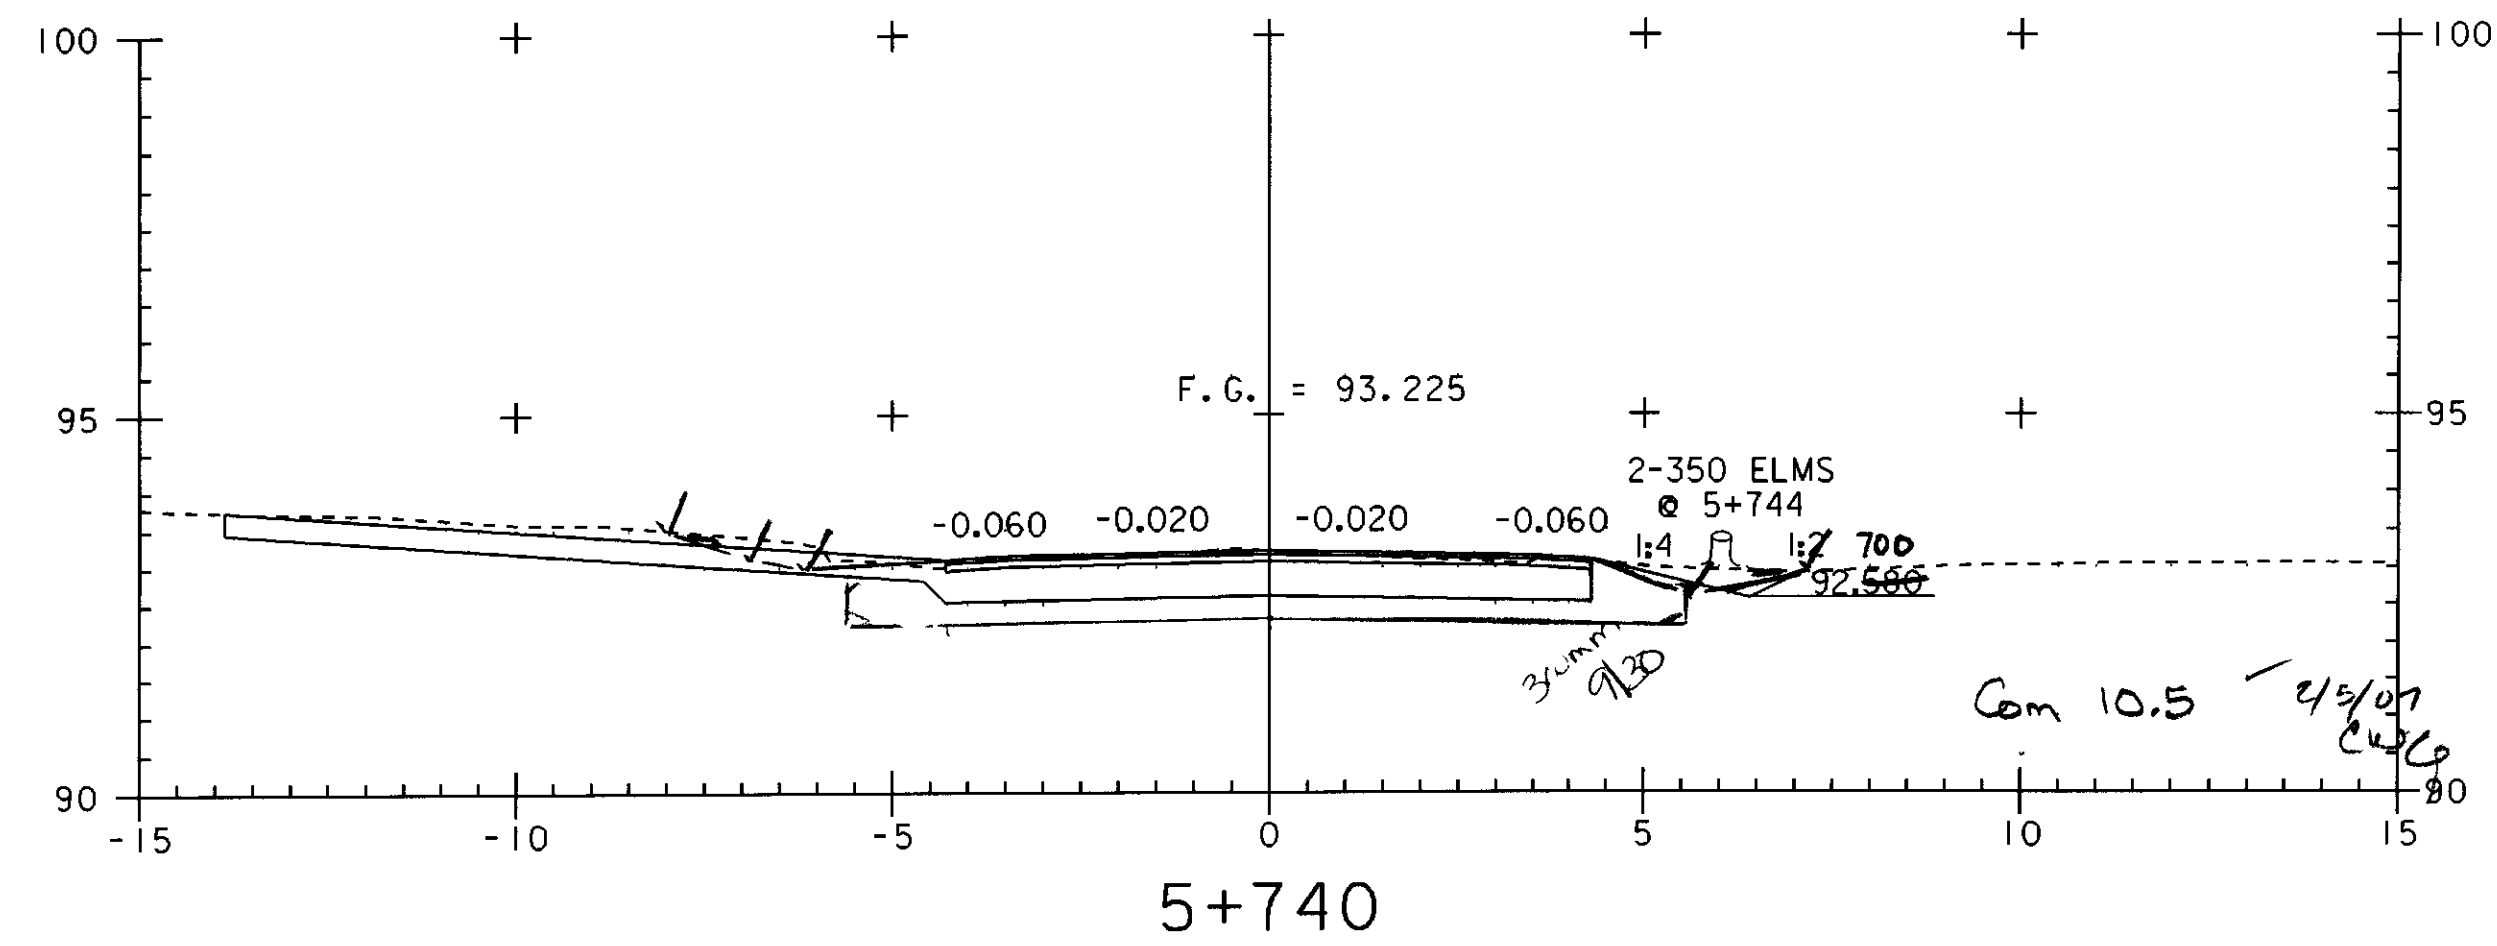
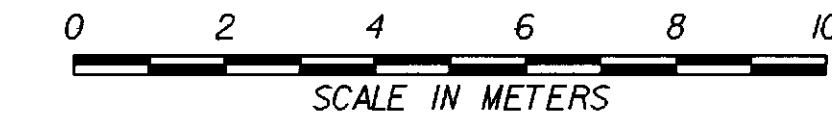
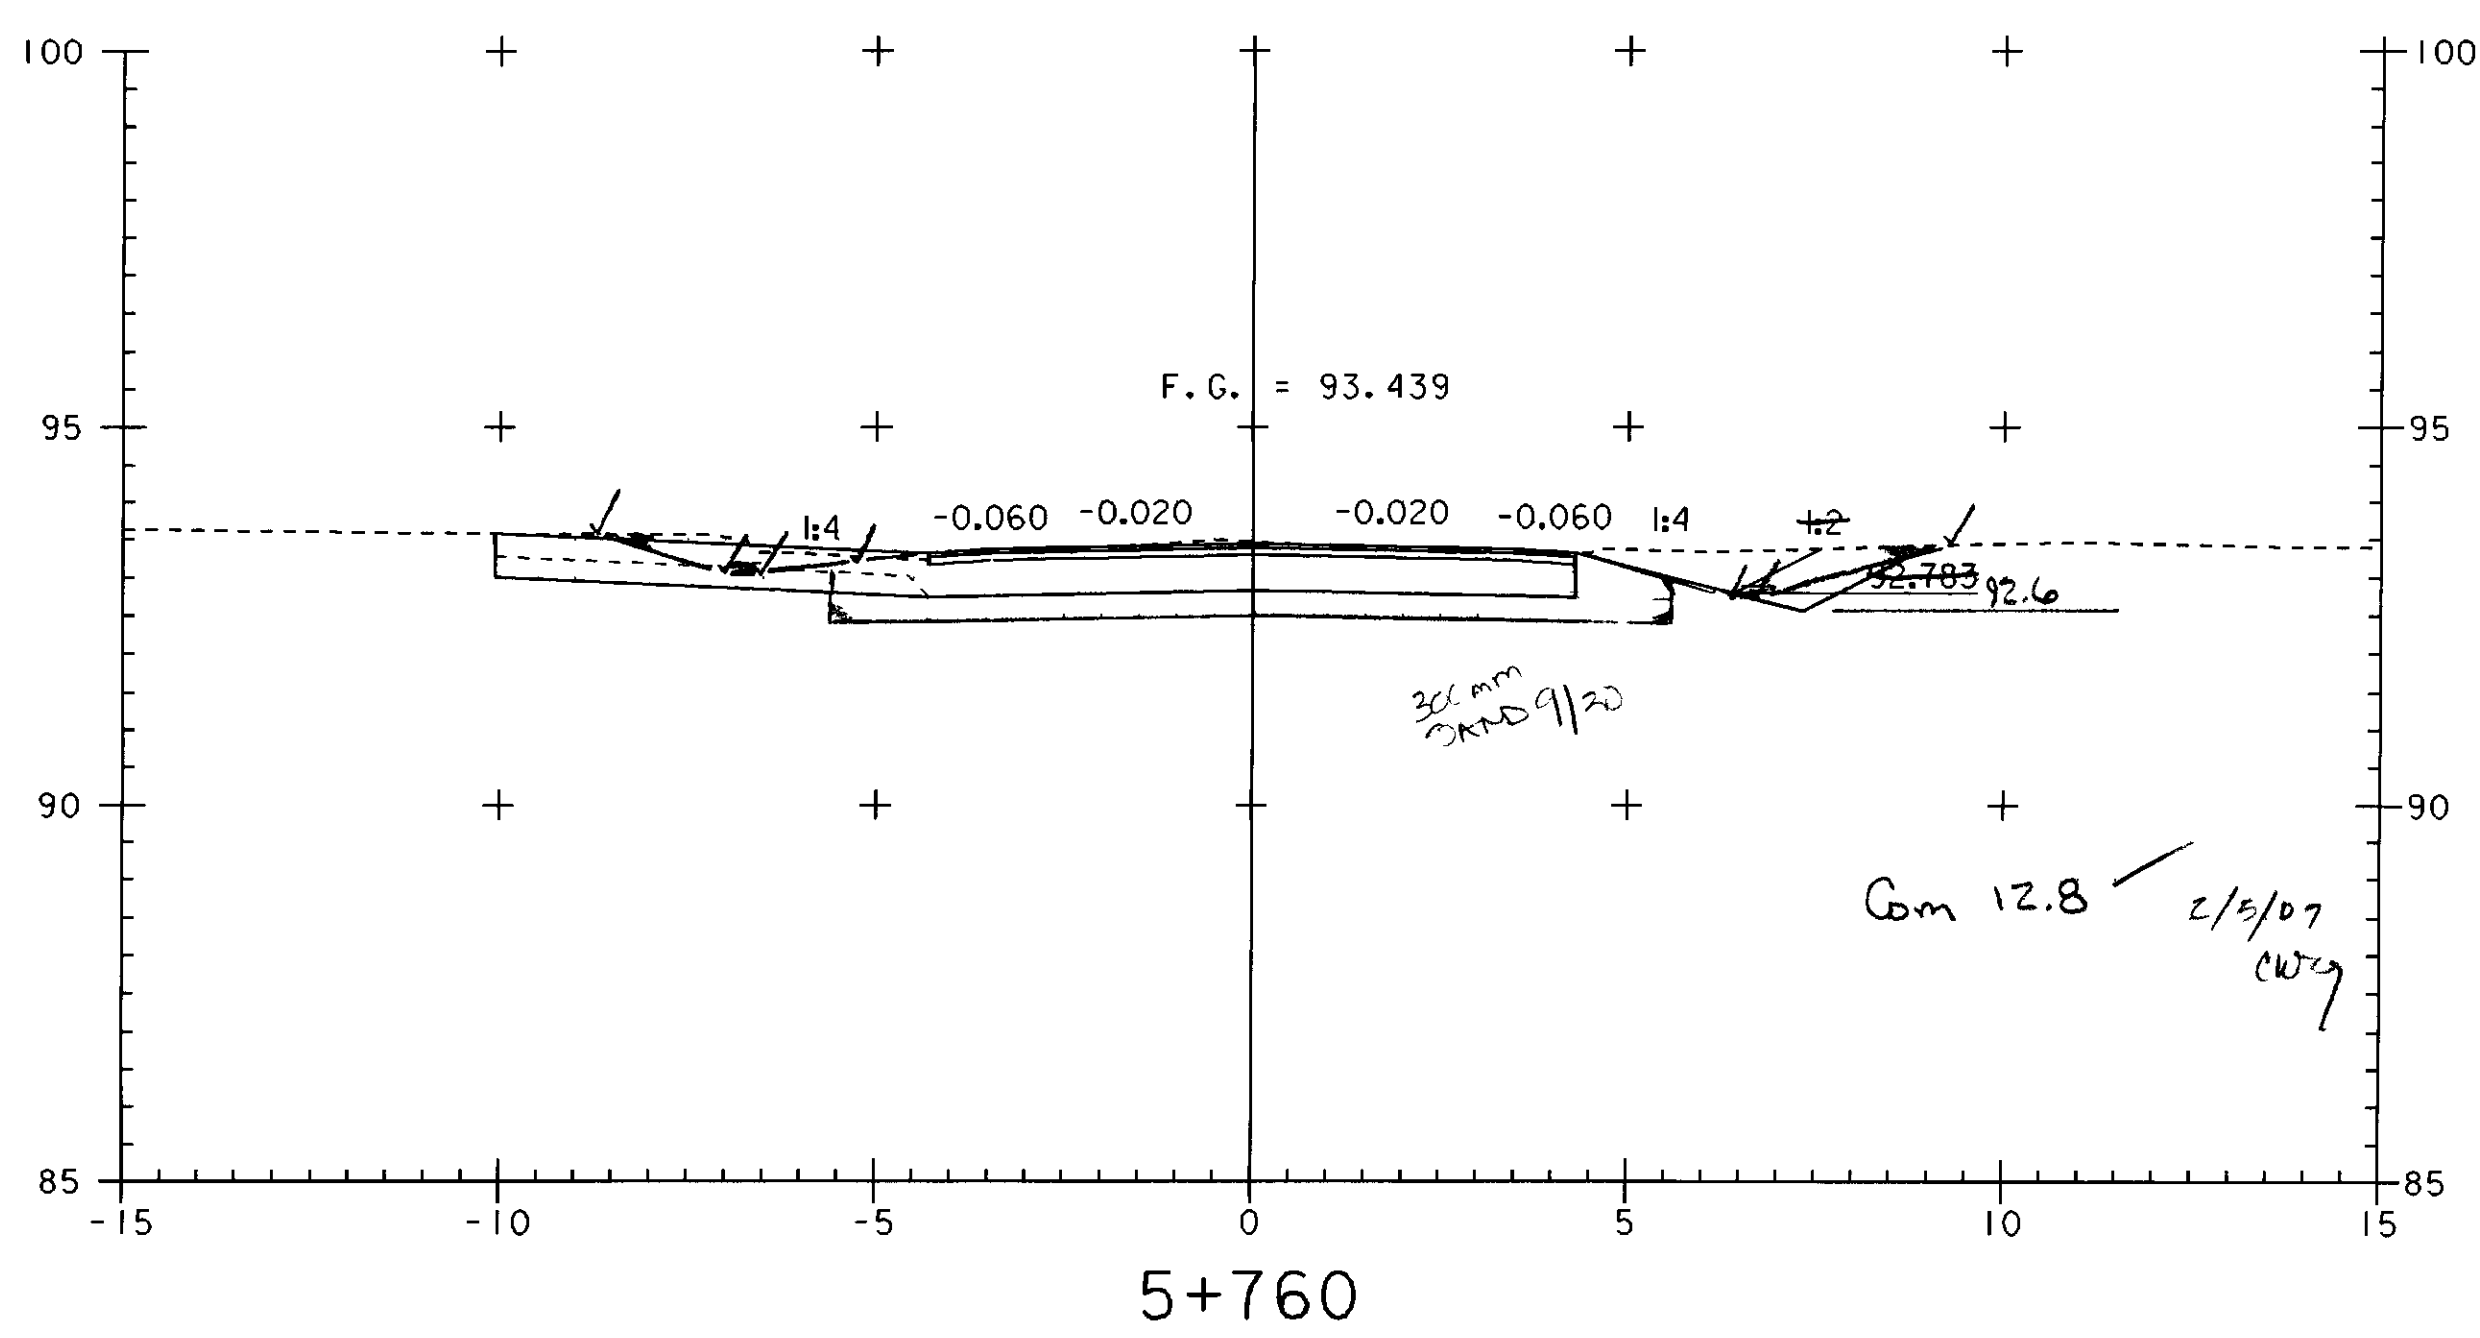
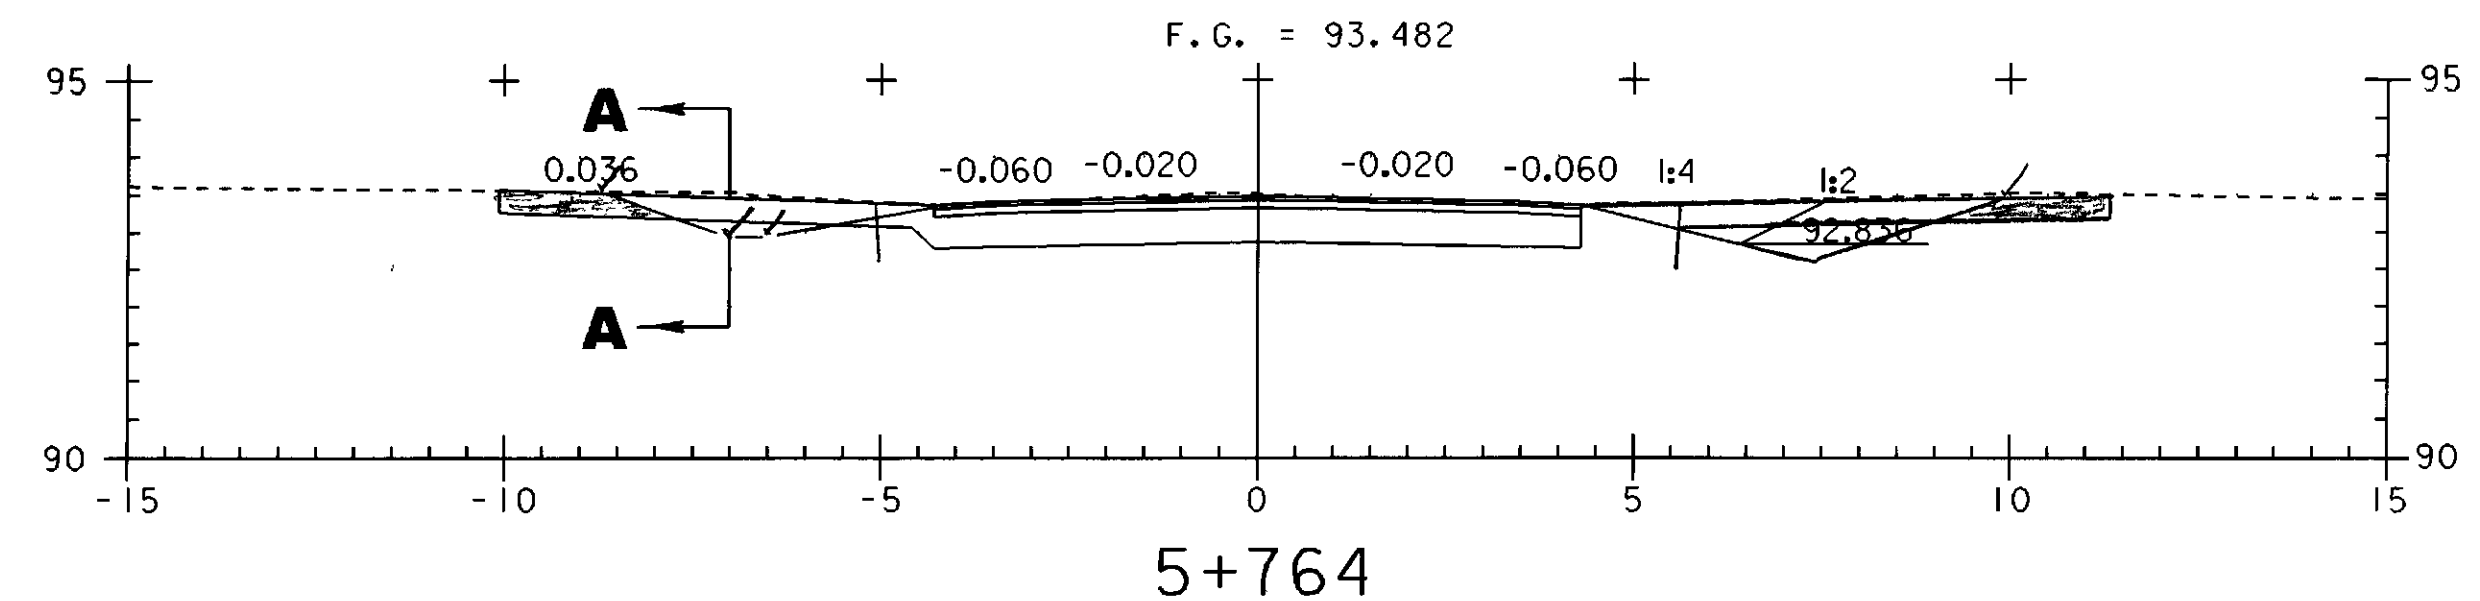


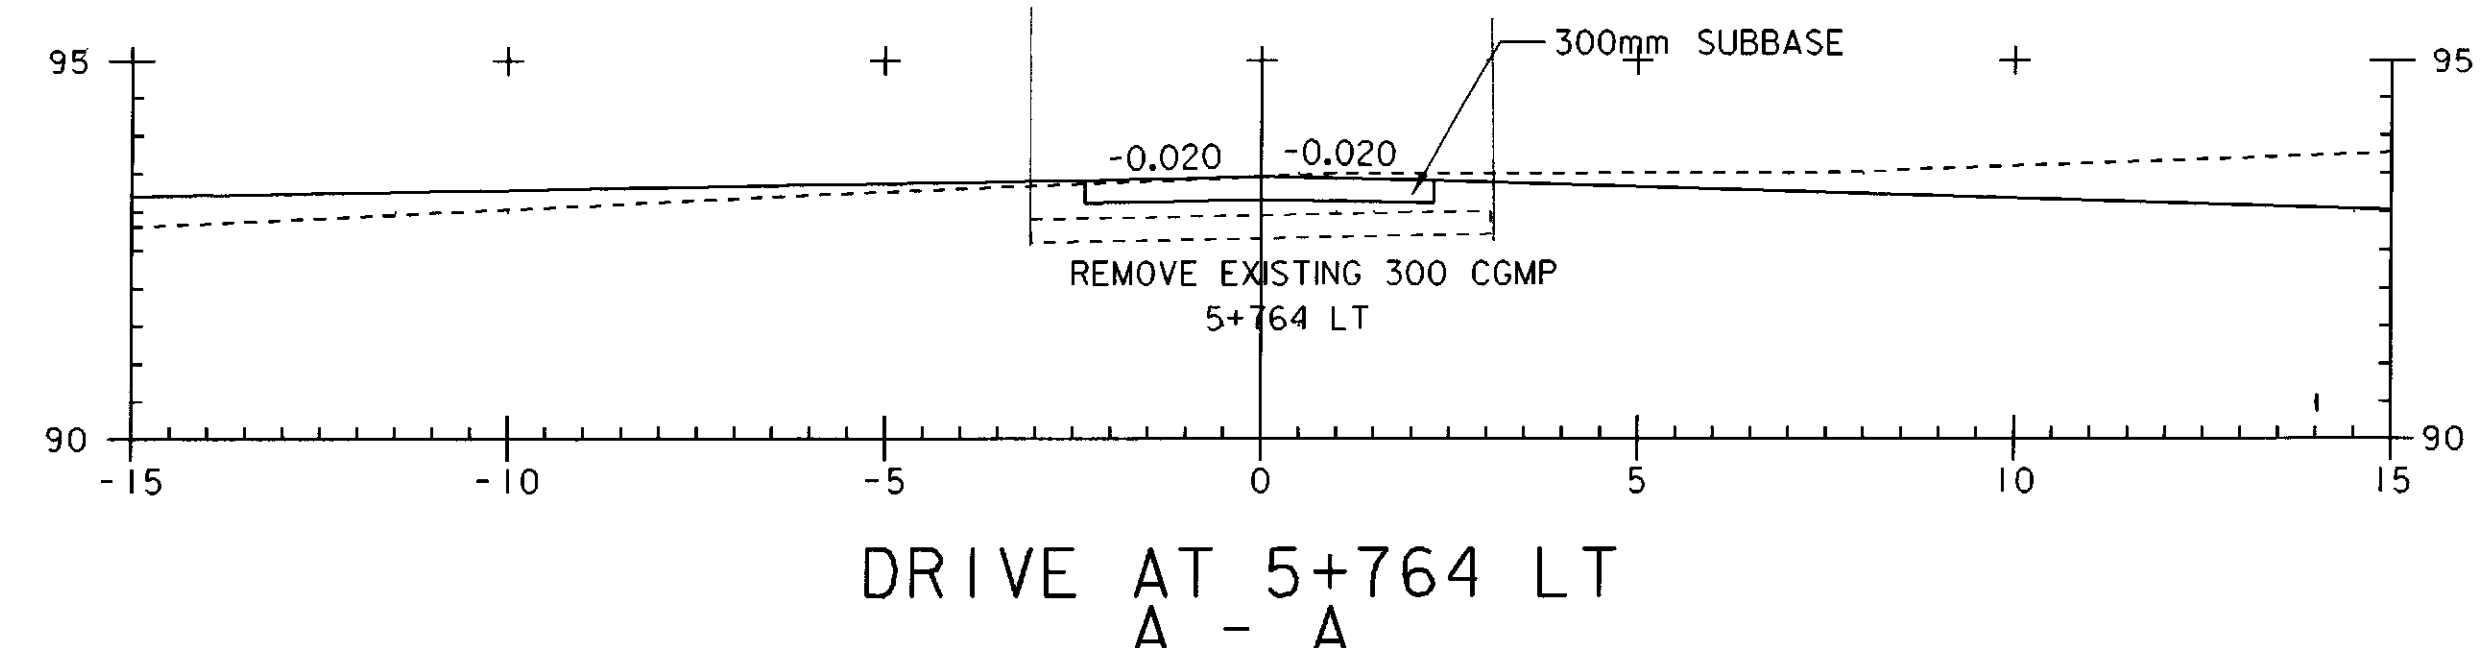

STA 5+720.000
END FINE GRADING AND PAVING
MATCH EXISTING GRADE

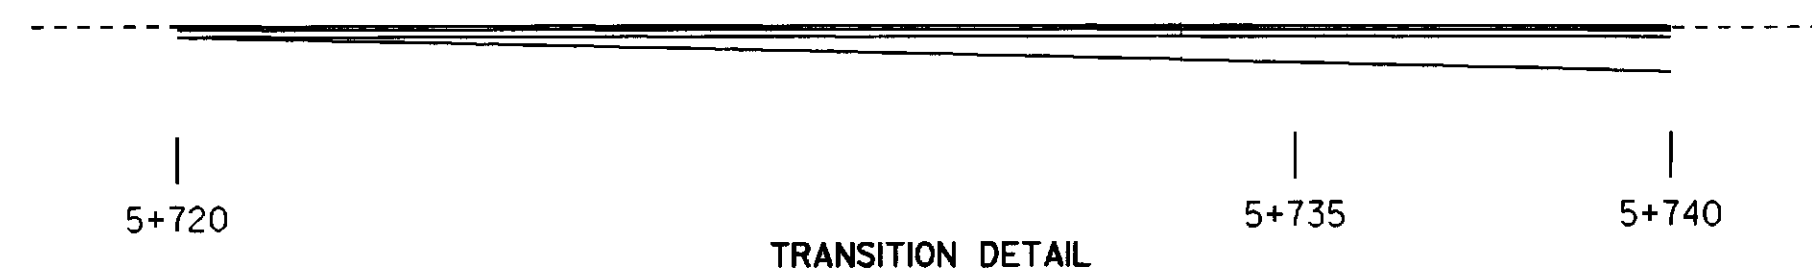

PROJECT NAME: HIGHGATE - FRANKLIN
PROJECT NUMBER: STP RS 030(I) SA
FILE NAME: ...85c060\design\dc060x07.dgn PLOT DATE: 09-MAY-2005
PROJECT LEADER: DELLASANTA DRAWN BY: SQUAD B
DESIGNED BY: SQUAD B CHECKED BY: SQUAD B
IPARM FILE NAME: dc060x0719.1 SHEET 365 OF 450