


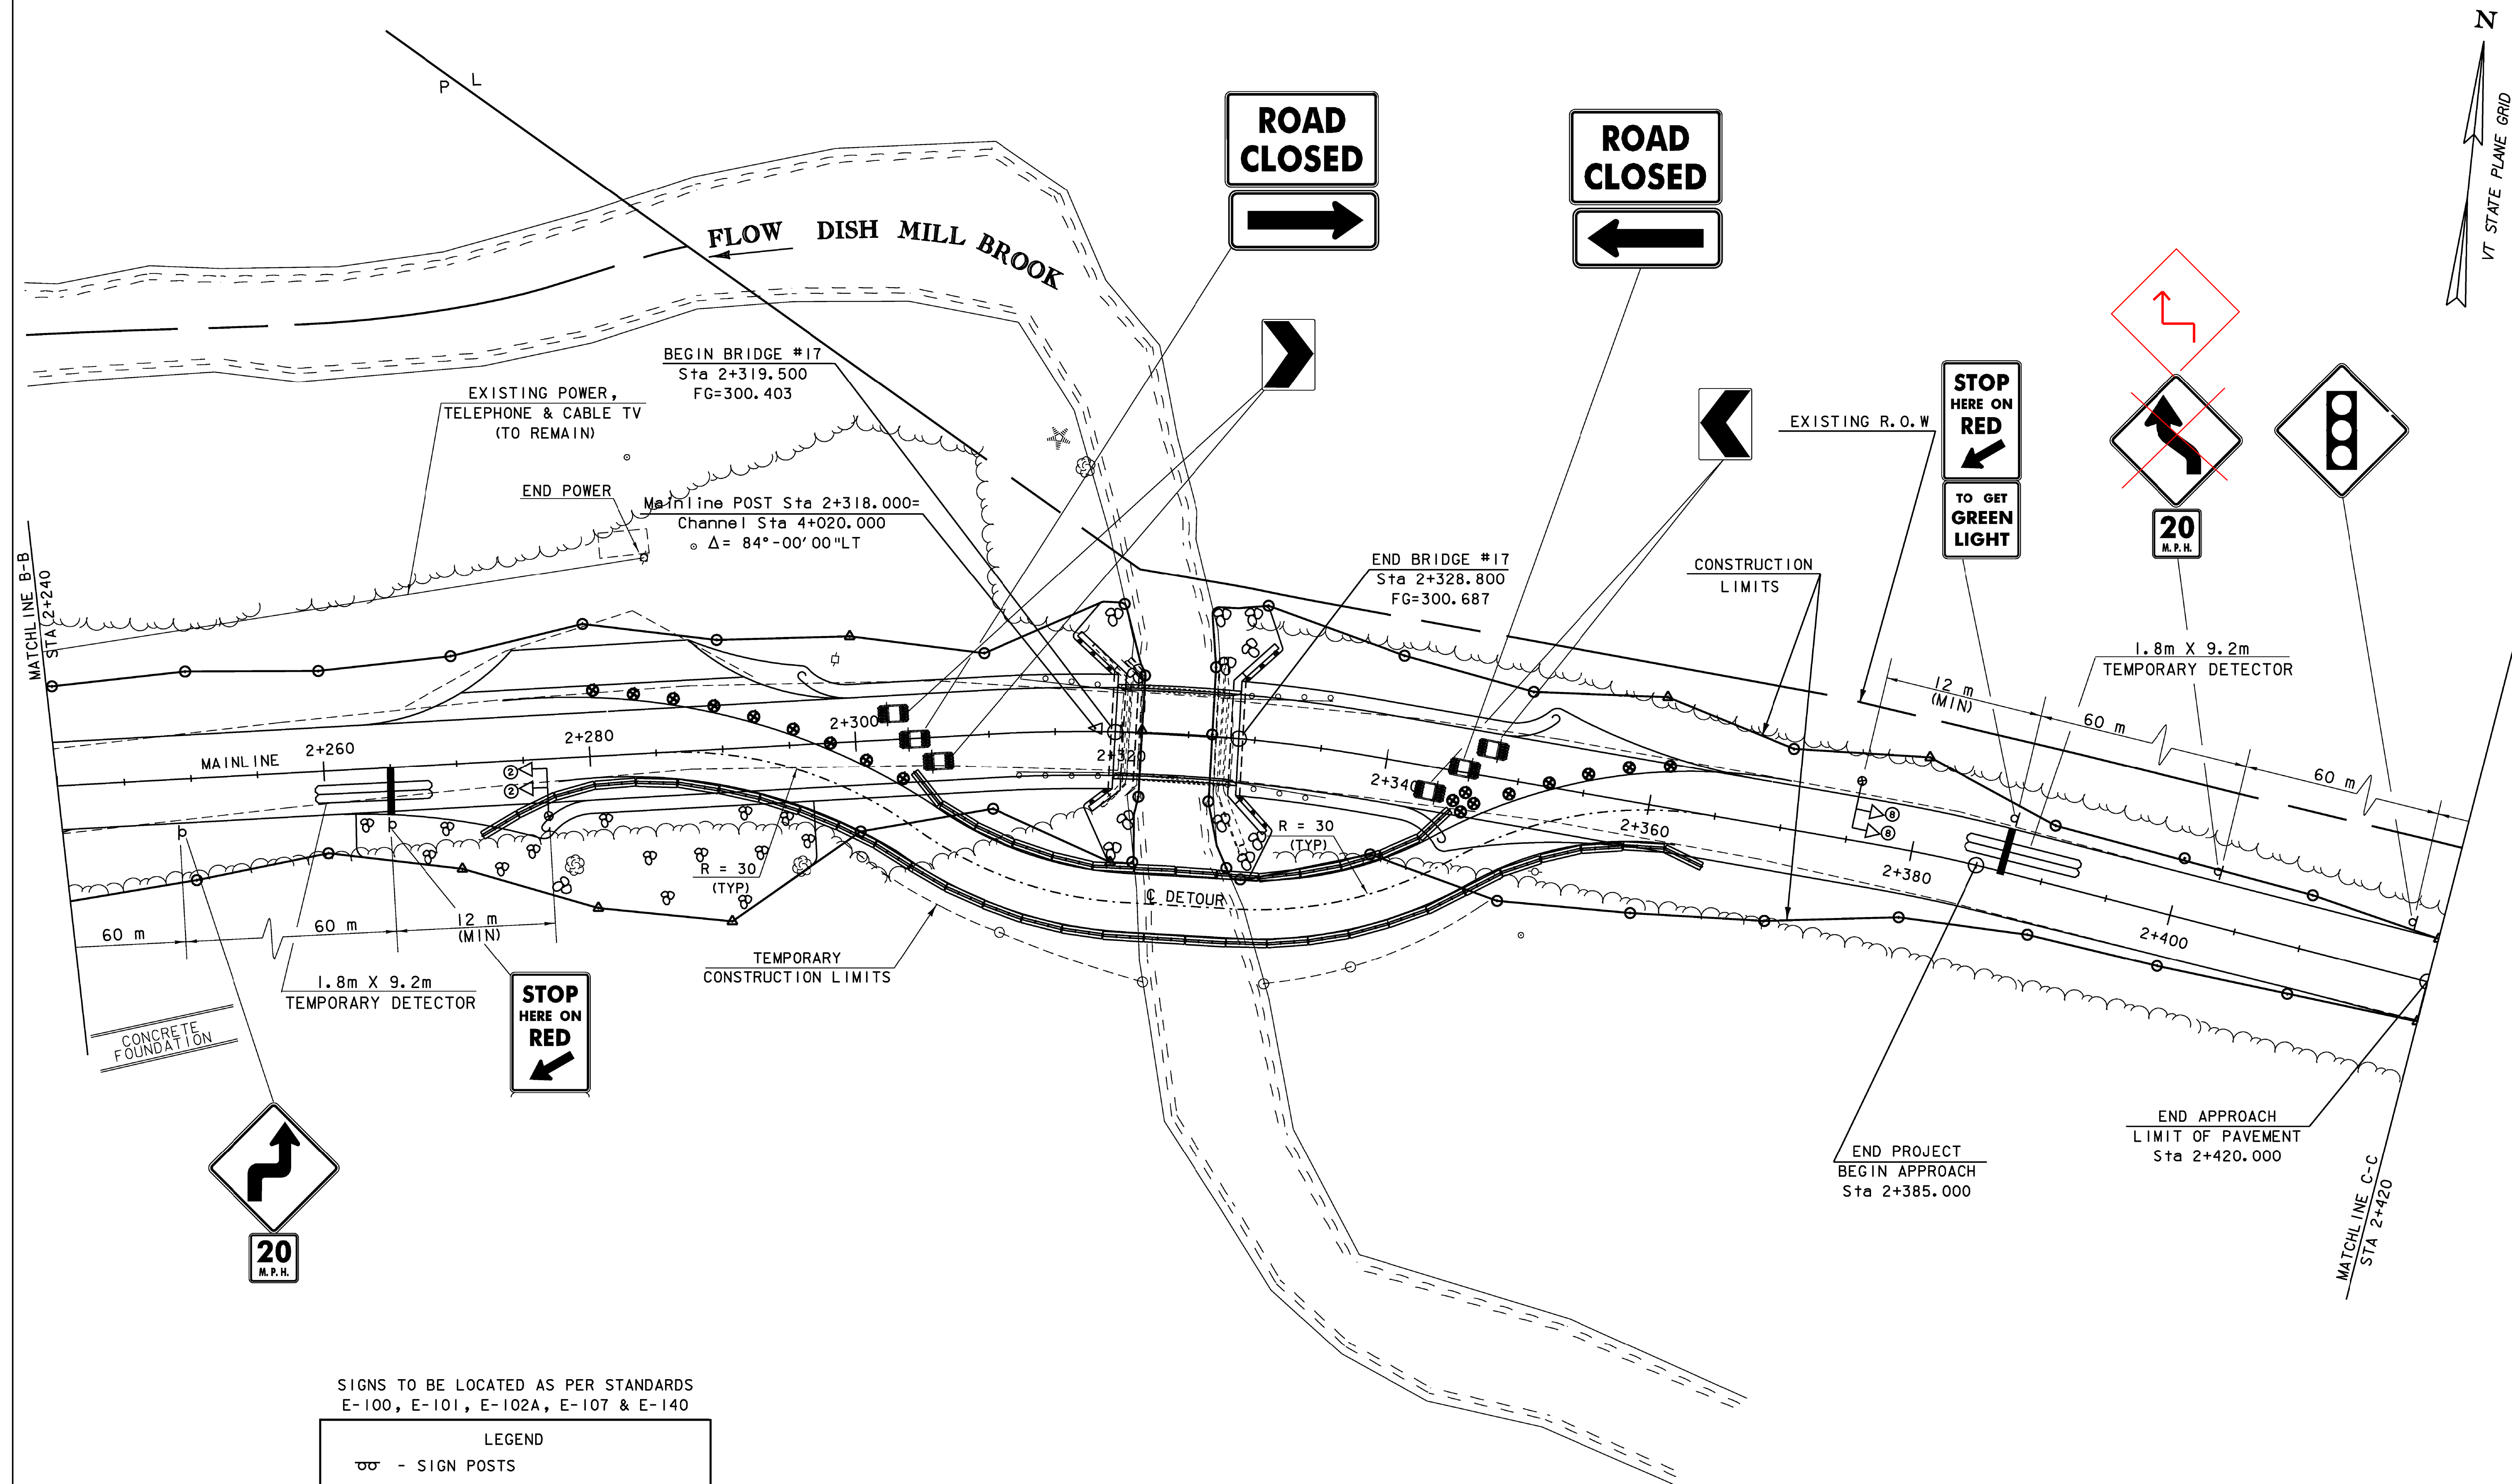

SIGNS TO BE LOCATED AS PER STANDARDS
E-100, E-101, E-102A, E-107 & E-140

LEGEND	
	- SIGN POSTS
	- TYPE III BARRICADES (MOD.)
	- TEMP. TRAFFIC BARRIER
	- REFLECTORIZED BARREL
	- TEMPORARY SIGNAL LIGHTS

DATUM	
VERTICAL	NAVD88
HORIZONTAL	NAD83 (92)

TRAFFIC CONTROL SHEET 3

NTS

THE TOWN OF BURKE OWNS ALL AFFECTED
EXISTING LAND BETWEEN STA 2+150.000 AND
2+420.000 SOUTH OF THE ROADWAY

PROJECT: BURKE	PROJECT NO.: BRZ 1447 (15)
DESIGN FILE NAME: 87e043\Structures\se043bdr.dgn	PLOT DATE: 10-MAR-2008
IPARM FILE NAME: se043detour3.l	SURVEY DATE: 12/95
SURVEYED BY: A. MYERS	DRAWN BY: T. ANDERSON
SQUAD LEADER: C. P. WILLIAMS	SHEET: 22 OF 81
TRAFFIC CONTROL SHEET 3	