


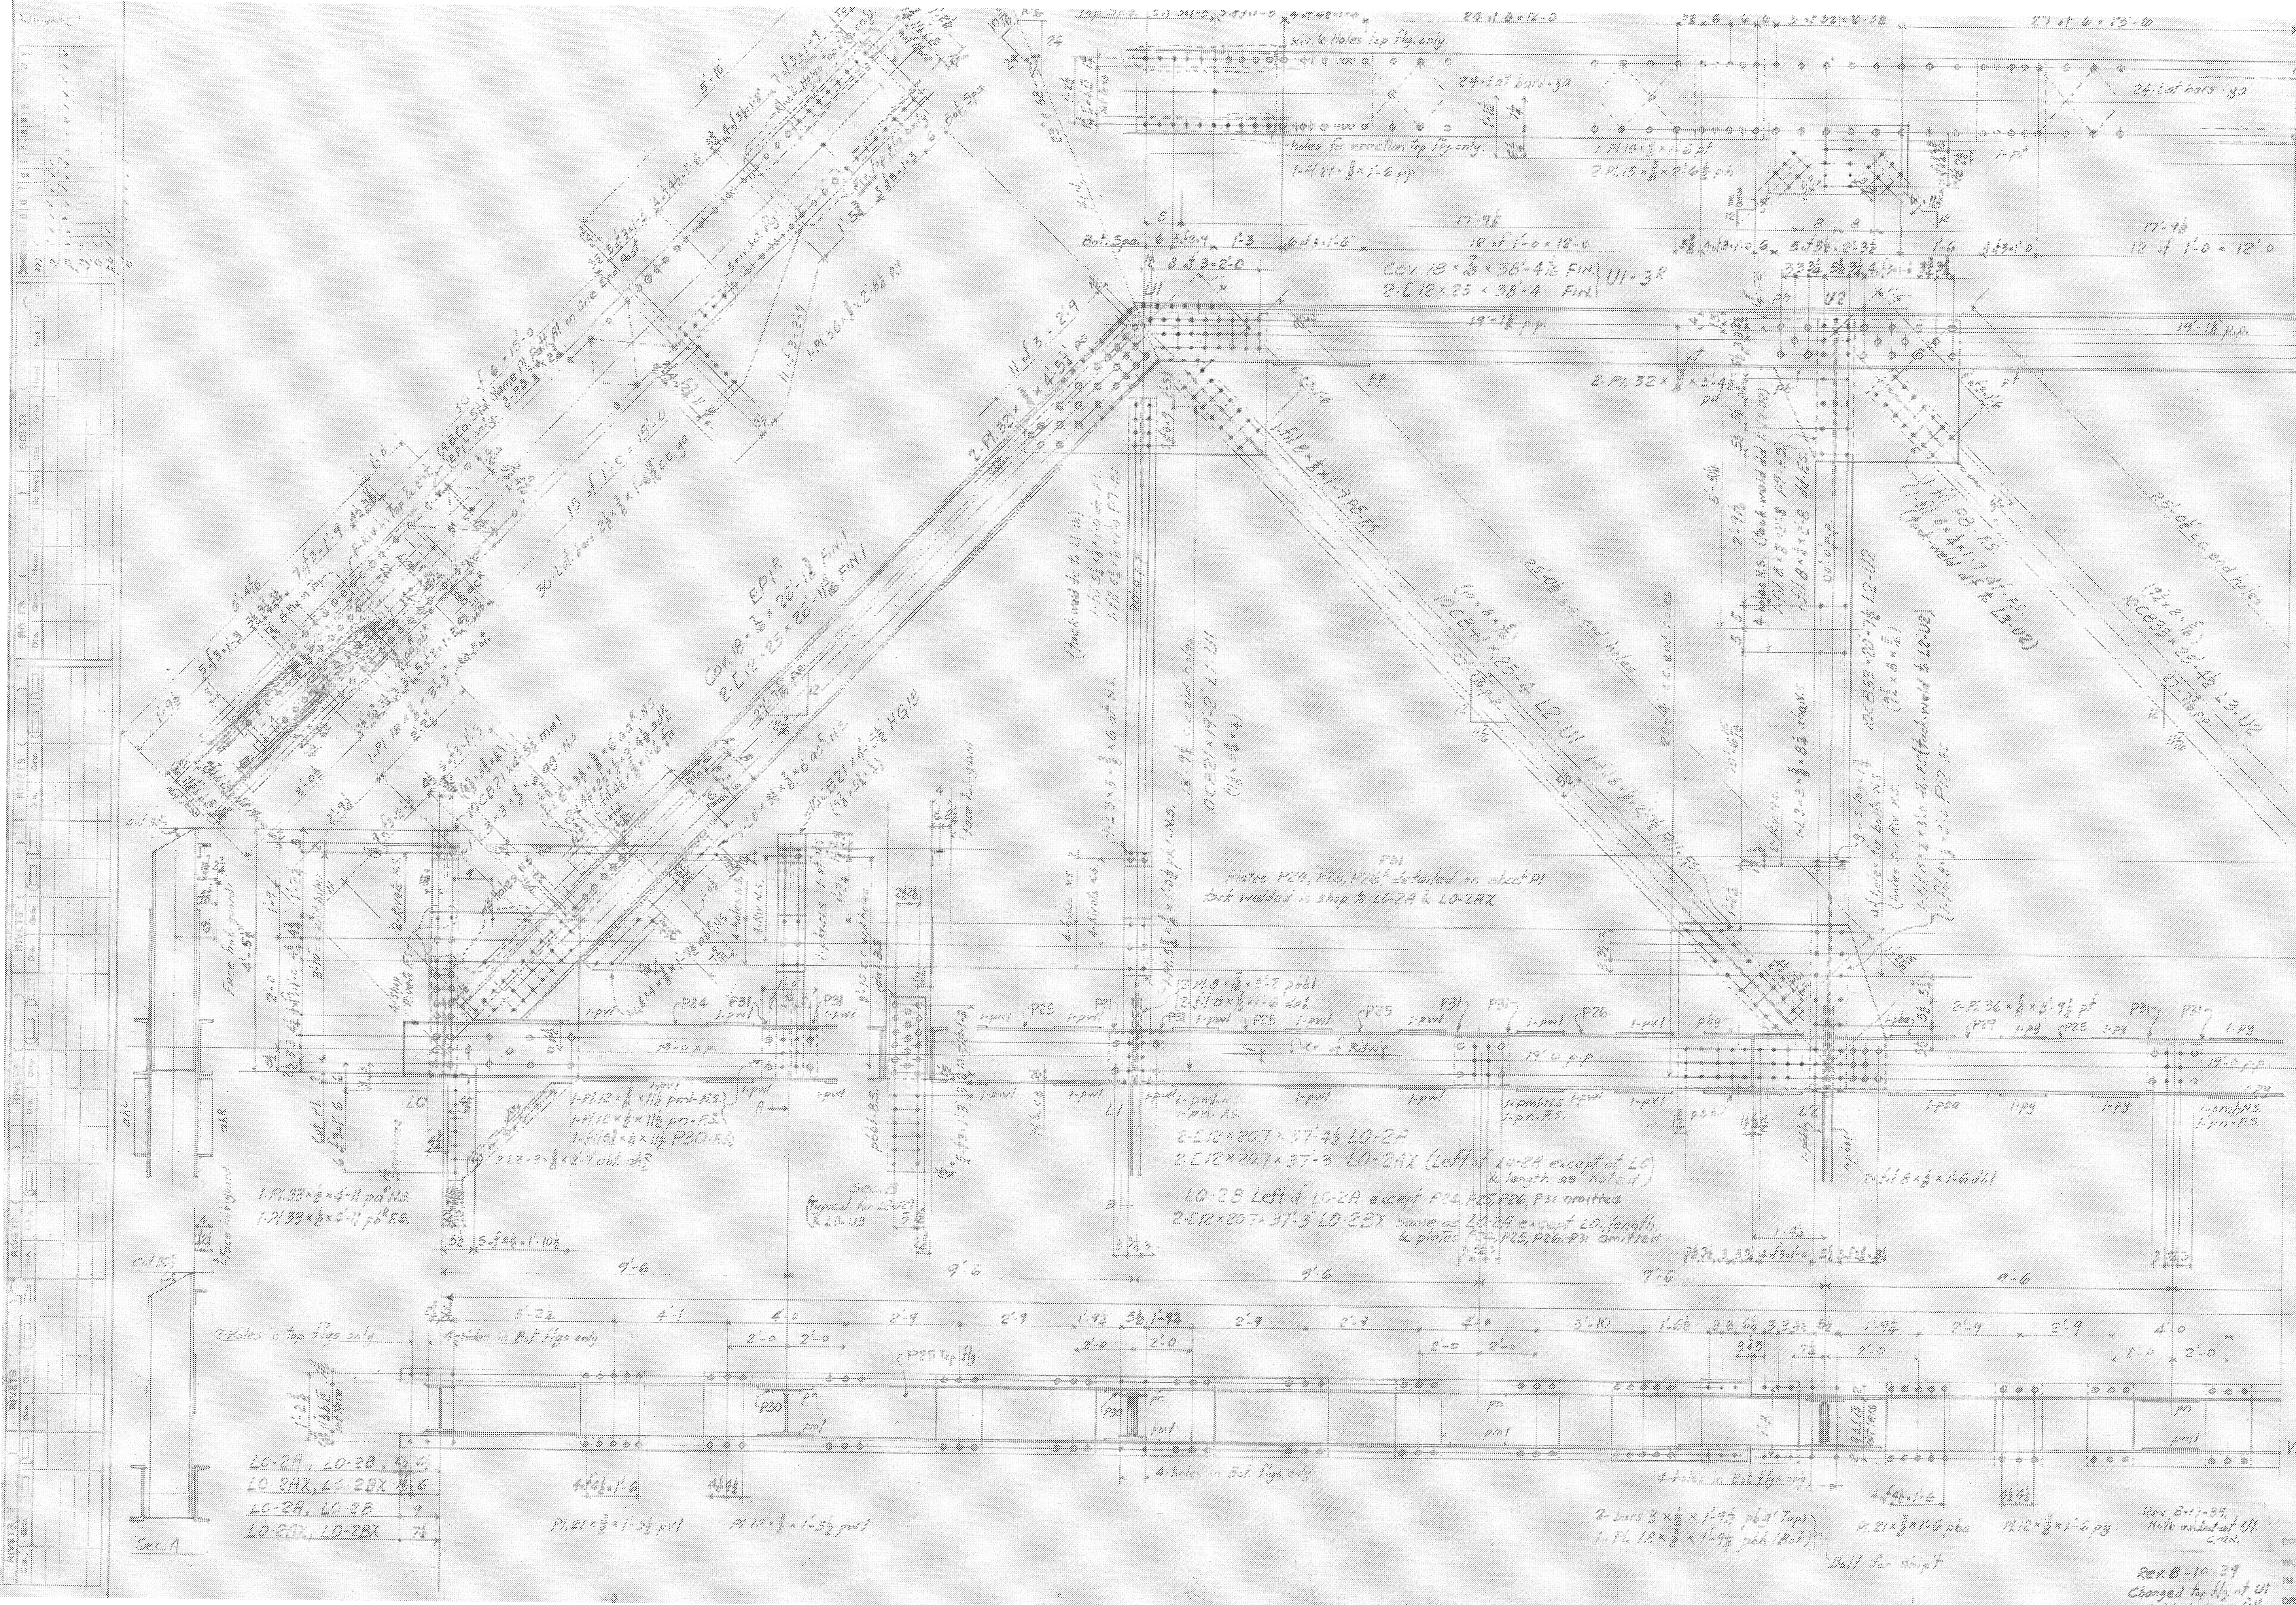

POWNA
BRZ 144(19) C/2
REFERENCE SHEET 9 OF 18
SHEET 99 OF 108

STATE OF VERMONT
VILLAGE BRIDGE, NORTH POWNA
STATE FLOOD PROJECT 1-B
TRUSSES

AMERICAN BRIDGE COMPANY
DRAWINGS MADE AT: CHICAGO PLANT
WORK FABRICATED AT: CHICAGO PLANT
IN CHARGE OF: Maloney
DRAWN BY: C. J. N. DATE 7-21-39

Rev B-10-29
Changed by H. J. U.
Welded base fillers