


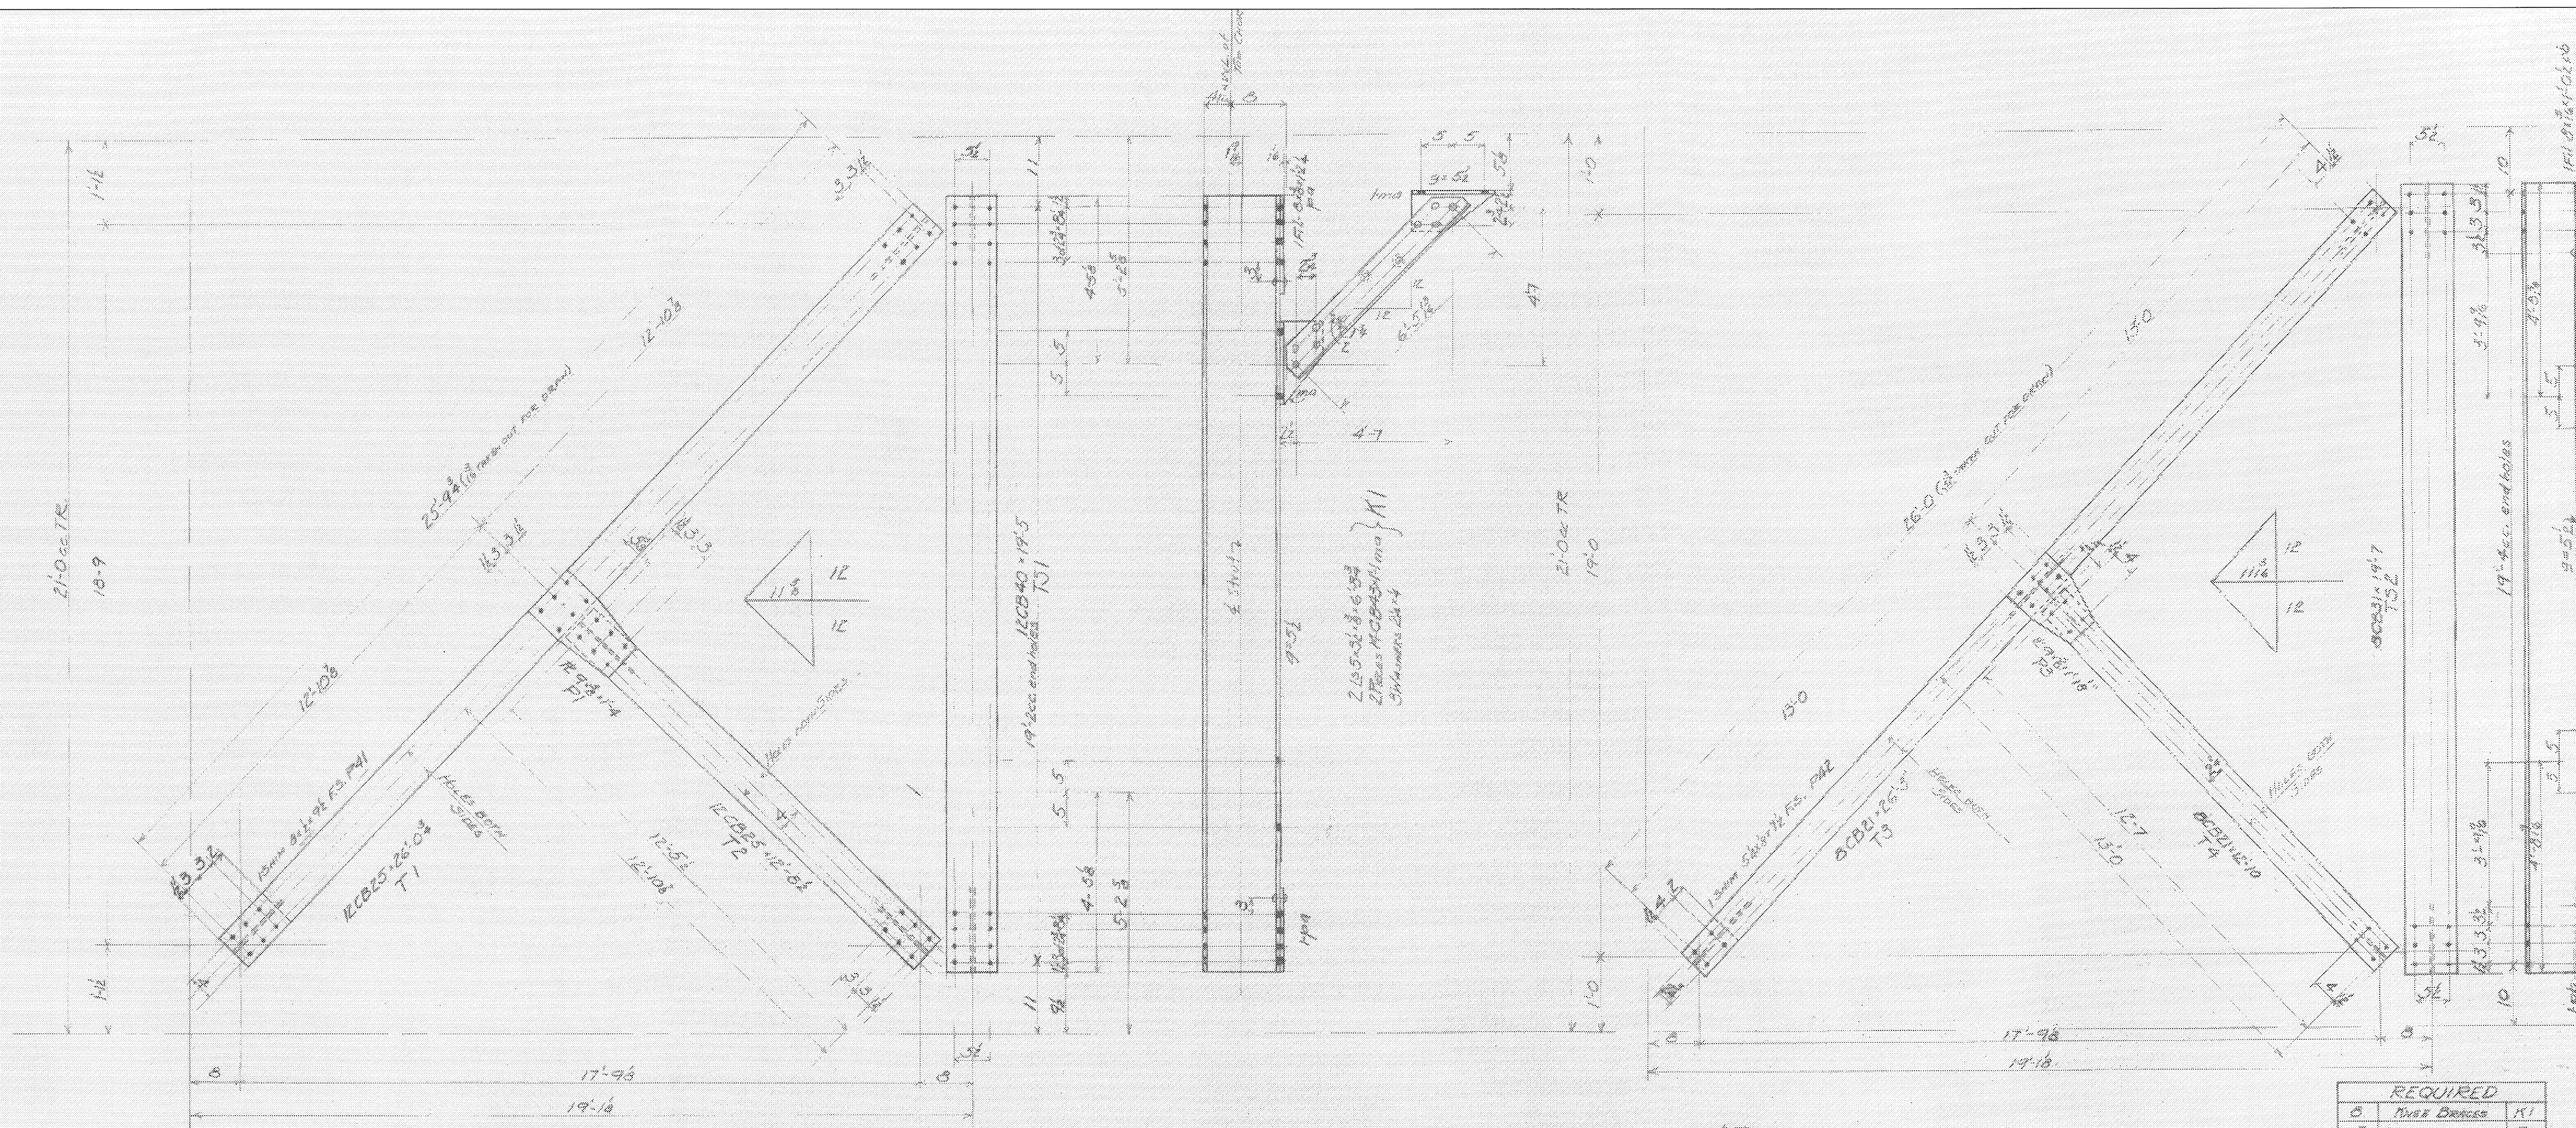

REQUIRED		
5	KNIFE BRACES	KN
8	TOP LATERALS	TL
6	"	FL
4	TOP STRUTS	TS
8	PLATES	PL
2	"	PF
4	KNIFE BRACES	KN
3	TOP LATERALS	TL
4	"	FL
2	TOP STRUTS	TS
4	PLATES	PL
2	"	PF
16	SHIMS	SH
10	SHIMS	SH

POWNA
BRZ 144(19) C/2
REFERENCE SHEET 10 OF 18
SHEET 100 OF 108

NOTES
RIVERS 8" HOLES 16"
SURFACES RIVETED IN CONTACT IN SHOP OR
FIELD - YES
PAINT - YES

Rev. 8-25-38
Added Notes in Dolt Flg. T52
" Fl. pb " "
" P41, P42

STATE OF VERMONT
VILLAGE BRIDGE, NORTH TOWNAL
STATE FLOOD PROJECT 1B
TOP LATERALS

AMERICAN BRIDGE COMPANY

DRAWINGS MADE AT ELMIRA PLANT

WORK FABRICATED AT ELMIRA PLANT

IN CHARGE OF MALONEY

DRAW. MADE BY JGD DATE 7/2/39

DRAW. CHECKED BY H. C. DATE 7-2-39

ORDER No.	SHEET No.
HZ6833	2