

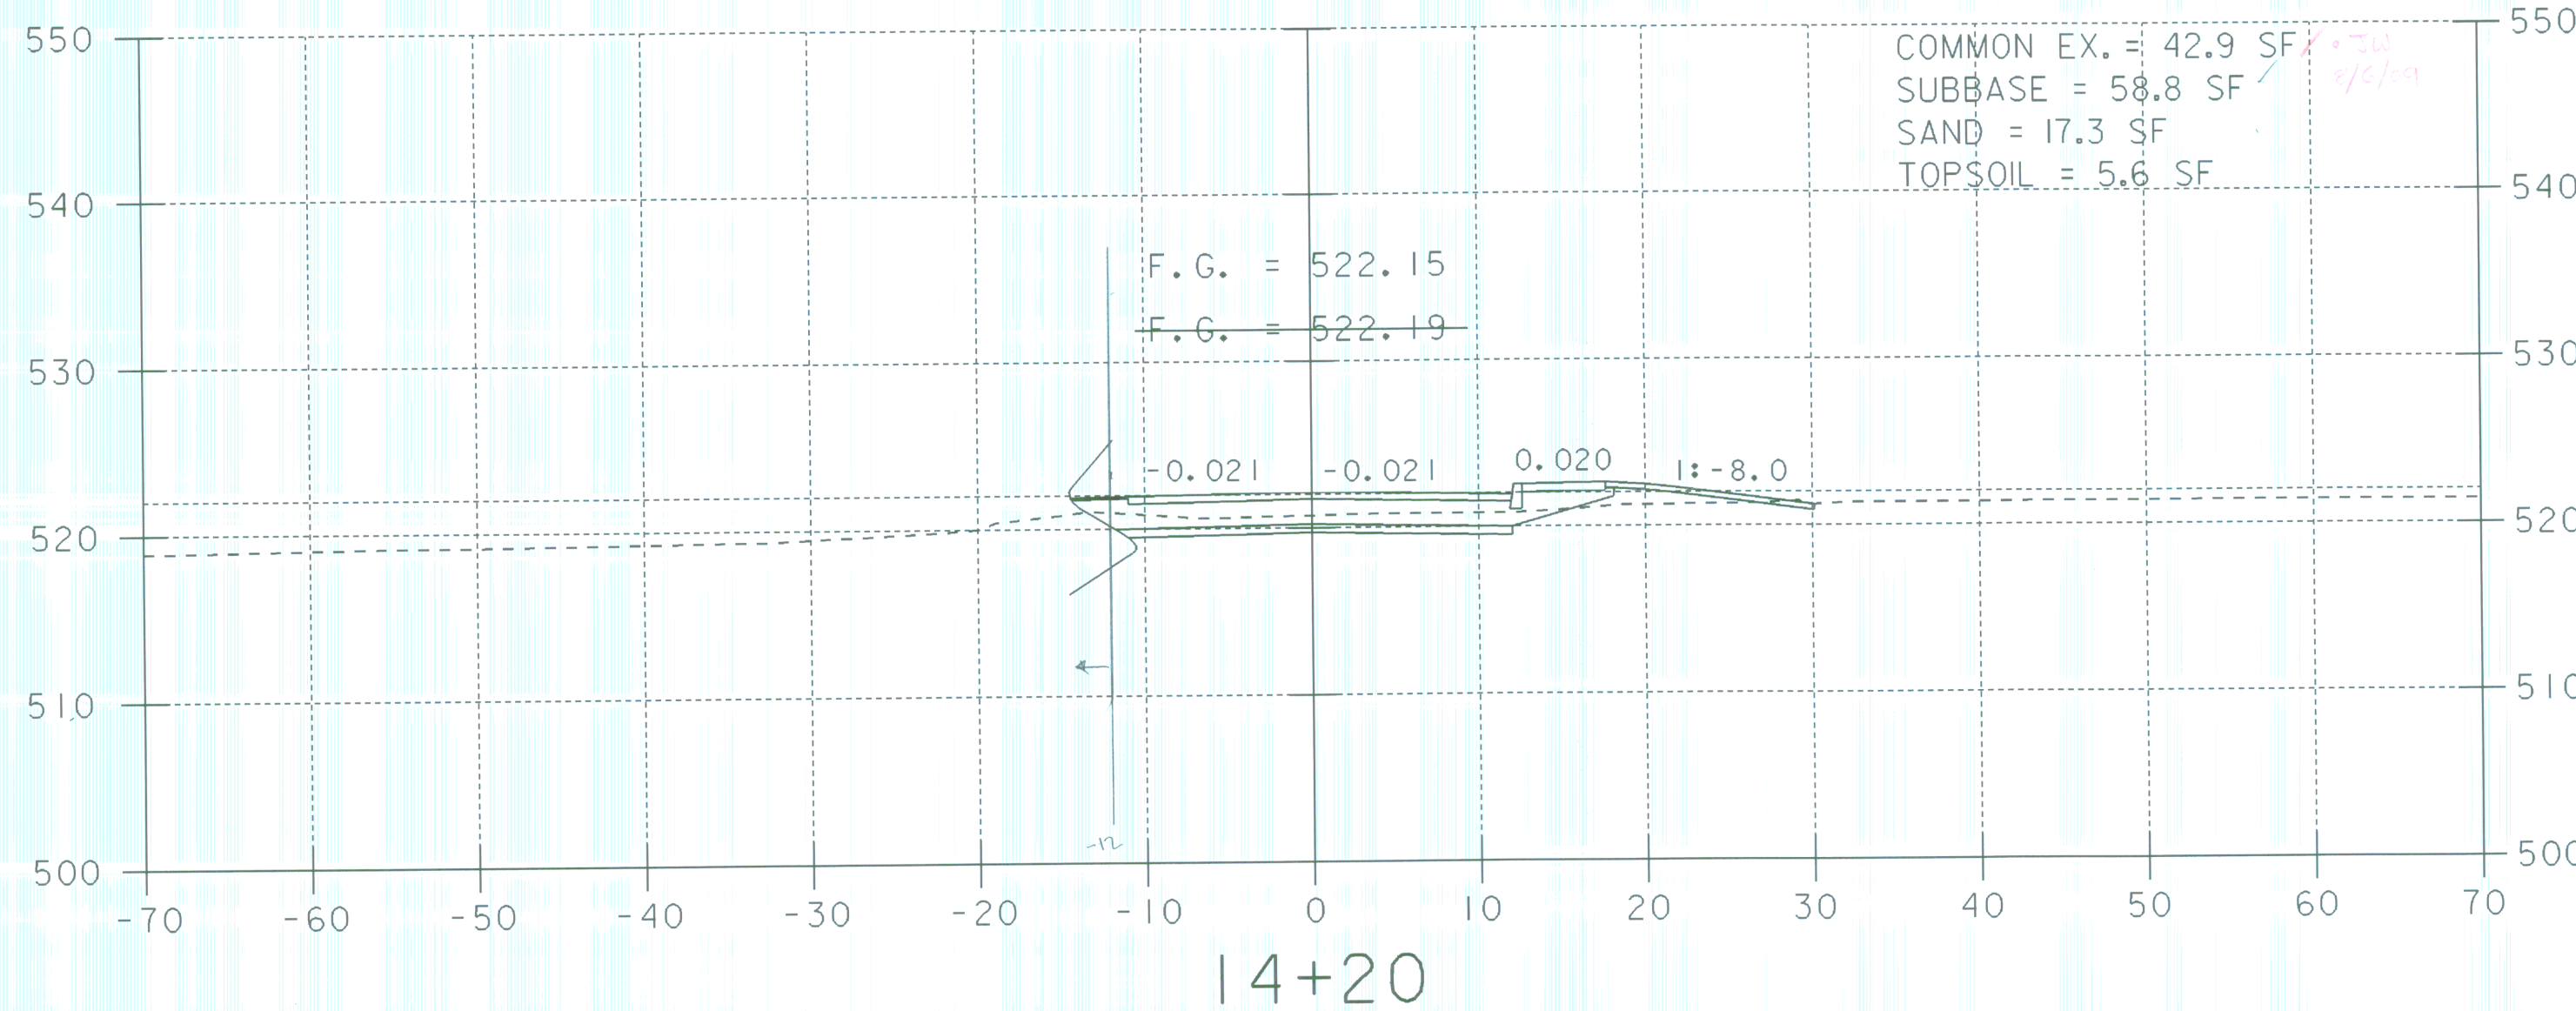
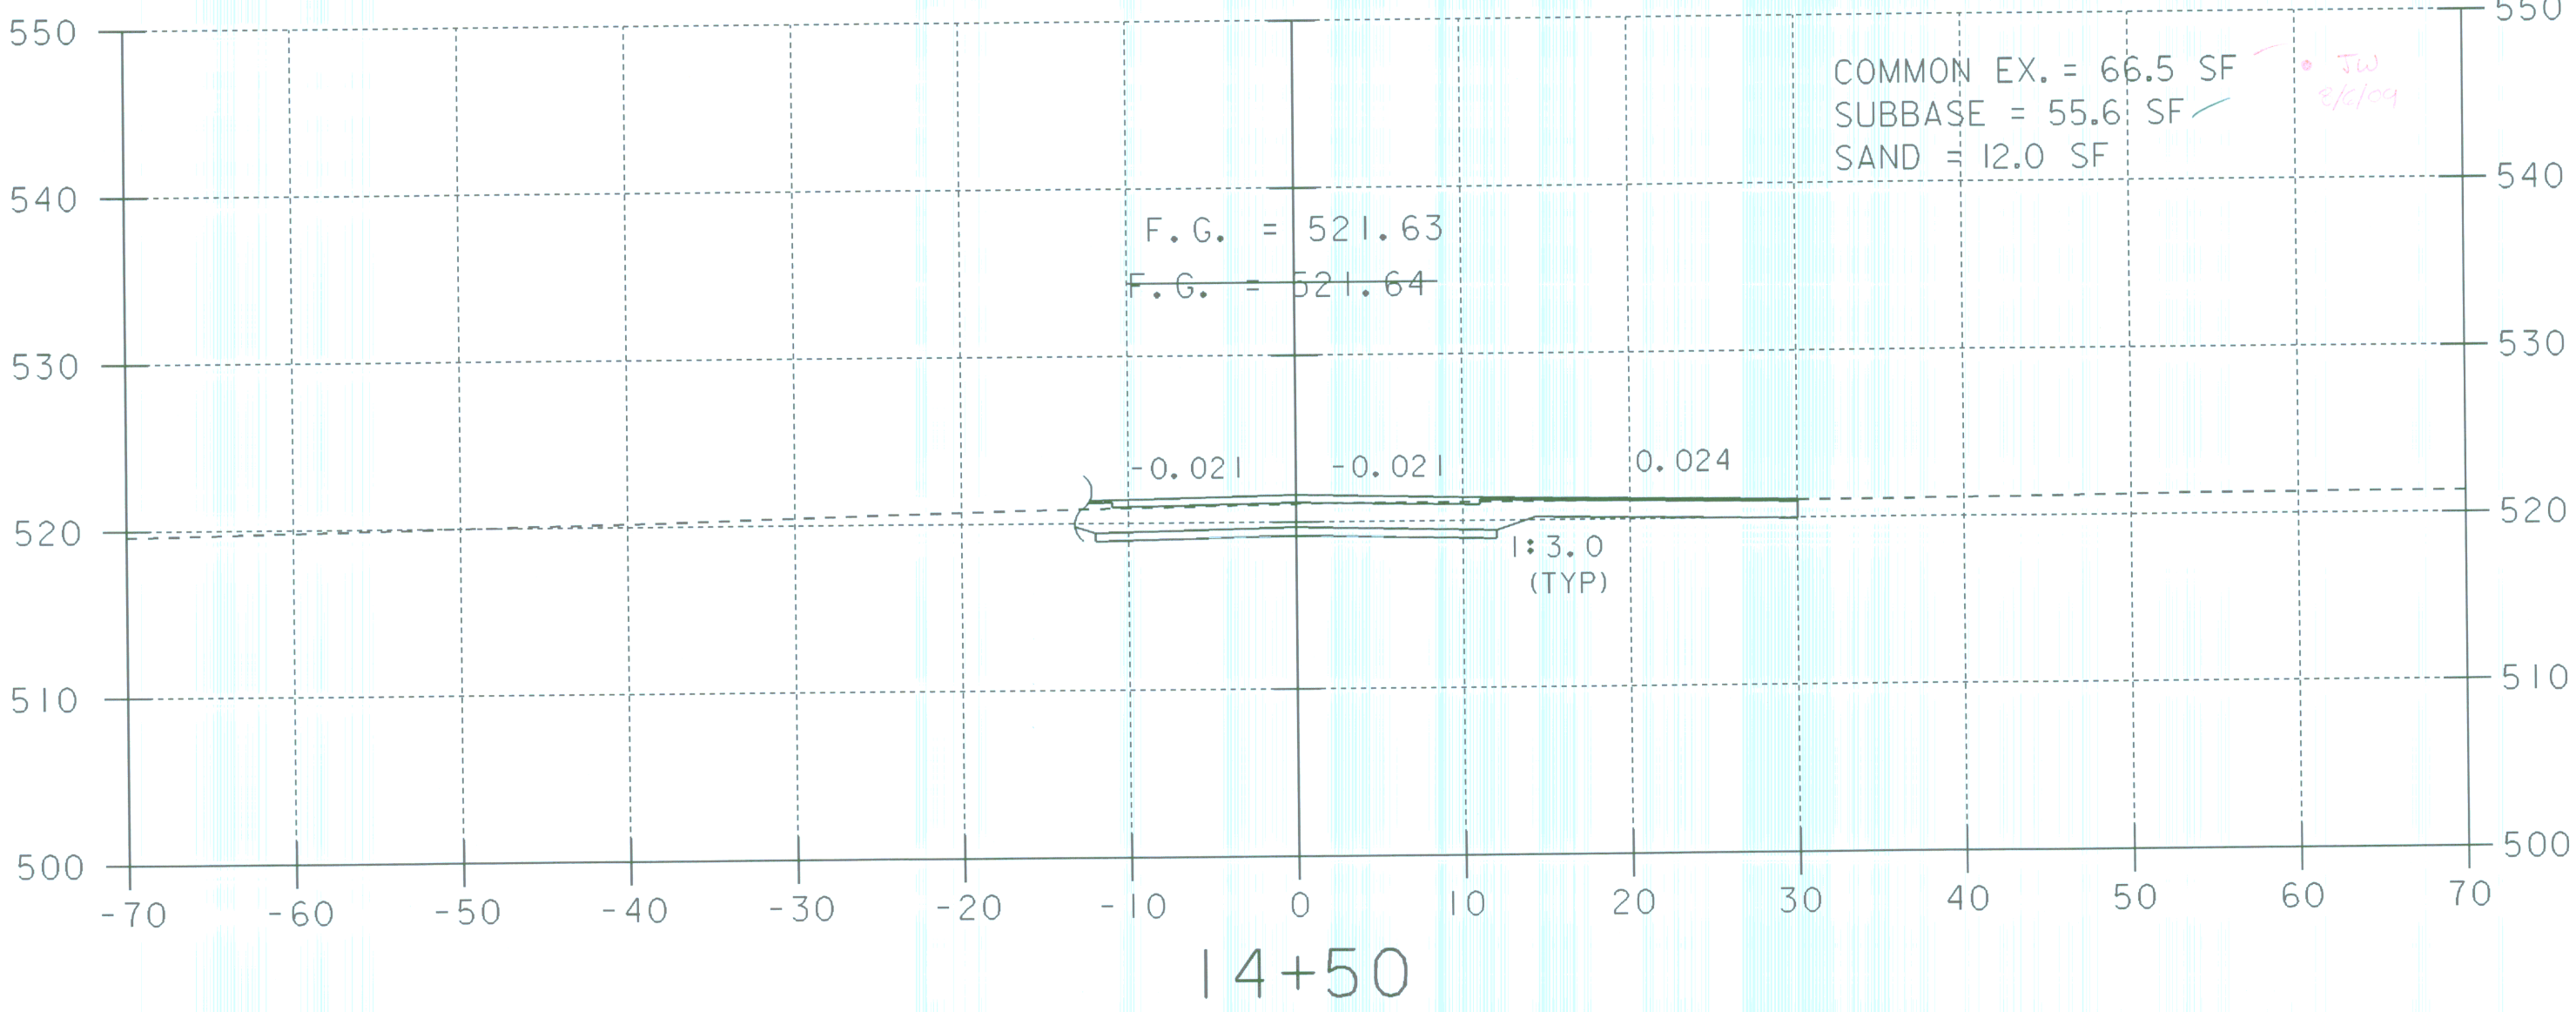


SEE SHEET 83 FOR
WWTF SIDELINE APPROACH NEAR
RR TRACKS

STA. 14+28.00 RT.
END PORTLAND CEMENT CONCRETE SIDEWALK, 5 INCH

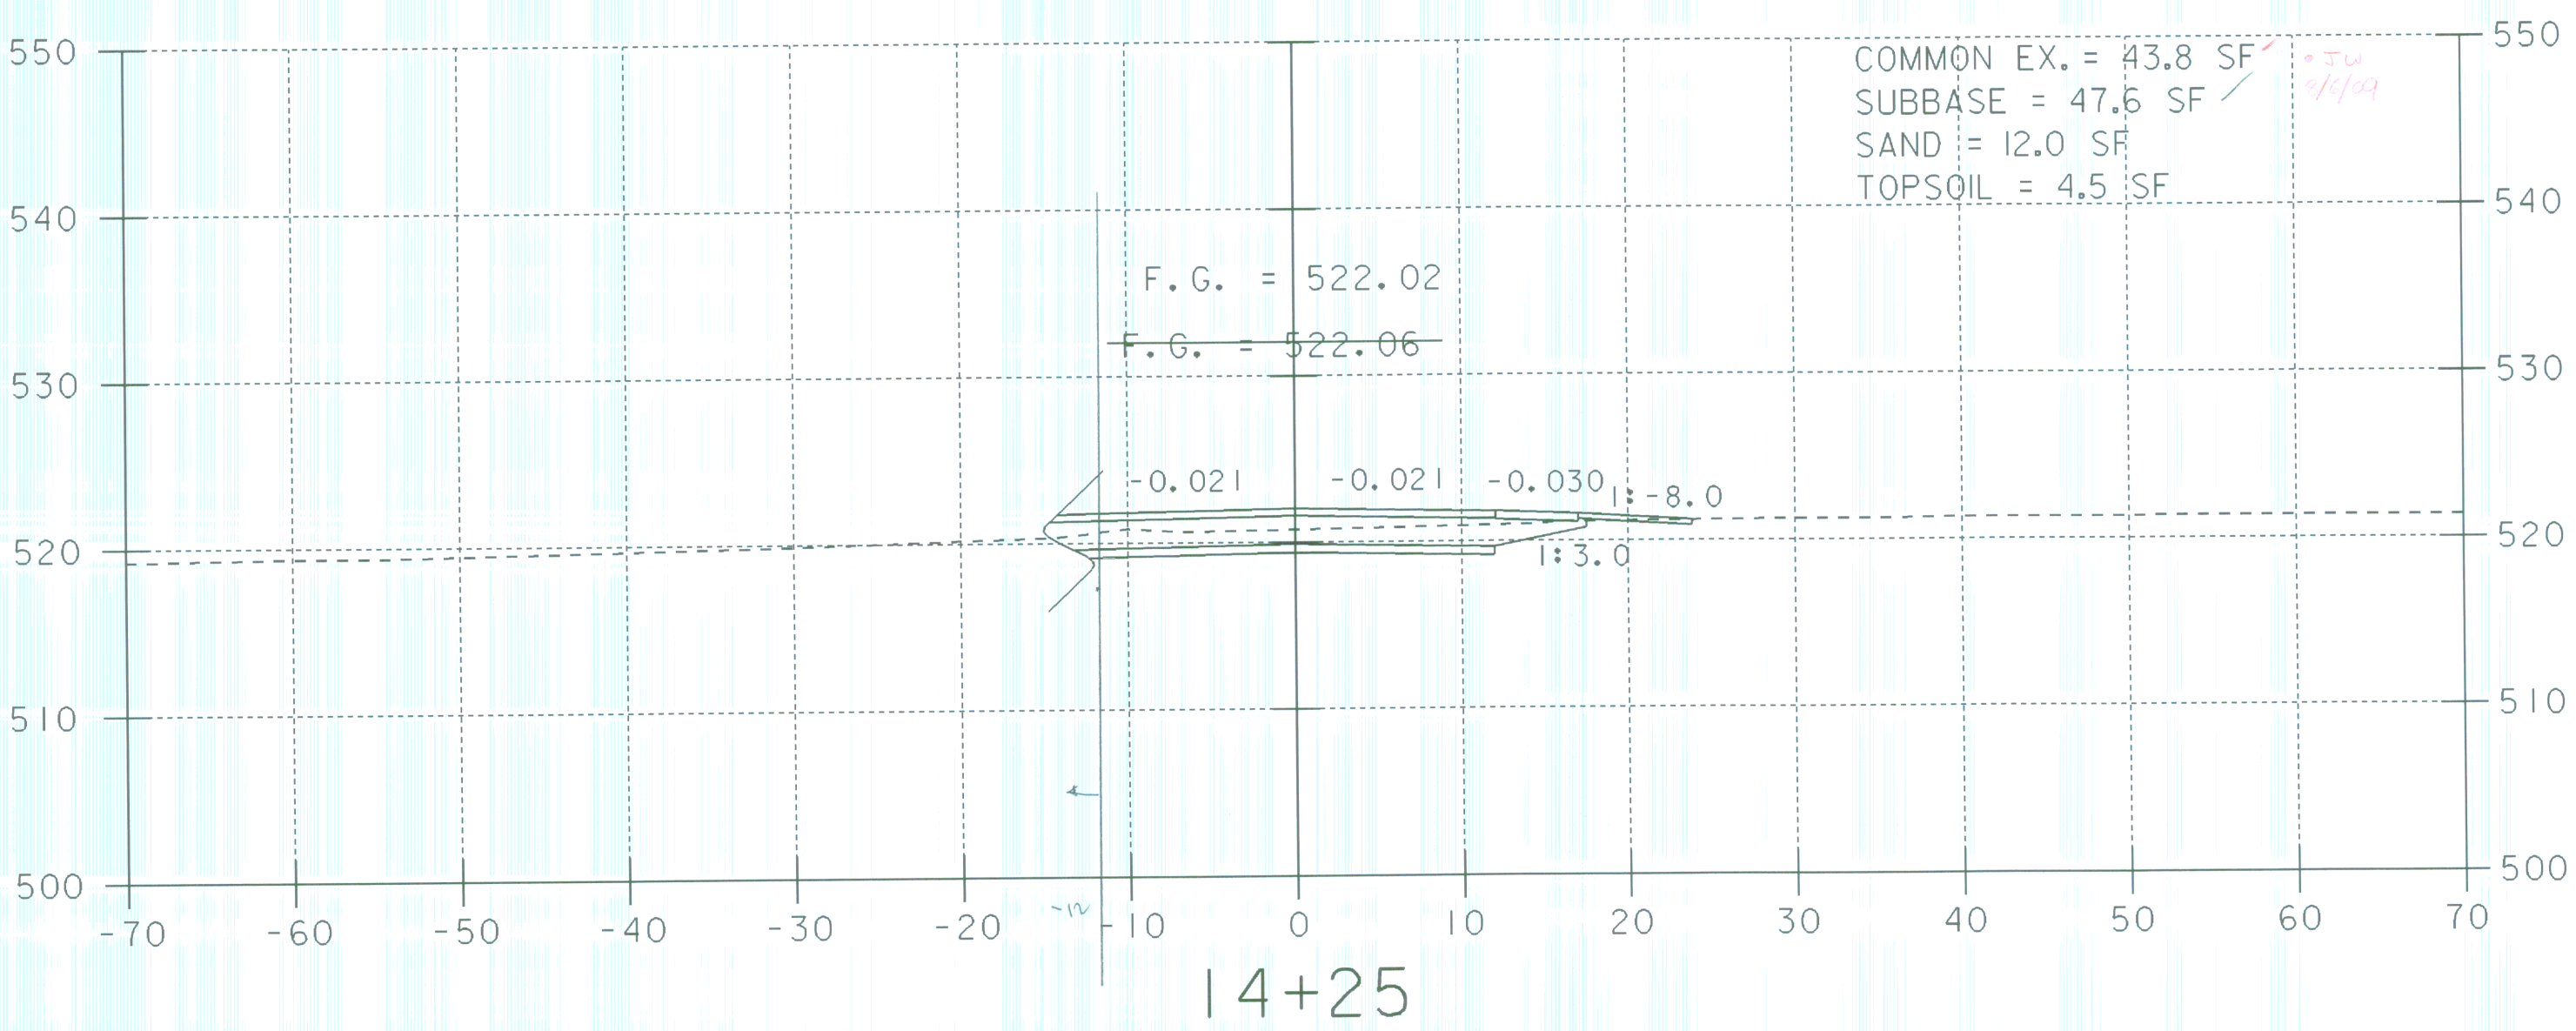

STA. 14+20.00 RT.
END CAST-IN-PLACE CONCRETE CURB, TYPE B

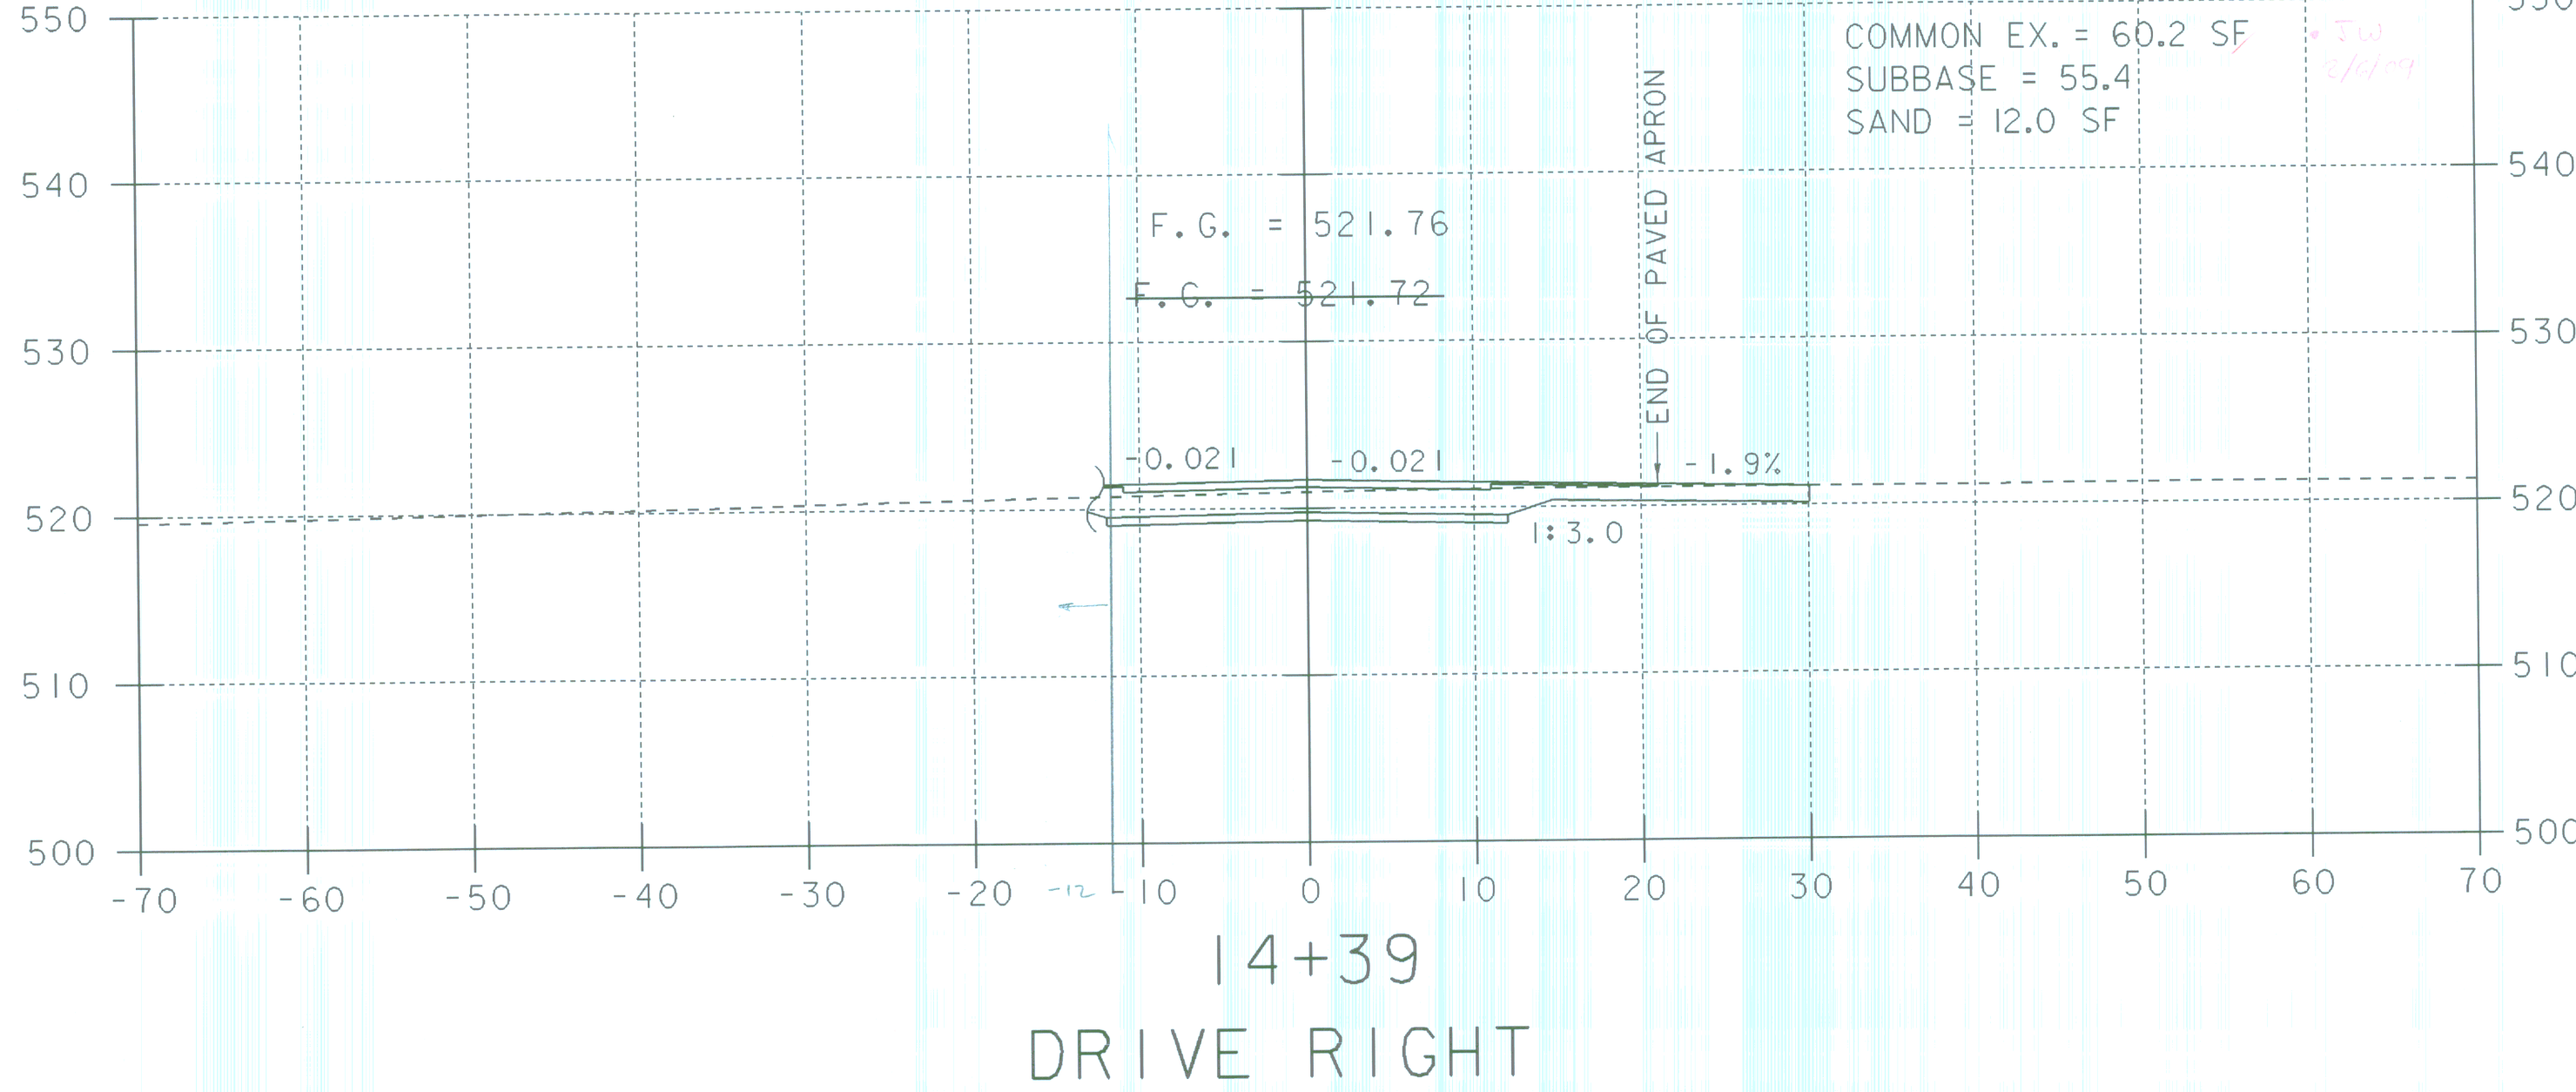

SHEET NAME: MAINLINE CROSS SECTIONS	
PROJECT NAME: POWNAL	HIGHWAY NO.: TH 24
PROJECT NUMBER: BRZ 144(I9) C/2	BRIDGE NO.: 41
	OVER: HOOSIC RIVER
FILE NAME: 87e045/str/se045xs2.dgn	PLOT DATE: 19-FEB-2009
PROJECT MANAGER: R. WHITCOMB	DRAWN BY: J. GILMORE
DESIGNED BY: C. CARLSON	IPARM NAME: se045mx6.i
	SHEET 72 OF 108