
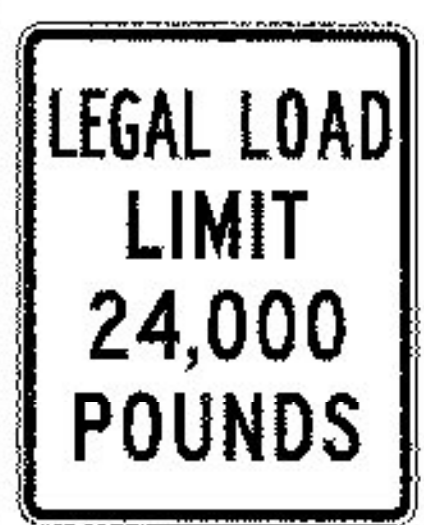


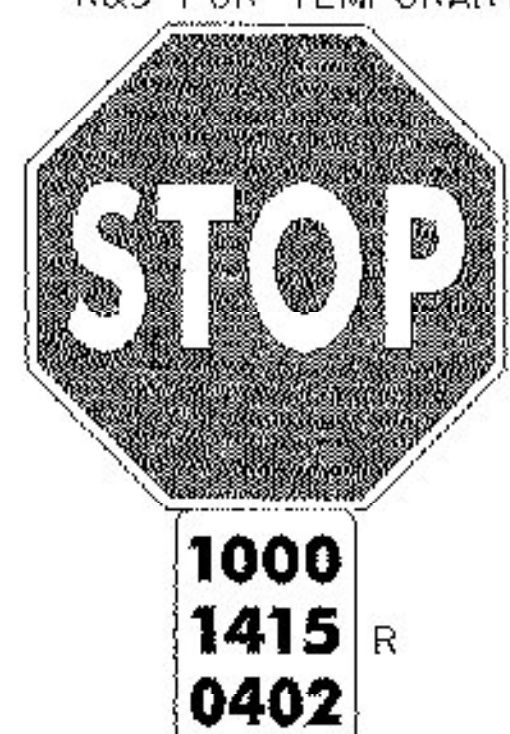

← DIST 4 ROCHESTER UNIT

TRAFFIC SIGN SHEET
nts

- TRAFFIC SIGNS, TYPE A
STA. 50+43 LT (2)
STA. 50+64 RT
- REMOVE SIGNS
STA. 10+07 RT
STA. 50+44 LT (2)
- DURABLE 4" WHITE LINE
STA. 50+30 LT - STA. 52+15 LT
STA. 50+45 RT - STA. 52+15 RT
- DURABLE 4" YELLOW LINE (CENTERLINE)
STA. 50+43 - STA. 52+15
- DURABLE 24" STOP BAR
STA. 50+43 (23')
- DURABLE LETTER OR SYMBOL
STA. 50+51 (STOP)
- ~~TEMPORARY 4" WHITE LINE
STA. 50+30 LT - STA. 52+15 LT
STA. 50+45 RT - STA. 52+15 RT~~
- ~~TEMPORARY 4" YELLOW LINE (CENTERLINE)
STA. 50+43 - STA. 52+15~~
- ~~TEMPORARY 24" STOP BAR
STA. 50+43 (23')~~
- ~~TEMPORARY LETTER OR SYMBOL
STA. 50+51 (STOP)~~

LEGEND
ALL SIGNS AND POSTS WILL BE
NEW UNLESS OTHERWISE NOTED:
R - REMOVE
R&S - REMOVE & SALVAGE
S - SALVAGE
RET - RETAIN

PROJECT: ROCHESTER	PROJECT NO.: BRZ 1444 (20)
DESIGN FILE NAME: 87e048/Structures/se048trf.dgn	PLOT DATE: 25-JAN-2002
IPARM FILE NAME: se048trf.j	SURVEY DATE: 3/91
SURVEYED BY: GILMAN	DRAWN BY: P.G. JARVIS
SOUND LEADER: C.P. WILLIAMS	SHEET: 11 OF 52
TRAFFIC SIGN SHEET	