


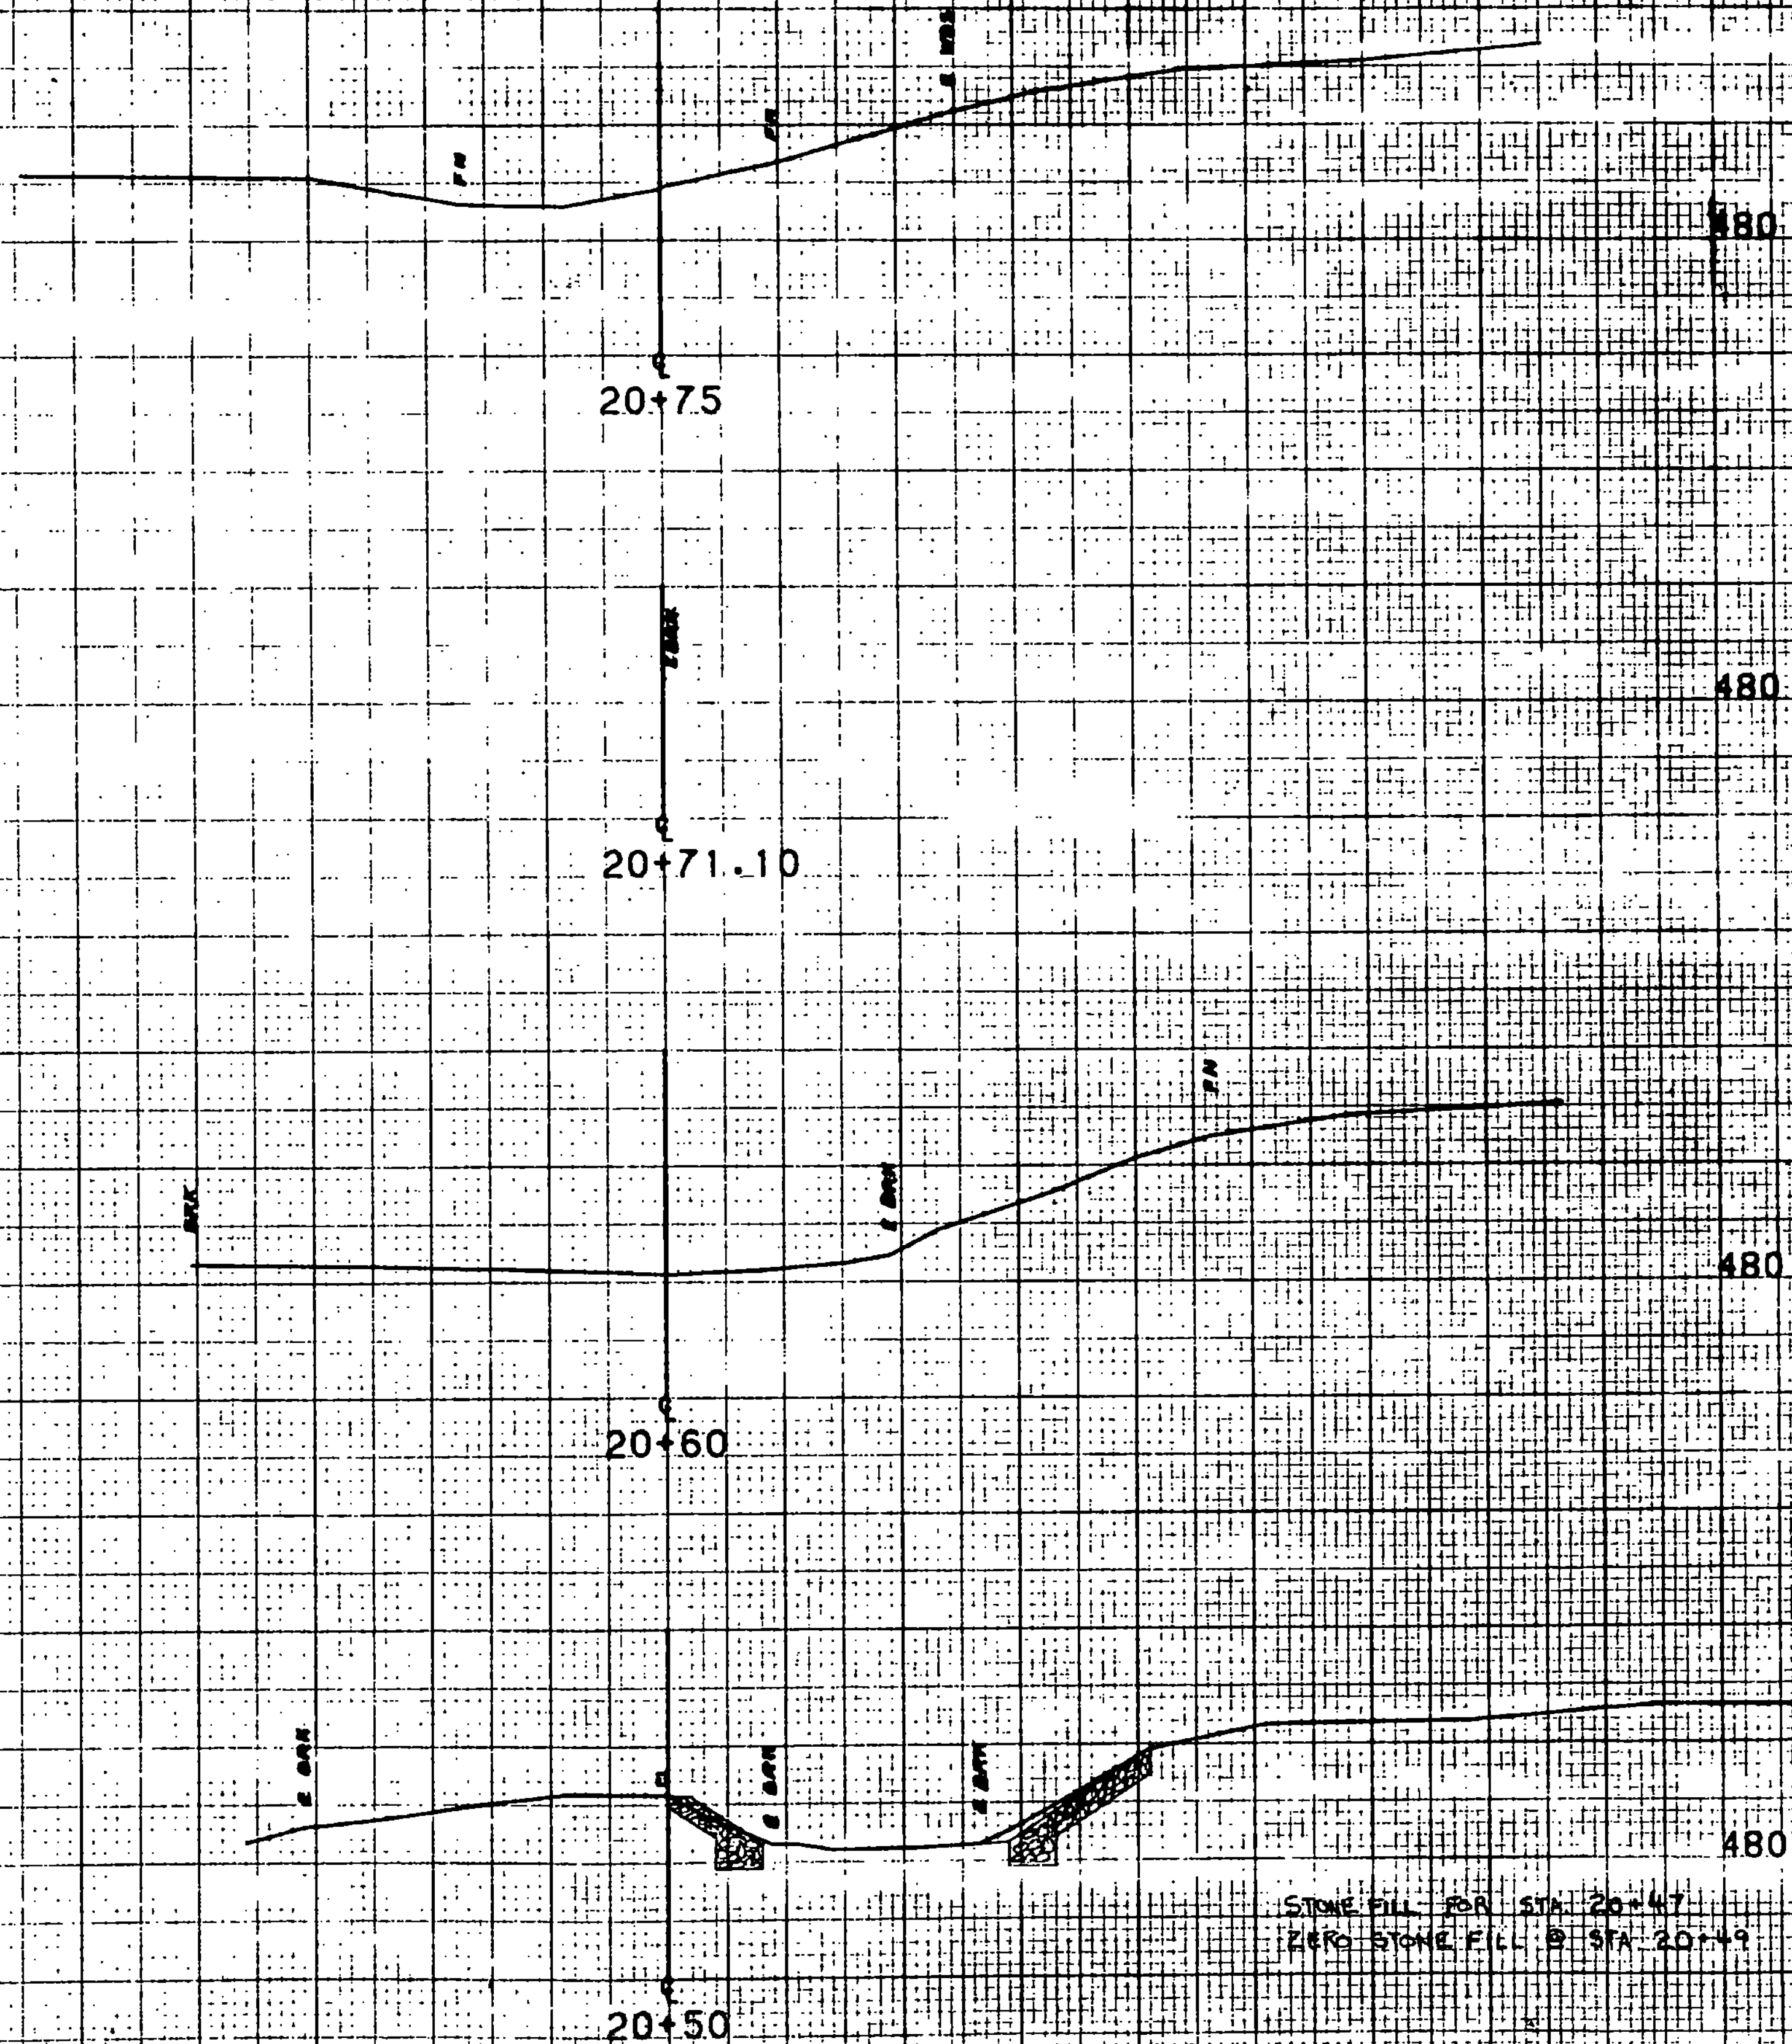

STONE FILL FOR STA. 20+47
ZERO STONE FILL @ STA. 20+49

FROM STA.	20+50	TO STA.	20+75
PROJECT NAME	CHELSEA CHANNEL SECTION		
NO.	13808	DATE	10/19/77
CHECKED BY	DATE	02/20/01	
SCALE	1" = 10 FEET		