
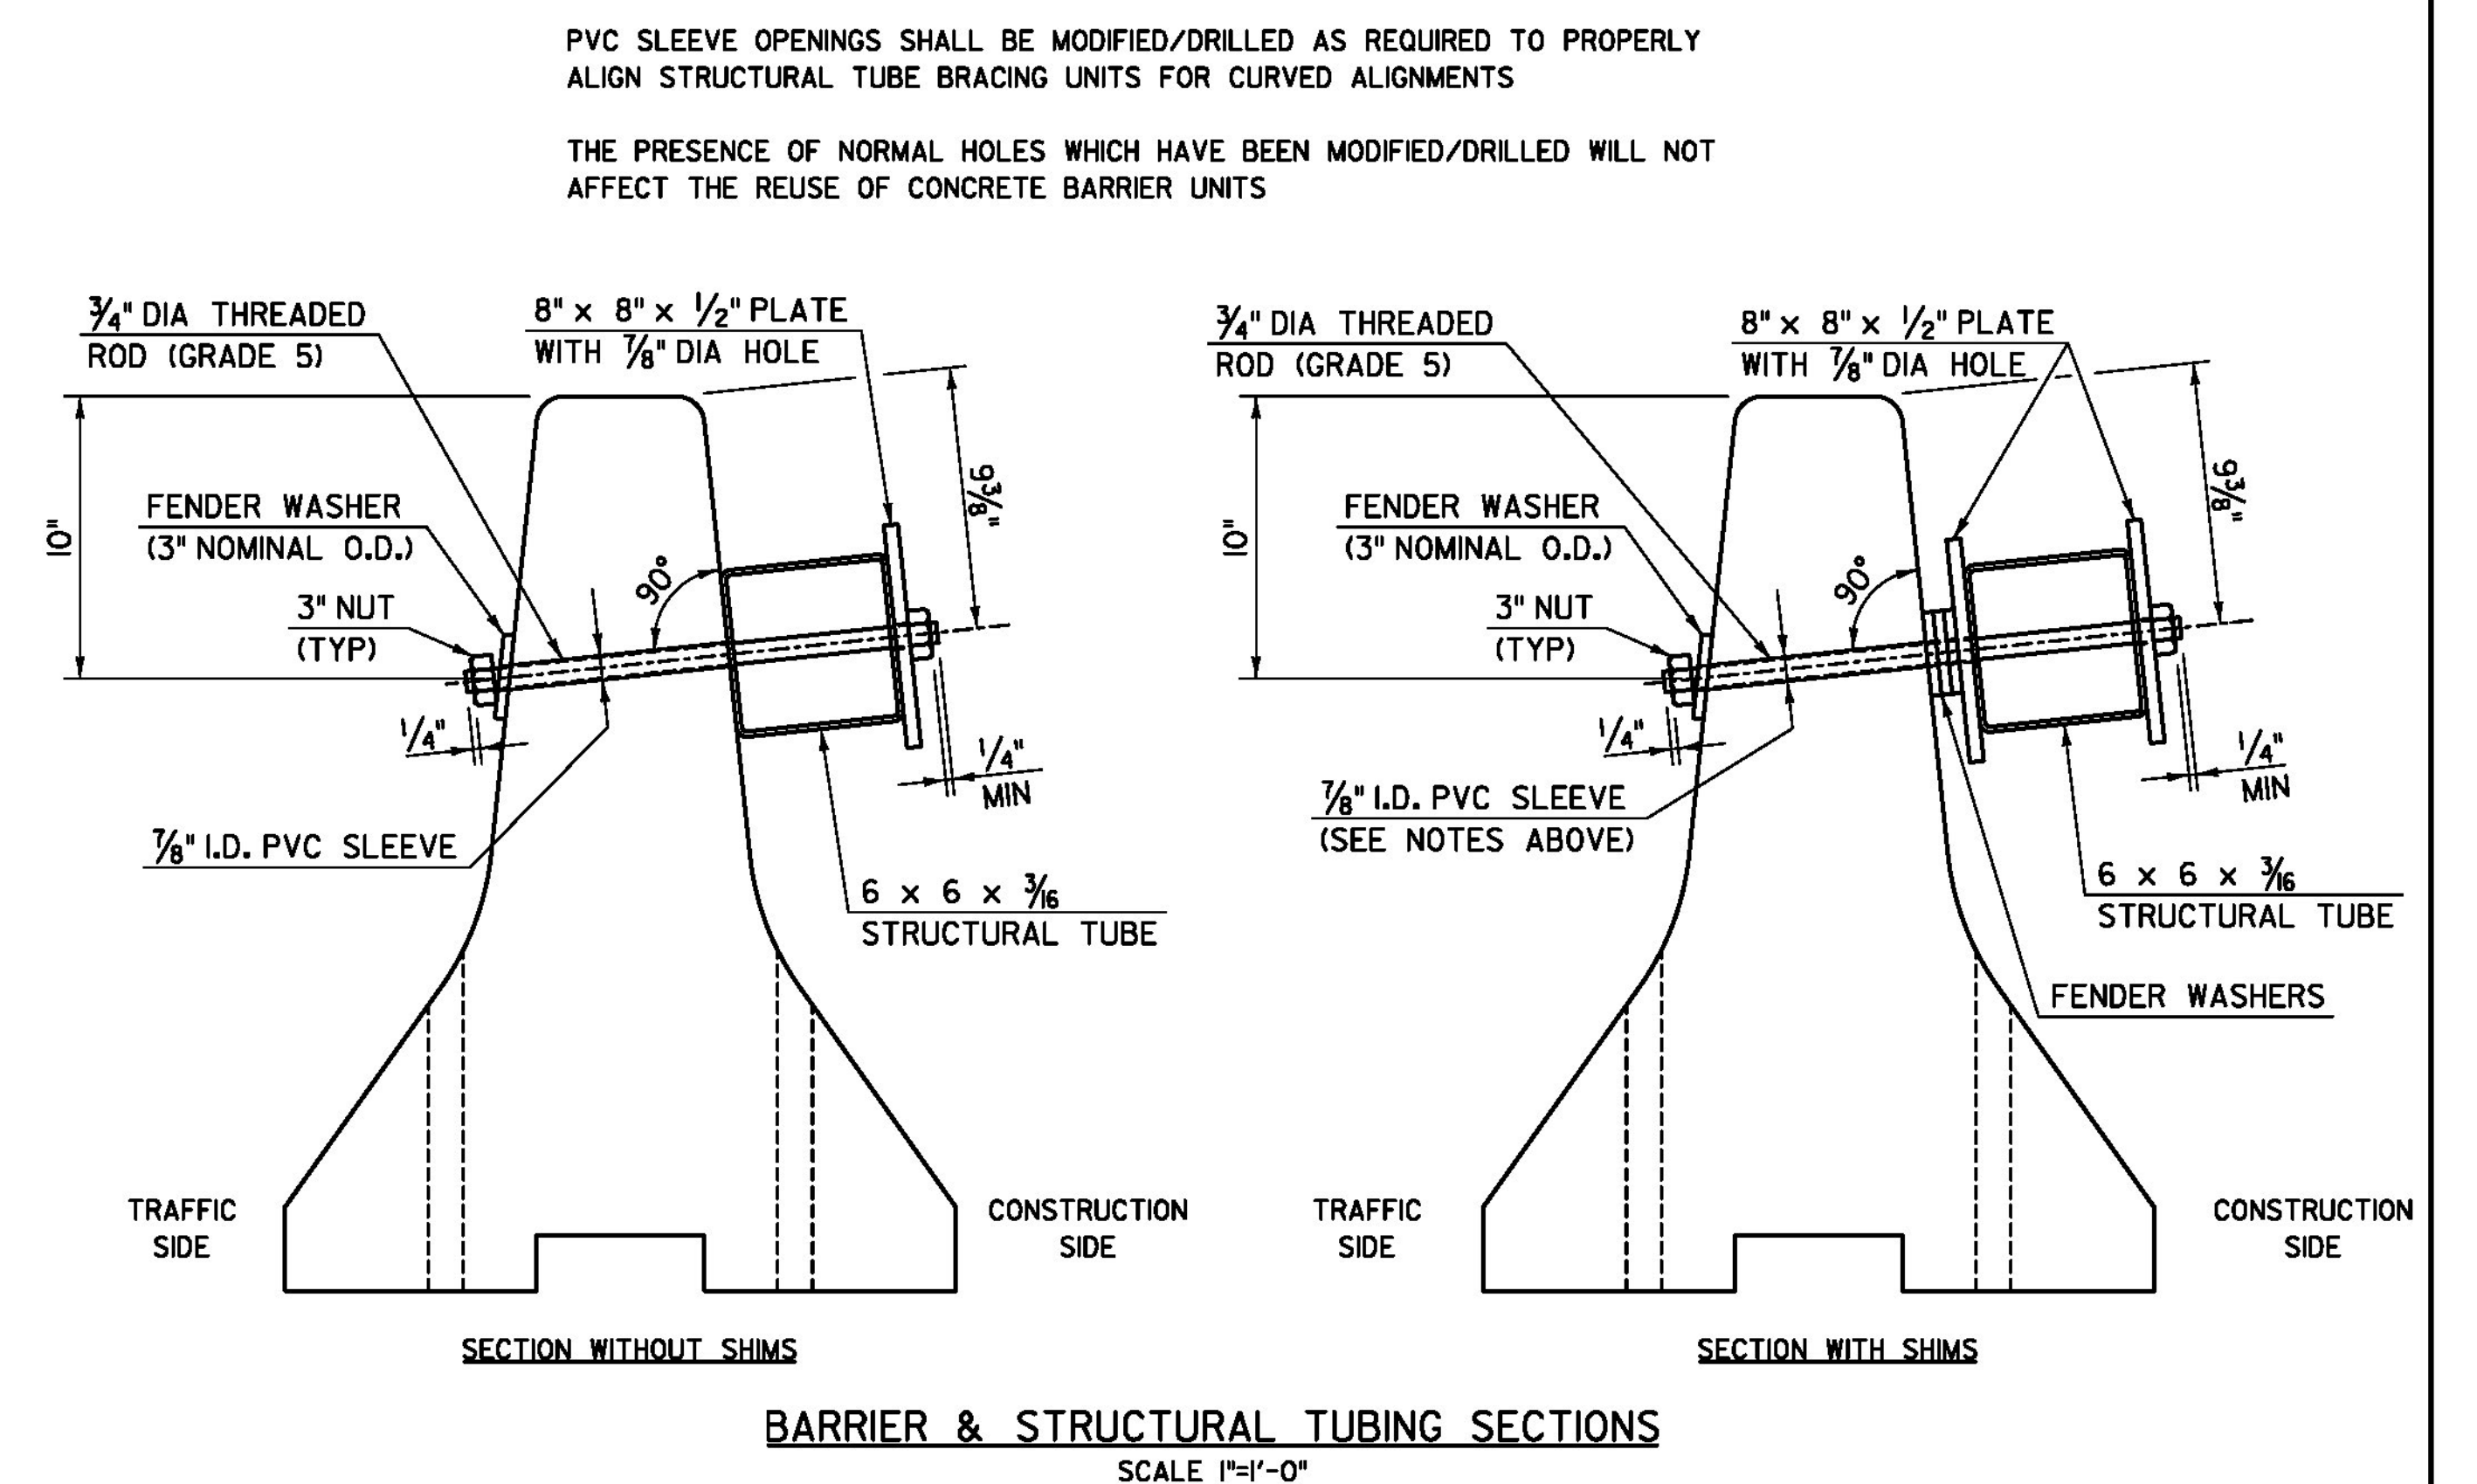
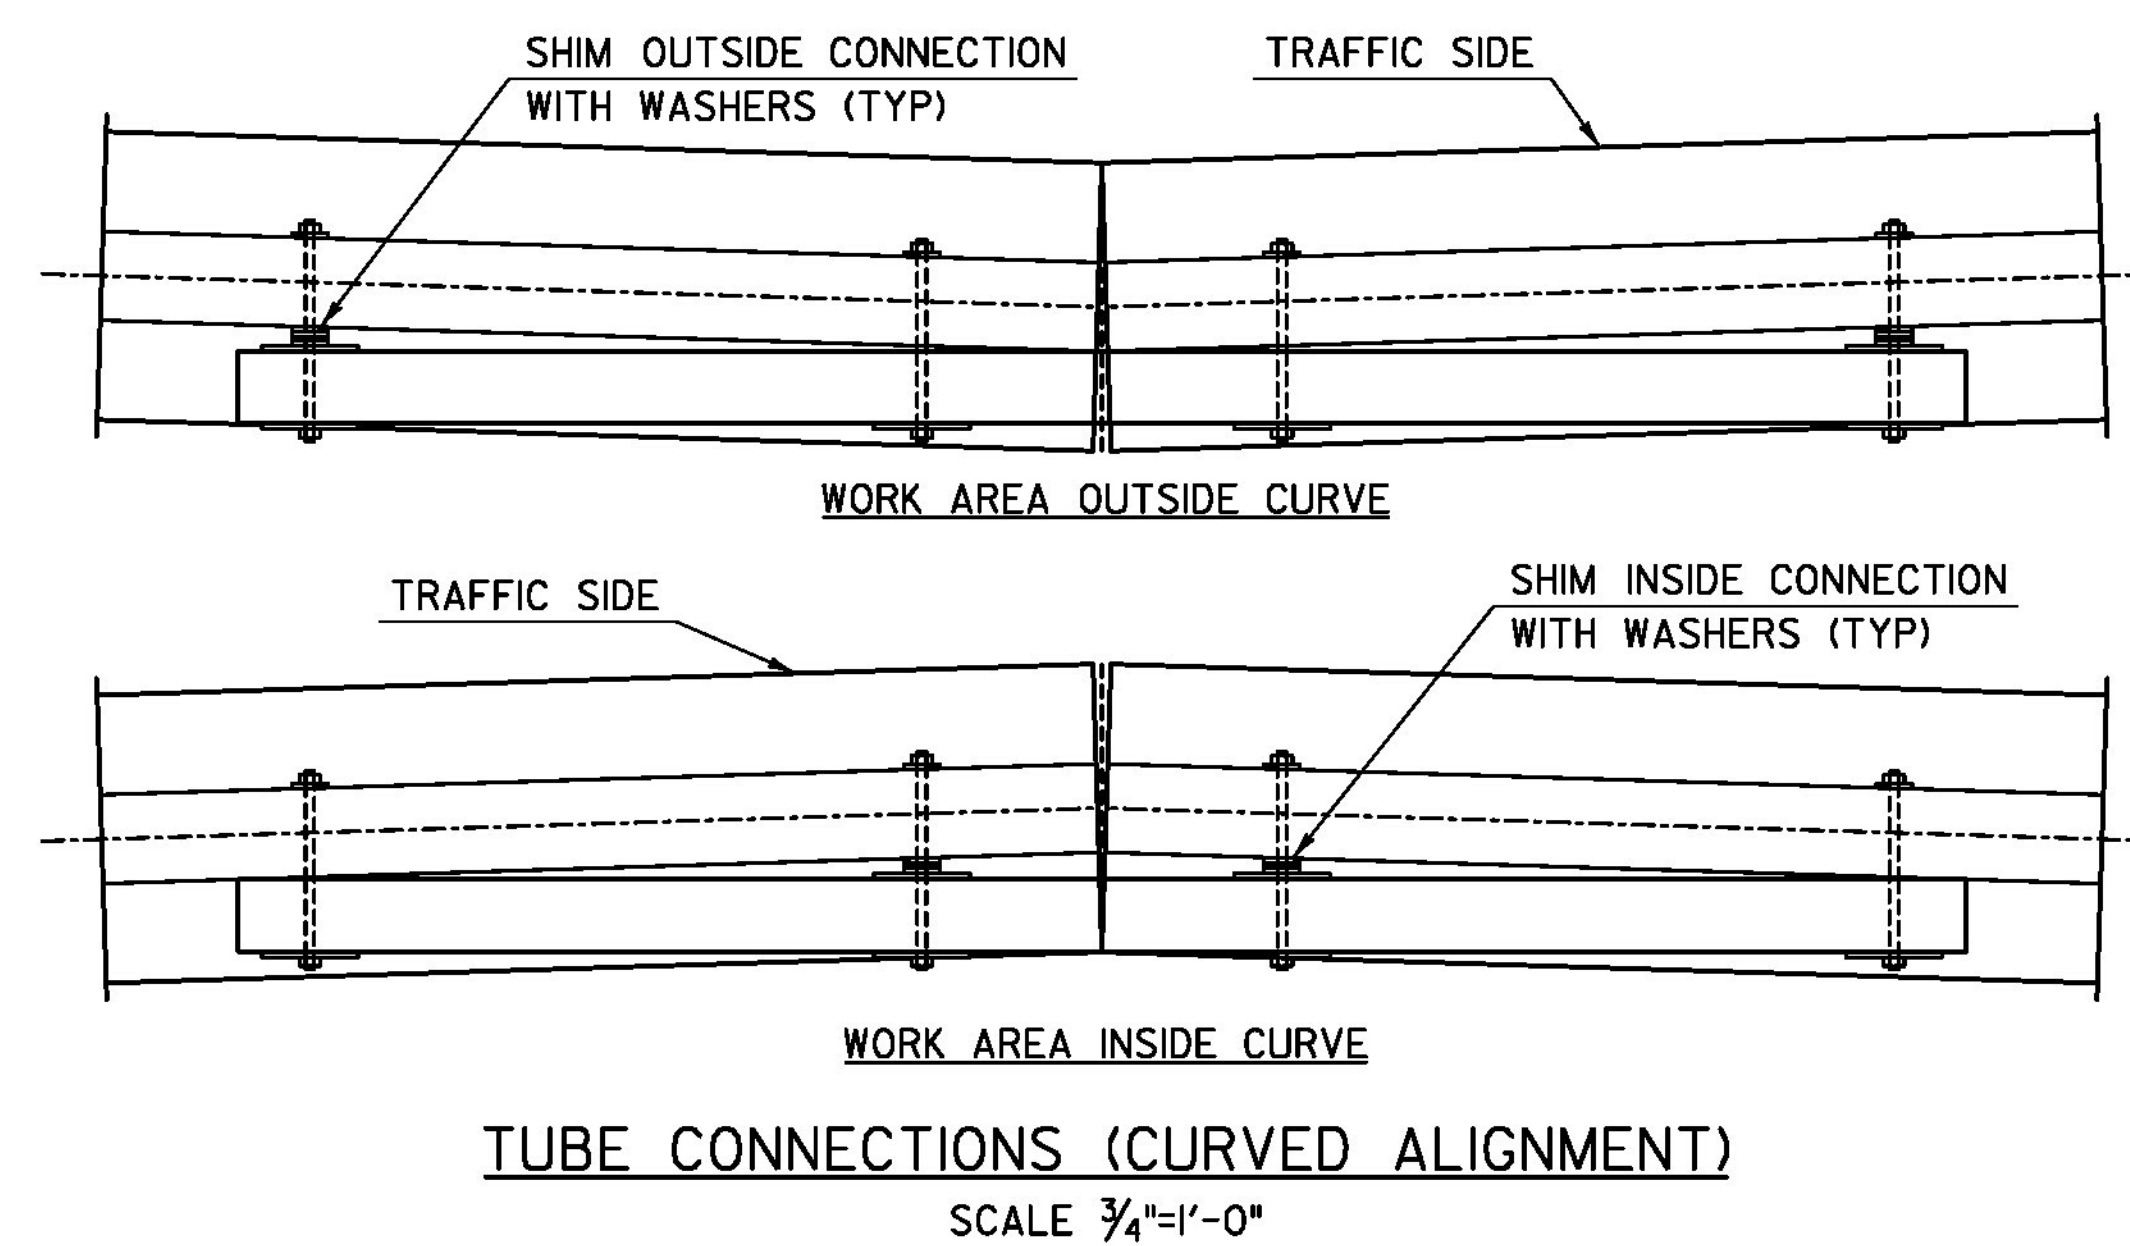
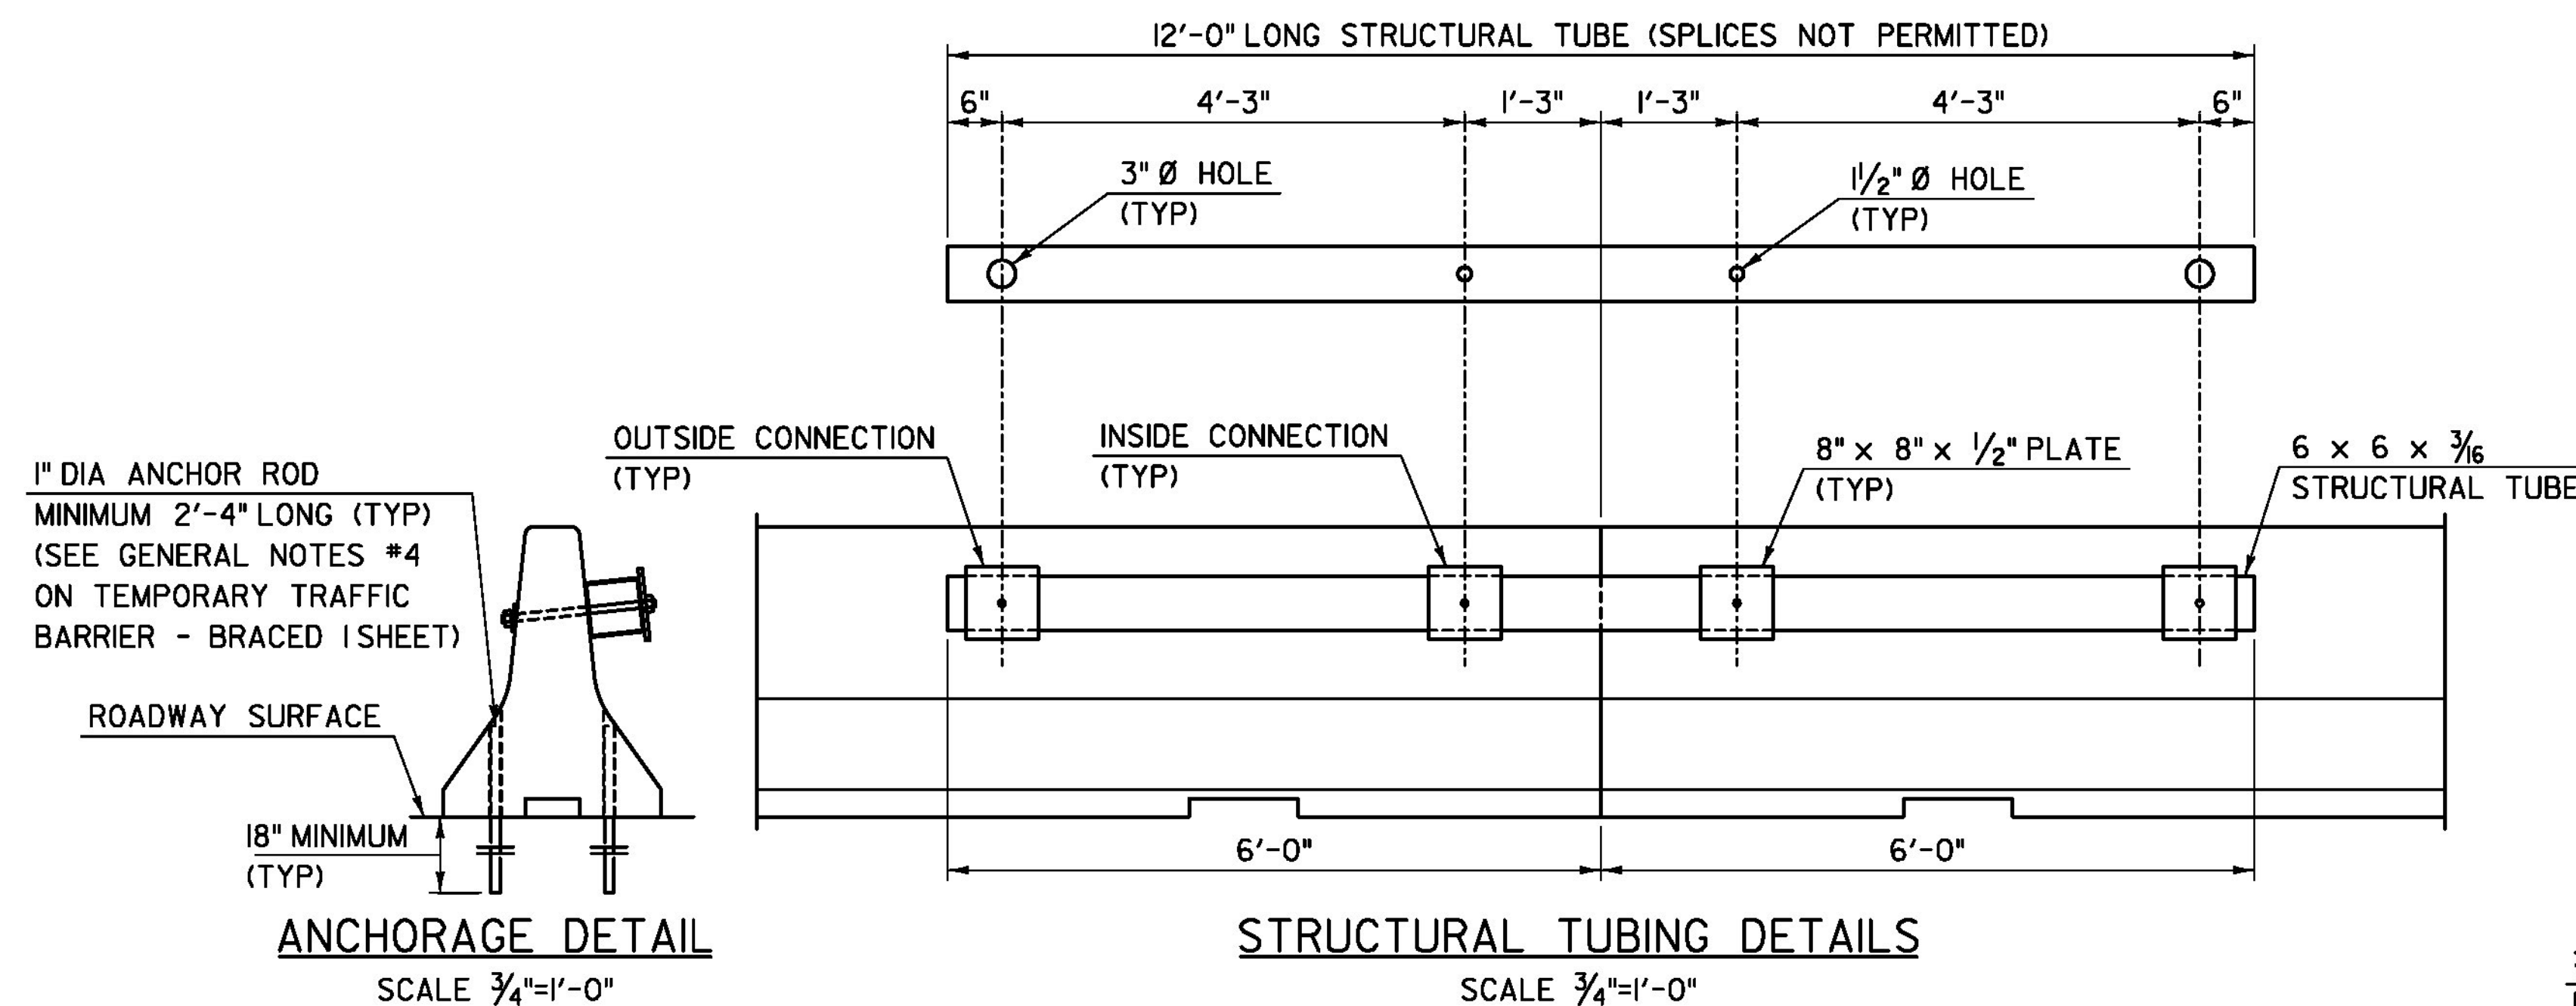


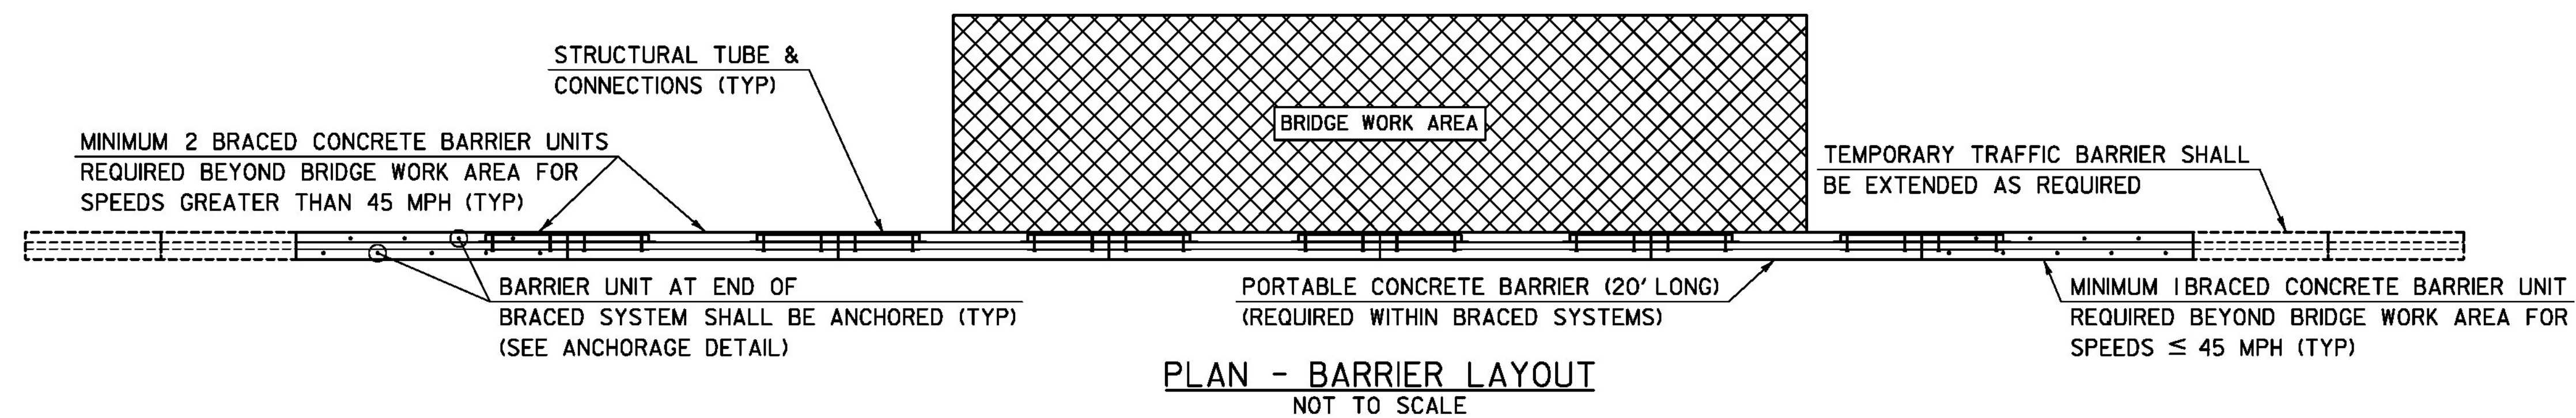

PROJECT NAME:	BENNINGTON
PROJECT NUMBER:	BRF 1000(16)
FILE NAME:	x88j087+tb.dgn
PROJECT LEADER:	R. HEBERT
DESIGNED BY:	R. HEBERT
TEMPORARY TRAFFIC BARRIER BRACED 2	
PLOT DATE:	8/7/2014
DRAWN BY:	S. MORGAN
CHECKED BY:	D. BURHANS
SHEET	26 OF 75