


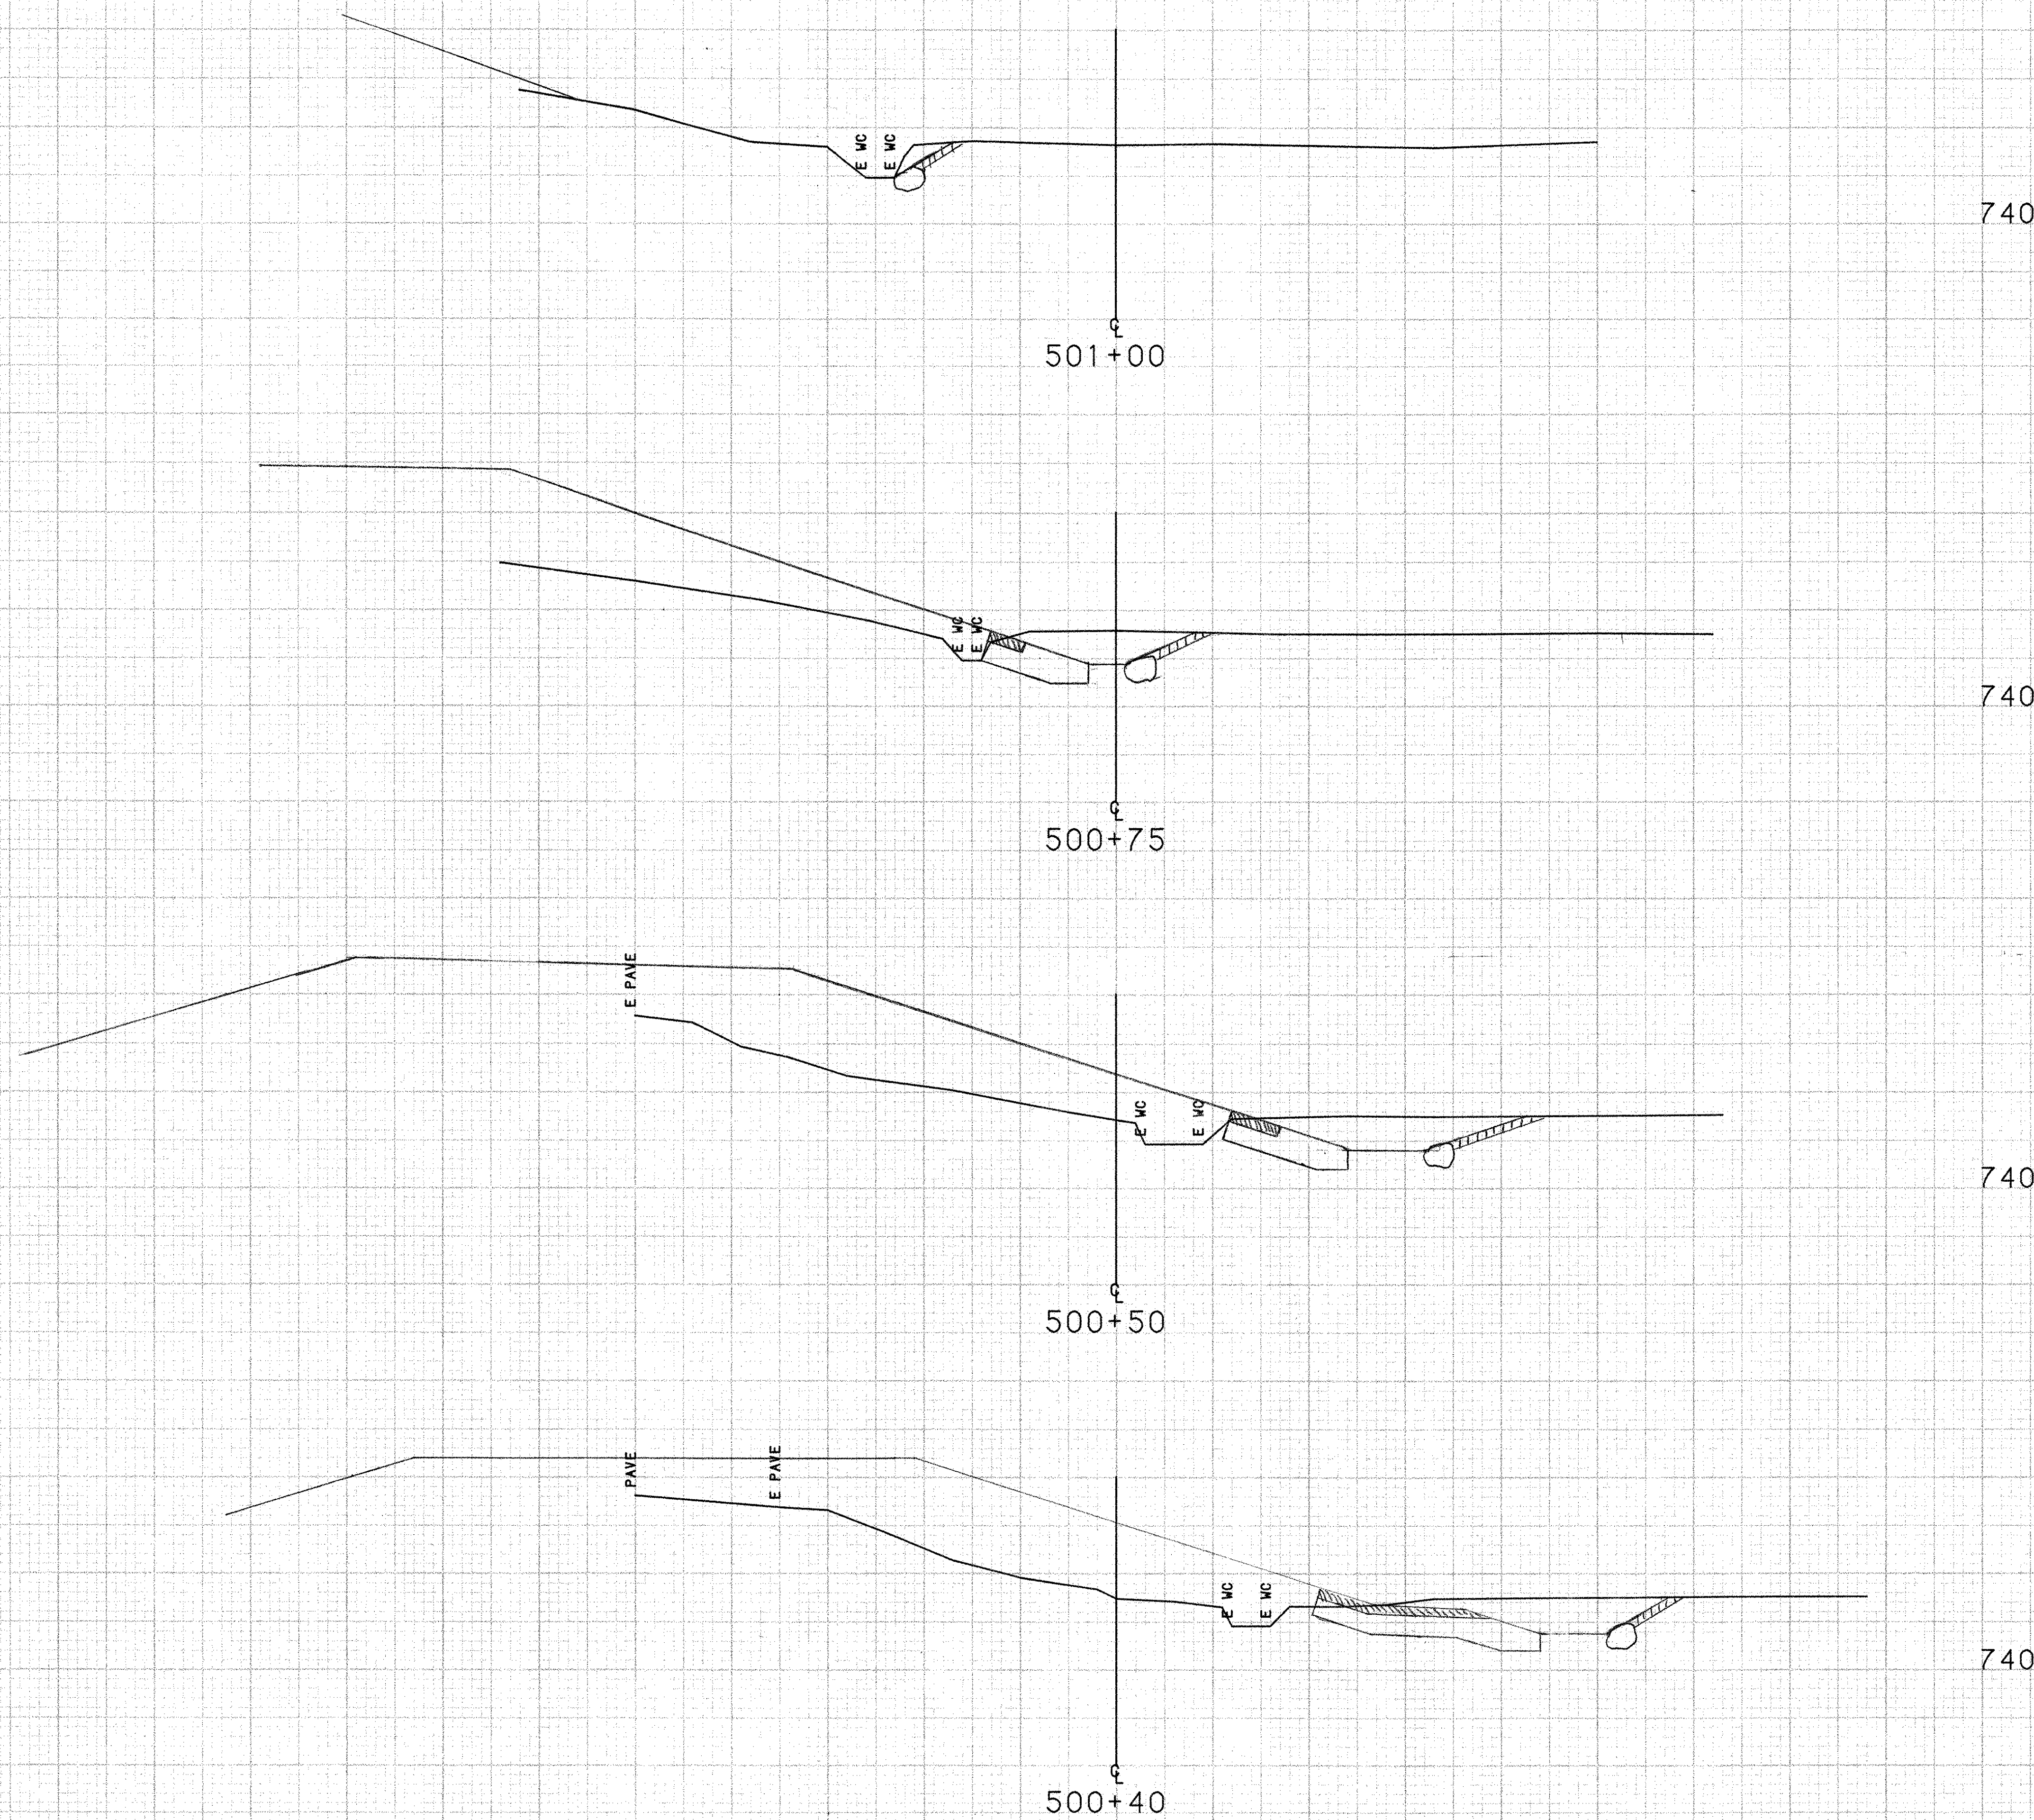

STA. 501+00
 END. UNCLASSIFIED CHANNEL EXCAV.
 END STONE FILL, TYPE II
 END RIPRAP, HEAVY TYPE
 END GRUBBING MATERIAL

SCALE 10 FEET

FROM STA.	500+40	TO STA.	501+00
PROJECT NAME	DERBY CHAN		
NO.	TH28910		
SURVEYED BY	L. NOYES		
SHEET	28	OF	29 SHEETS
		PLOTTED	05/16/89
		03/89	0219