



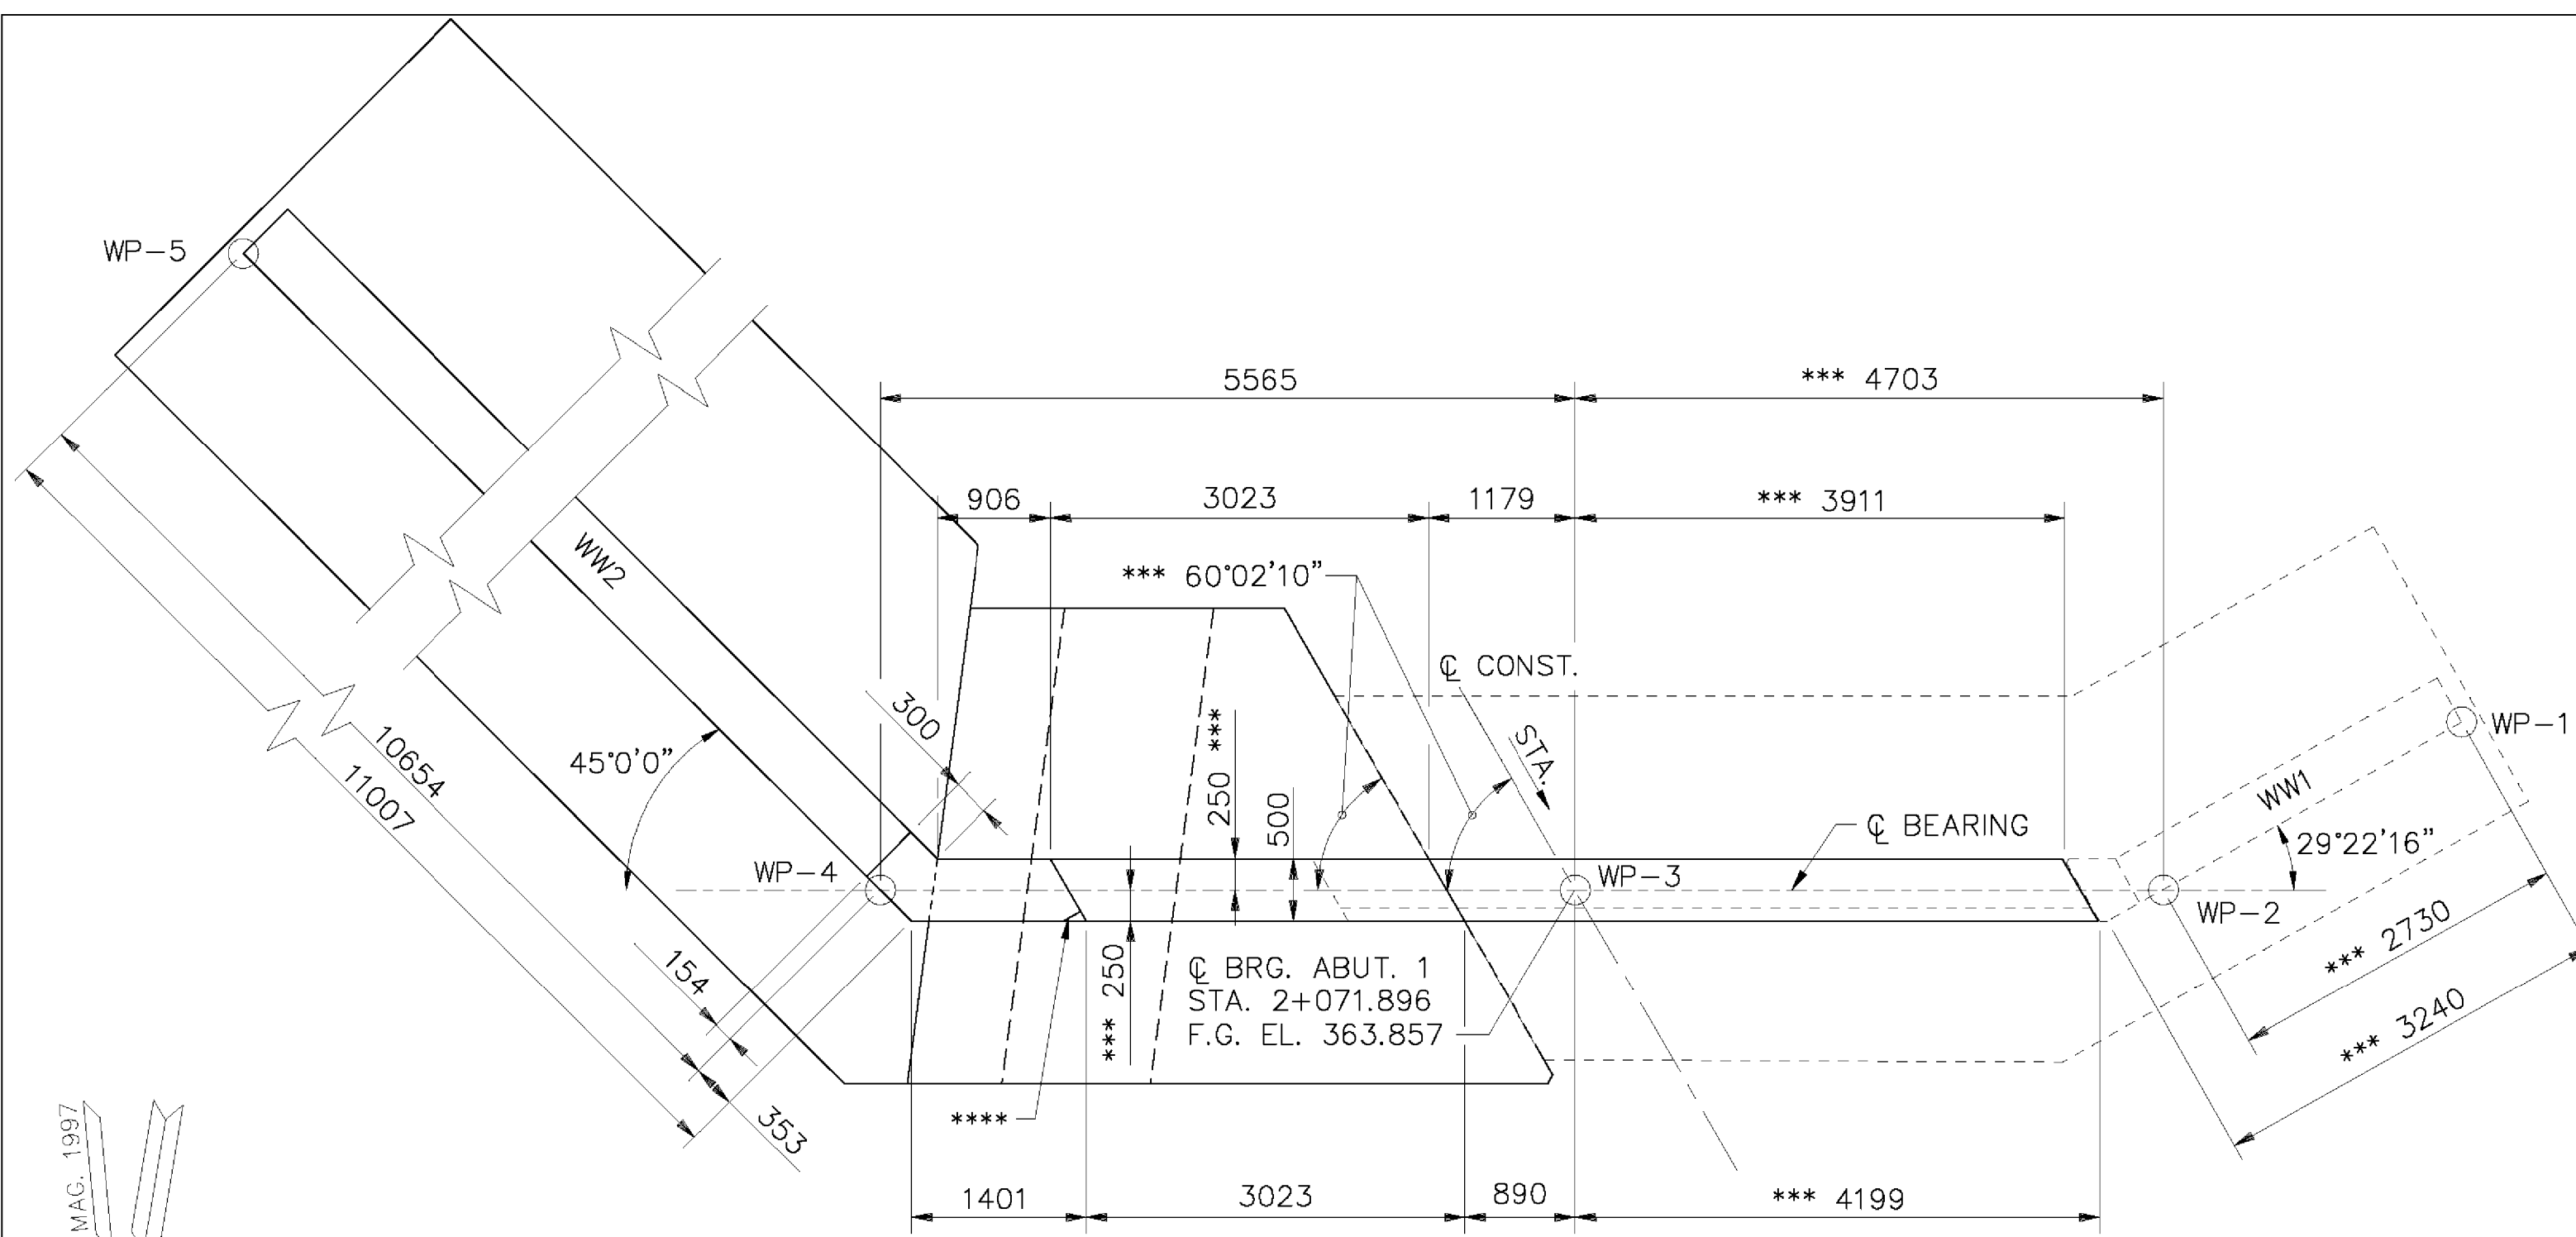

PLAN

LIMITS OF REMOVAL NOT SHOWN
IN PLAN VIEW FOR CLARITY.

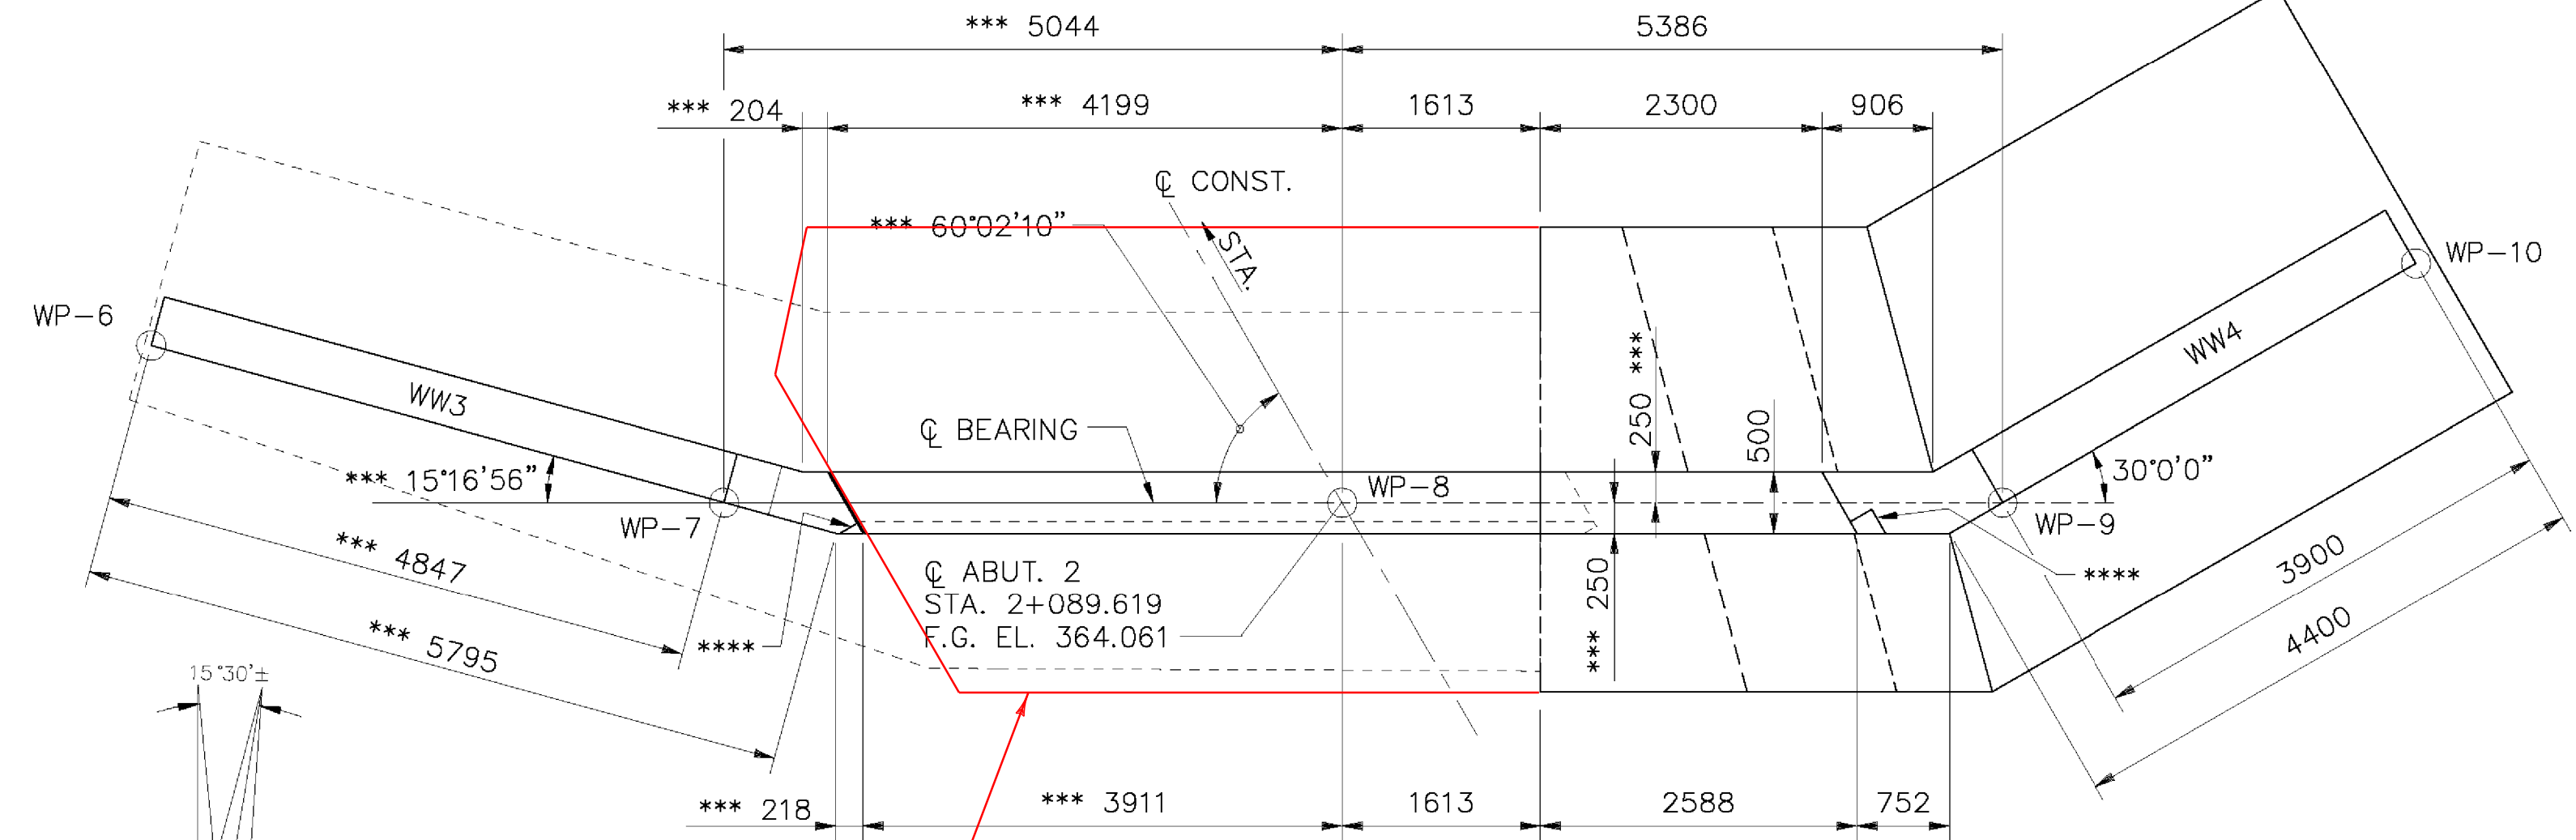


PLAN

LIMITS OF REMOVAL NOT SHOWN
IN PLAN VIEW FOR CLARITY.

* SEE NOTE BELOW

* WW #3 WORK DEEMED
UNNECESSARY

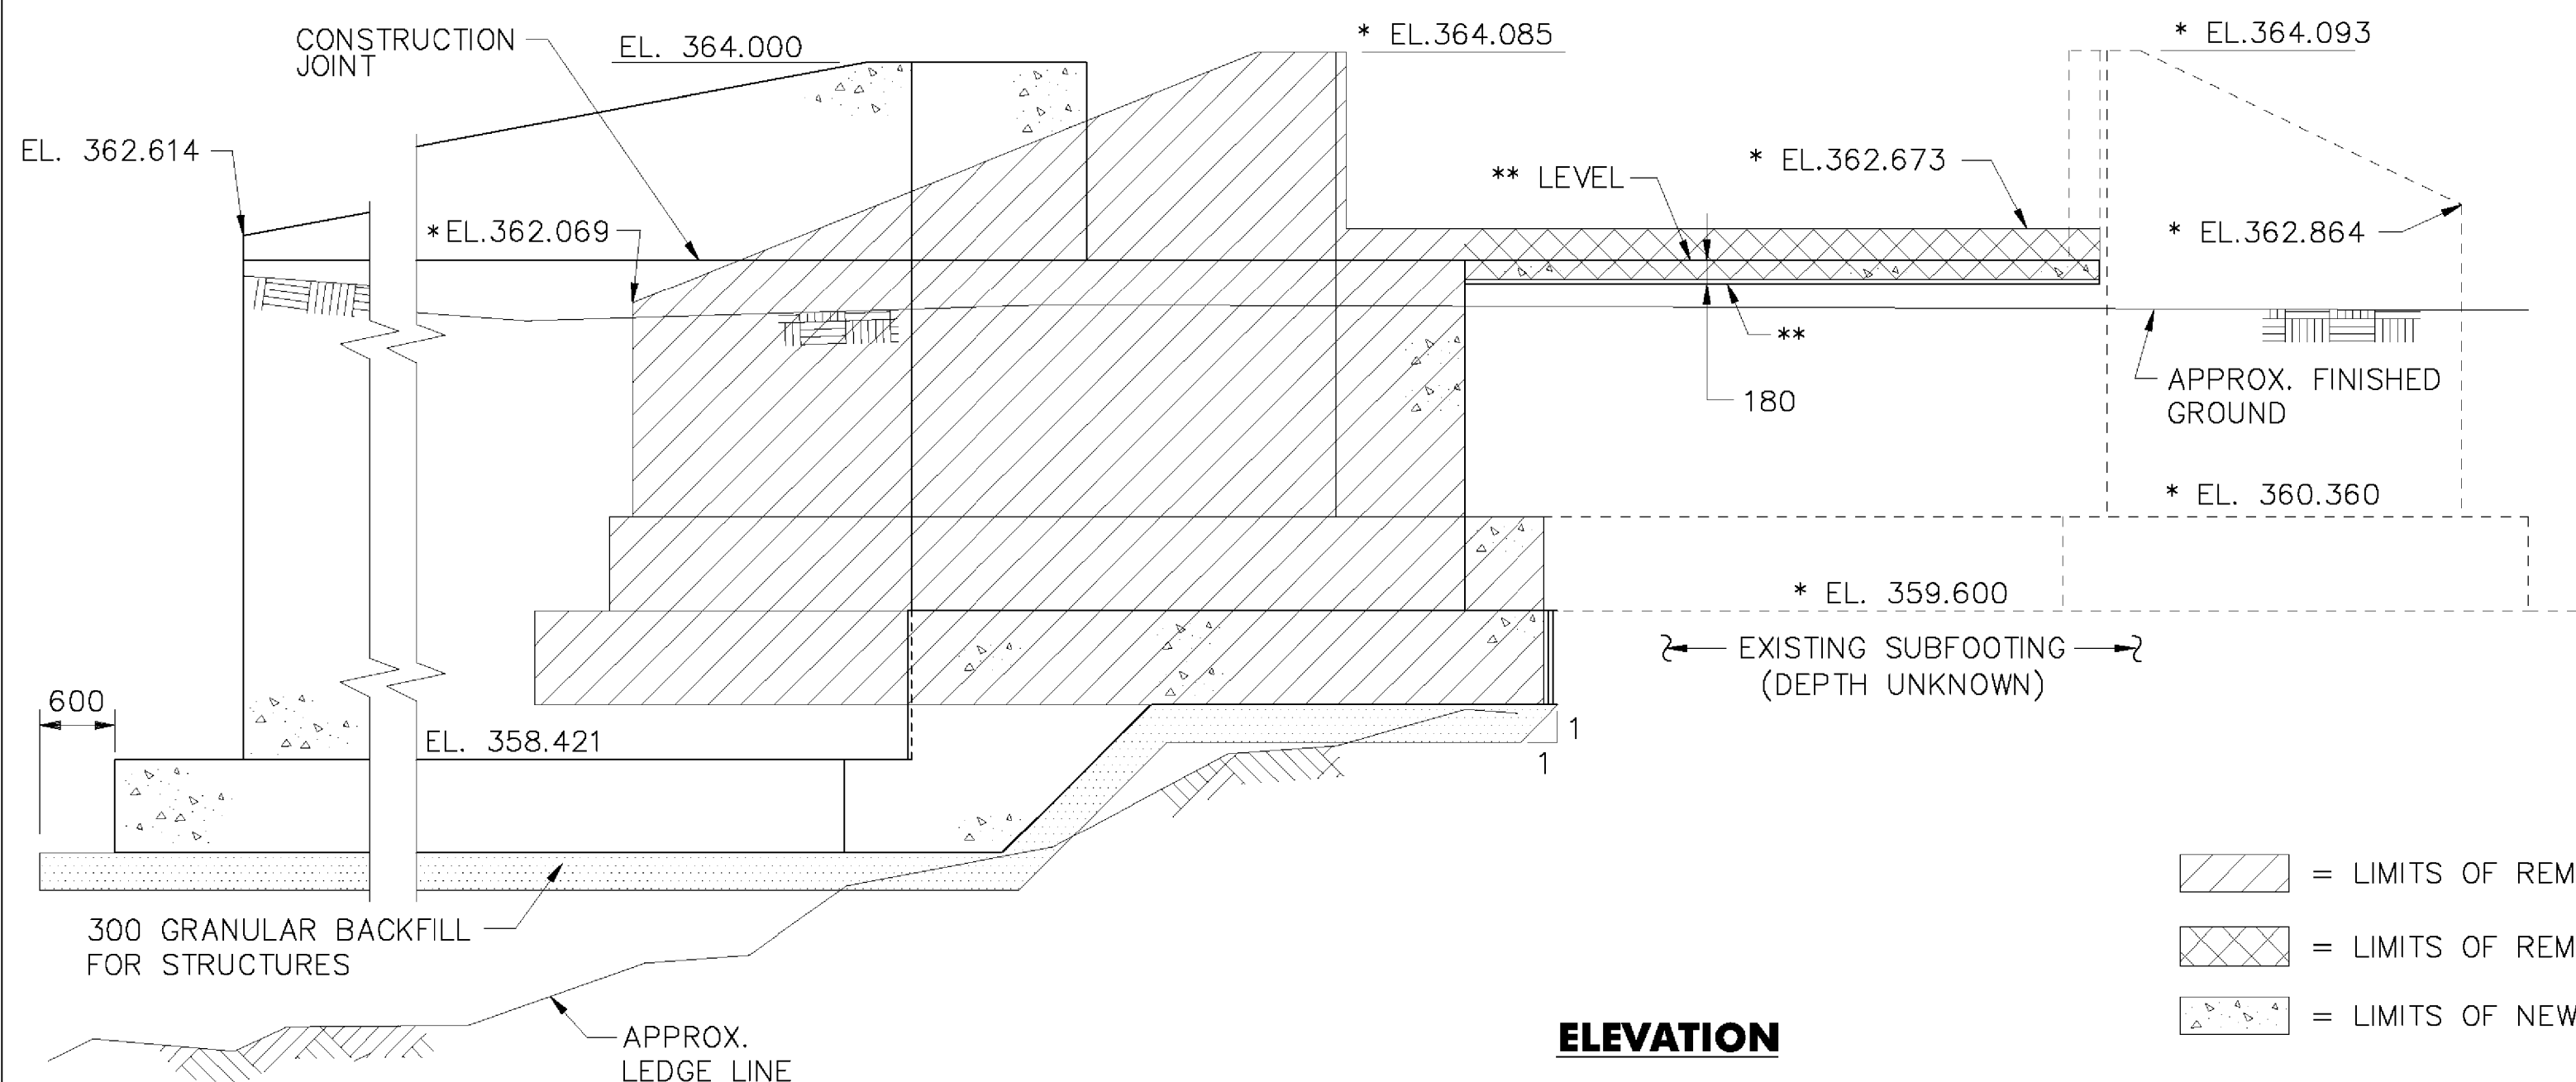


ELEVATION

ABUTMENT 1

SCALE: 1:50
0 1 2 3
SCALE IN METERS

- = LIMITS OF REMOVAL (PAID UNDER ITEM 208.35).
- = LIMITS OF REMOVAL (PAID UNDER ITEM 529.20, SEE GENERAL NOTES #8, SHEET 16)
- = LIMITS OF NEW CONCRETE

* EXISTING ELEVATIONS ARE APPROXIMATE
** SEE GENERAL NOTE #19, SHEET 16.
*** SEE GENERAL NOTE # 3, SHEET 16.
**** BLOCKOUT WINGWALL AS REQUIRED
TO ACCOMMODATE BRIDGE RAIL POST.

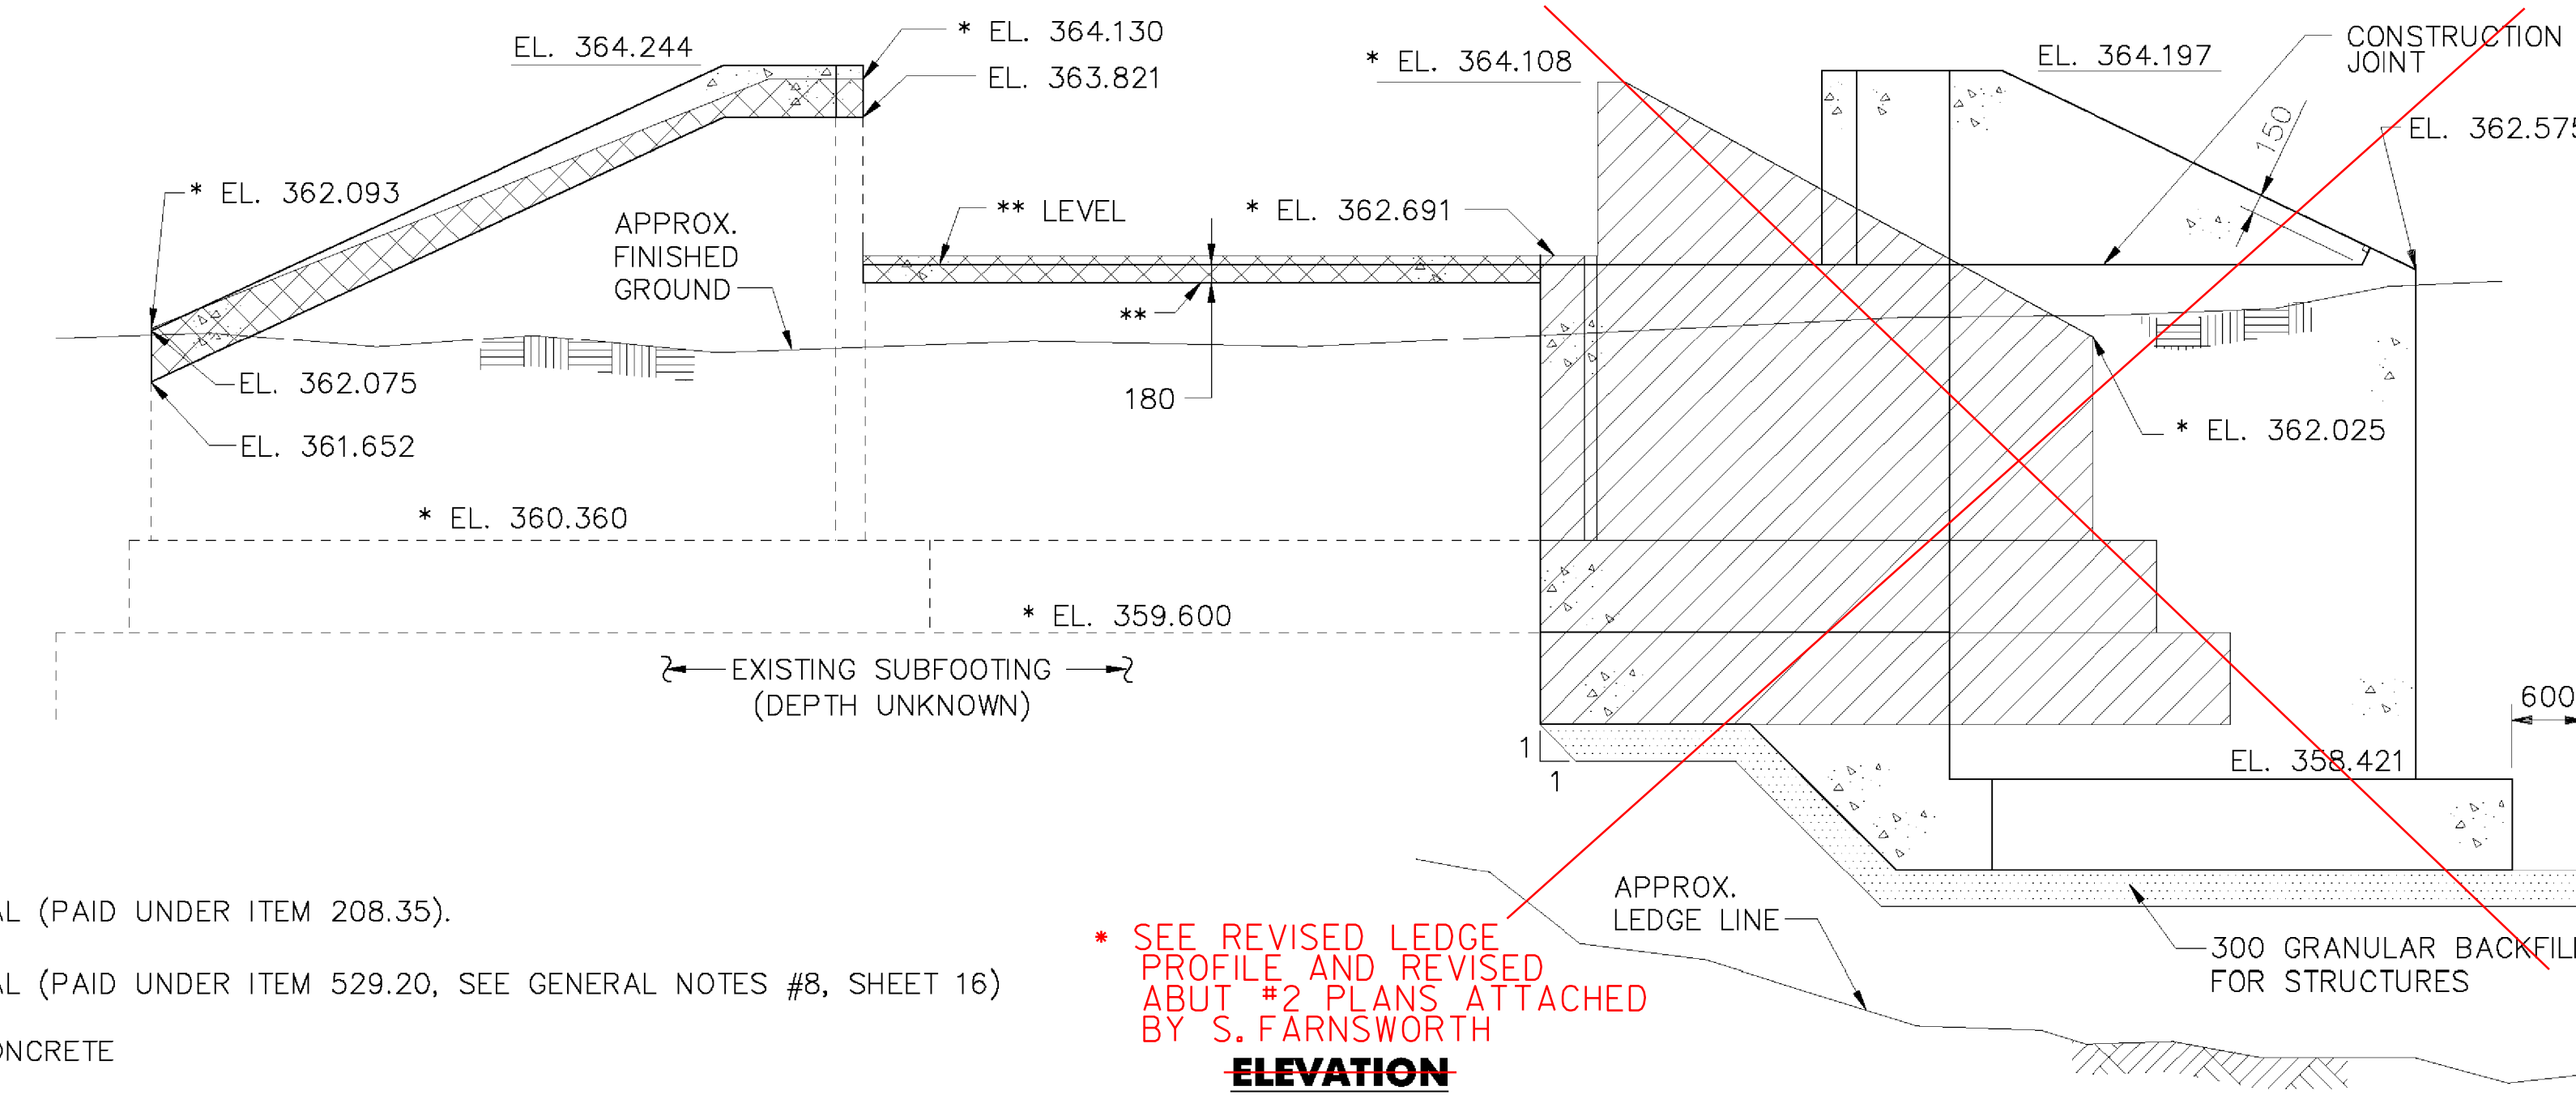

ELEVATION

ABUTMENT 2

SCALE: 1:50
0 1 2 3
SCALE IN METERS

* SEE REVISED LEDGE
PROFILE AND REVISED
ABUT #2 PLANS ATTACHED
BY S. FARNSWORTH

REVISIONS

REVISED WINGWALL 2.



**STATE OF VERMONT
AGENCY OF TRANSPORTATION**

Town Of	RIPTON	Bridge No.	BRIDGE #17
Highway No.	TH 18	Log Sta.	
		Surv. Sta.	
TH 18 OVER SOUTH BRANCH MIDDLEBURY RIVER ABUTMENT MASONRY			
Designed By	Y I LIU	Drawn By	W J GAYNOR
Checked By	B P GUZAS	Bridge Design Supervisor	R L JOY
	8/09		Date 10/09
PROJECT	RIPTON	PROJECT NO.	FH 010-1(2)
I.G.C. Info.			
Bridge Sheet No.	Sheet 19R of 26		