




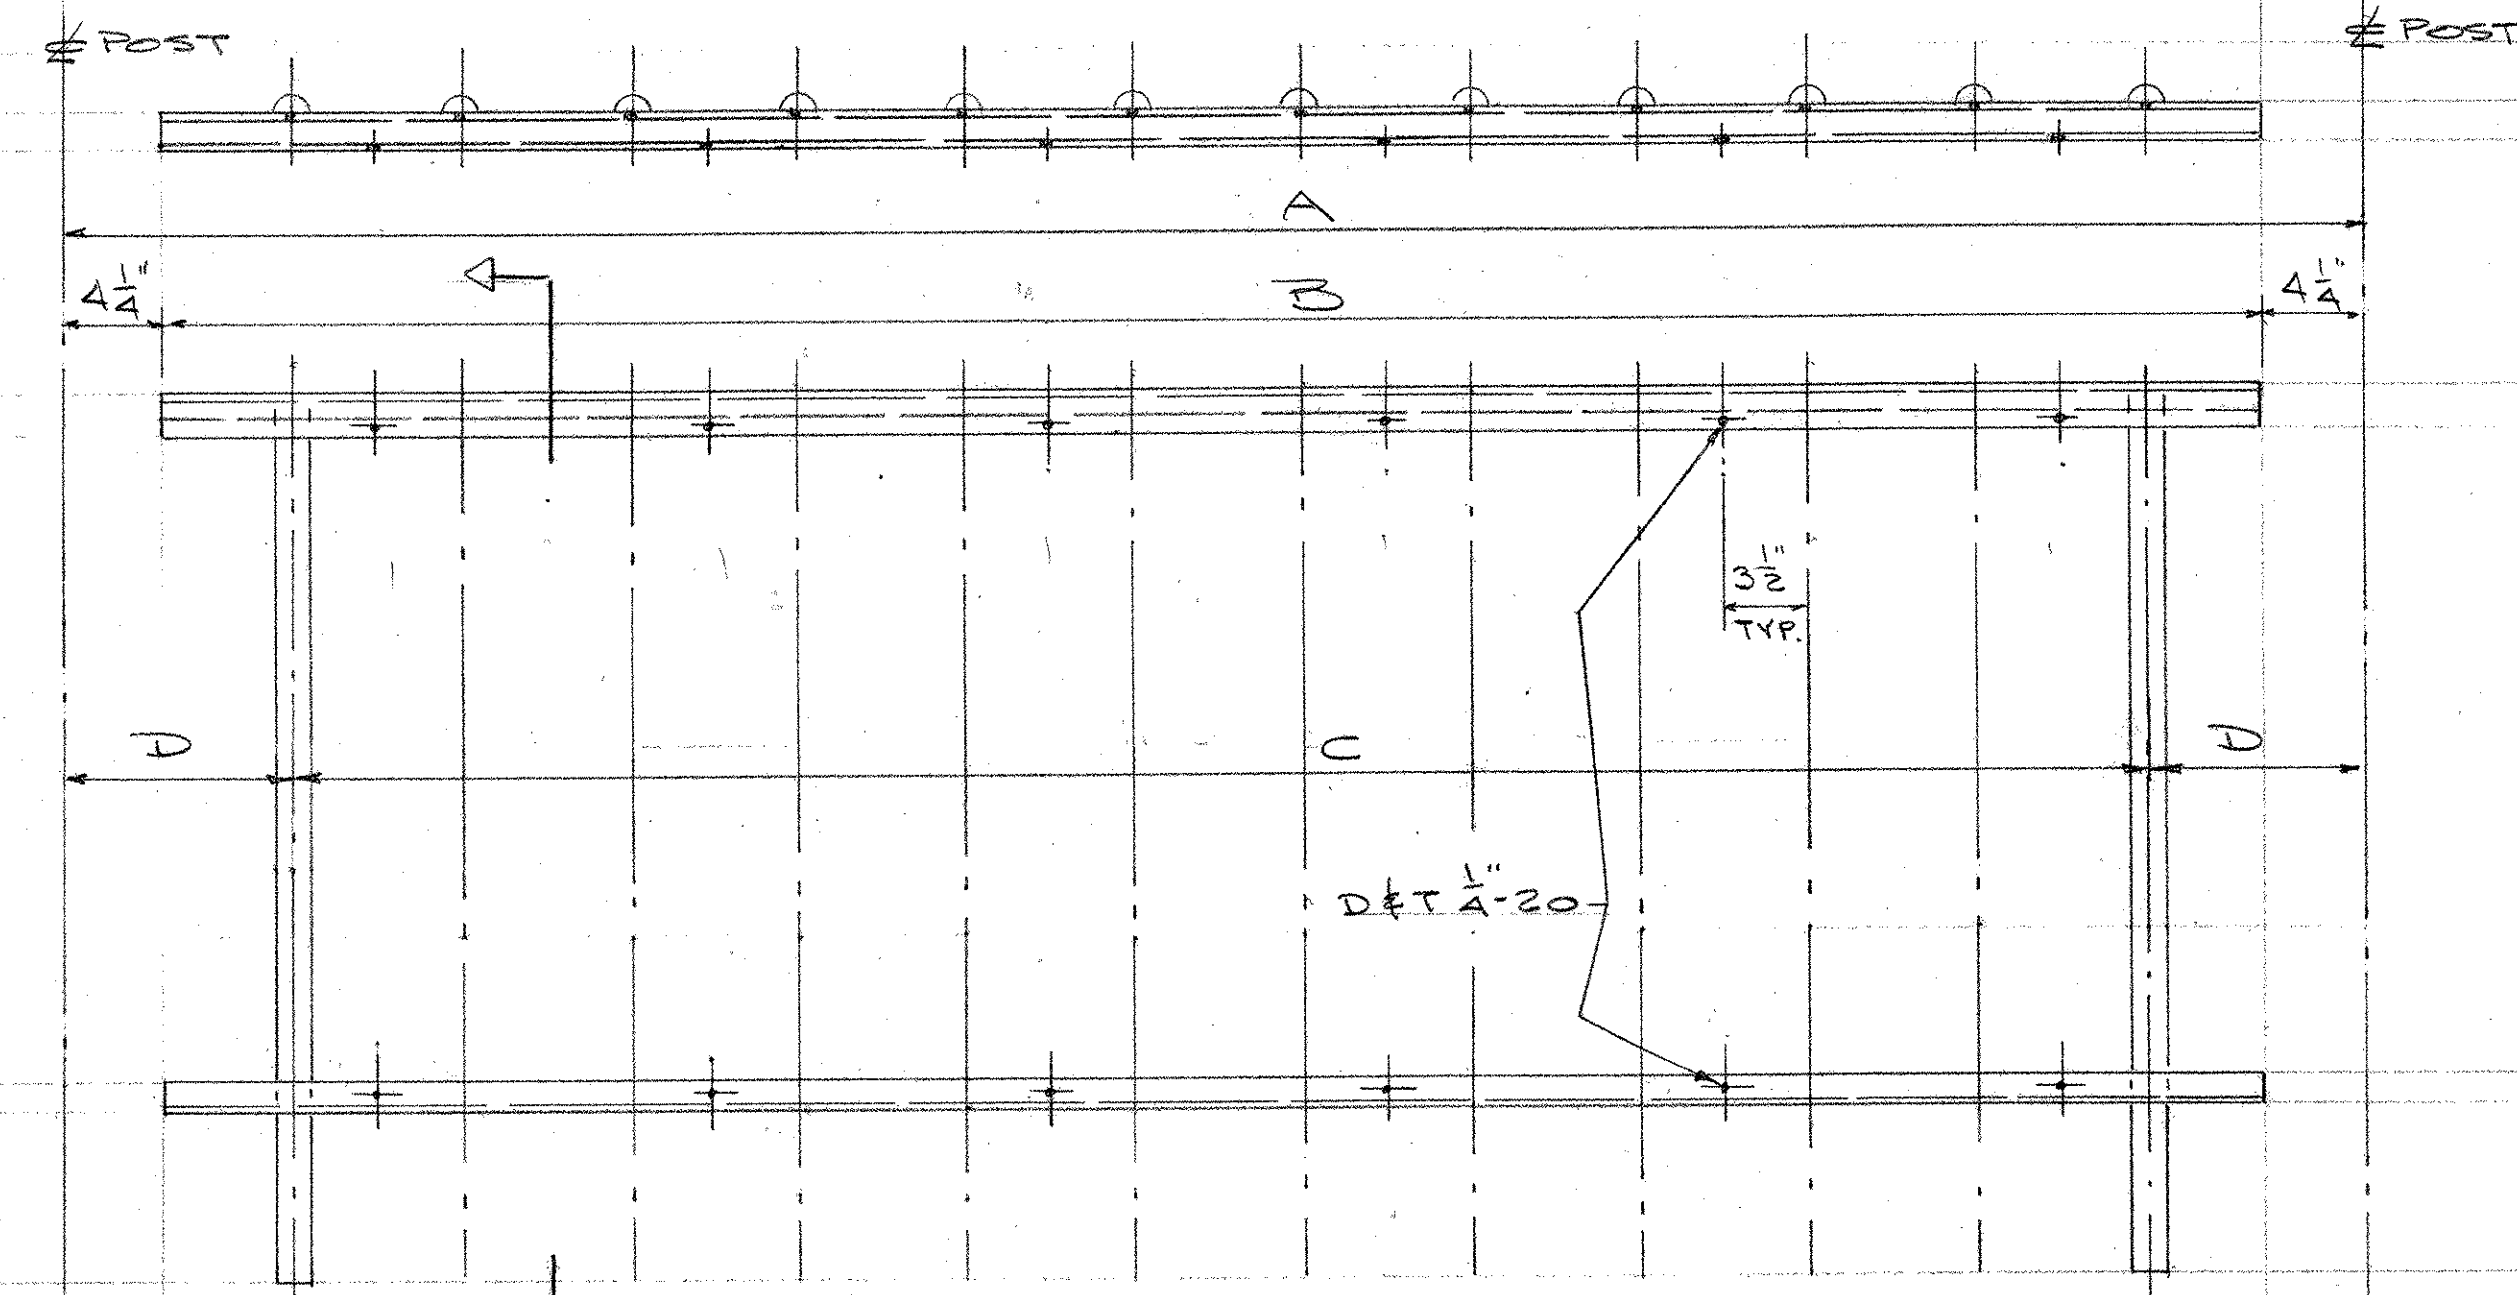

PANEL No.	QUAN	A	B	C	D
A3	2	7'-0 1/2"	6'-3 3/4"	10 SP @ 7" = 5'-10"	7 1/2"
A5	40	7'-11 1/2"	7'-3"	11 SP @ 7" = 6'-5"	9 1/4"

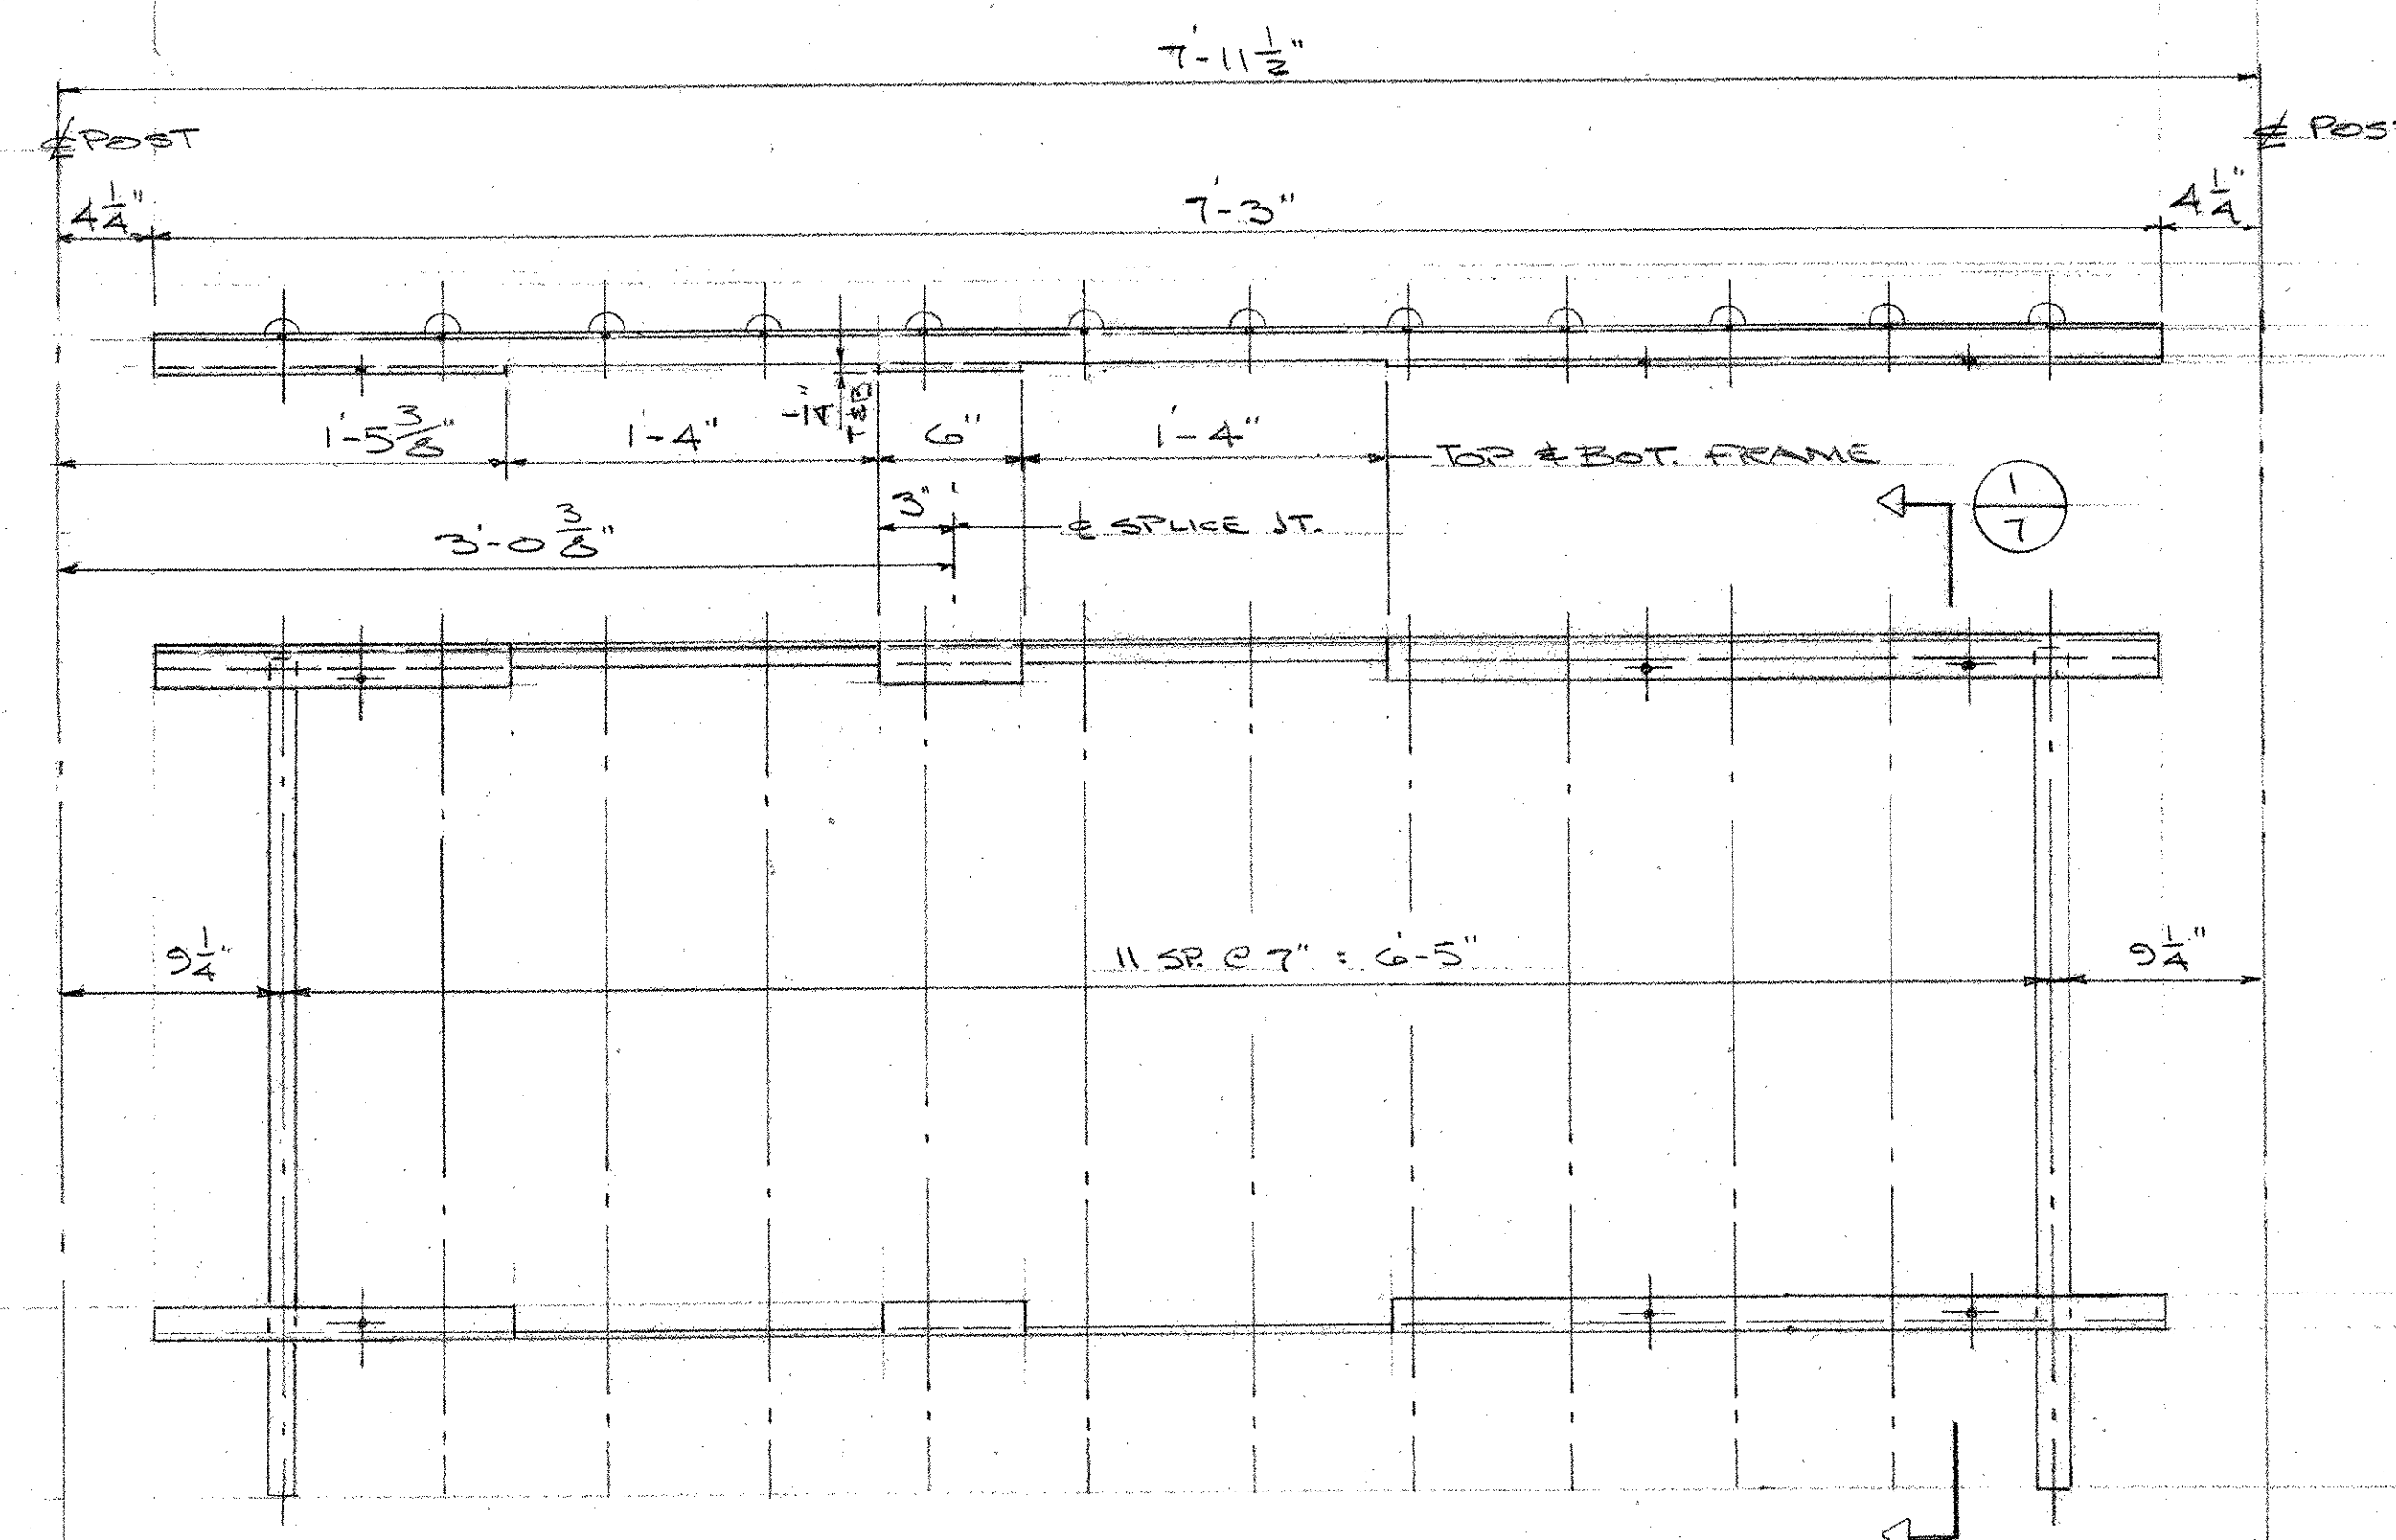

PANEL A4 (15-REQD)

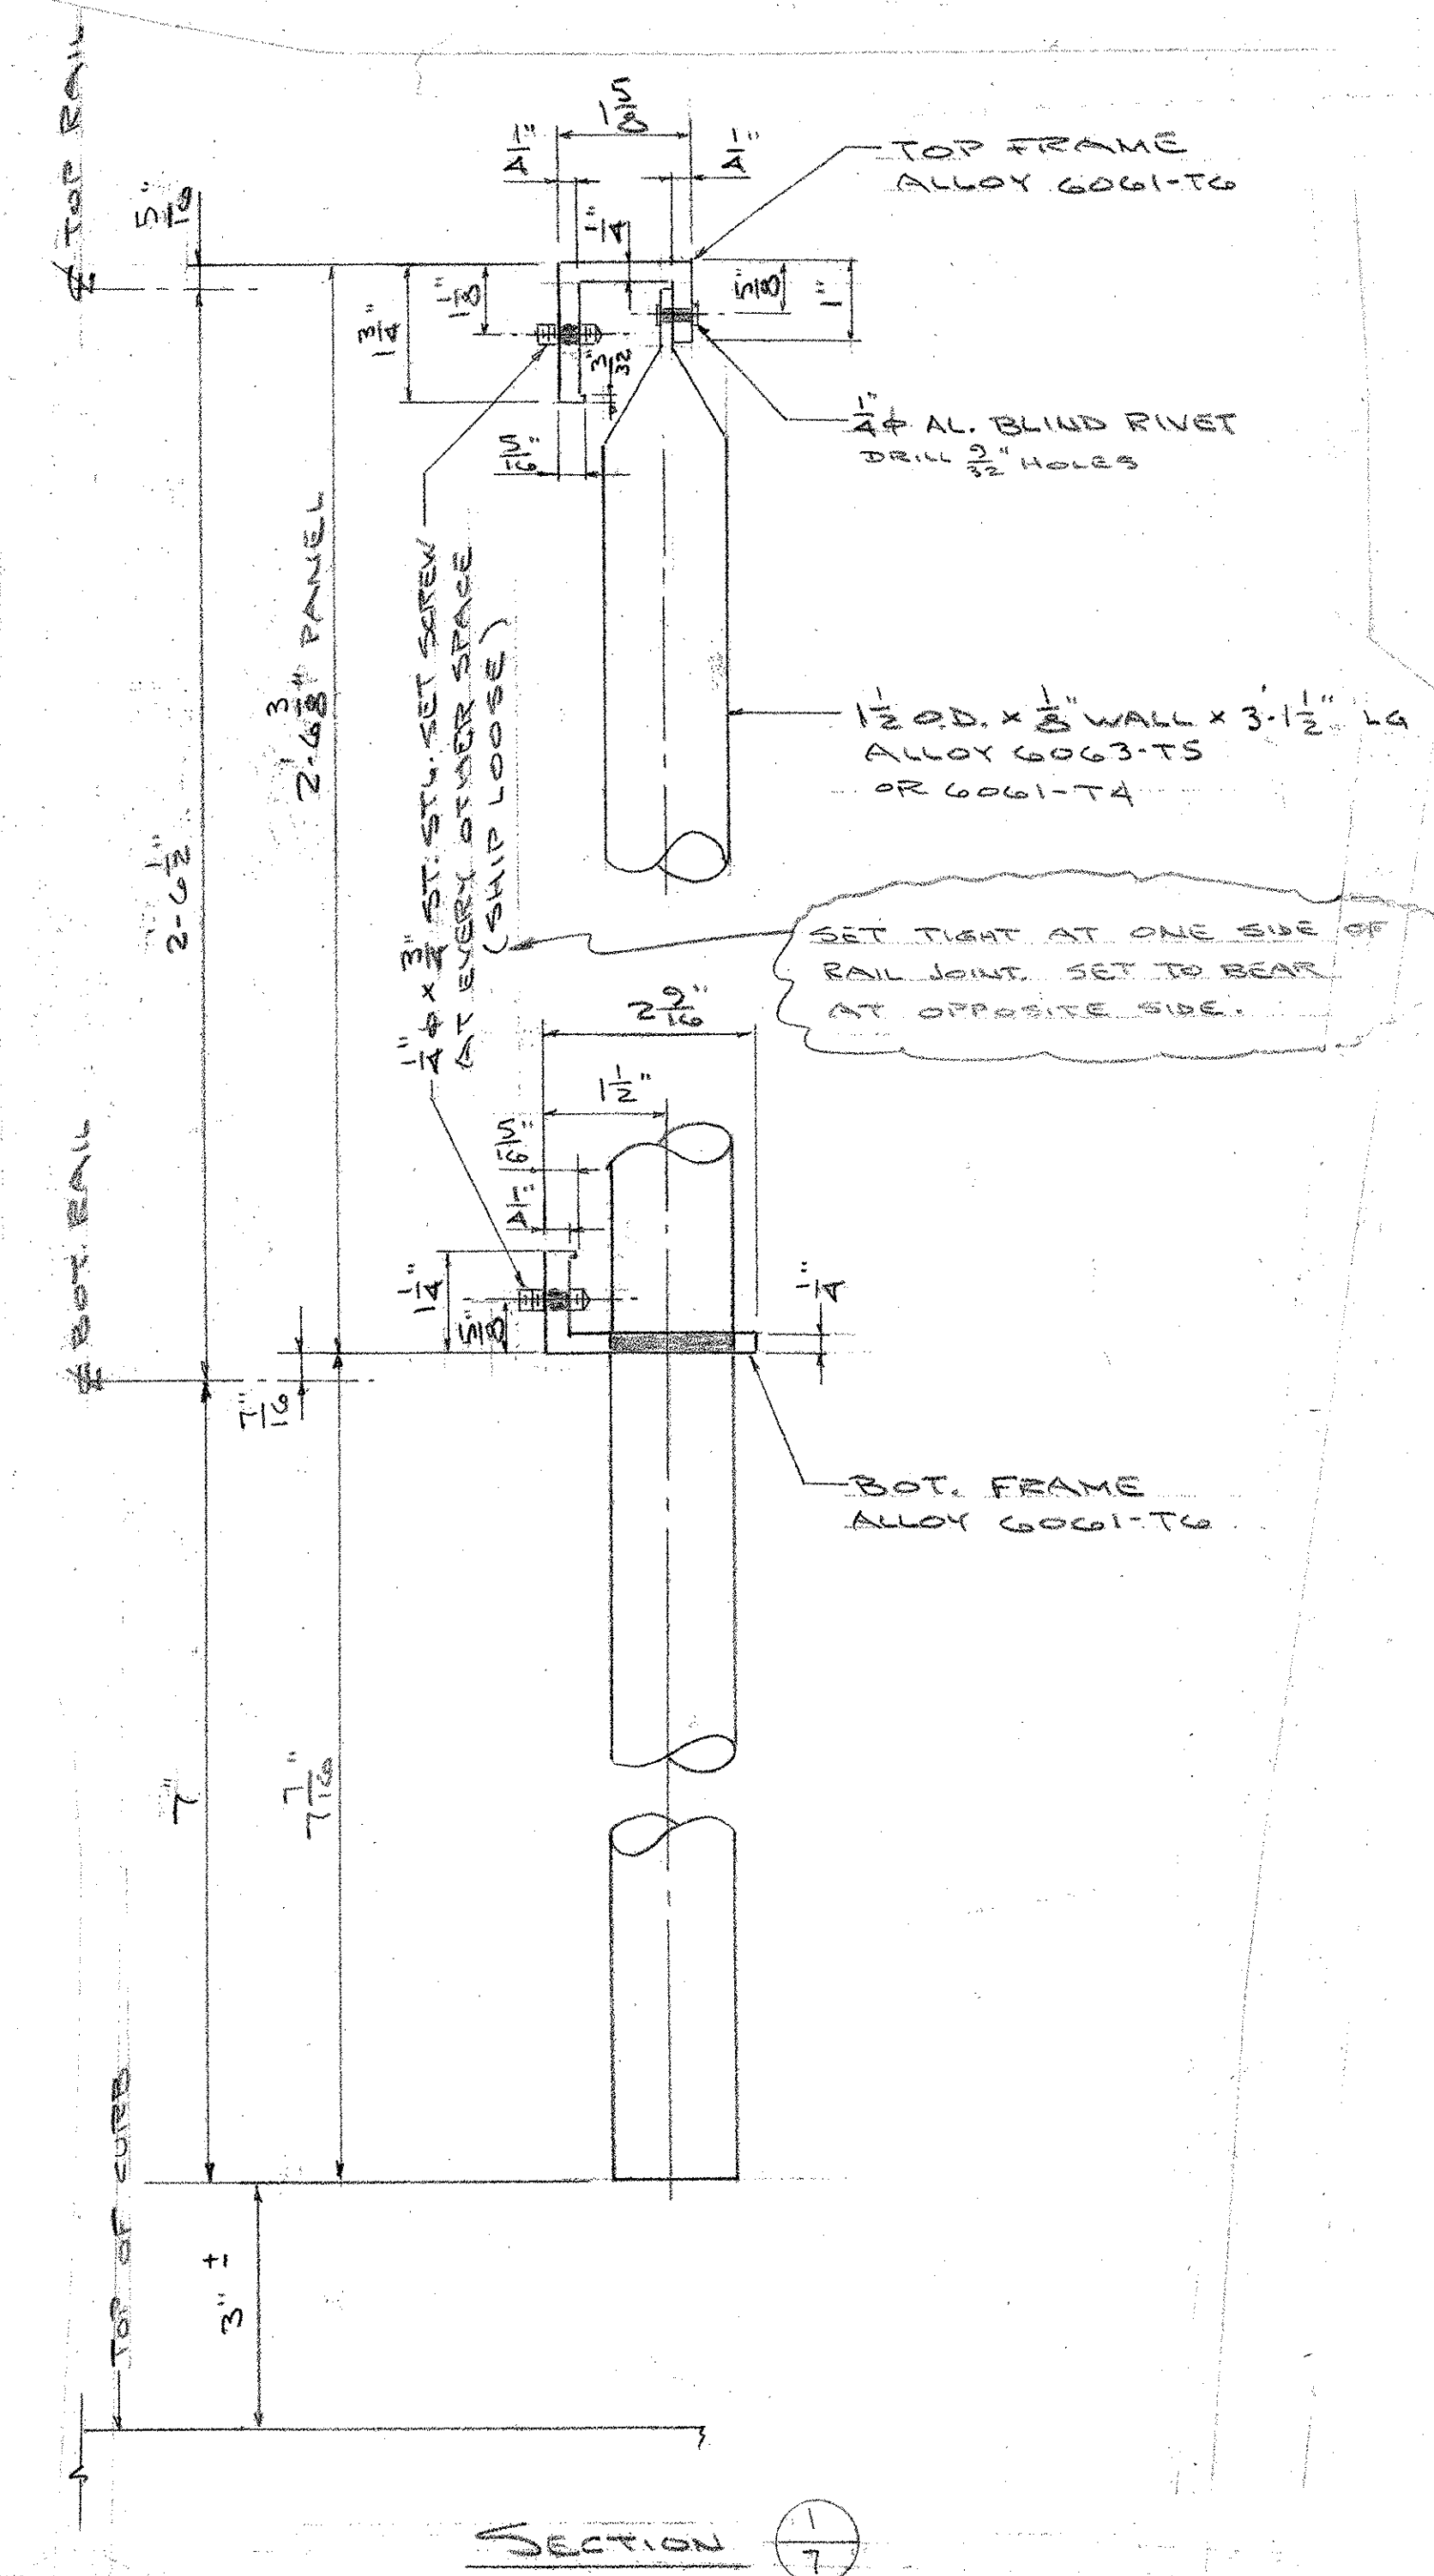

RECEIVED
 CK'D BY KPH CK'D BY _____
 MAY 12 2006
 RESUBMIT _____ APPROVED _____
 BY CPW DATE 5/15/06

2		5-8-06	FOR APPROVAL	AUCIELLO IRON WORKS INC 560 MAIN ST. HUDSON, MA (978) 568-8382 VT. AGENCY OF TRANSPORTATION HARTFORD PROJ #BRO-BTN2004(1) BRIDGE #3 T.H.4 OVER WHITE RIVER ALUM. PICKET PANELS SURFACE PREP: NONE FINISH: BLACK ANODIZE FOR FRANK W. WHITCOMB CORP. DR. WM 3-23-06 CHK. 3-24-06 JOB NO. BR-2878 BY AB60012-1001 SHEET 7 OF 8
1		3-24-06	FOR APPROVAL	
ISSUE	DATE	DESCRIPTION		