

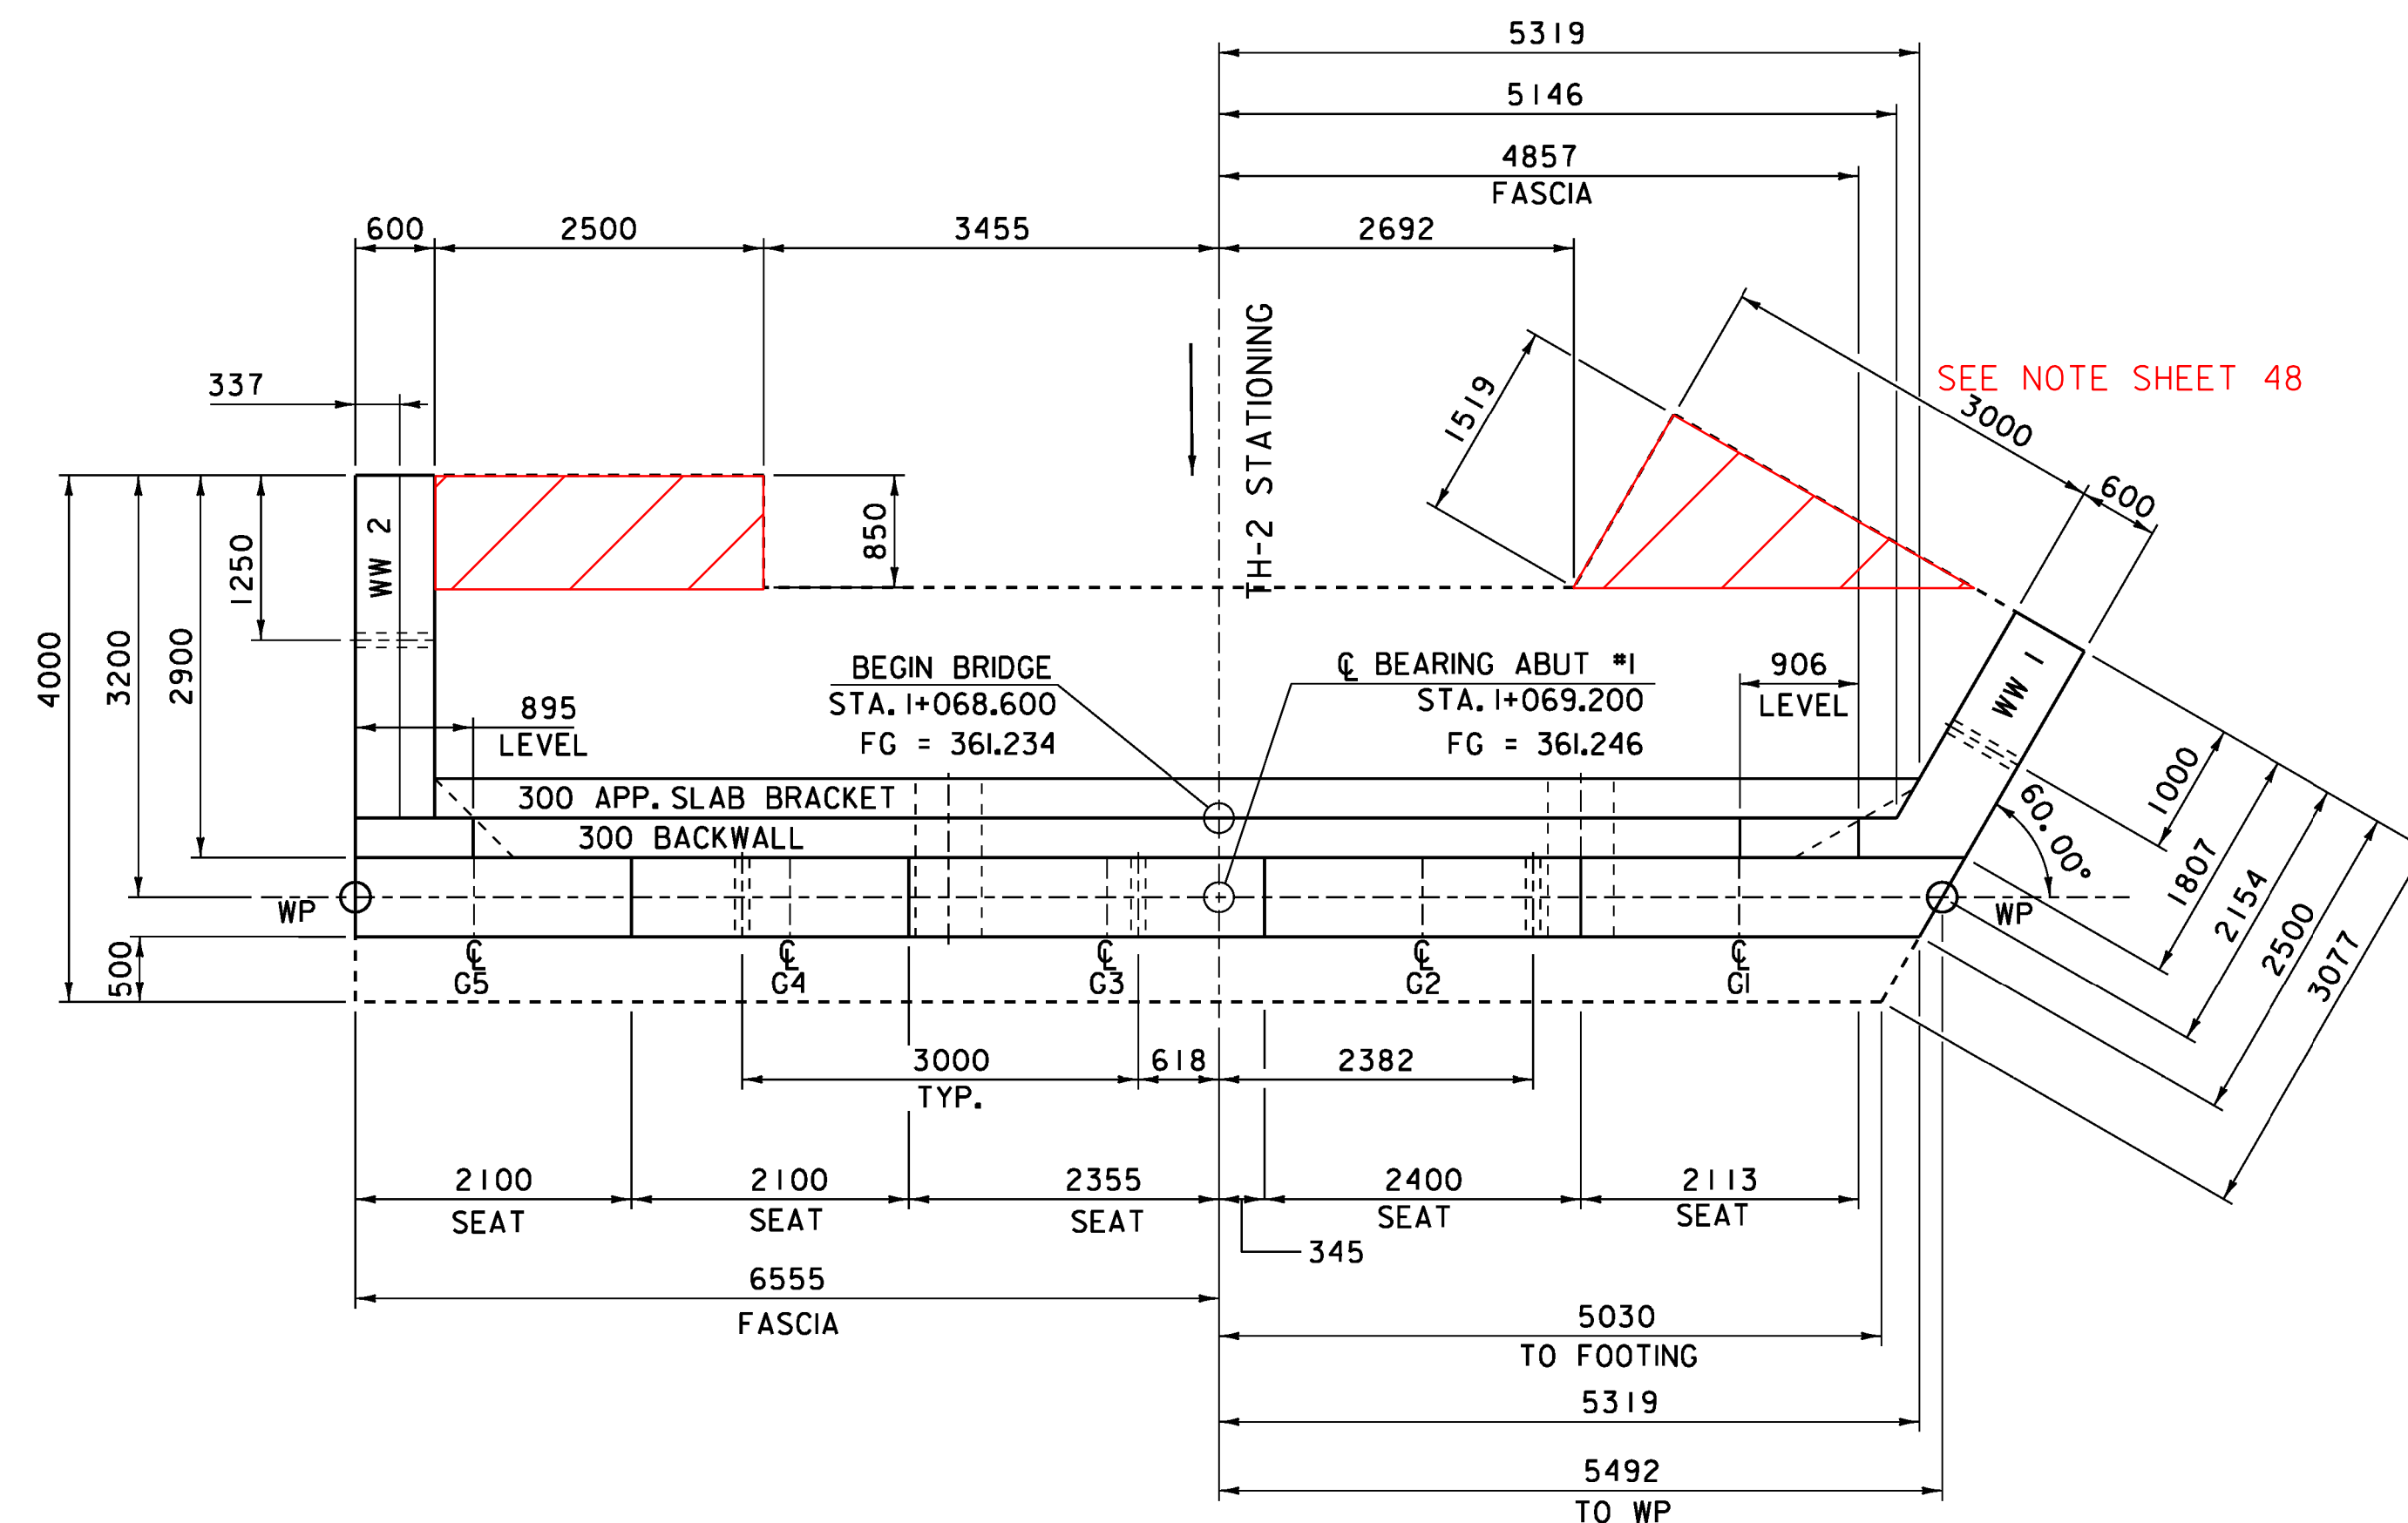


SEE REVISED
PAGES # 1~5

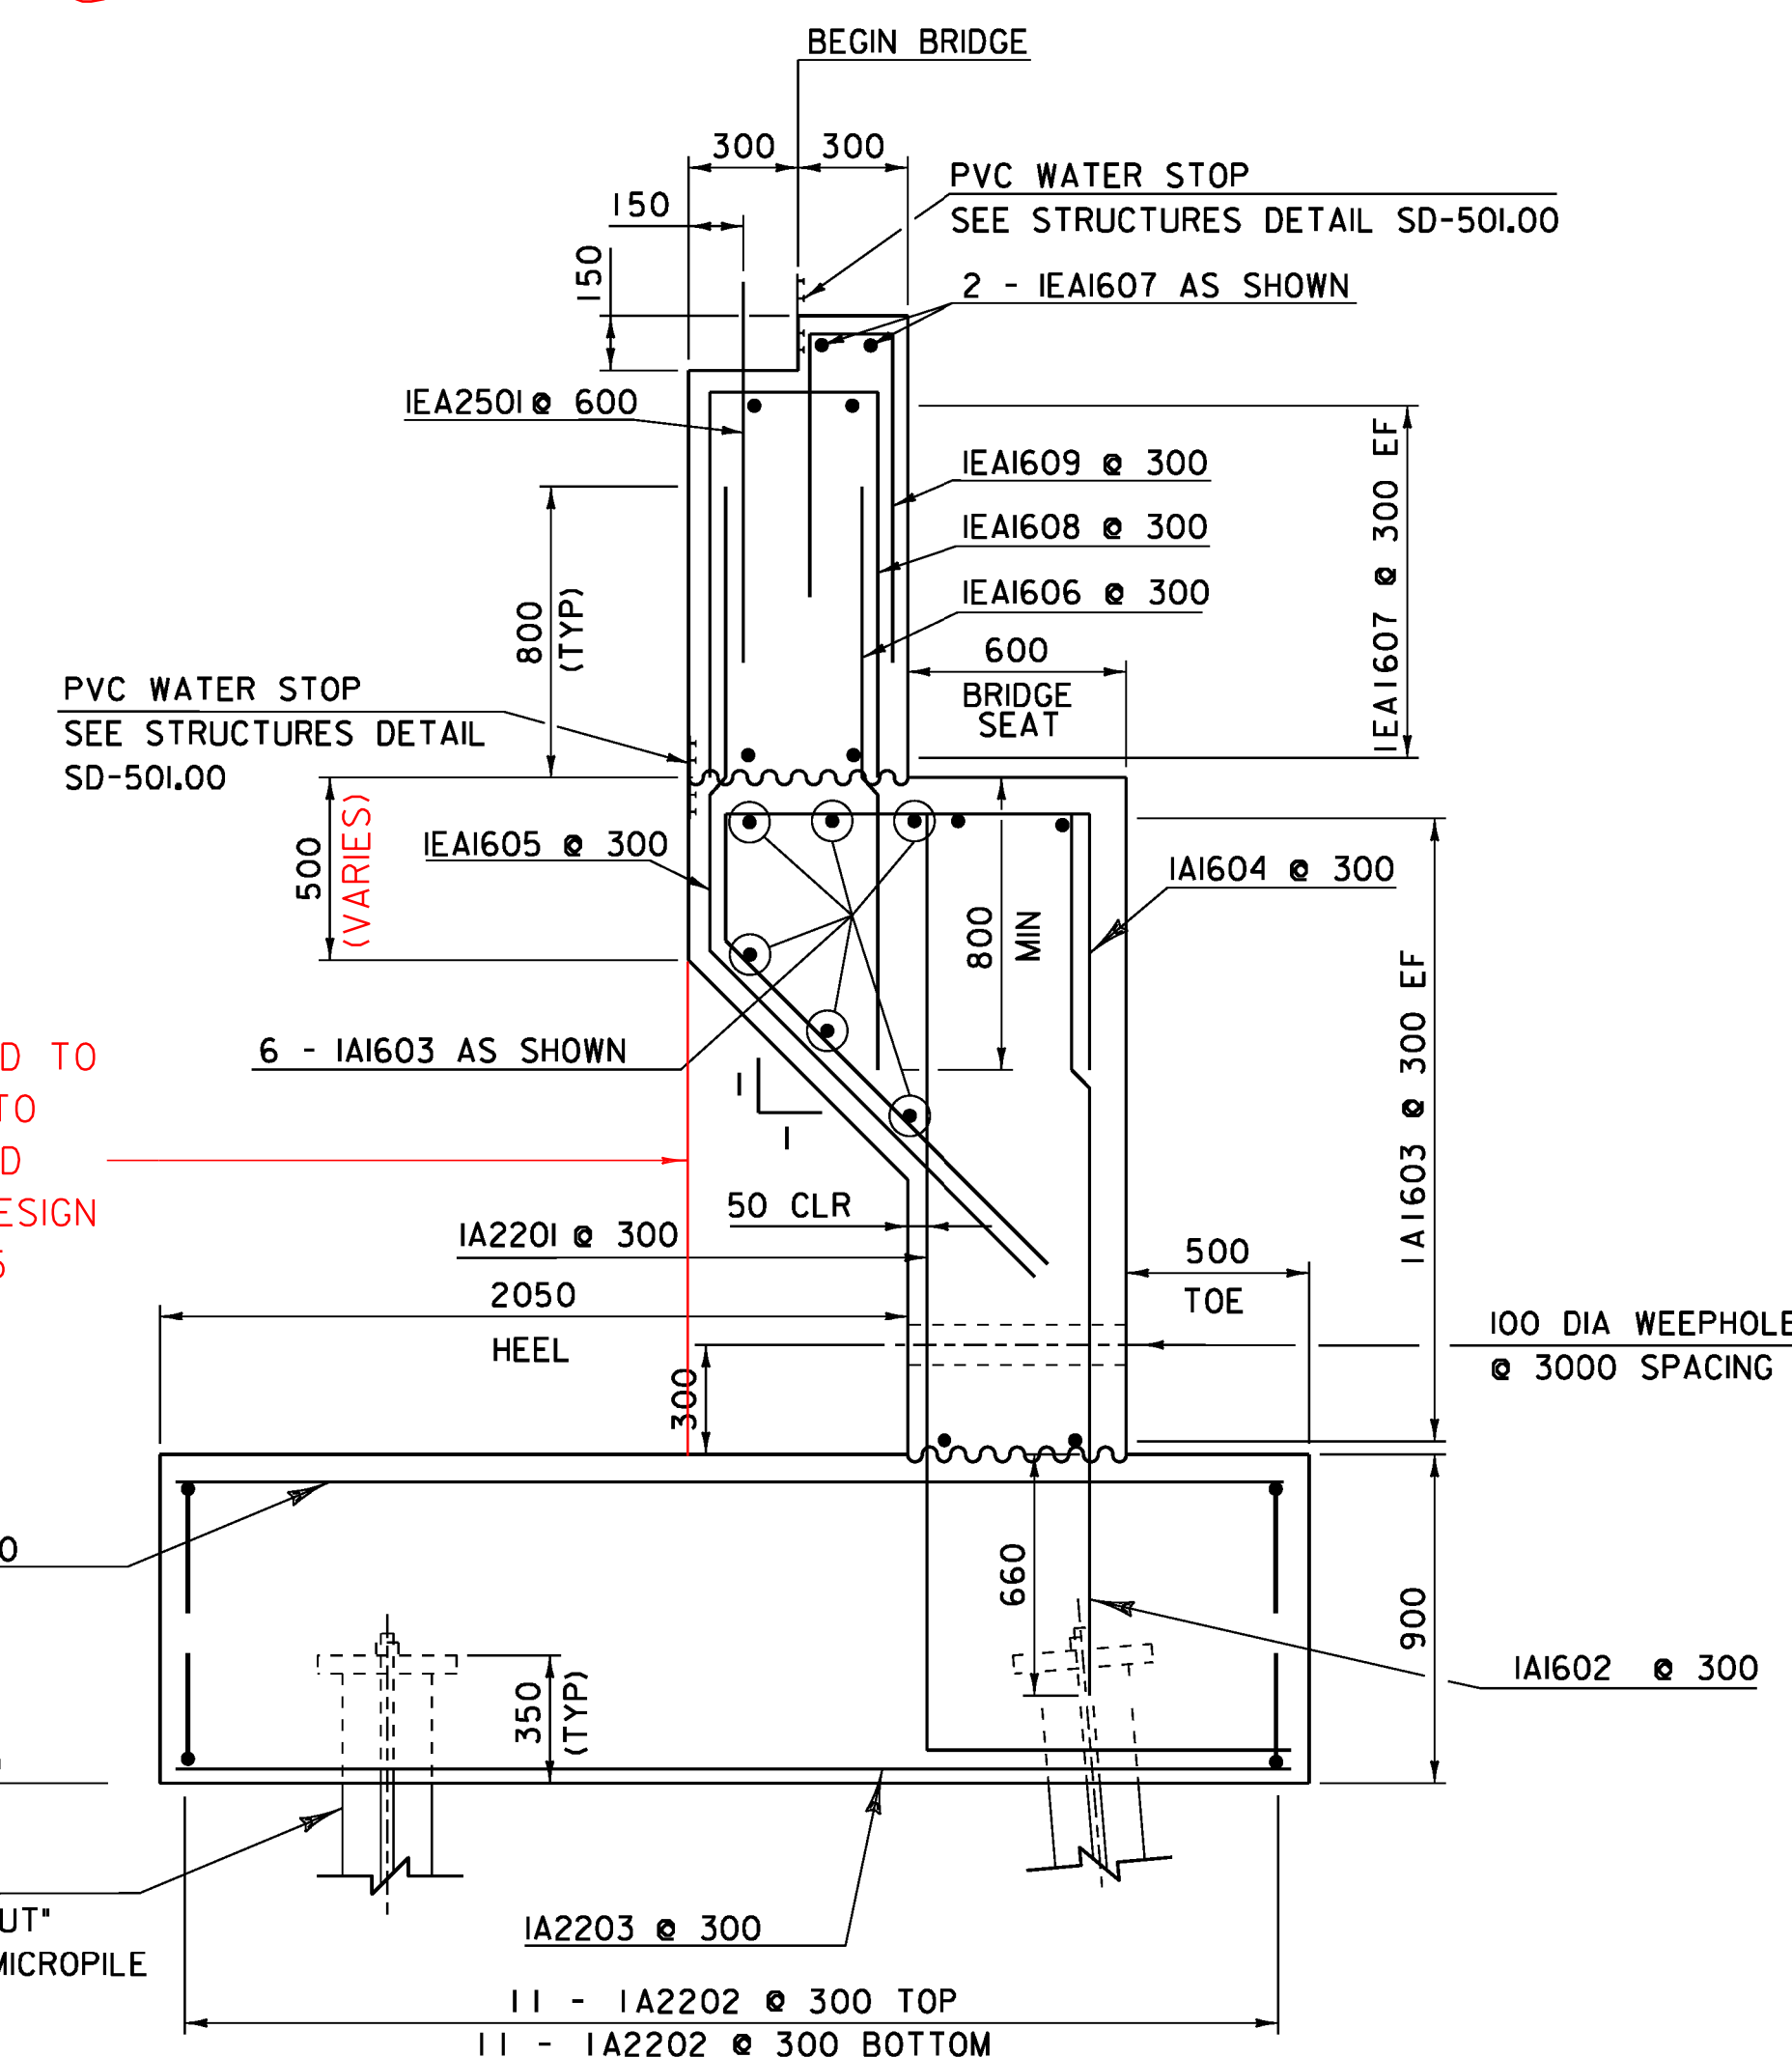


ABUTMENT #1 PLAN

SCALE = 1:50

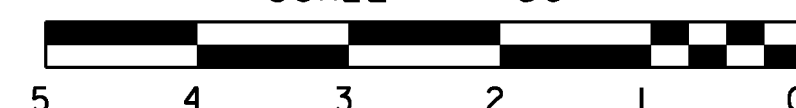


ABUTMENT #1 TYPICAL SECTION

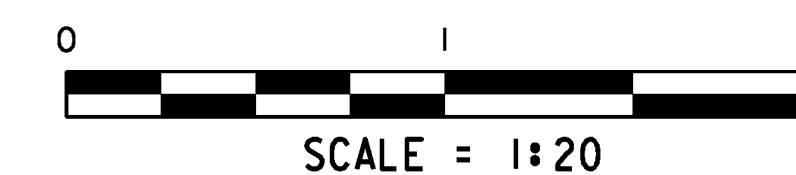


SCALE = 1:20

NF = NEAR FACE
FF = FAR FACE
EF = EACH FACE
▲ = CUT TO FIT IN FIELD

75 CLEAR, UNLESS OTHERWISE
SPECIFIED ON THE PLANS
660 BAR LAP UNLESS OTHERWISE
SPECIFIED ON THE PLANS

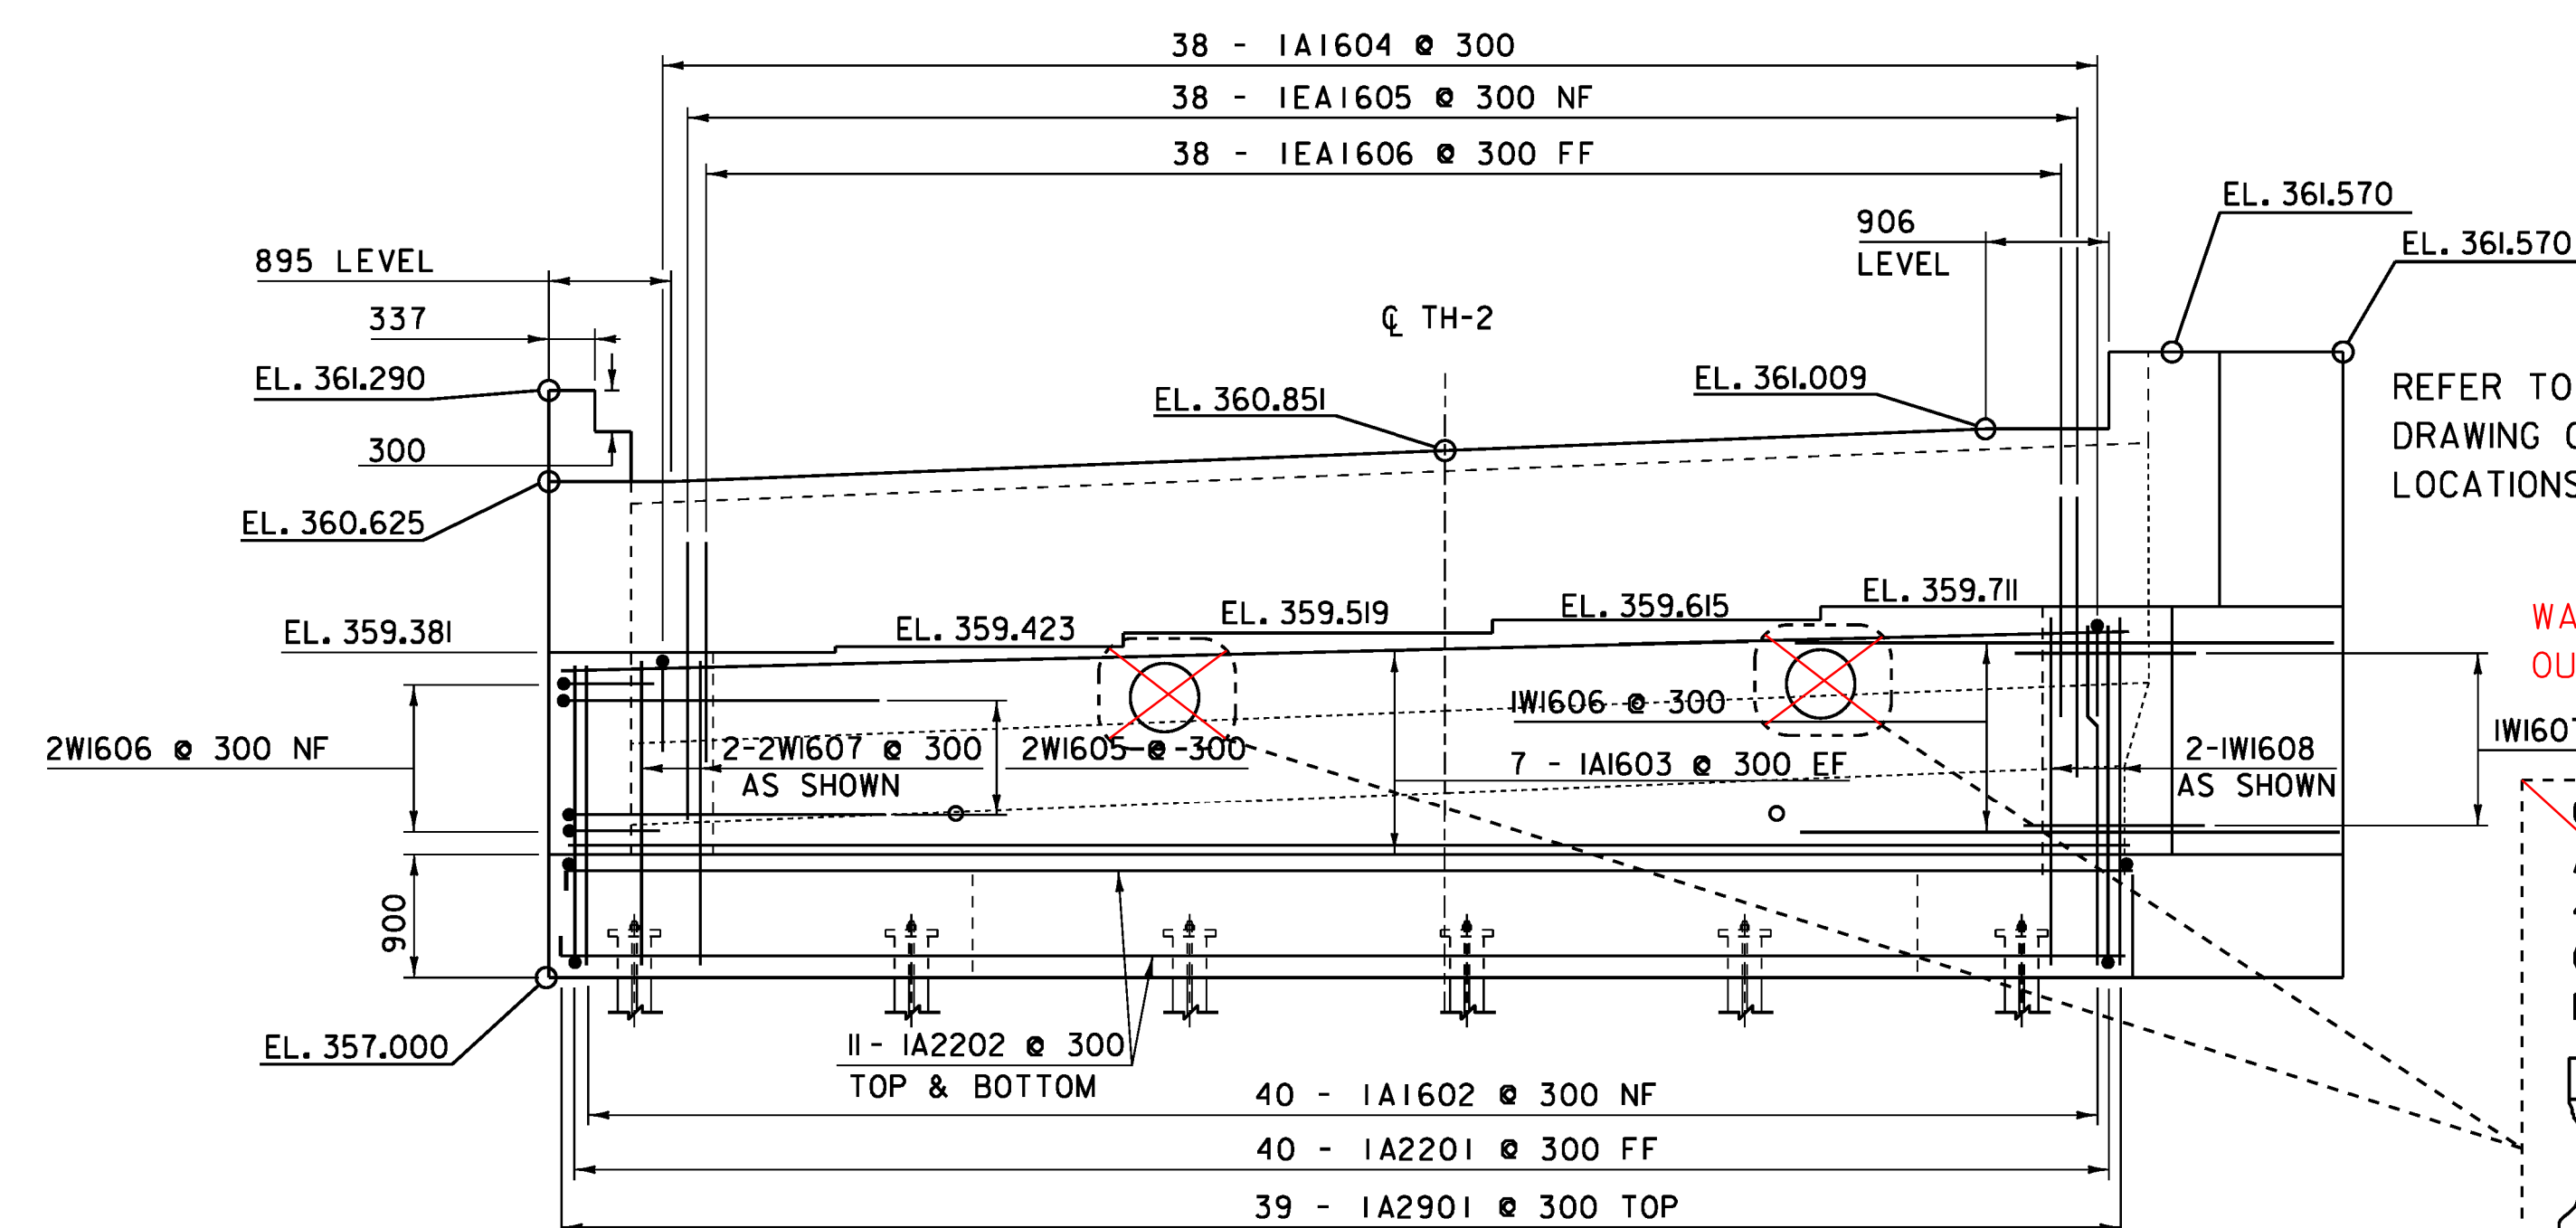

ABUTMENT #1 ELEVATION

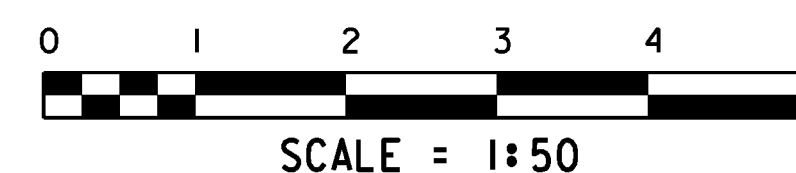

SCALE = 1:50


CONTRACTOR REQUESTED TO
POUR STRAIGHT DOWN TO
FACILITATE FORMING AND
OK'D BY PM (TYP). REDESIGN
ON SHEETS 1 THROUGH 5

REFER TO CONSULTANT (DUFRESNE GROUP)
DRAWING C2 FOR UTILITY PIPING
LOCATIONS IN ABUTMENTS.

WATER & SEWER LINES WERE RAISED AND INSTALLED
OUTSIDE OF FASCIA BEAMS. SEE CO#4, DATED 10/13/17

ORIENT ADDITIONAL REINFORCING
AT PIPE SLEEVE APPROX.
45 DEGREES TO MAIN REINFORCING
(BEND AS NEEDED,
DO NOT CUT)

ELIMINATED

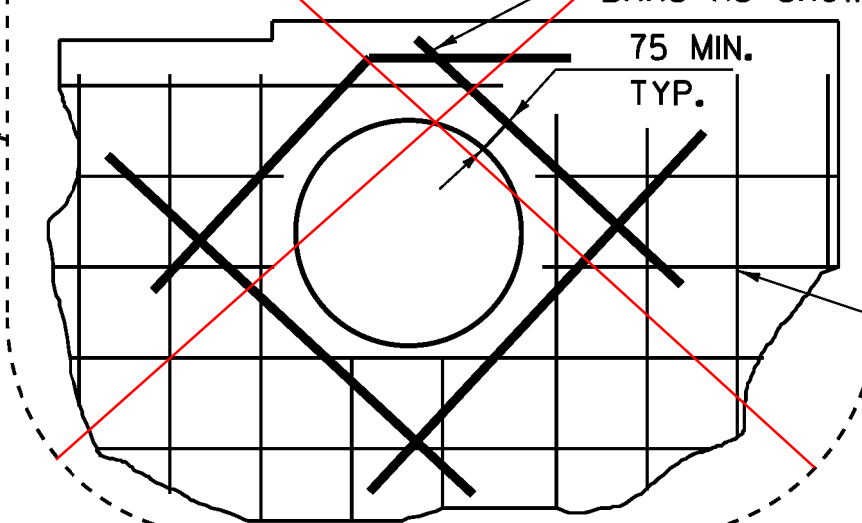

CONCEPTUAL POSITION OF
MAIN REINFORCEMENT

SEE REDESIGNED ABUTMENTS SHEETS 1 THROUGH 5

PROJECT NAME: READSBORO
PROJECT NUMBER: BRF 0105 (3)

FILE NAME: 89J088/STR/s89J088sub.dgn
PROJECT LEADER: J. LACROIX
DESIGNED BY: W. PELLETIER
ABUTMENT 1 DETAILS

PLOT DATE: 07-MAR-2012
DRAWN BY: G. ROKES
CHECKED BY: W. PELLETIER
SHEET 50 OF 90