

|    | <u>AASHTO</u>                     |
|----|-----------------------------------|
| A1 | Gravel and Sand                   |
| A3 | Fine Sand                         |
| A2 | Silty or Clayey Gravel and Sand   |
| A4 | Silty Soil - Low Compressibility  |
| A5 | Silty Soil - Highly Compressible  |
| A6 | Clayey Soil - Low Compressibility |
| A7 | Clayey Soil - Highly Compressible |

| R.O.D. (%) | ROCK DESCRIPTION |
|------------|------------------|
| <25        | Very Poor        |
| 25 to 50   | Poor             |
| 51 to 75   | Fair             |
| 76 to 90   | Good             |
| >90        | Excellent        |

| UNDRAINED<br>SHEAR STRENGTH<br>IN P.S.F. | CONSISTENCY |
|------------------------------------------|-------------|
| <250                                     | Very Soft   |
| 250-500                                  | Soft        |
| 500-1000                                 | Med. Stiff  |
| 1000-2000                                | Stiff       |
| 2000-4000                                | Very Stiff  |
| >4000                                    | Hard        |

| DENSITY<br>(GRANULAR SOILS) |                     | CONSISTENCY<br>(COHESIVE SOILS) |                     |
|-----------------------------|---------------------|---------------------------------|---------------------|
| N                           | DESCRIPTIVE<br>TERM | N                               | DESCRIPTIVE<br>TERM |
| <5                          | Very Loose          | <2                              | Very Soft           |
| 5-10                        | Loose               | 2-4                             | Soft                |
| 11-24                       | Med. Dense          | 5-8                             | Med. Stiff          |
| 25-50                       | Dense               | 9-15                            | Stiff               |
| >50                         | Very Dense          | 16-30                           | Very Stiff          |
|                             |                     | 31-60                           | Hard                |
|                             |                     | >60                             | Very Hard           |


|       |                                   |
|-------|-----------------------------------|
| ▼     | Water Elevation                   |
| ⊙     | Standard Penetration Boring       |
| ⊕     | Auger Boring                      |
| ○     | Rod Sounding                      |
| S     | Sample                            |
| N     | Standard Penetration Test         |
|       | Blow Count Per Foot For:          |
|       | 2' 0. D. Sampler                  |
|       | 1 3/8" I. D. Sampler              |
|       | Hammer Weight Of 140 Lbs.         |
|       | Hammer Fall Of 30"                |
| VS    | Field Vane Shear Test             |
| US    | Undisturbed Soil Sample           |
| B     | Blast                             |
| DC    | Diamond Core                      |
| MD    | Mud Drill                         |
| WA    | Wash Ahead                        |
| HSA   | Hollow Stem Auger                 |
| AX    | Core Size 1 1/8"                  |
| BX    | Core Size 1 3/8"                  |
| NX    | Core Size 2 1/8"                  |
| M     | Double Tube Core Barrel Used      |
| LL    | Liquid Limit                      |
| PL    | Plastic Limit                     |
| PI    | Plasticity Index                  |
| NP    | Non Plastic                       |
| w     | Moisture Content (Dry Wgt. Basis) |
| M     | Dry                               |
| D     | Moist                             |
| MTW   | Moist To Wet                      |
| W     | Wet                               |
| Sat   | Saturated                         |
| Bo    | Boulder                           |
| Gr    | Gravel                            |
| Sa    | Sand                              |
| Si    | Silt                              |
| Cl    | Clay                              |
| HP    | Hardpan                           |
| Le    | Ledge                             |
| NLTD  | No Ledge To Depth                 |
| CNPF  | Can Not Penetrate Further         |
| TLOB  | To Ledge Or Boulder               |
| NR    | No Recovery                       |
| Rec.  | Recovery                          |
| %Rec. | Percent Recovery                  |
| ROD   | Rock Quality Designation          |
| CBR   | California Bearing Ratio          |
| <     | Less Than                         |
| >     | Greater Than                      |
| R     | Refusal (N > 100)                 |

|     |        |      |              |
|-----|--------|------|--------------|
| blk | Black  | pnk  | Pink         |
| bl  | Blue   | pu   | Purple       |
| brn | Brown  | rd   | Red          |
| dk  | Dark   | tn   | Tan          |
| gry | Gray   | wh   | White        |
| gn  | Green  | yel  | Yellow       |
| lt  | Light  | mltc | Multicolored |
| or  | Orange |      |              |

| ELEV.            | DEPTH | BLOWS ON CASING<br>SAMPLING PENETRATION | SAMPLE NUMBER | MOISTURE | COLOR | LABORATORY CLASSIFICATION OF SOIL                                                                                                                                                                                        |
|------------------|-------|-----------------------------------------|---------------|----------|-------|--------------------------------------------------------------------------------------------------------------------------------------------------------------------------------------------------------------------------|
| ELEV. 1151.51    |       |                                         | P             | DRY      | BRN   | A-1-b GrSa w/trace of W=9 Rec. 0.4 BOULDERS                                                                                                                                                                              |
|                  |       |                                         |               |          |       |                                                                                                                                                                                                                          |
|                  |       | R                                       |               | M        | BRN   | A-1-a SaGr Rec. 1.0 W=8.9                                                                                                                                                                                                |
|                  |       | R                                       |               | DRY      | BRN   | A-1-b GrSa Rec. 0.9 W=9.0                                                                                                                                                                                                |
|                  | 10    | T9                                      |               | DRY      | BRN   | A-2-4 GrSiSa Rec. 1.5 W=12.9                                                                                                                                                                                             |
| OTTOM OF FOOTING |       | R                                       |               | DRY      | BRN   | A-2-4 SiSa Rec. 0.6 W=13.7                                                                                                                                                                                               |
| UTMENT NO. 1     |       | R                                       |               | M        | BRN   | A-1-b GrSa Rec. 0.3                                                                                                                                                                                                      |
| E.V. 1138.00     |       | R                                       |               | DRY      | BRN   | A-2-4 GrSa Rec. 0.4 NO REC. W=12.2                                                                                                                                                                                       |
|                  | 20    |                                         |               |          |       | BOULDERS Top of Bedrock @ 22.0' Run 1: BXMDC 22.0-27.0 Rec. 3.5                                                                                                                                                          |
|                  |       |                                         |               |          |       | Run 2: BXMDC 27.0-32.0 Rec. 1.5                                                                                                                                                                                          |
|                  | 30    |                                         |               |          |       | See Geologist's Report                                                                                                                                                                                                   |
|                  |       |                                         |               |          |       | Hole stopped @ 32.0' in Bedrock                                                                                                                                                                                          |
|                  |       |                                         |               |          |       | Geologist's Report                                                                                                                                                                                                       |
|                  | 40    |                                         |               |          |       | Core consists of medium biotite gneiss. Fractures are moderately weathered surrounded by competent rock. Lost core is probably from the weathered zones. Weathered zones are moderately soft and the fresh rock is hard. |
|                  | 50    |                                         |               |          |       | RUN RECOV. ROD<br>1 70% 0<br>2 30% 0                                                                                                                                                                                     |

| ELEV.                                                | DEPTH | BLOWS ON<br>CASENO.<br>SAMPLER<br>PENETRATION | SAMPLE<br>NUMBER | MOISTURE | COLOR | LABORATORY<br>CLASSIFICATION<br>OF SOIL                                                                                                                         |
|------------------------------------------------------|-------|-----------------------------------------------|------------------|----------|-------|-----------------------------------------------------------------------------------------------------------------------------------------------------------------|
| ELEV. 1153.90                                        |       |                                               |                  |          |       |                                                                                                                                                                 |
|                                                      |       |                                               | 8                | M        | BRN   | A-2-4 SiSa W=24.2<br>Rec. 0.6                                                                                                                                   |
| 10                                                   |       |                                               |                  |          |       | BXDC 9.0'-11.0'<br>BOULDERS                                                                                                                                     |
| BOTTOM OF FOOTING<br>ABUTMENT NO. 2<br>ELEV. 1138.00 |       | R                                             |                  |          |       | NO REC.                                                                                                                                                         |
| 20                                                   |       |                                               | R                | M        | BRN   | A-1-b SaGr W=11.5<br>Rec. 0.3<br>Top of Bedrock @ 23.0'                                                                                                         |
|                                                      |       |                                               |                  |          |       | Run 1: BXMDC 23.0'-28.0'<br>Rec. 1.3<br>Run 2: BXMDC 28.0'-33.0'<br>Rec. 2.1<br>See Geologist's Report                                                          |
| 30                                                   |       |                                               |                  |          |       | Hole stopped @ 33.0' in Bedrock                                                                                                                                 |
|                                                      |       |                                               |                  |          |       | Geologist's Report:                                                                                                                                             |
| 40                                                   |       |                                               |                  |          |       | Core consists of medium grained biotite gneiss. The rock is moderately weathered, moderately soft but will be as competent bearing surface in a confined state. |
|                                                      |       |                                               |                  |          |       | RUN RECOV. ROD<br>1 25% 0<br>2 42% 10%                                                                                                                          |
| 50                                                   |       |                                               |                  |          |       |                                                                                                                                                                 |

| HOLE NO. | SURV. STATION | OFFSET | GROUND ELEV. | ELEV. TLOB |
|----------|---------------|--------|--------------|------------|
| B-1      | 2+27          | 23' LT | 1151.51      | 1129.51    |
| B-2      | 2+81          | 19' RT | 1153.90      | 1130.90    |

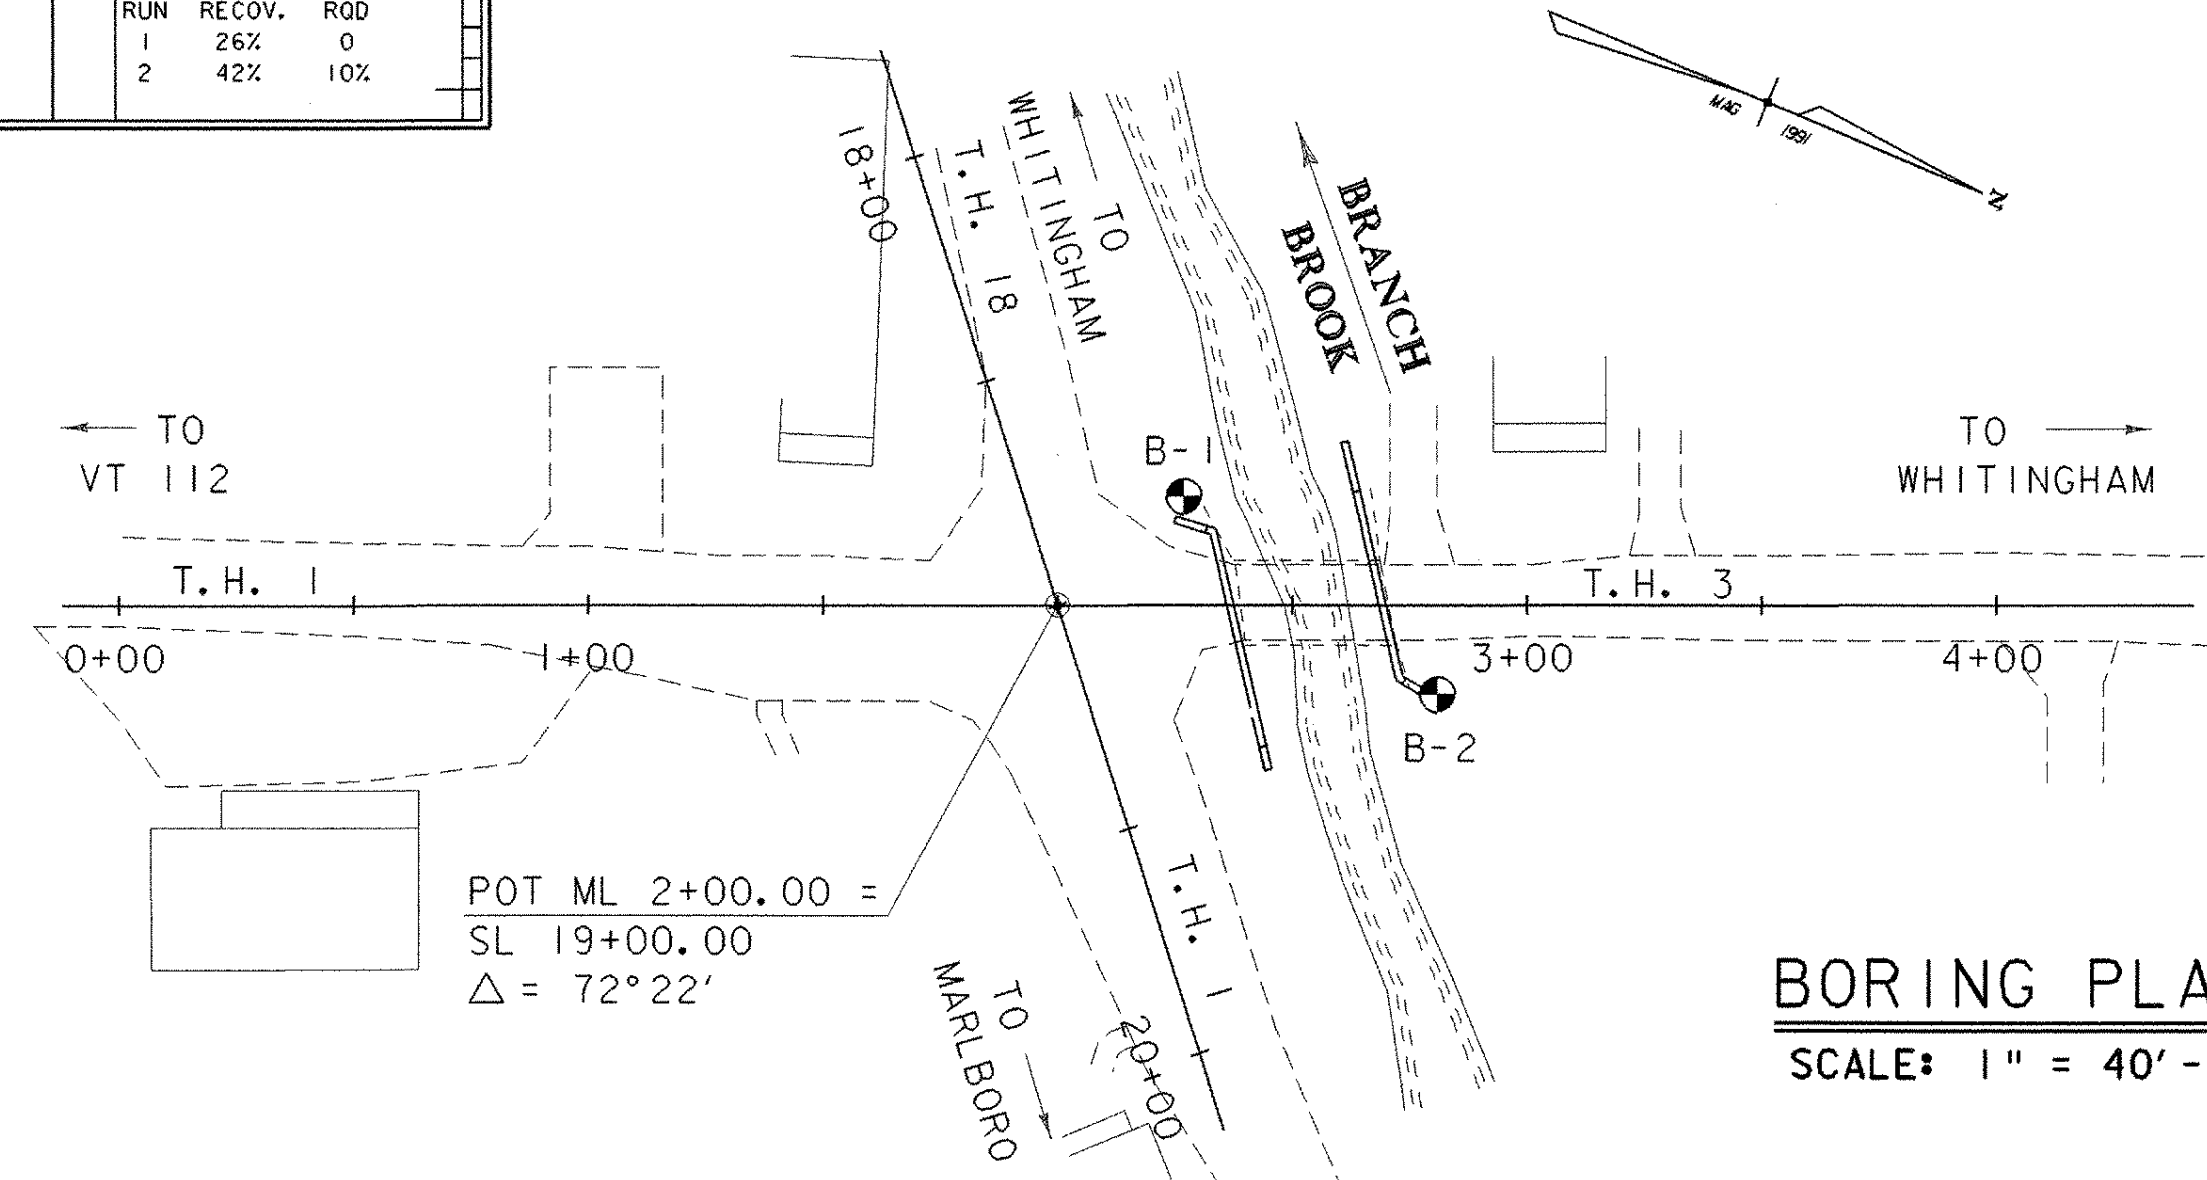

**BEDROCK (LEDGE)** - Rock in its native location of Indefinite thickness.

**BOULDER** - A rock fragment with an average dimension > 12 inches.

**COBBLE** - Rock fragments with an average dimension between 3 and 12 inches.

**GRAVEL** - Rounded particles of rock < 3" and > 0.075" (#10 sieve).

**SAND** - Particles of rock < 0.075" (#10 sieve) and > 0.0029" (#200 sieve).

**SILT** - Soil < 0.0029" (#200 sieve), non or slightly plastic and exhibits no strength when air-dried.

**CLAY** - Fine grained soil, exhibits plasticity when moist and considerable strength when air-dried.

**VARVED** - Alternate layers of silt and clay.

**HARDPAN** - Extremely dense soil, cemented layer, not softened when wet.

**MUCK** - Soft organic soil (containing > 10% organic material).

**MOISTURE CONTENT** - Weight of water divided by dry weight of soil.

**FLOWING SAND** - Granular soil so saturated (loose) that it flows into drill casing during extraction of wash rod.

**STRIKE** - Angle from magnetic north to line of intersection of bed with a horizontal plane.

**DIP** - Inclination of bed with a horizontal plane.

1. The subsurface explorations shown herein were made between 7-12-93 and 7-14-93 by the Agency.
2. Soil and rock classifications, properties and descriptions are based on engineering interpretation from available subsurface information by the Agency and may not necessarily reflect actual variations in subsurface conditions that may be encountered between individual boring or sample locations.
3. Observed water levels and/or conditions indicated are as recorded at the time of exploration and may vary according to the prevailing rainfall, methods of exploration and other factors.

4. Engineering Judgement was exercised in preparing the subsurface information presented herein. Analysis and interpretation of subsurface data was performed and interpreted for Agency design and estimating purposes. Presentation of the information in the Contract is intended to provide the Contractor access to the same data available to the Agency. The subsurface information is presented in good faith and is not intended as a substitute for personal investigation, independent interpretation, independent analysis or judgement by the Contractor.

5. Pictorial structure details shown on the boring plan layout or soils profile are for illustrative purposes only and may not accurately portray final contract details.
6. Terminology used on boring logs to describe the hardness, degree of weathering, and spacing of fractures, joints and other discontinuities in the bedrock is defined in the AASHTO Manual on Subsurface Investigations, 1988.

|                                                   |                                                         |                      |
|---------------------------------------------------|---------------------------------------------------------|----------------------|
| Town Of <i>HALIFAX</i>                            |                                                         | Bridge No. <i>28</i> |
| Highway No. <i>T. H. 3</i>                        | Log Sta. <i>2 + 53</i>                                  |                      |
| <i>T. H. 3 OVER THE BRANCH BROOK</i>              |                                                         |                      |
| <i>BORING INFORMATION SHEET</i>                   |                                                         |                      |
| Designed By <i>S. BAKI</i>                        | Drawn By <i>G. ROY</i>                                  |                      |
| Checked By <i>Date</i>                            | Bridge ID <i>1442</i> <i>BRZ 1442</i> <i>Supervisor</i> |                      |
| <i>T. SUMNER</i> <i>8/00</i>                      | <i>R. R. WHITCOMB</i> <i>Date 8/00</i>                  |                      |
| PROJECT <i>HALIFAX</i>                            | PROJECT NO. <i>BRZ 1442 (18)</i>                        |                      |
| I.G.C. Info. <i>89J092\structures\j092bor.dgn</i> |                                                         | <i>s\j092bor.j</i>   |
| Bridge Sheet No. <i>14</i>                        | Sheet <i>14</i> of <i>33</i>                            |                      |