



NOTE:  
FIELD CUT ALL SPILY EDGES AROUND CAP  
TYPICAL AT ALL TOWERS AT PIER AND ABUTMENTS.

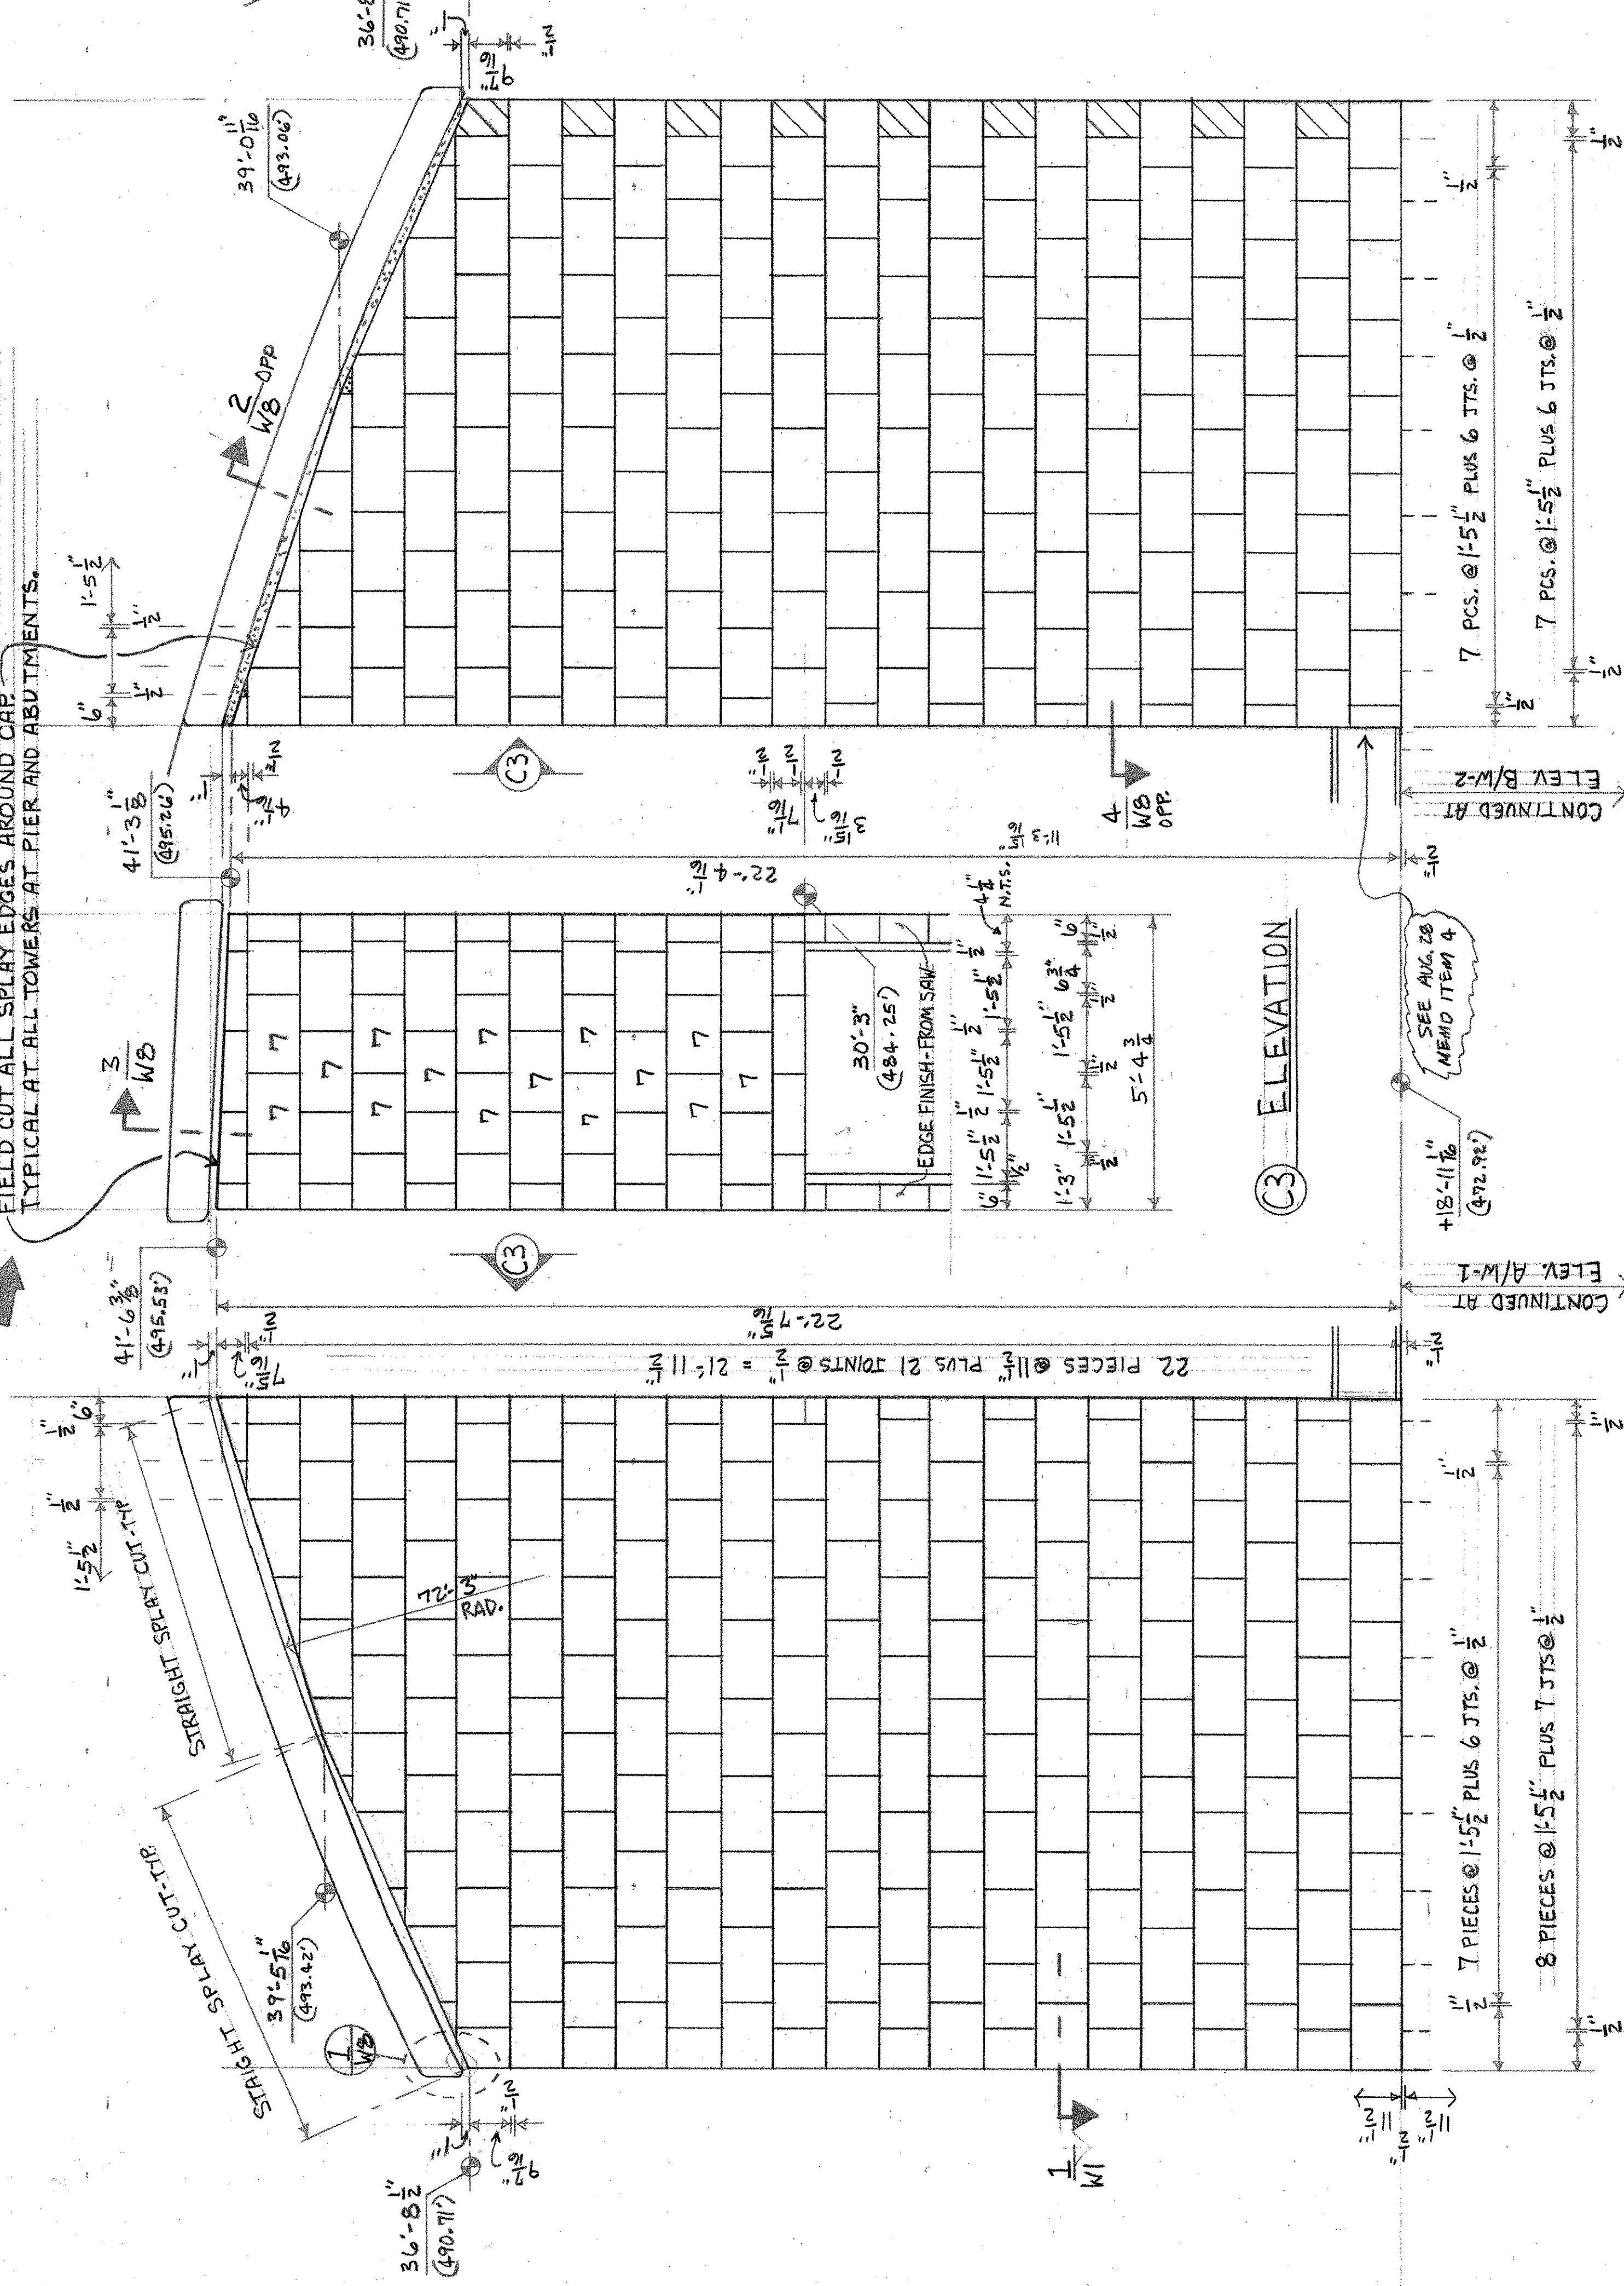


C2 ELEVATION

C4 ELEVATION

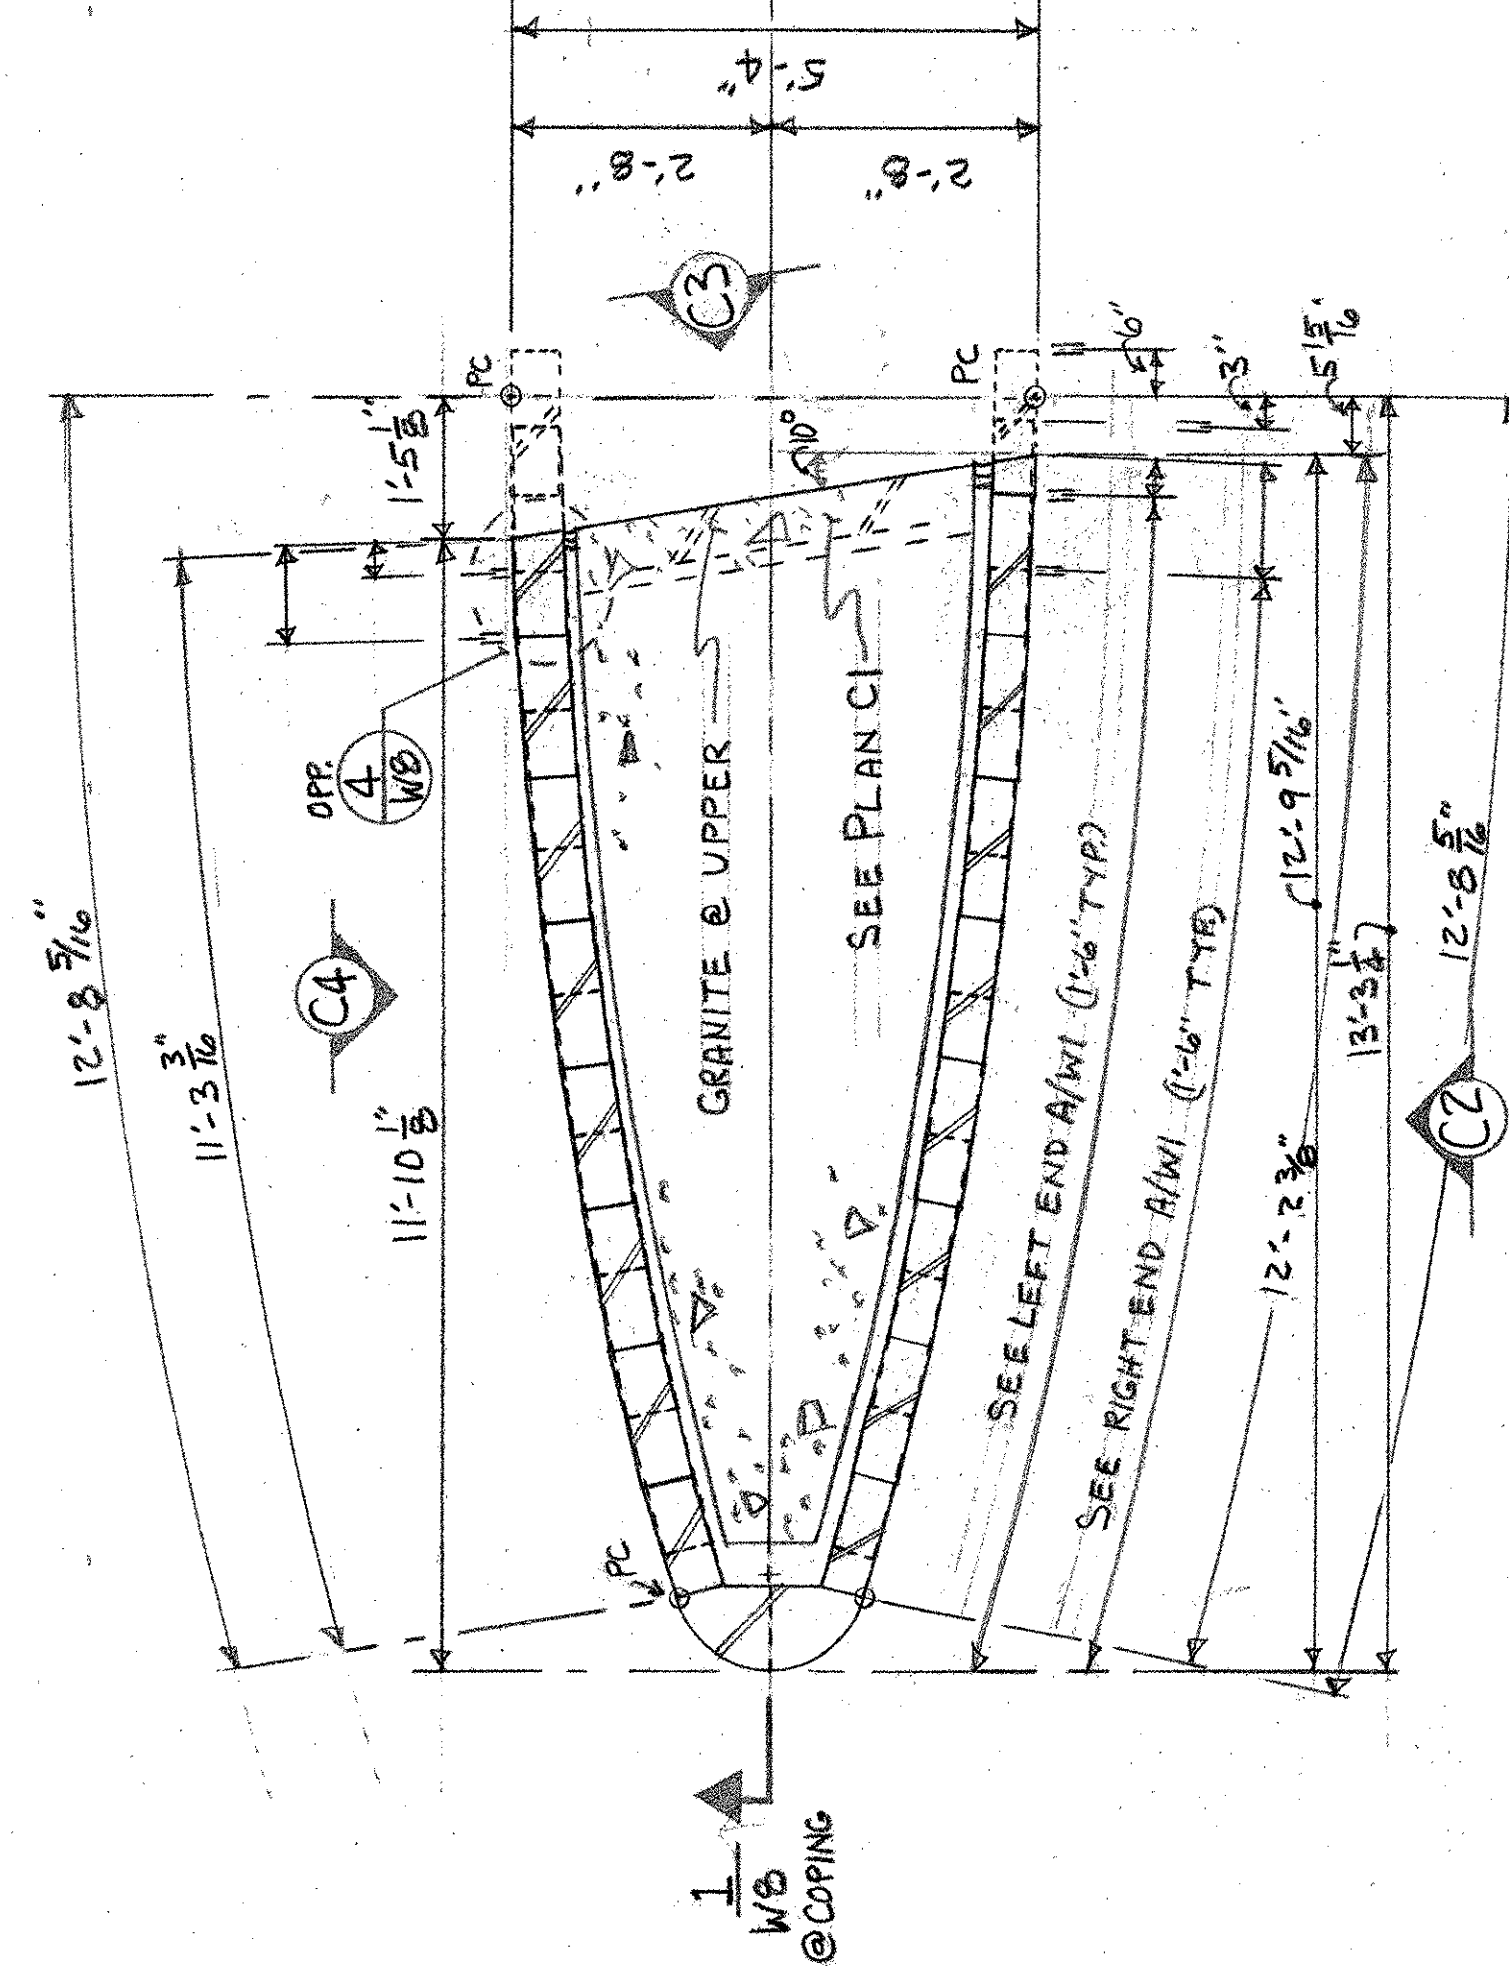

C PLAN

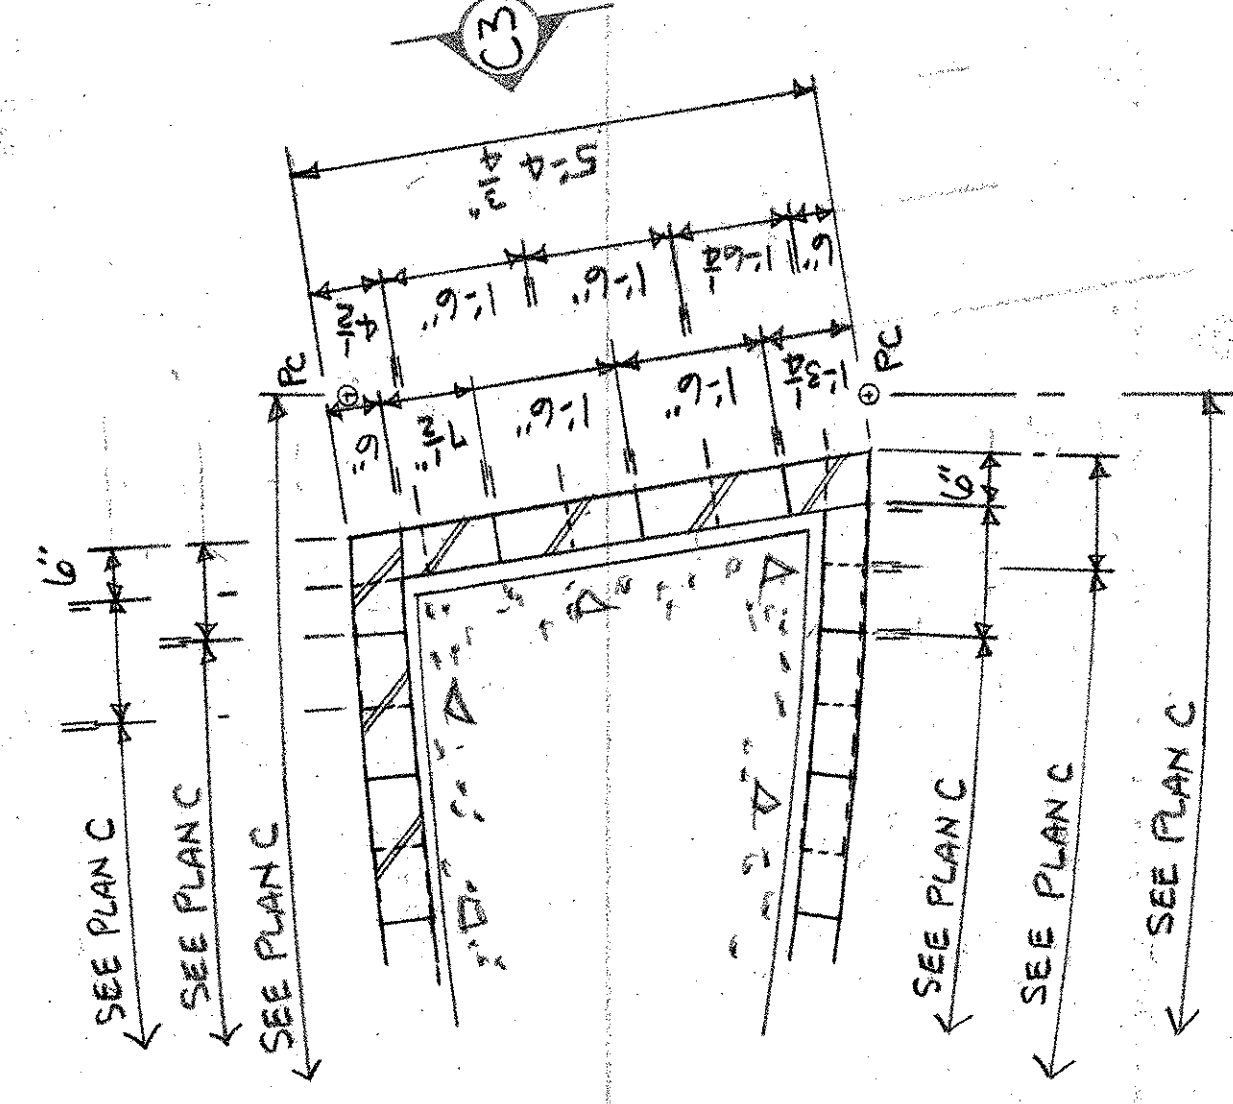

C1 PLAN

KEY PLAN  
SEE W-1 & W-2

NOTE:  
This shop drawing represents  
specifications, and our contract  
documents, and shall be used for  
construction, and erection of  
the structure, and shall be used  
by our customer.  
Approval of this drawing is not  
guarantee of the accuracy of the  
information contained herein.  
We assume no responsibility for  
errors or omissions in this drawing  
or for any consequences arising  
therefrom.

CKD BY  
RESUBMIT  
BY