


① DETAIL

② DETAIL

③ DETAIL


④ DETAIL 1/2"

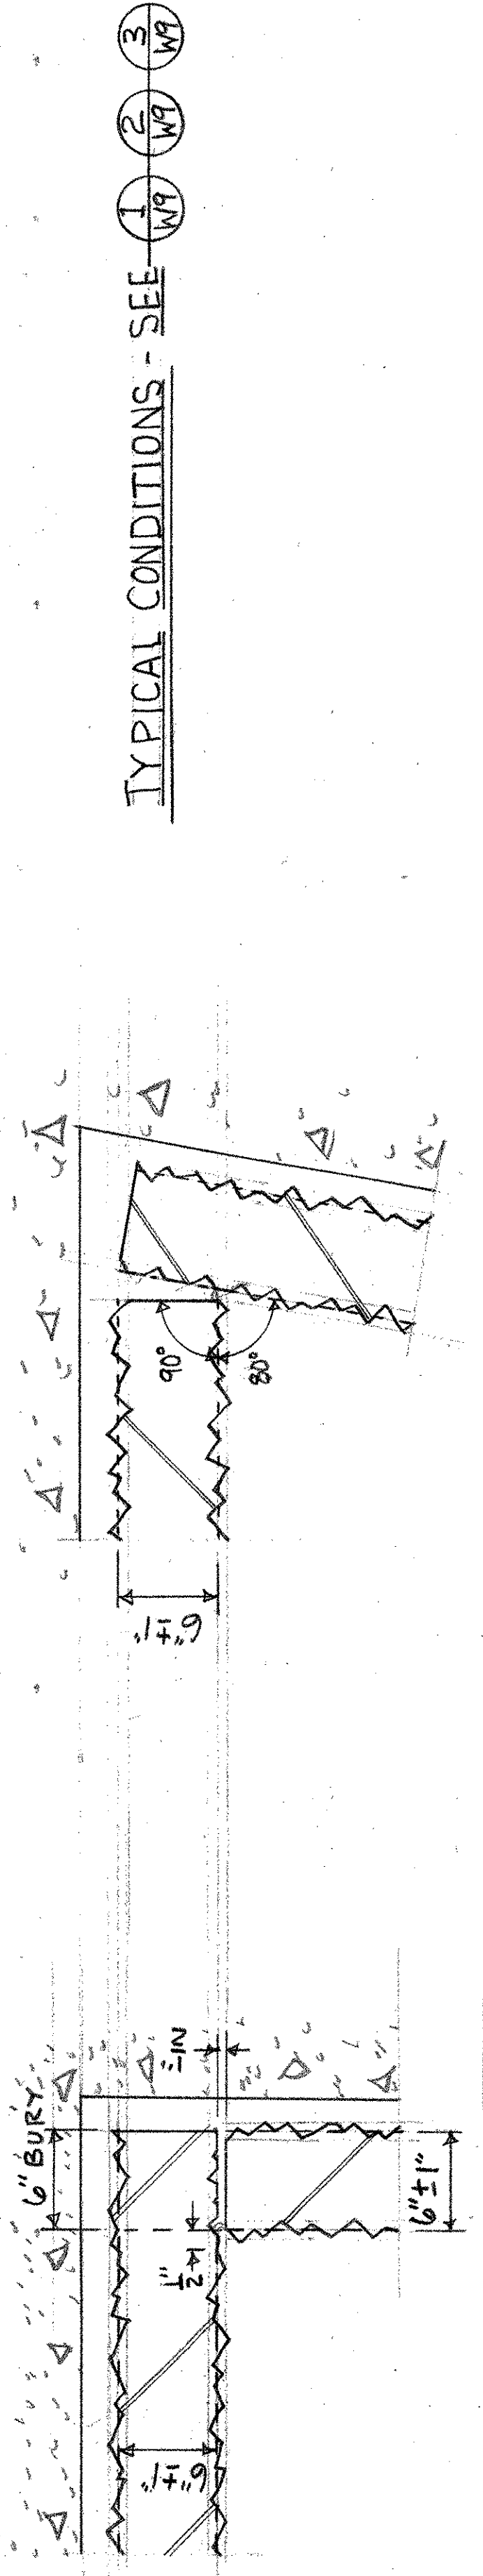


TYPICAL CONDITIONS - SEE ① ② ③ ④

⑨ DETAIL


⑧ DETAIL

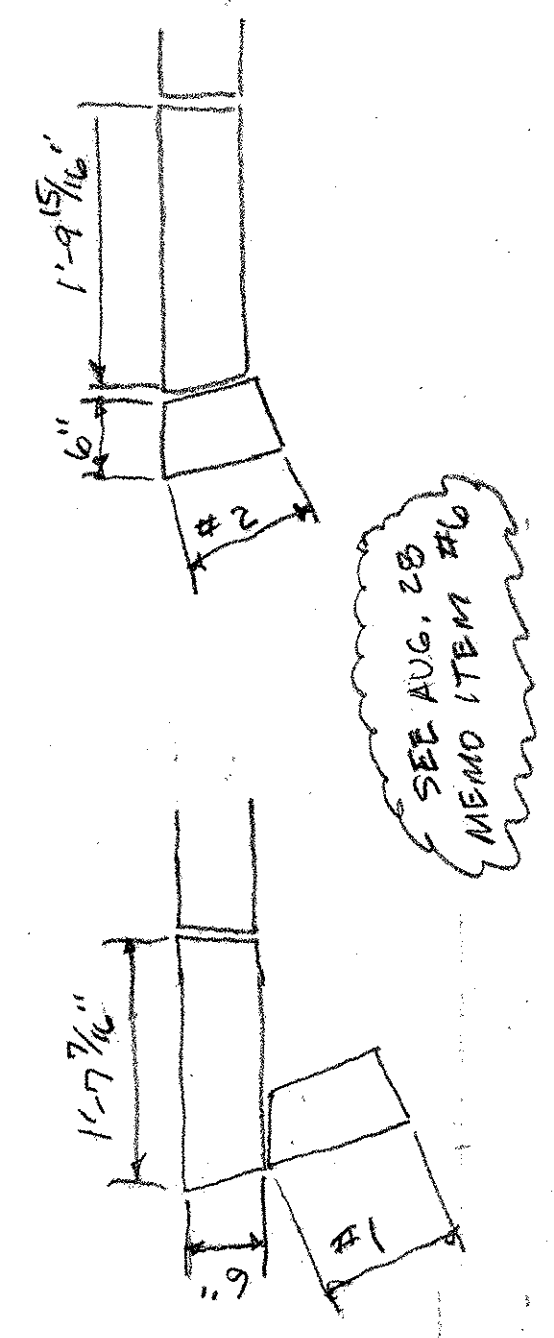

SEE AUG. 28
MEMO ITEM #16

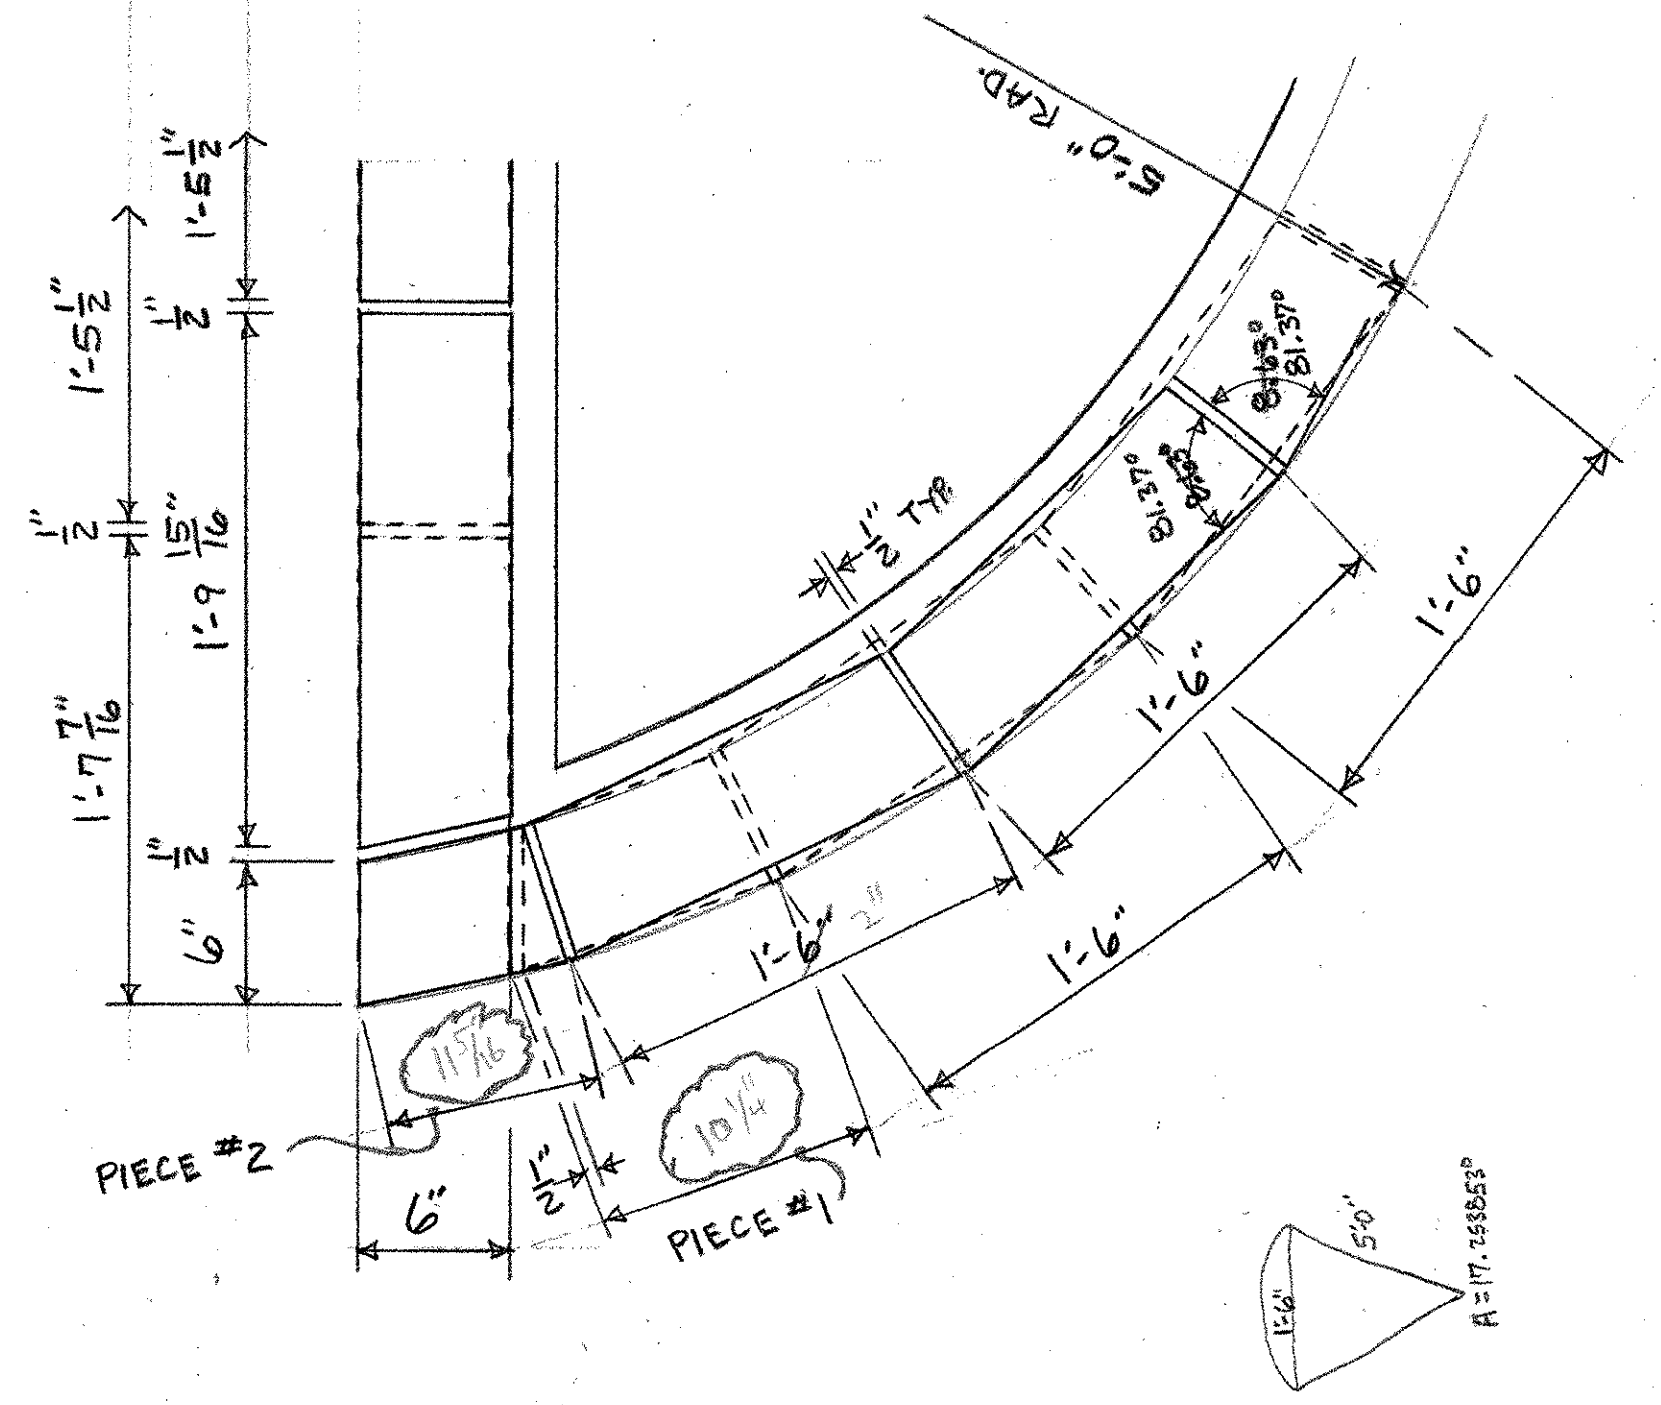

⑩ DETAIL

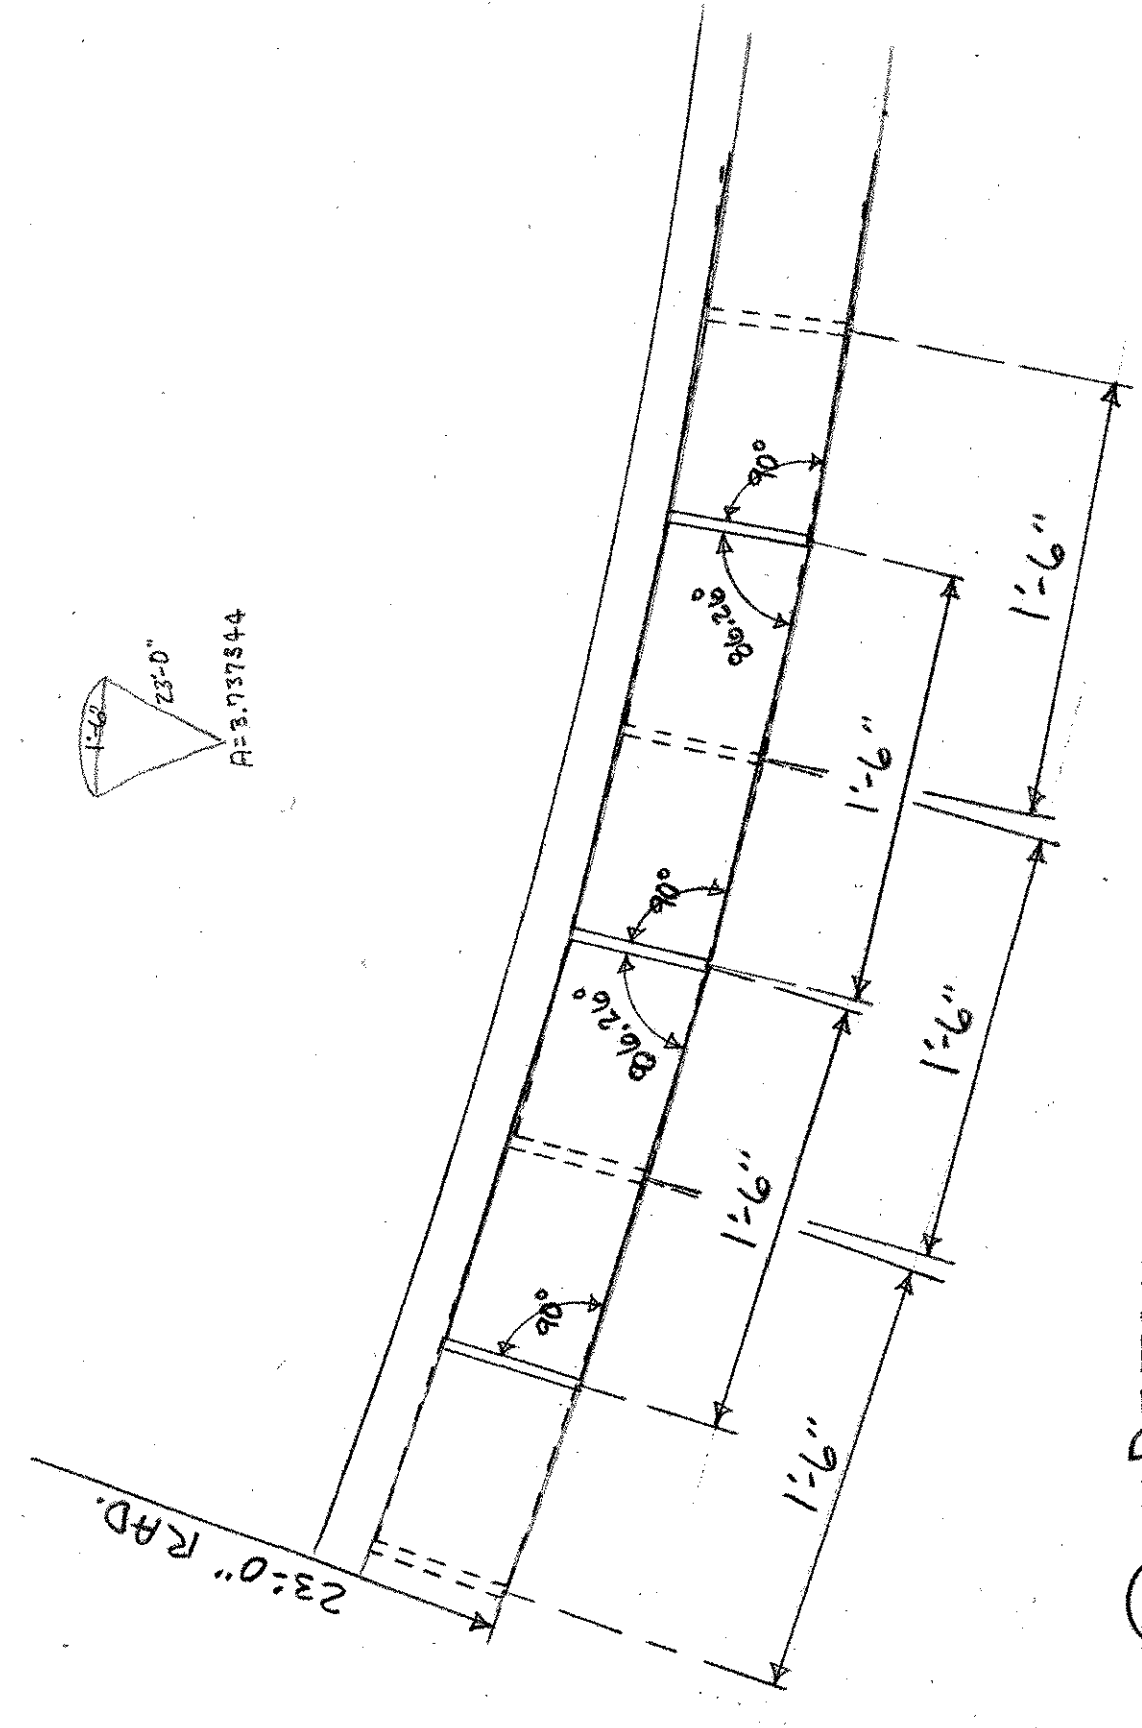

⑪ DETAIL

NOTE:
This drawing is prepared for the purpose of showing the general character of the work to be done. It is not intended to be a contract document. The contractor shall be responsible for the interpretation of the drawing and for the selection of materials and methods of construction. The contractor shall be responsible for the interpretation of the drawing and for the selection of materials and methods of construction. The contractor shall be responsible for the interpretation of the drawing and for the selection of materials and methods of construction.