
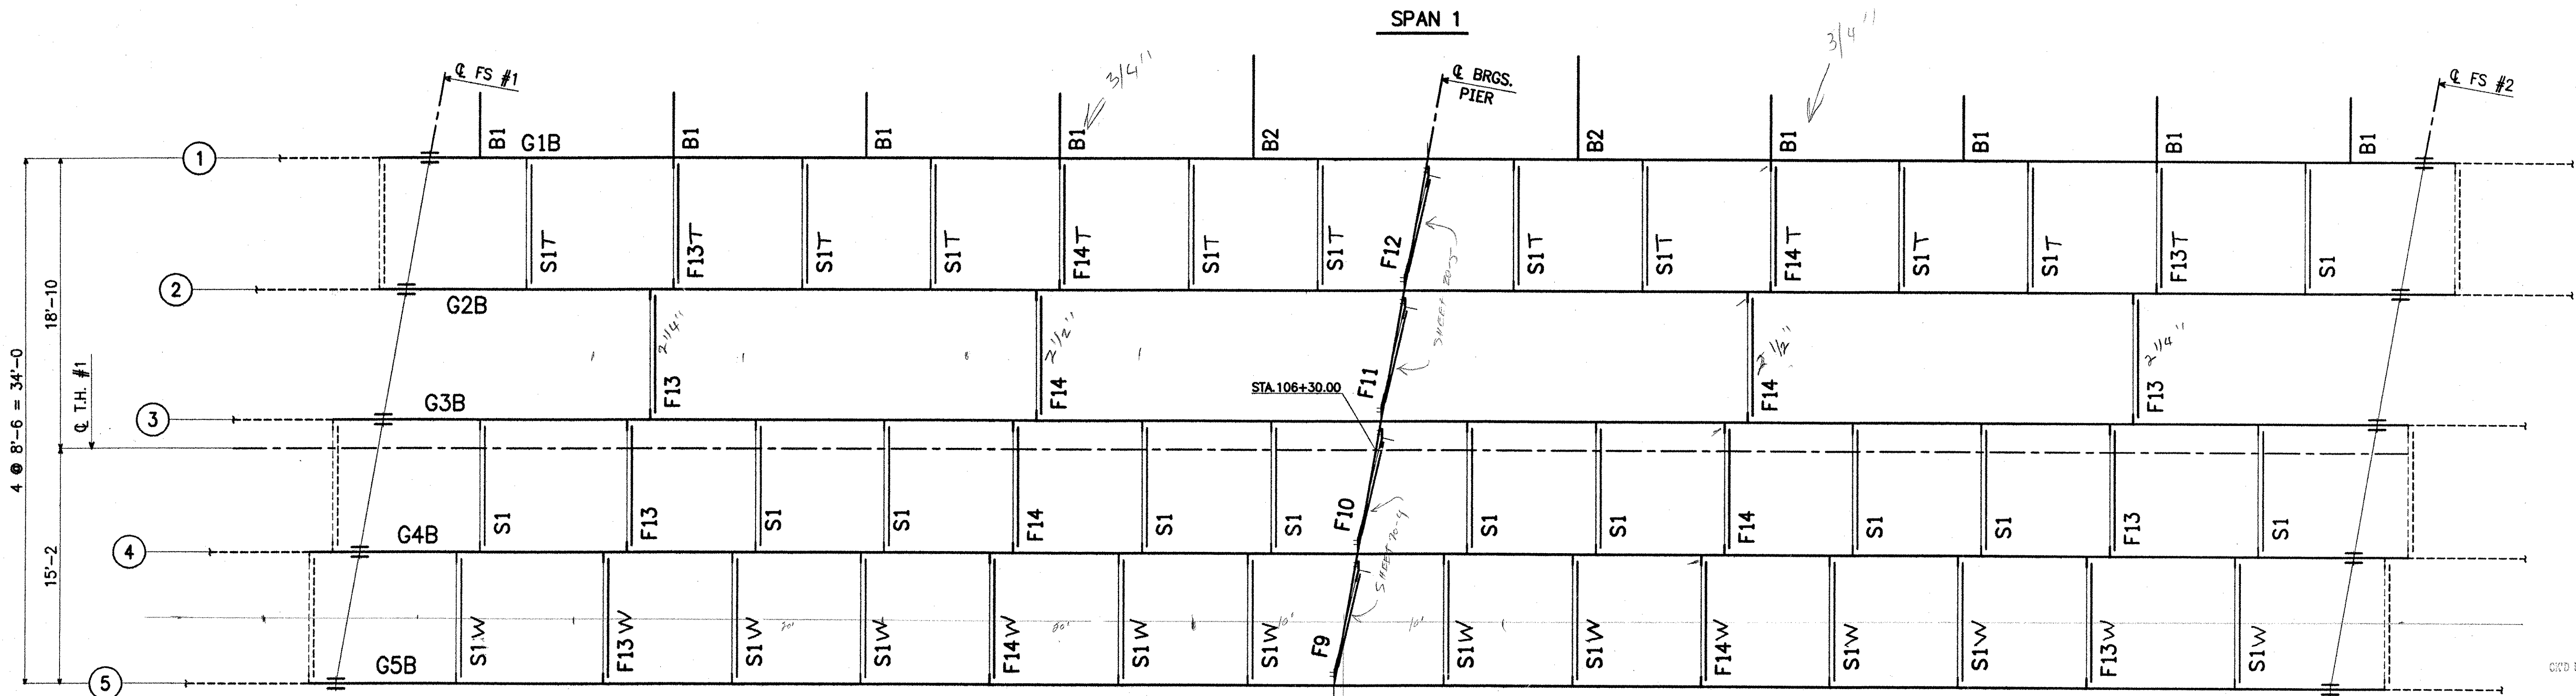


WORK ORDER NO.	DRAWING NO.	REV.
15873	E1	1

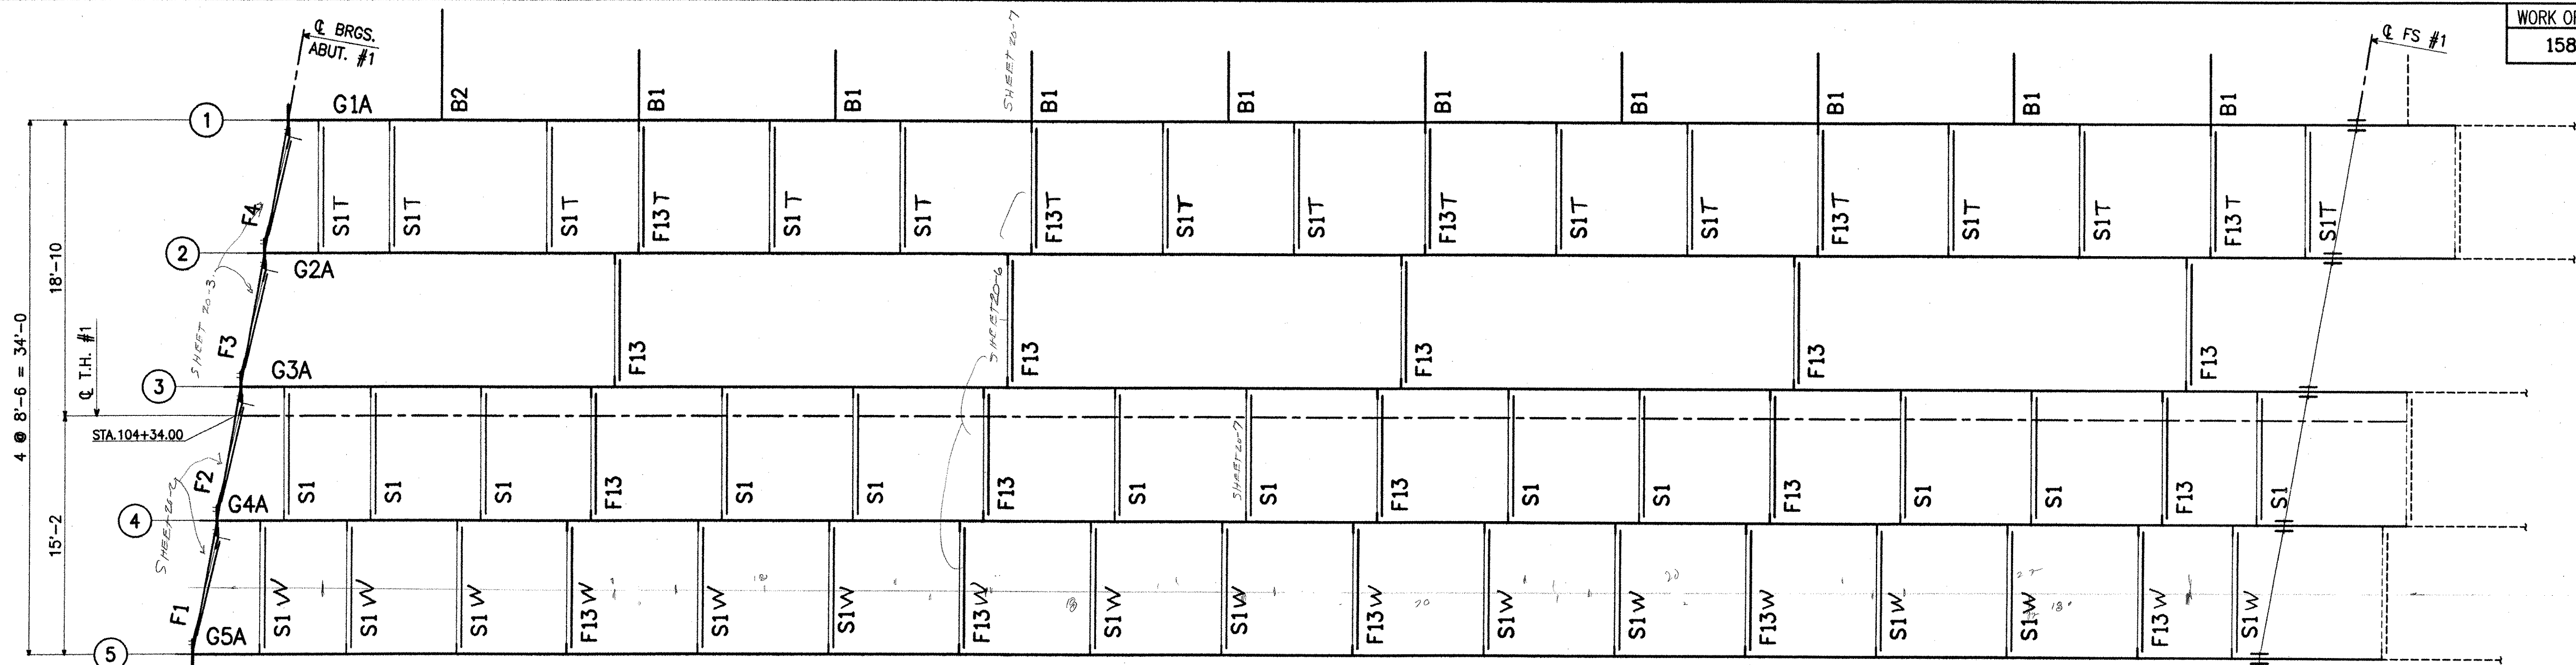

ERECTION PLAN

RECEIVED
NOV 21 2001
BY: CPW DATE: 11/20/01

FOR APPROVAL

ITEM NO. 506.55			BR. NO. 3		PROJ. NO. BRZ 1444(22)	
TITLE: ERECTION PLAN						
APPROVED: 9-5-01			NE National Eastern Corporation Plainville, Connecticut JOB: T.H. 1 OVER THE WHITE RIVER ROYALTON, VERMONT CUSTOMER: BECK & BELLUCCI, INC. DESIGNER: VERMONT AGENCY OF TRANSPORTATION WORK ORDER NO. 15873 DRAWING NO. E1 REV. 1			
PRINT DIST.						
5	4-7-01	APPR.				
ORIG.	9-5-01	FAB.				
5	7-13-01	APP				
5	8-24-01	APP				
5	11-19-01	APP				
11	11-19-01	FAB				

PC MKS 11-12-01 JCM