




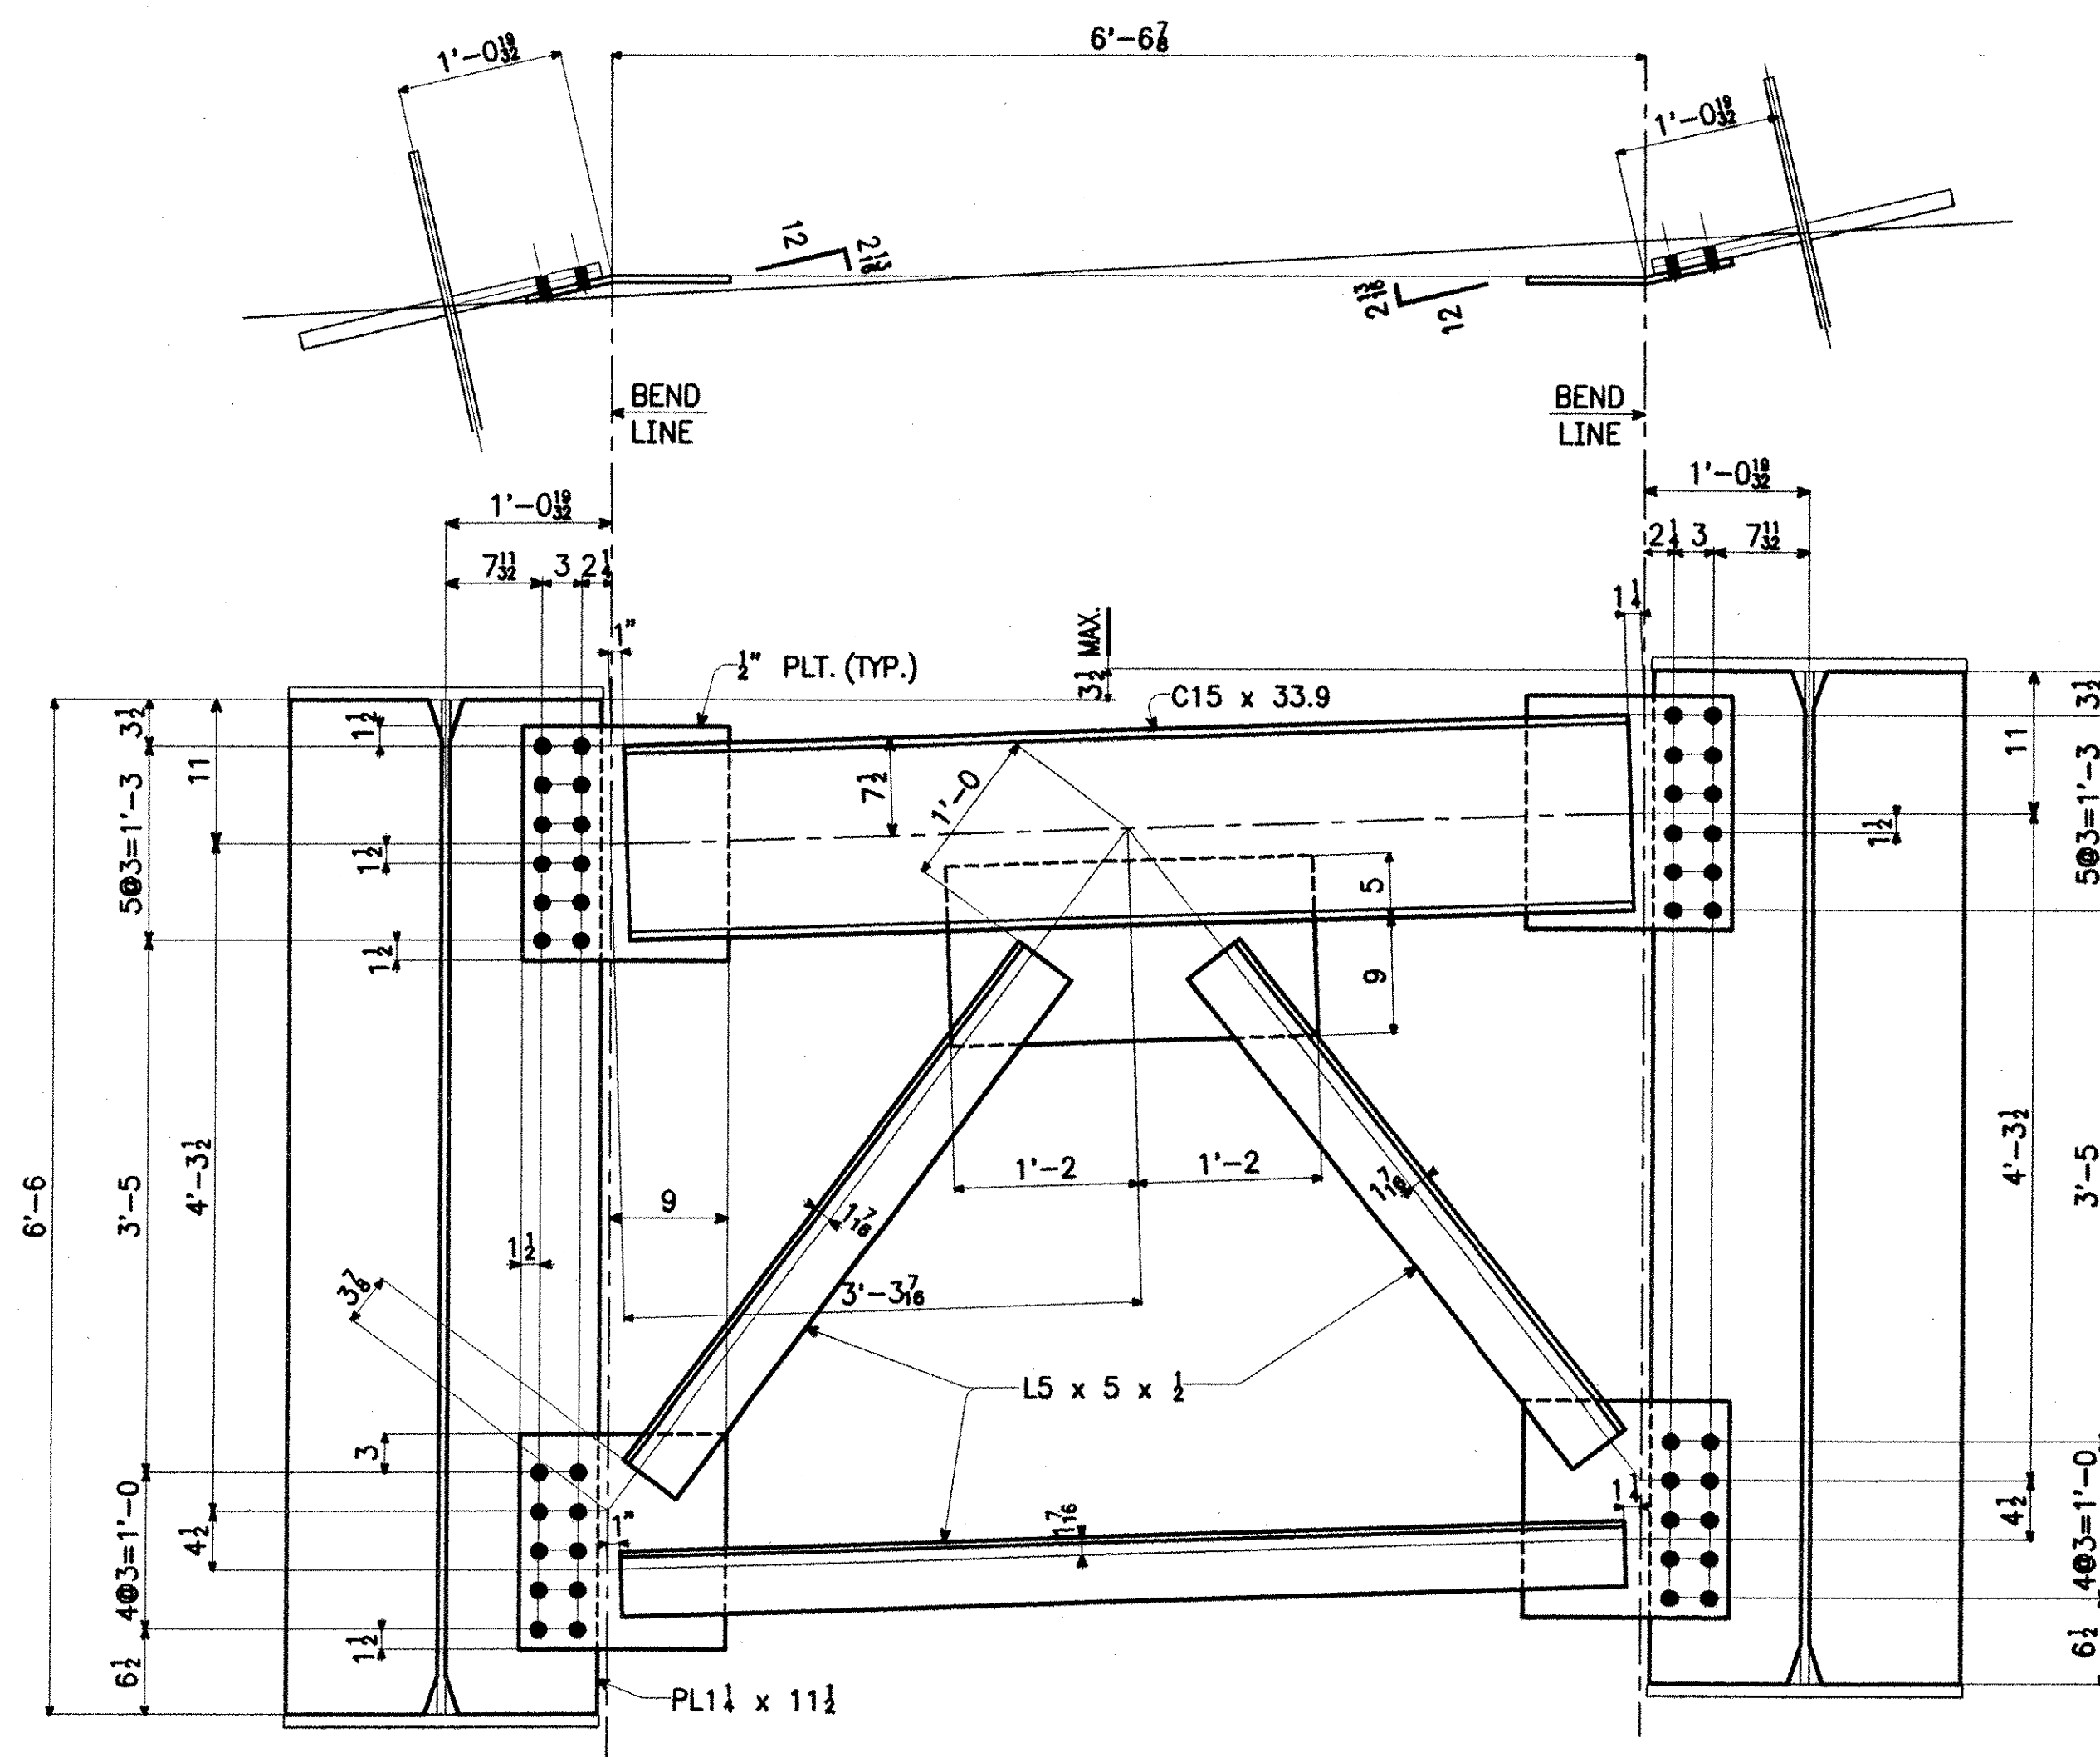

ABUT. CROSSFRAME LAYOUT

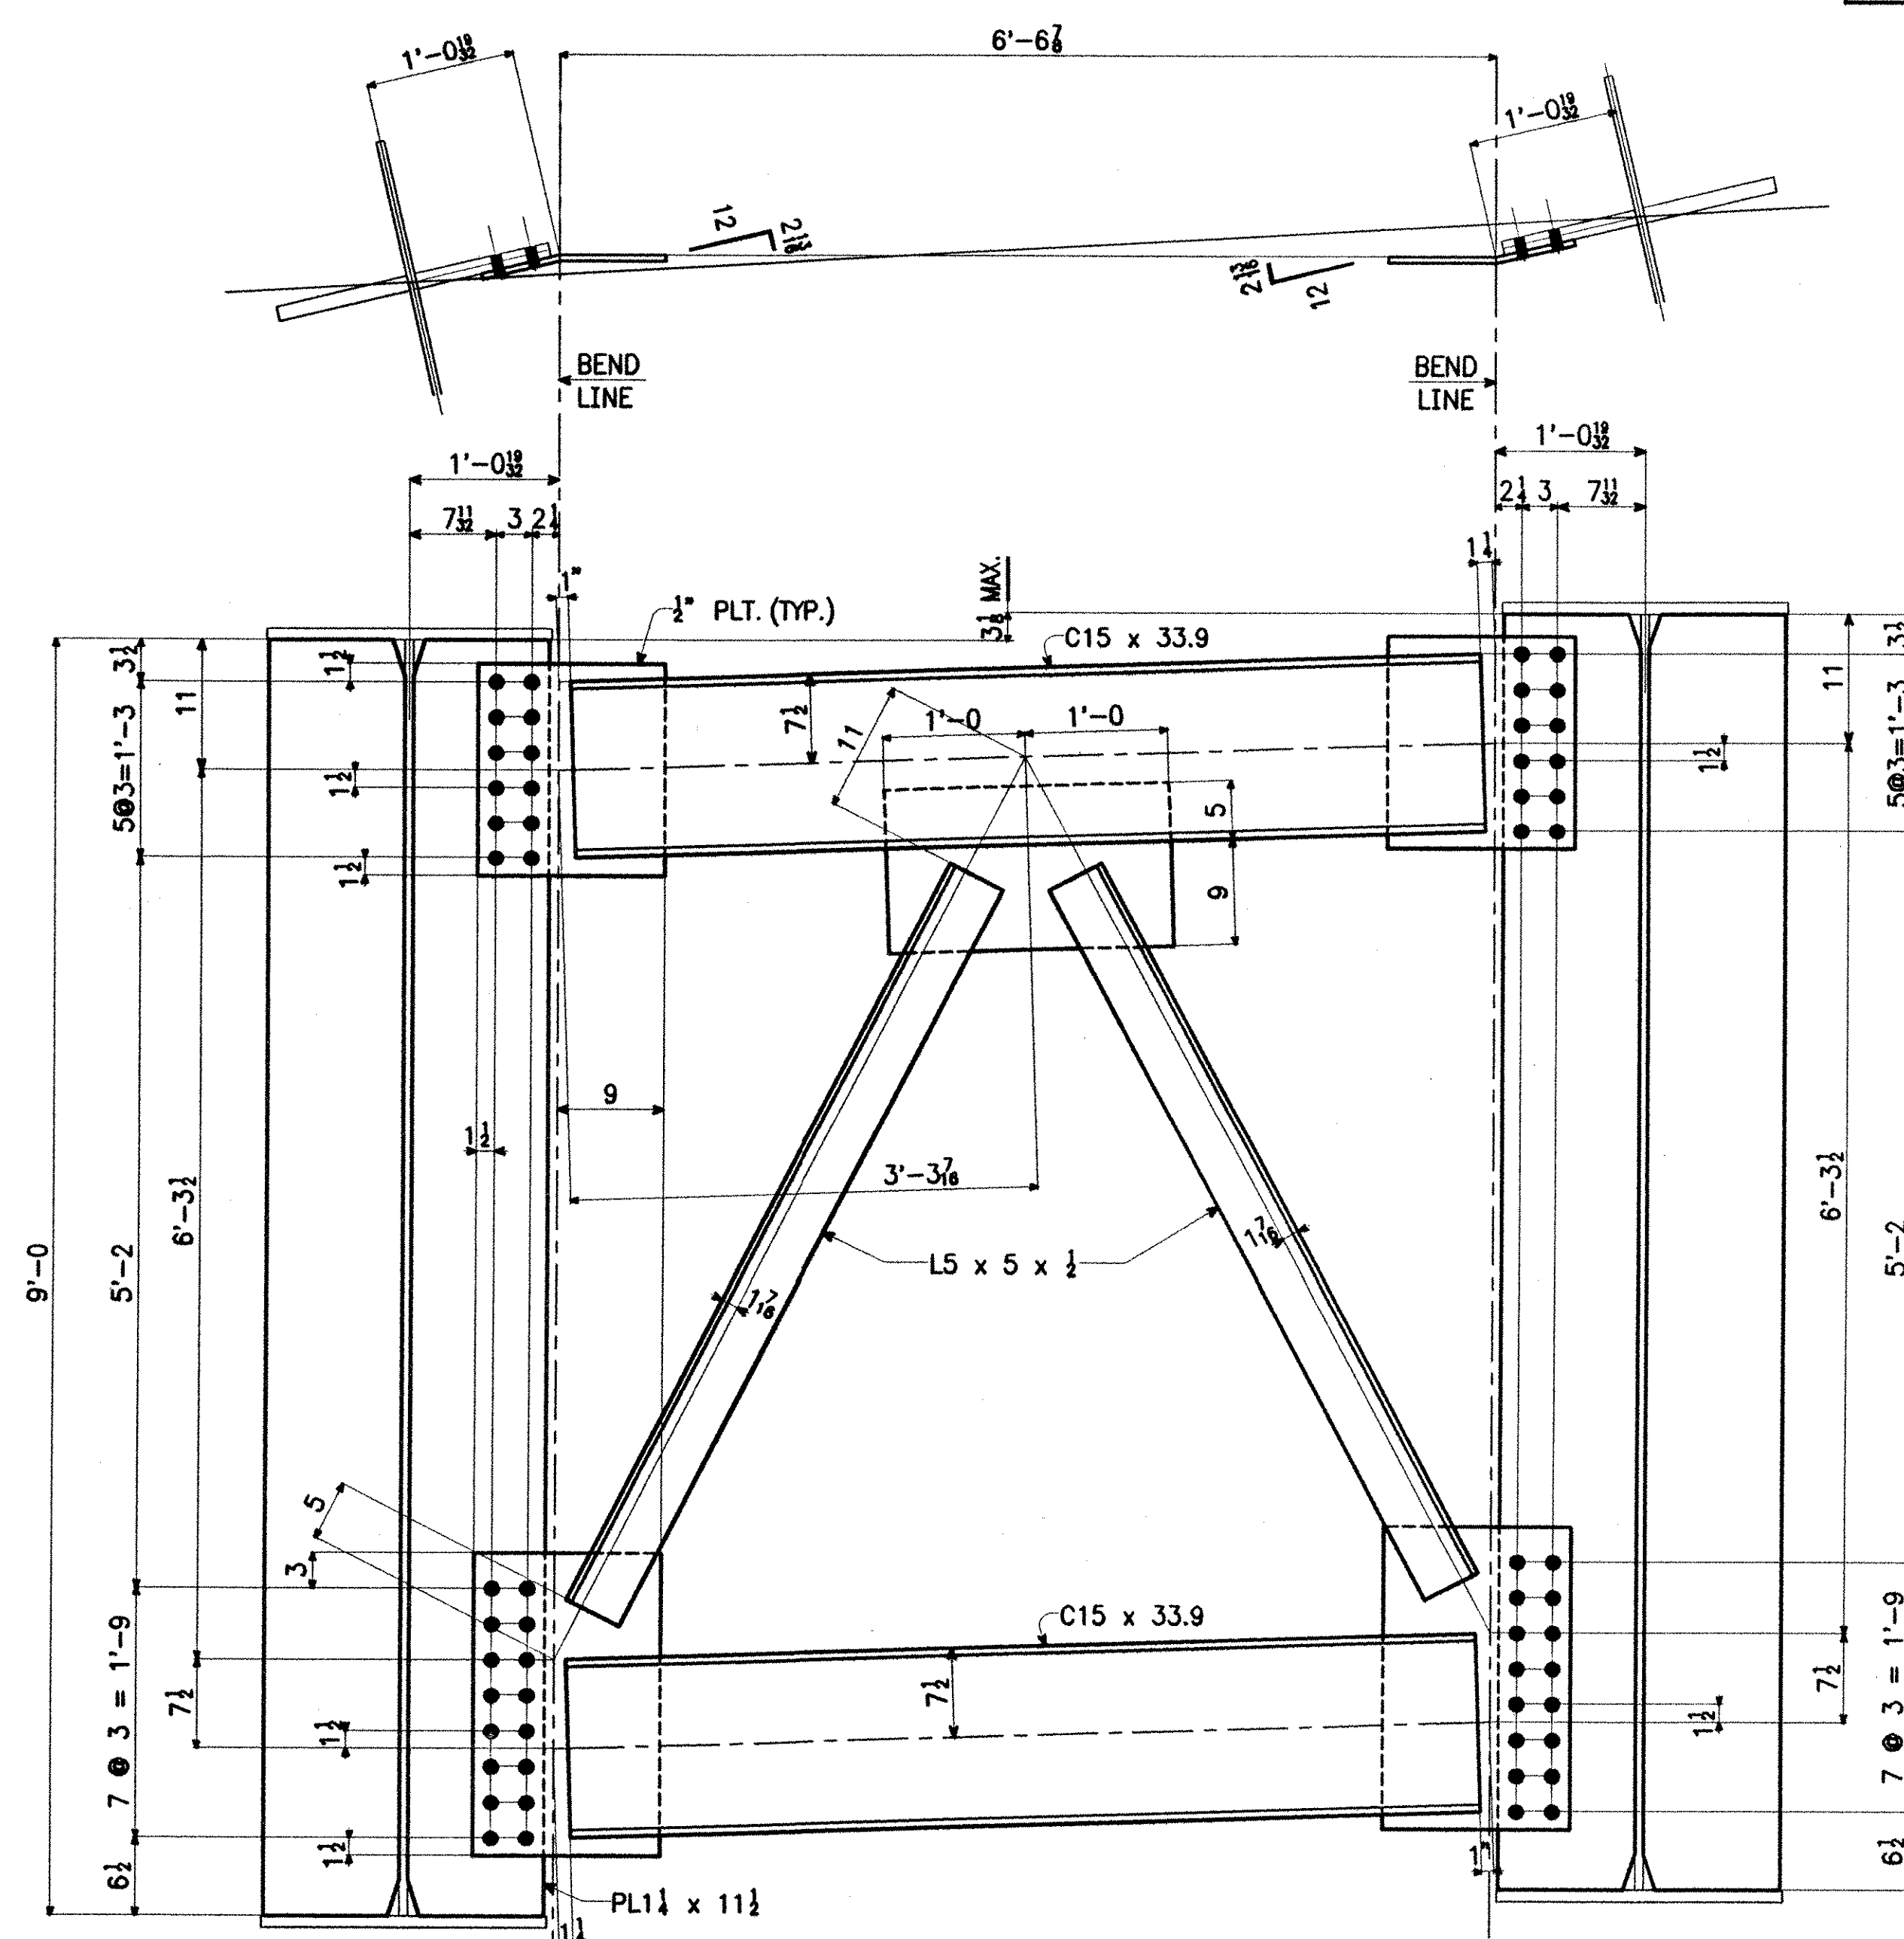

PIER CROSSFRAME LAYOUT

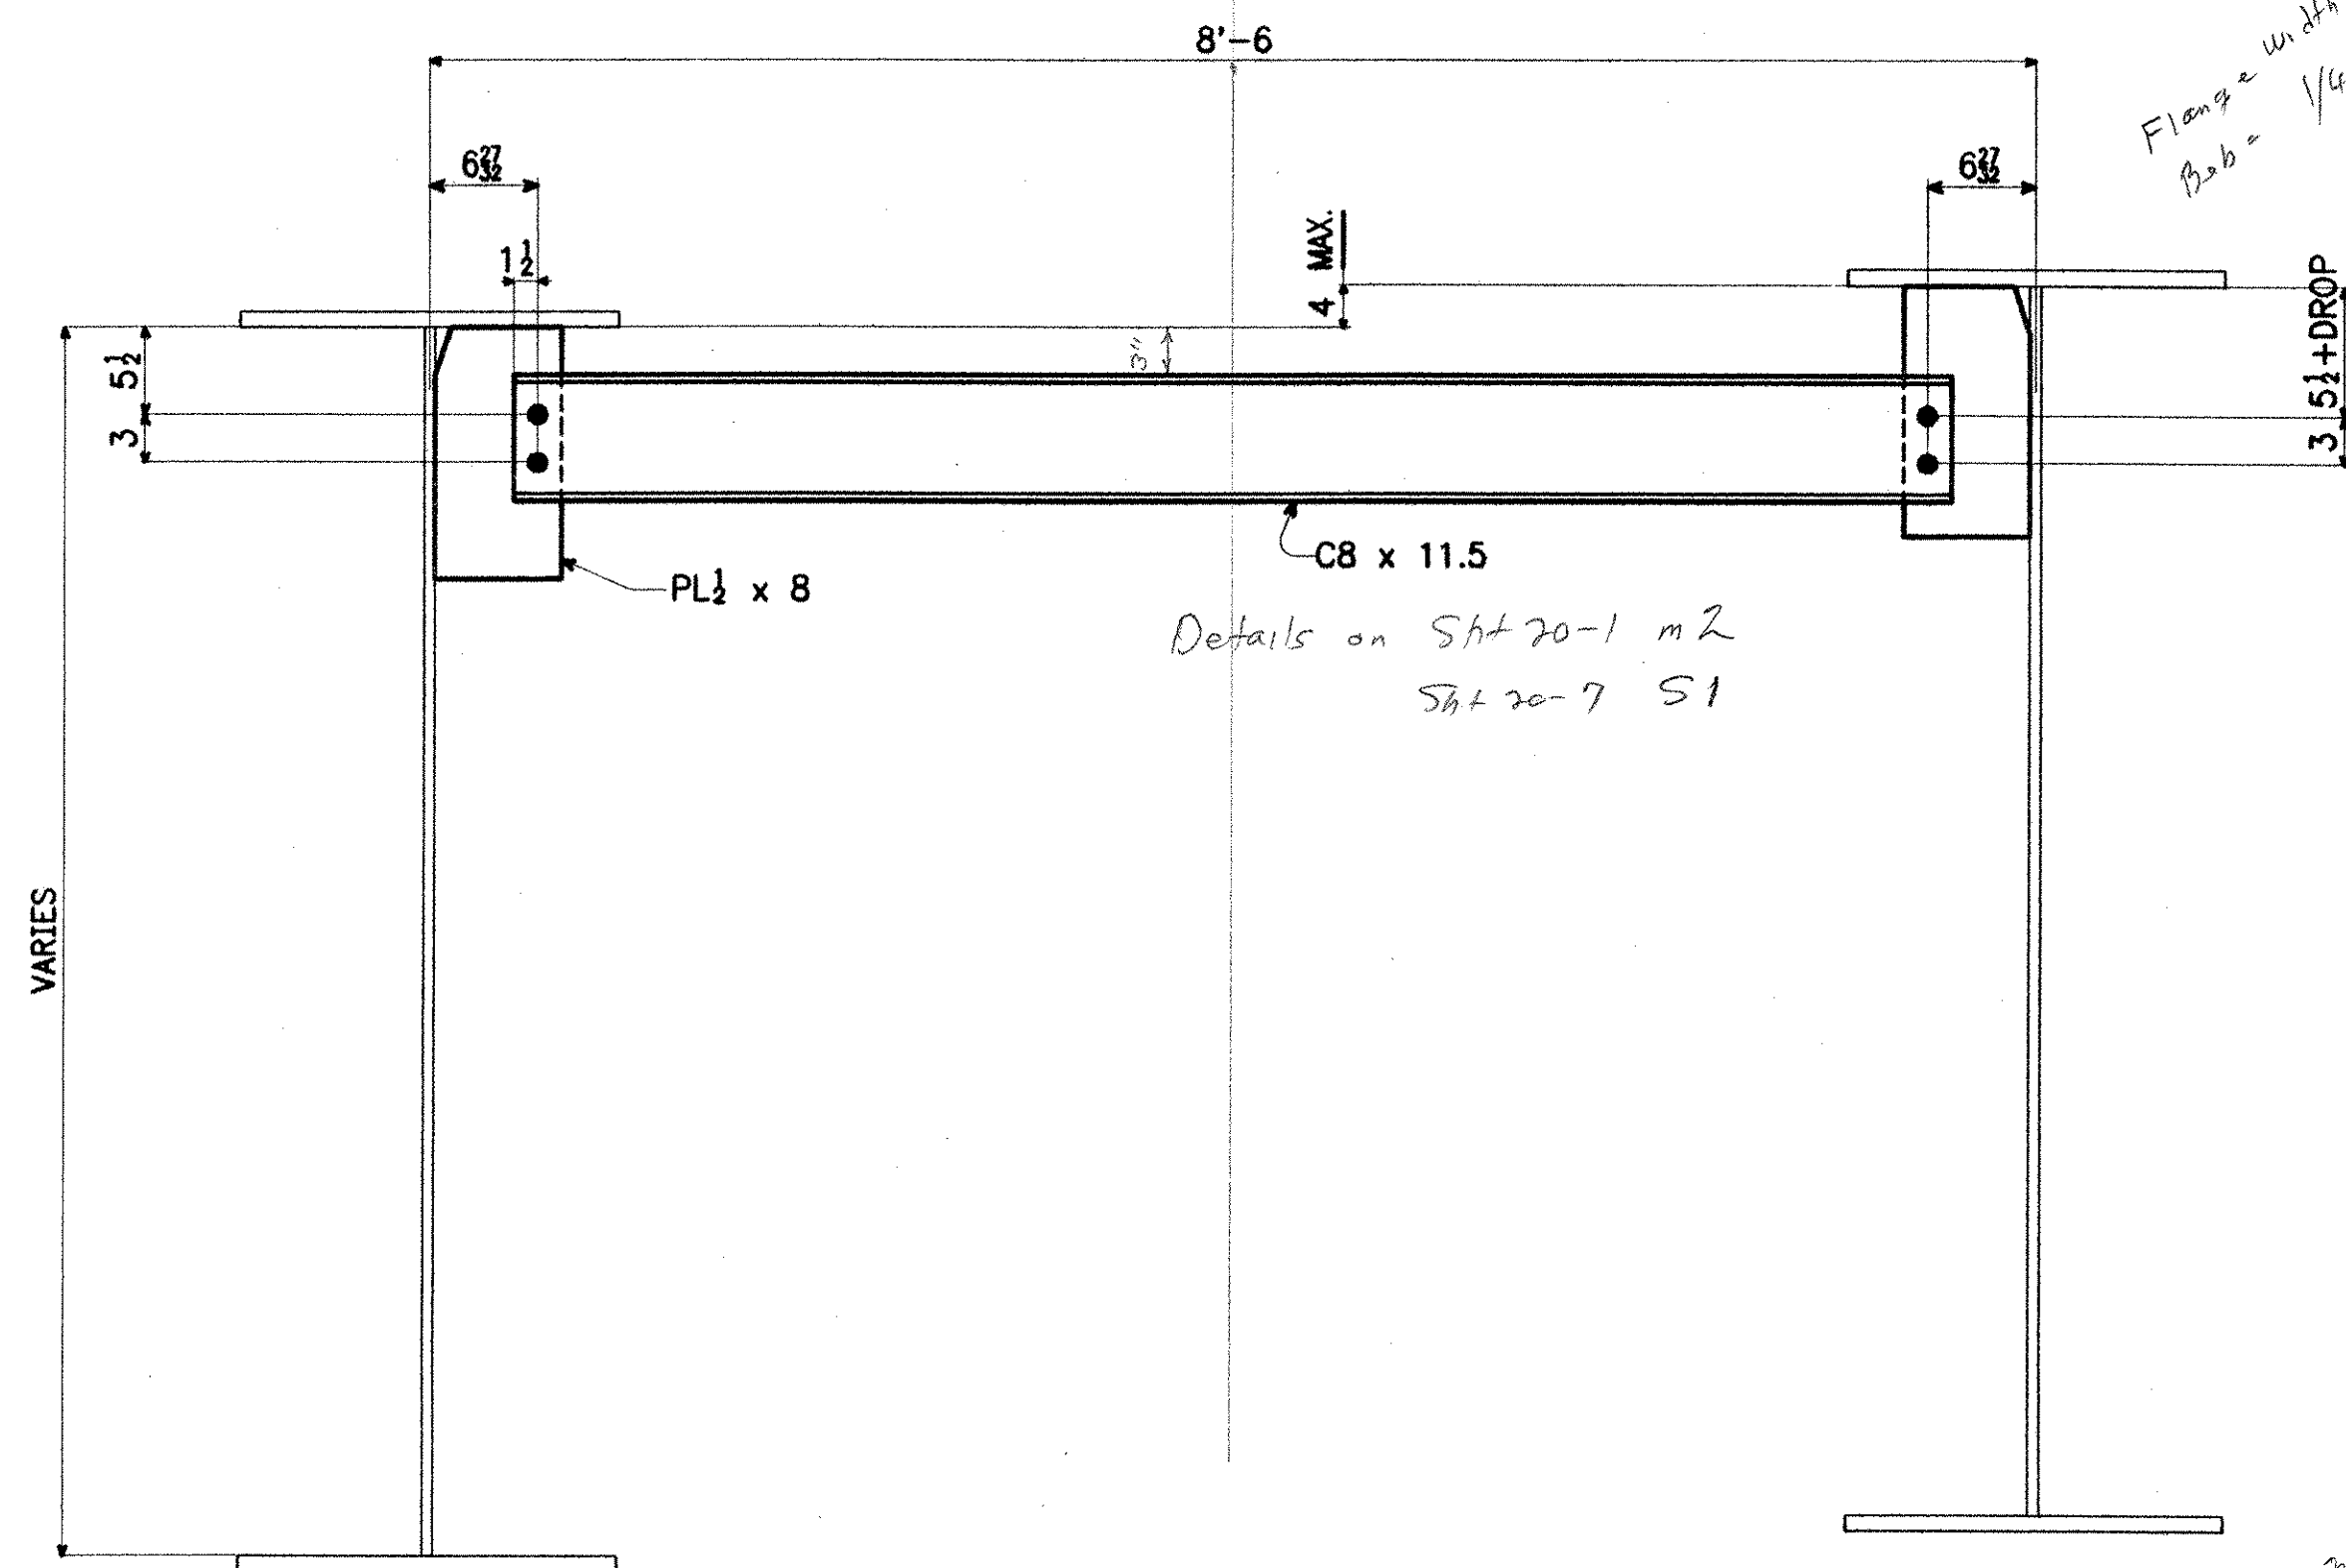

UTILITY SUPPORT LAYOUT

RECEIVED
 CK'D BY: LGS OK'D BY: _____
 AUG 27 2001
 RESUBMIT: _____ APPROVED: _____
 BY: CPW DATE: 8/30/01

ITEM NO. 506.55		BR. NO. 3		PROJ. NO. BRZ 1444(22)	
TITLE: LAYOUTS					
APPROVED:					
PRINT DIST.		APPR.			
5	4-7-01	FAB.			
5	7-13-01	APP			
5	8-14-01	APP			
FOR APPROVAL National Eastern Corporation Plainville, Connecticut					
JOB: T.H. 1 OVER THE WHITE RIVER ROYALTON, VERMONT					
CUSTOMER: BECK & BELLUCCI, INC.					
DESIGNER: VERMONT AGENCY OF TRANSPORTATION					
WORK ORDER NO.		DRAWING NO.		REV.	
15873		WS3		A	