
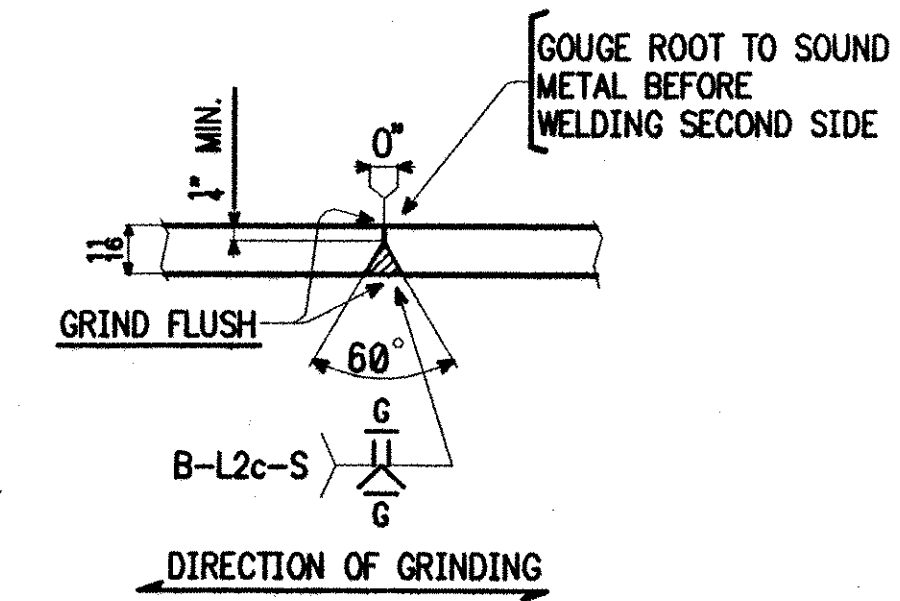
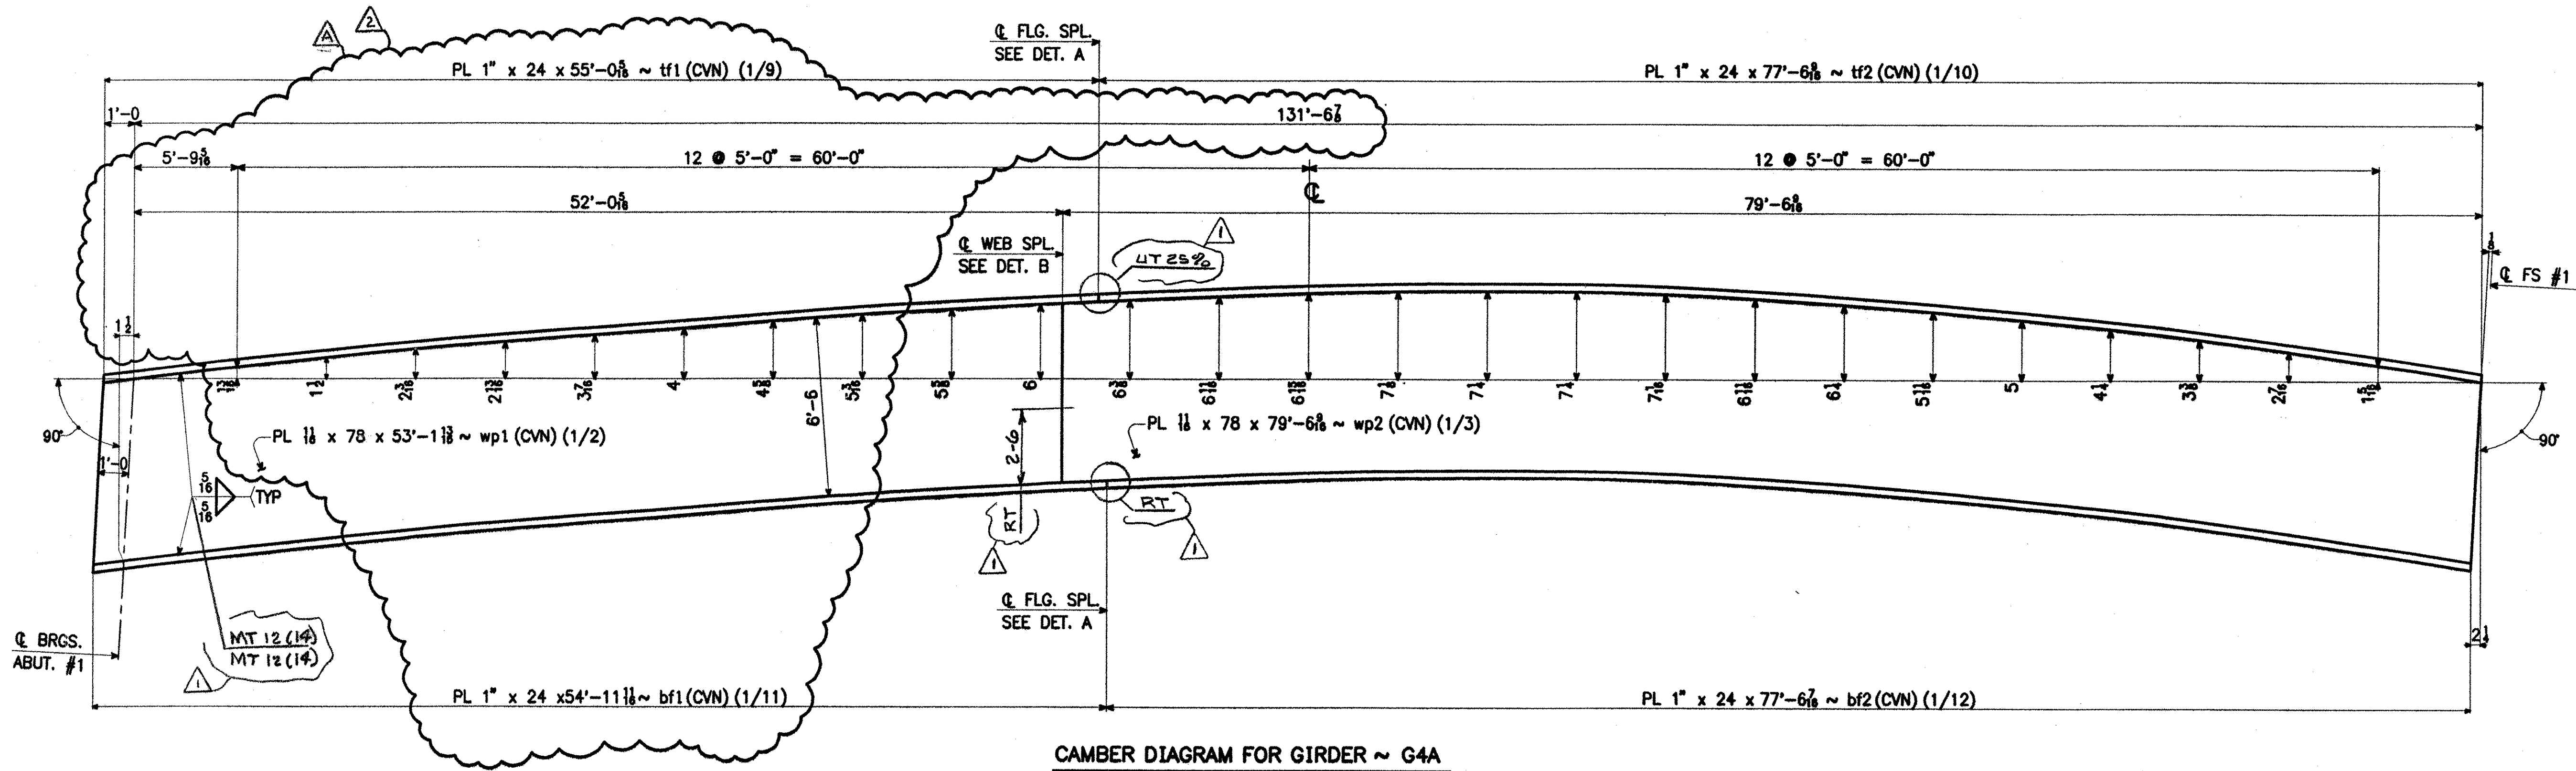
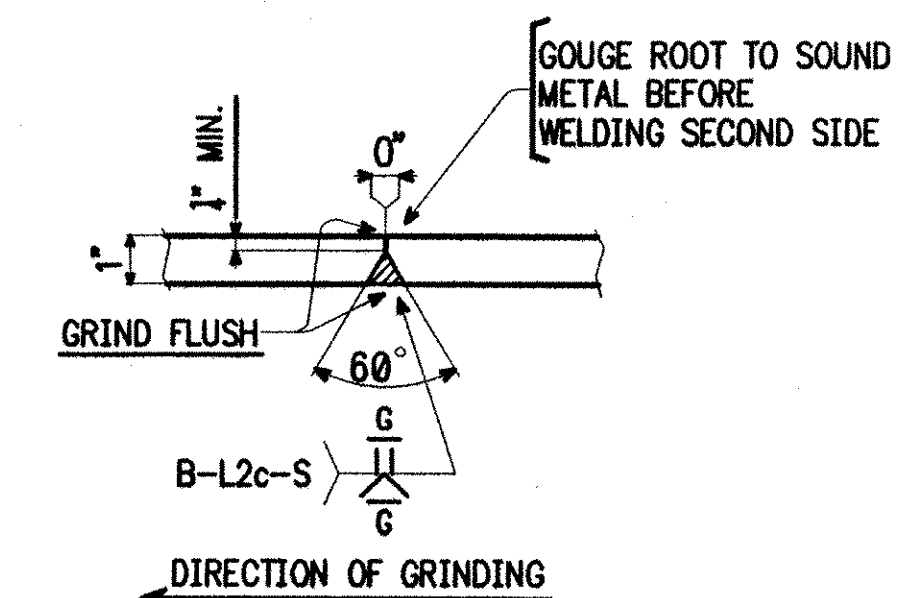


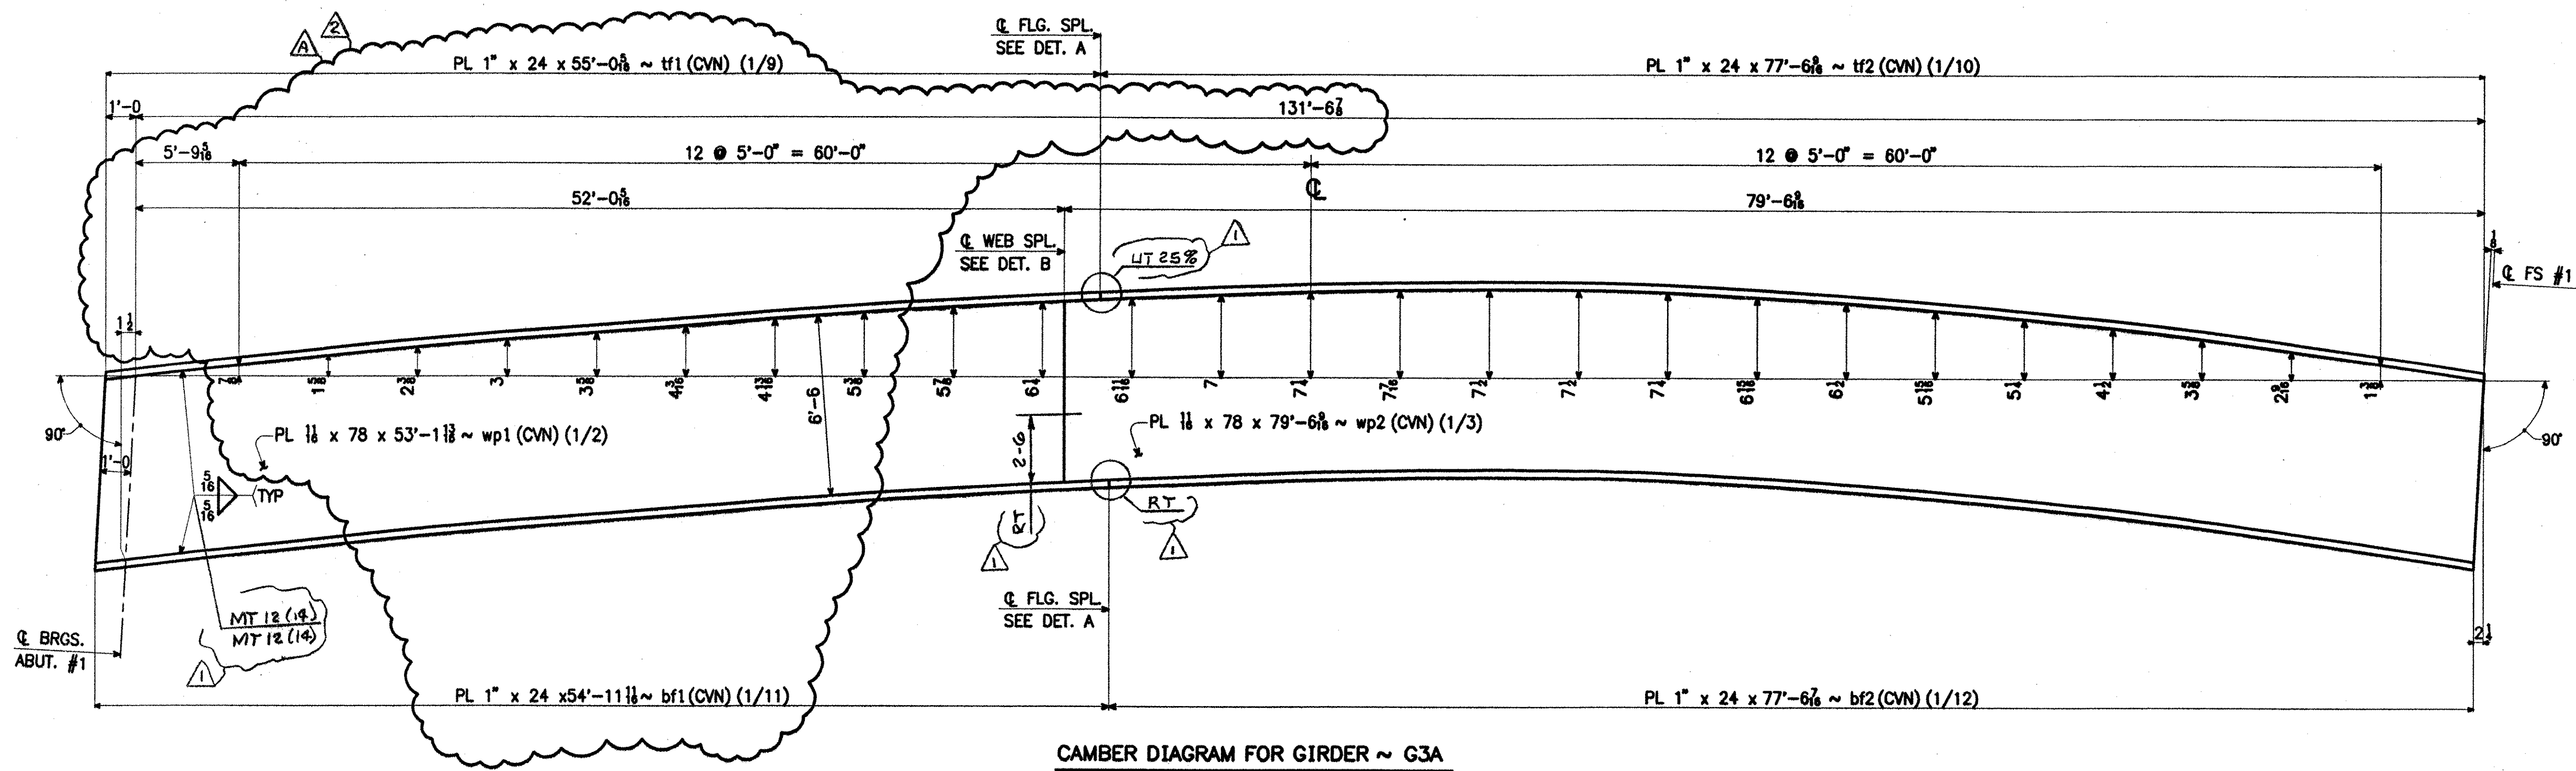

- NOTES:**
1. MATERIAL: ASTM A709-50W
 2. CVN DENOTES CHARPY V-NOTCH TESTING REQUIRED.

- 2 FLG & WEB 12-17-01 AV
- 1 NDT 8-23-01 JCM
- A APPL COMMENTS 6-21-01 AV

RECEIVED
OK'D BY WJS OK'D BY _____
DEC 27 2001
RESUBMIT _____ APPROVED ✓
BY CPW DATE 1/4/02

ITEM NO.506.55	BR. NO. 3	PROJ. NO. BRZ 1444(22)
TITLE: CAMBER DIAGRAMS		
APPROVED: 9-5-01		
PRINT DIST.		
5	4-7-01	APPR.
ORIG.	6-21-01	FAB.
5	7-13-01	APP
5	8-24-01	APP
12	8-24-01	FAB
5	12-18-01	APP
11	12-18-01	FAB
National Eastern Corporation Plainville, Connecticut		
JOB: T.H. 1 OVER THE WHITE RIVER ROYALTON, VERMONT		
CUSTOMER: BECK & BELLUCCI, INC.		
DESIGNER: VERMONT AGENCY OF TRANSPORTATION		
CHECKED	TS	3/01
DRAWN	AV	3/01
15873	12-2	A

FOR APPROVAL
REVISED