


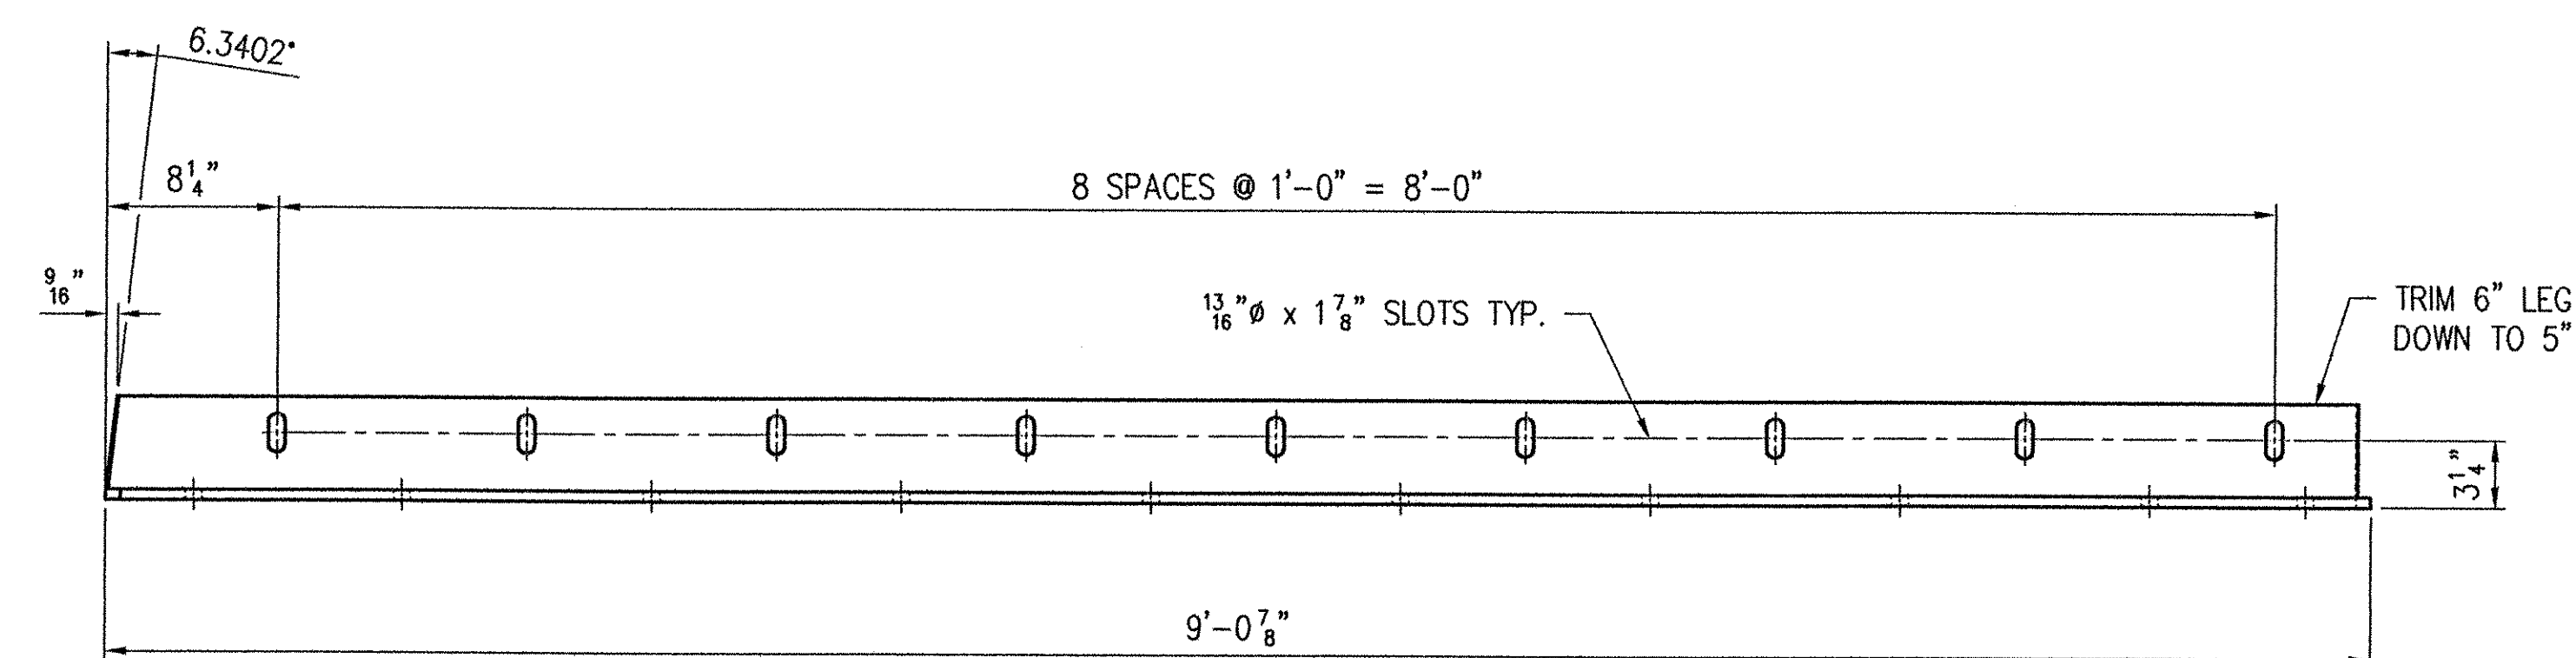


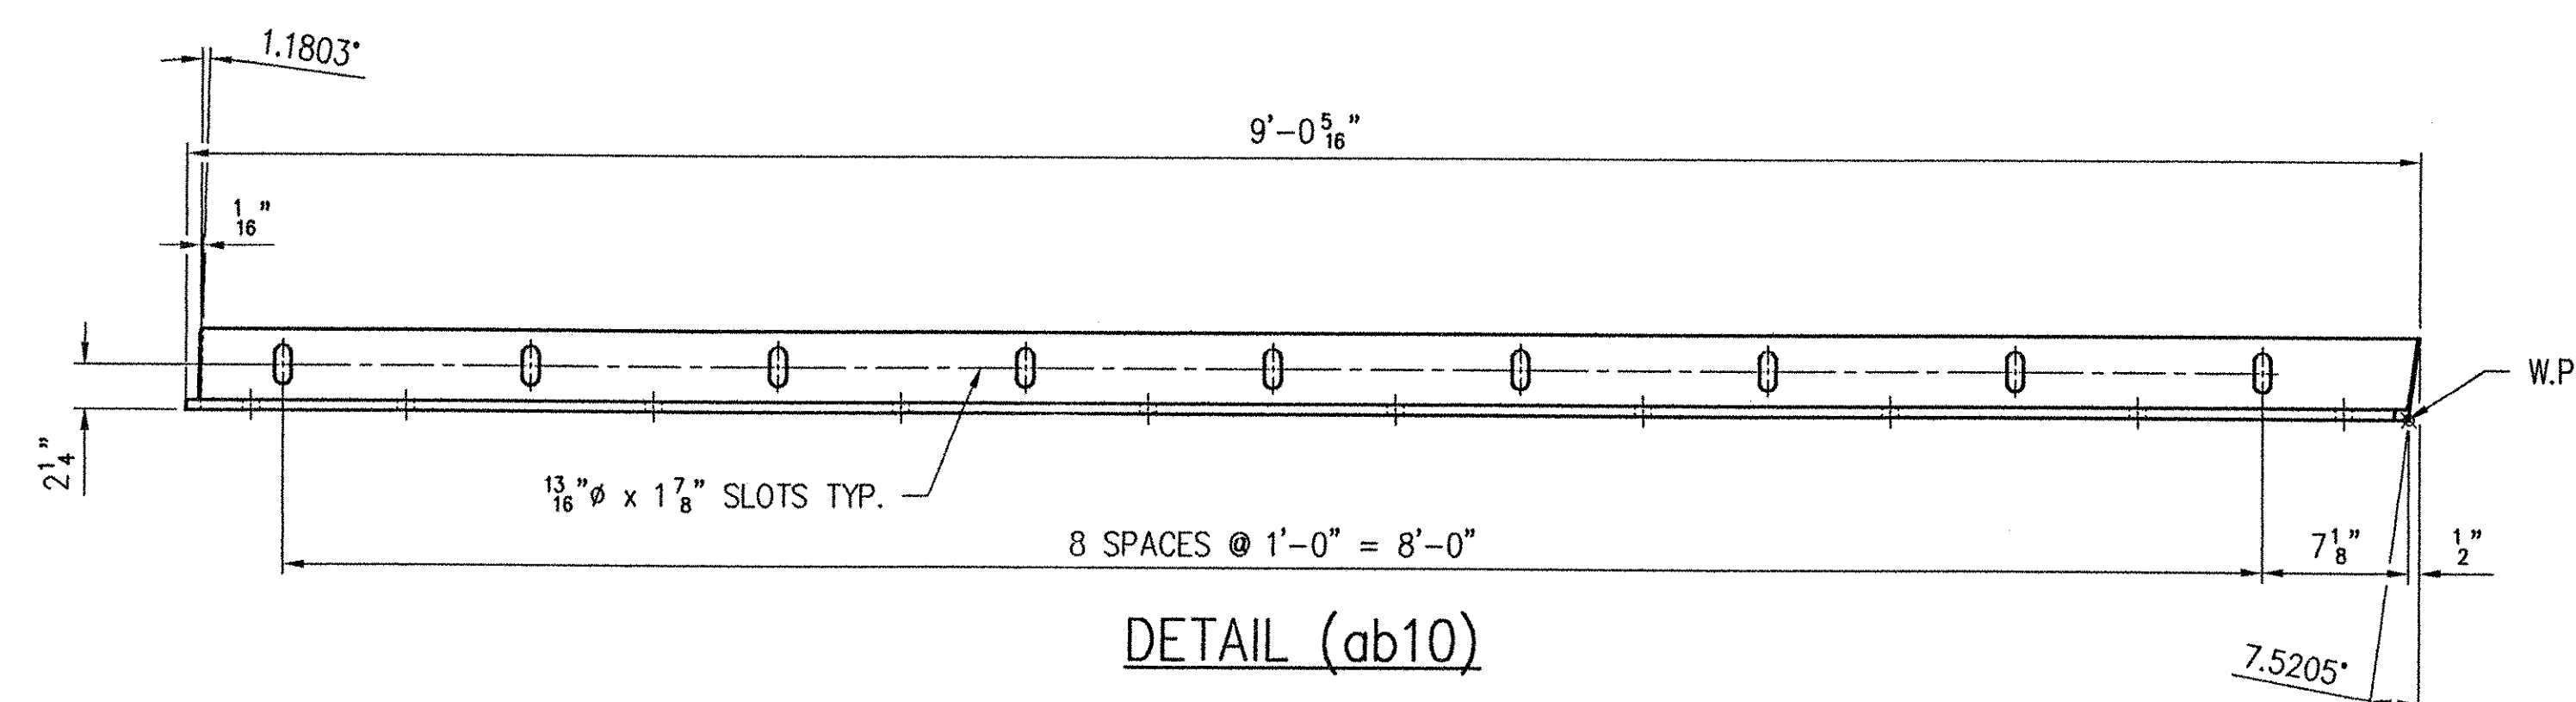


DETAIL (aa10)

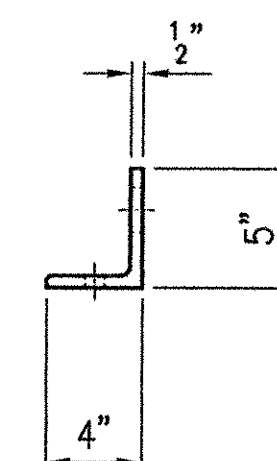

DETAIL (ab10)

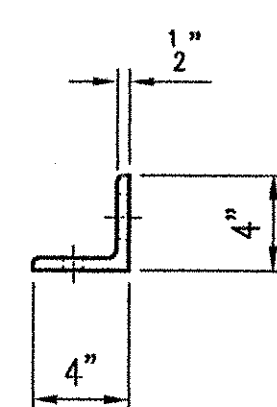

SEE SHEET NO. 15 FOR GENERAL NOTES.
WORK THIS SHEET WITH SHEET NO. 8, 9, 11 & 12.

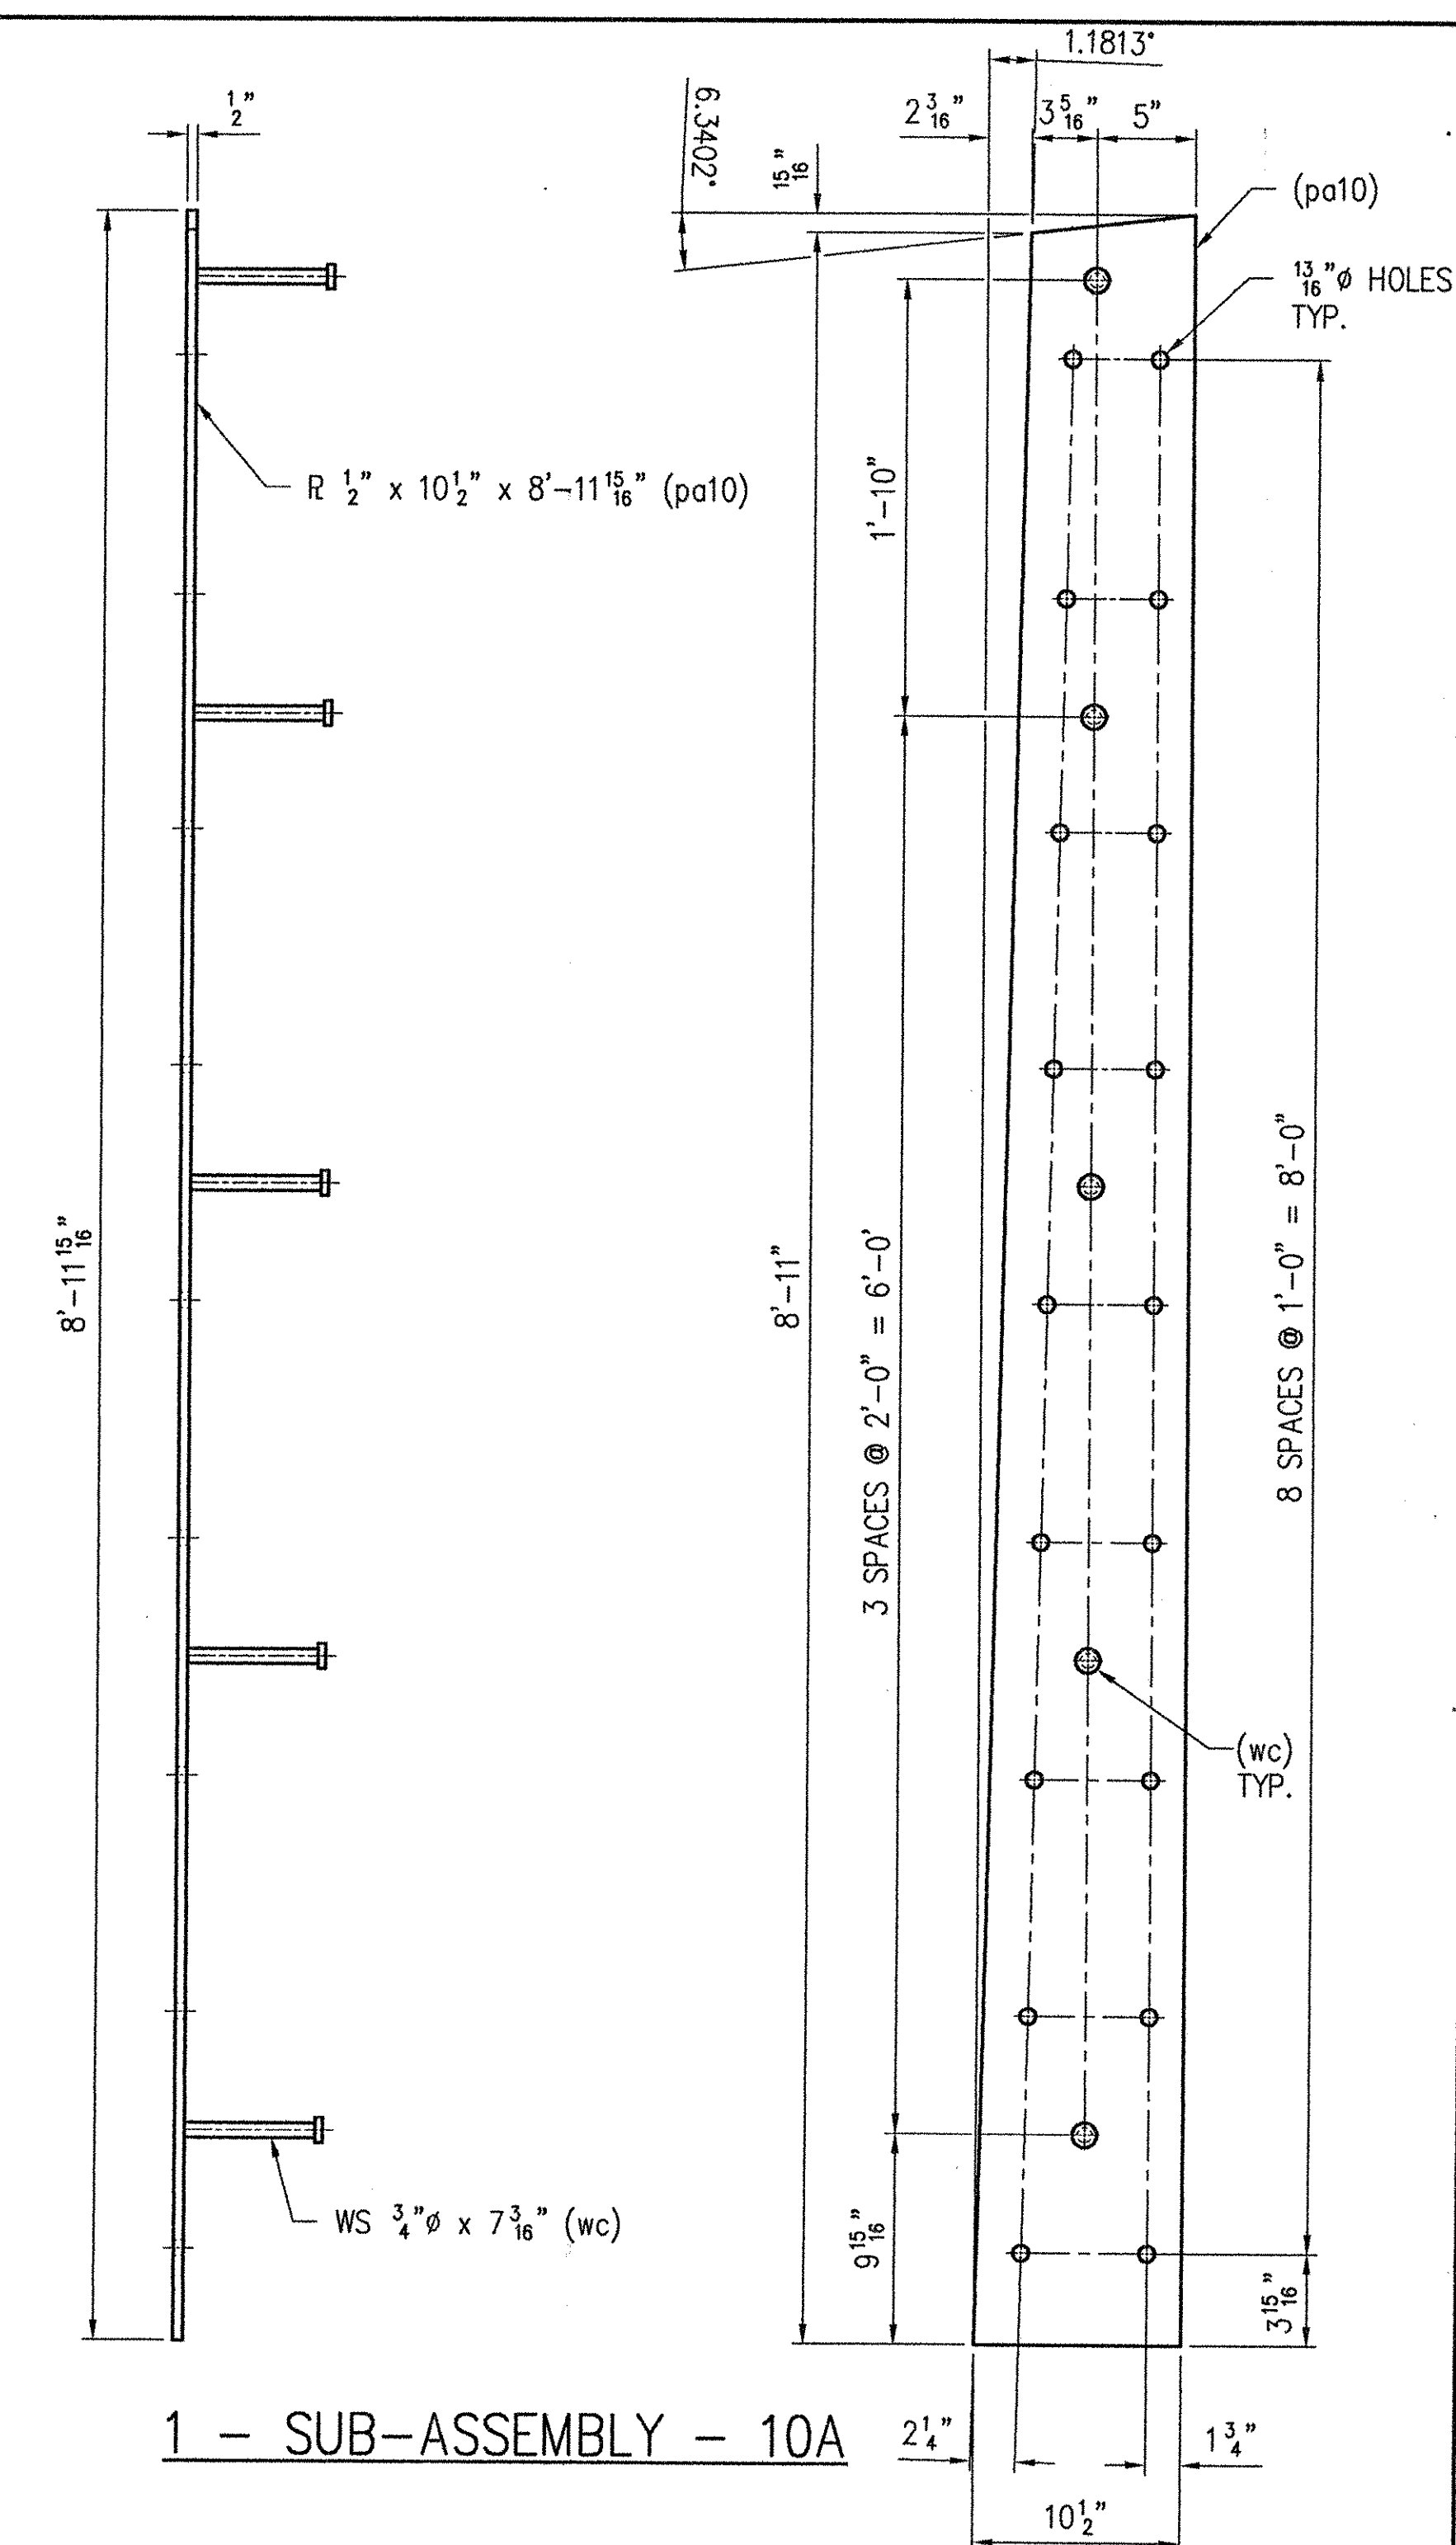

1 - SUB-ASSEMBLY - 10A

RECEIVED
CK'D BY WBS CK'D BY _____
JAN 11 2002
RESUBMIT _____ APPROVED ✓
BY CPW DATE 1/11/02

		REV.	DESCRIPTION	DATE	INT
		ANY AND ALL BACKCHARGES WILL BE REJECTED UNLESS WRITTEN CONSENT IS GIVEN BY LEWIS ENGINEERING COMPANY PRIOR TO ANY WORK PERFORMED FOR OUR ACCOUNT. SUCH REJECTION MEANS THAT INVOICES WILL NOT BE HONORED OR DEDUCTIONS FROM PAYMENT WILL BE CHARGED BACK.			
			LEWIS ENGINEERING COMPANY		
		4201 NOREX DRIVE -- CHASKA, MINNESOTA 55318 -- (952) 368-3000			
		PROJECT	— ROYALTON / RTE. TH 1, CL 1 BRIDGE NO. 3		
		STATE PROJECT	— AC BRZ 1444(22)		
		FEDERAL PROJECT	—		
		CUSTOMER	— BECK & BELLUCCI, INC.		
		LOCATION	— WINDSOR COUNTY, VT		
		DESCRIPTION	— EXPANSION JOINT DETAILS ABUTMENT NO. 2		
S.		CUST.		W.P. chk'd	
2.		DATE		Drawn By JMB	
		PRINTS ISSUED	L.E.C. 10 OF 30	Chk'd. By TSF	
			SHEET NO. 10 OF 15	Date: 12/5/01	
			Job. No. : 2034.1042.1		