
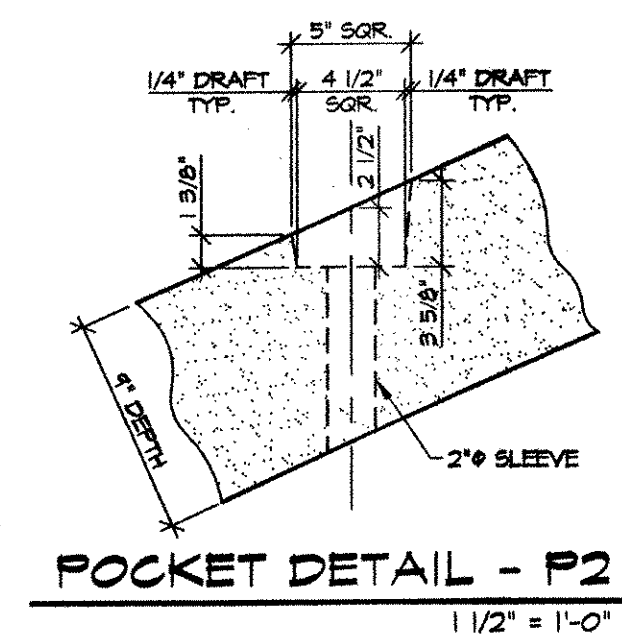
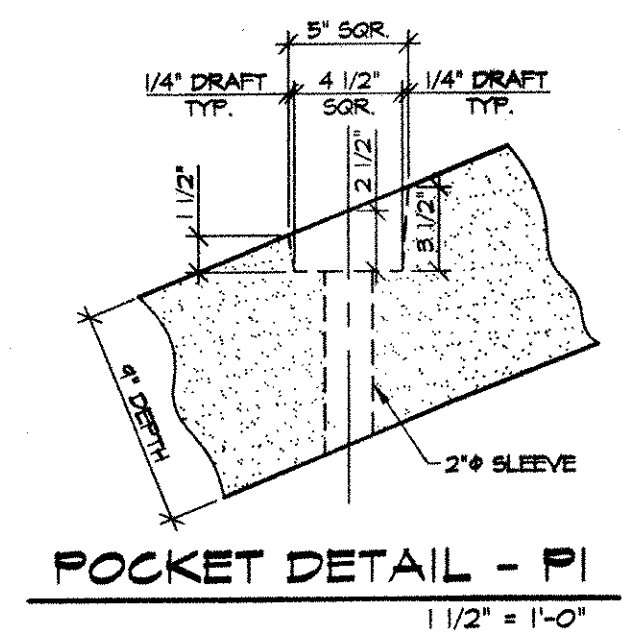
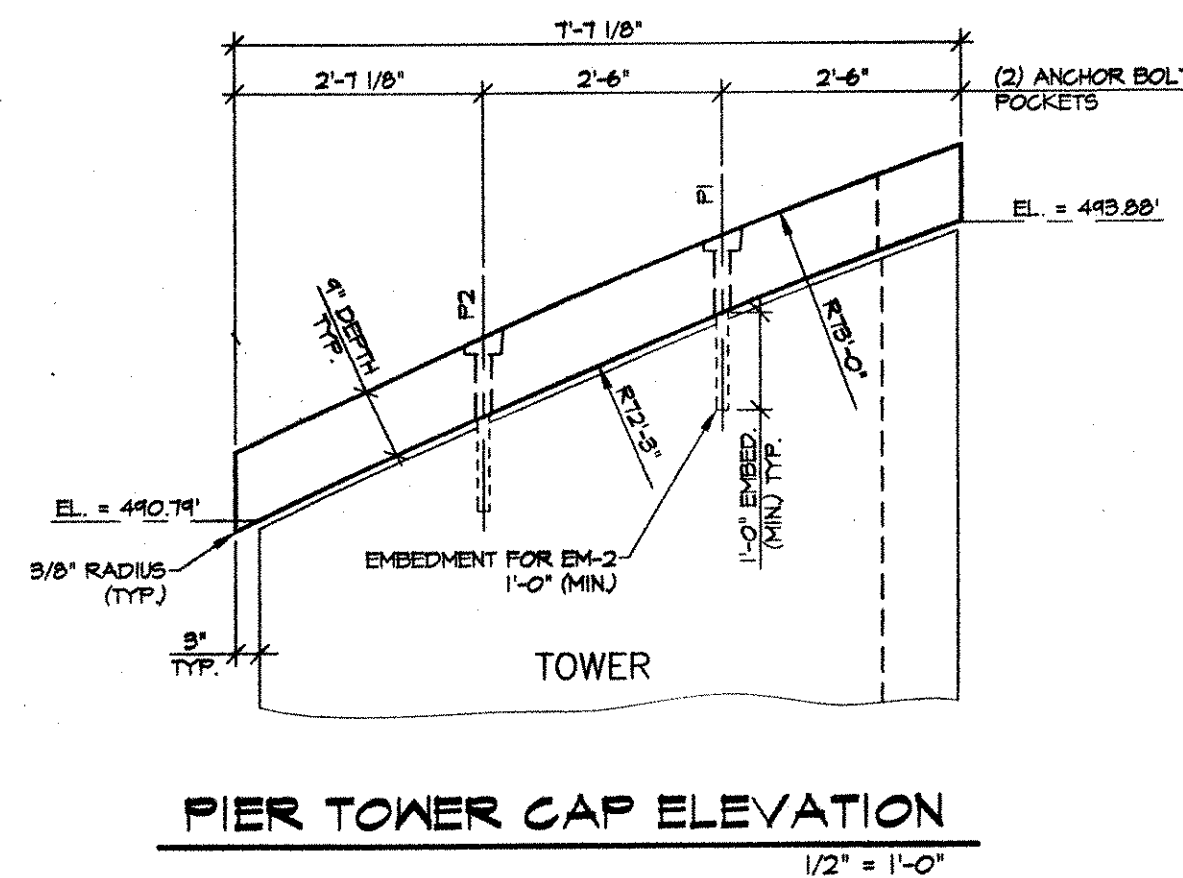
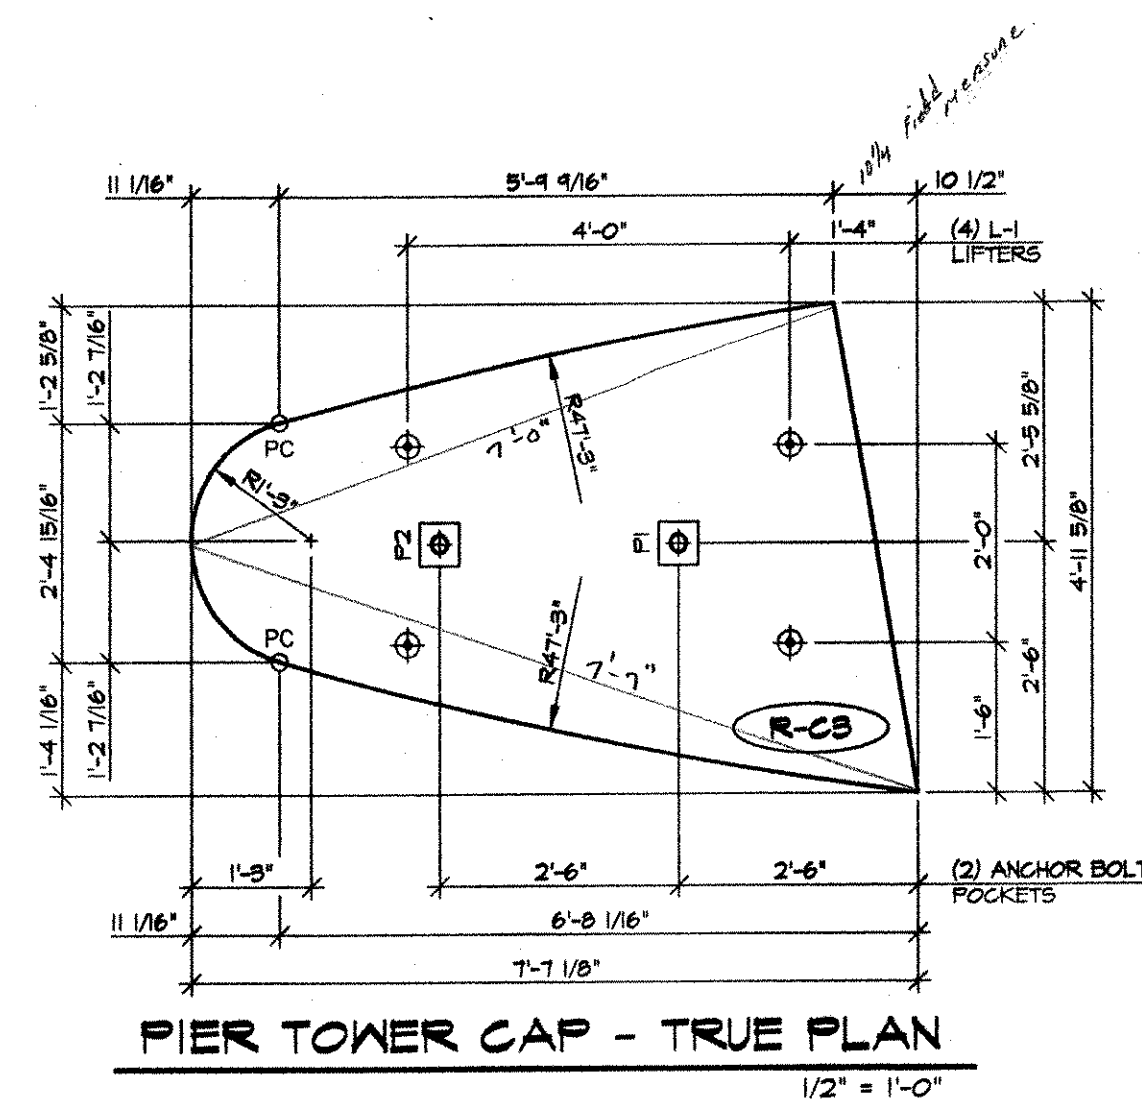
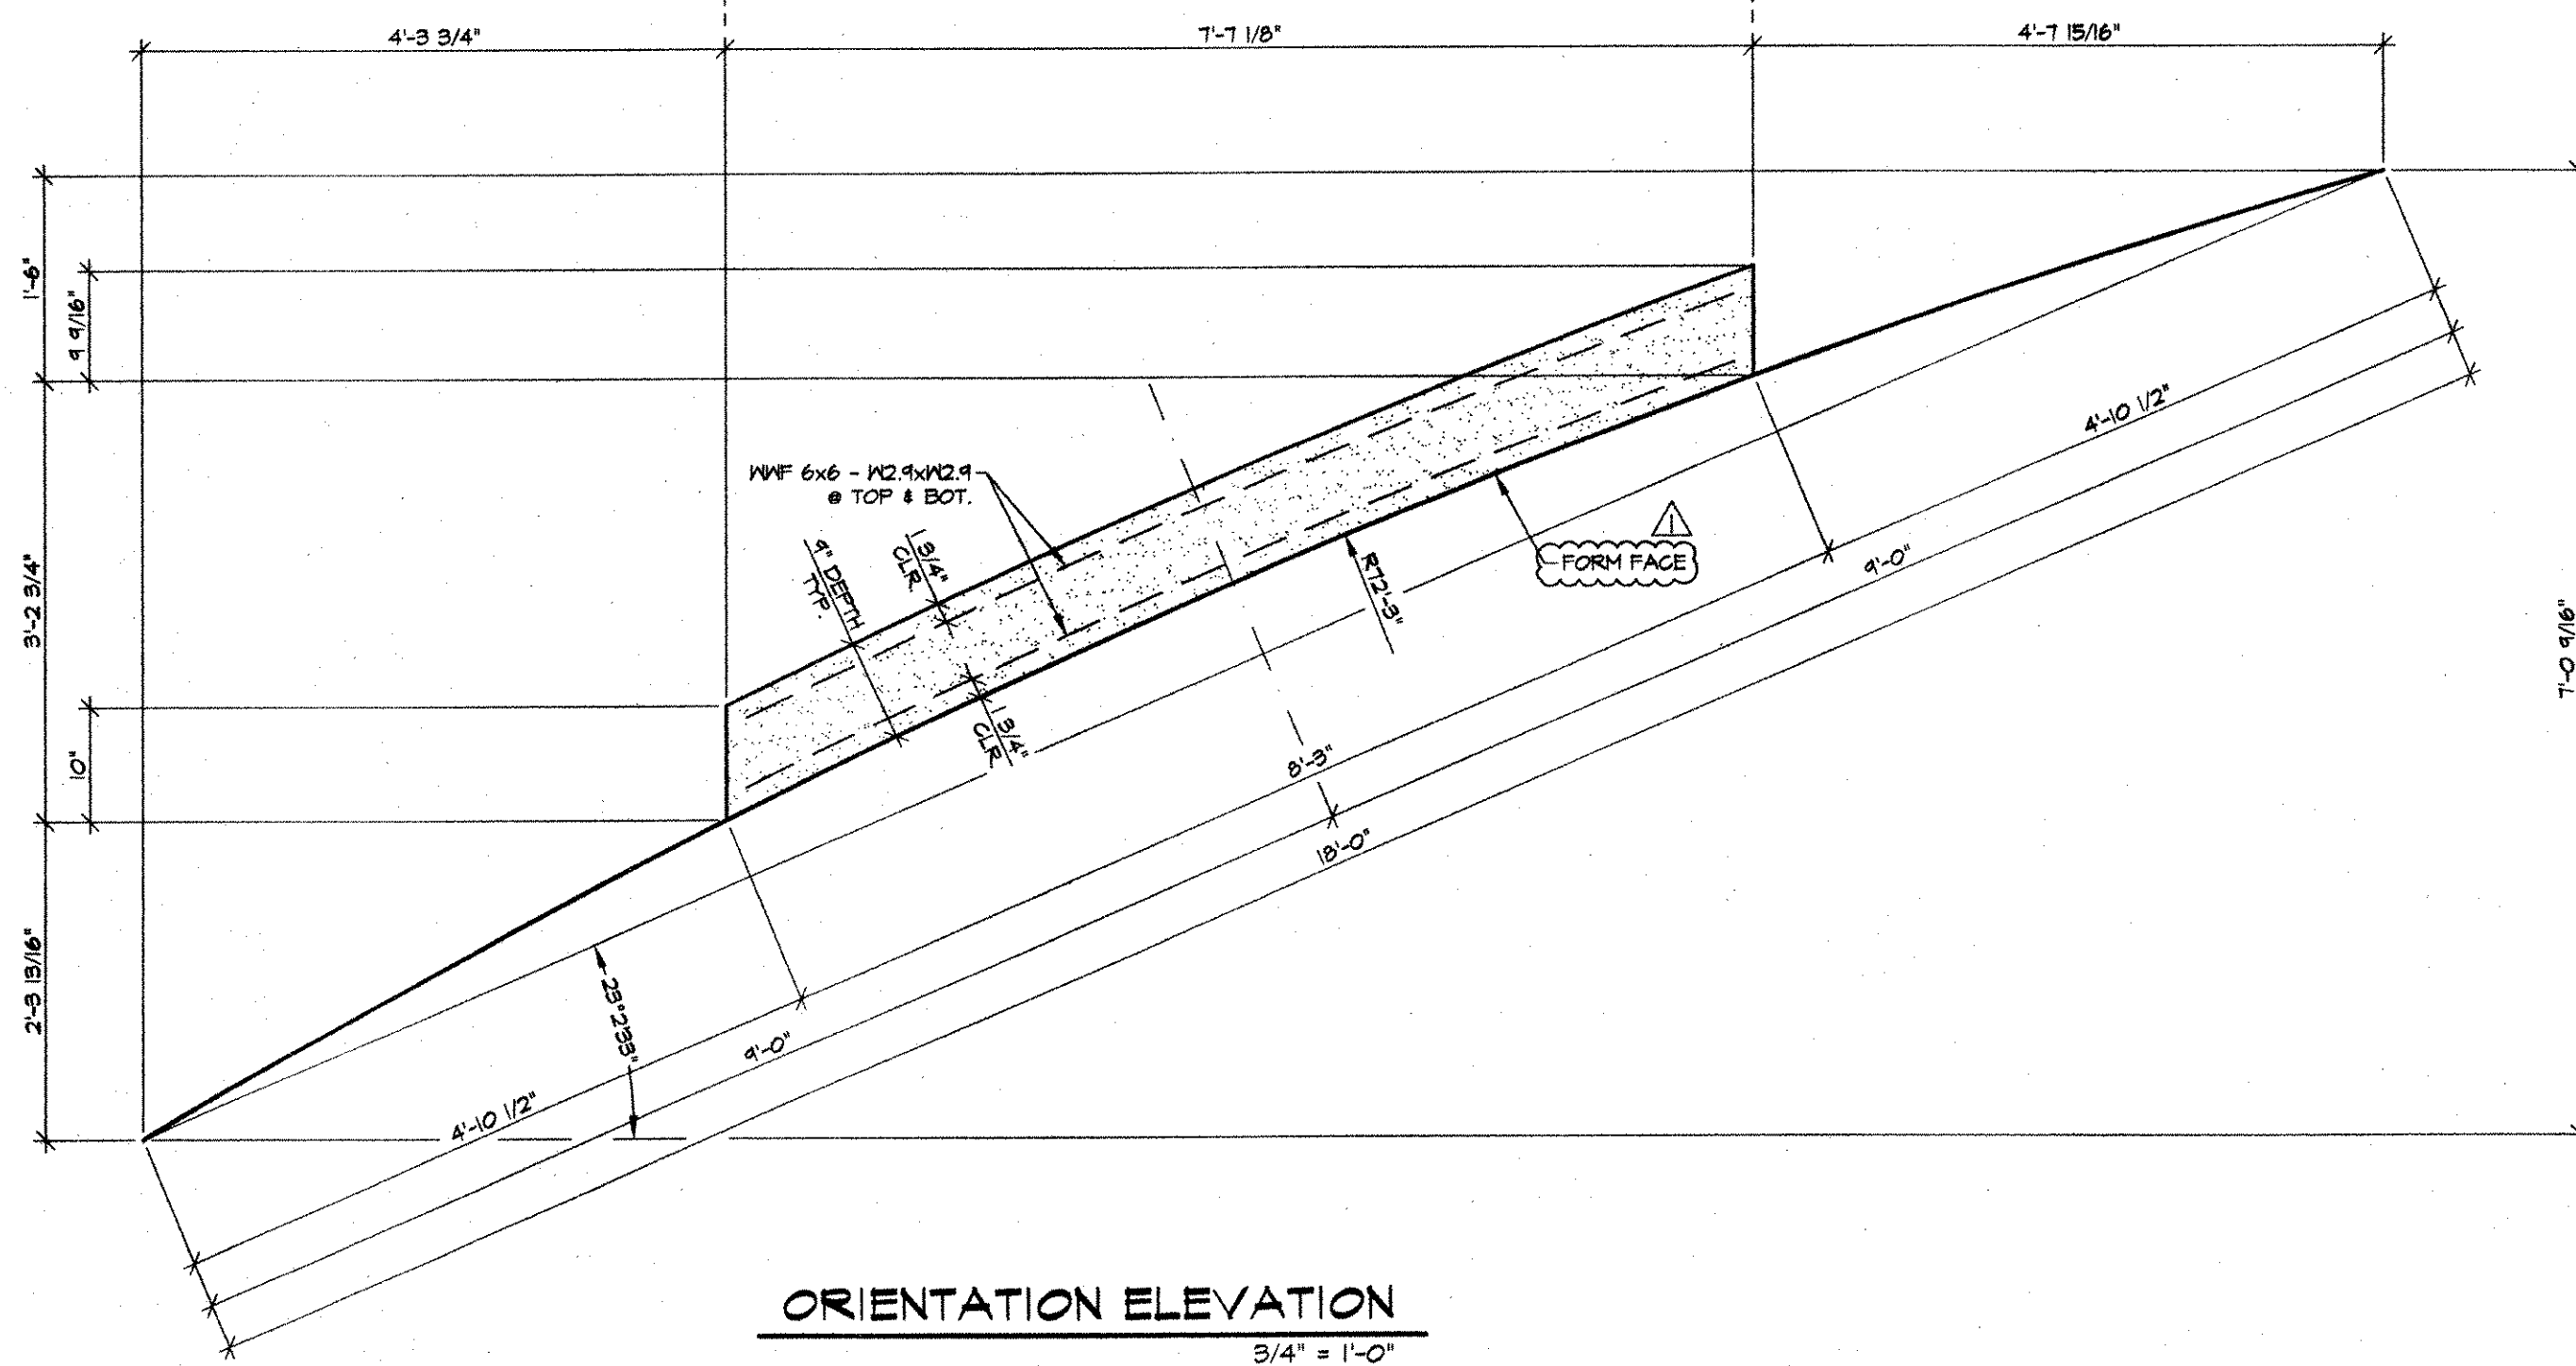


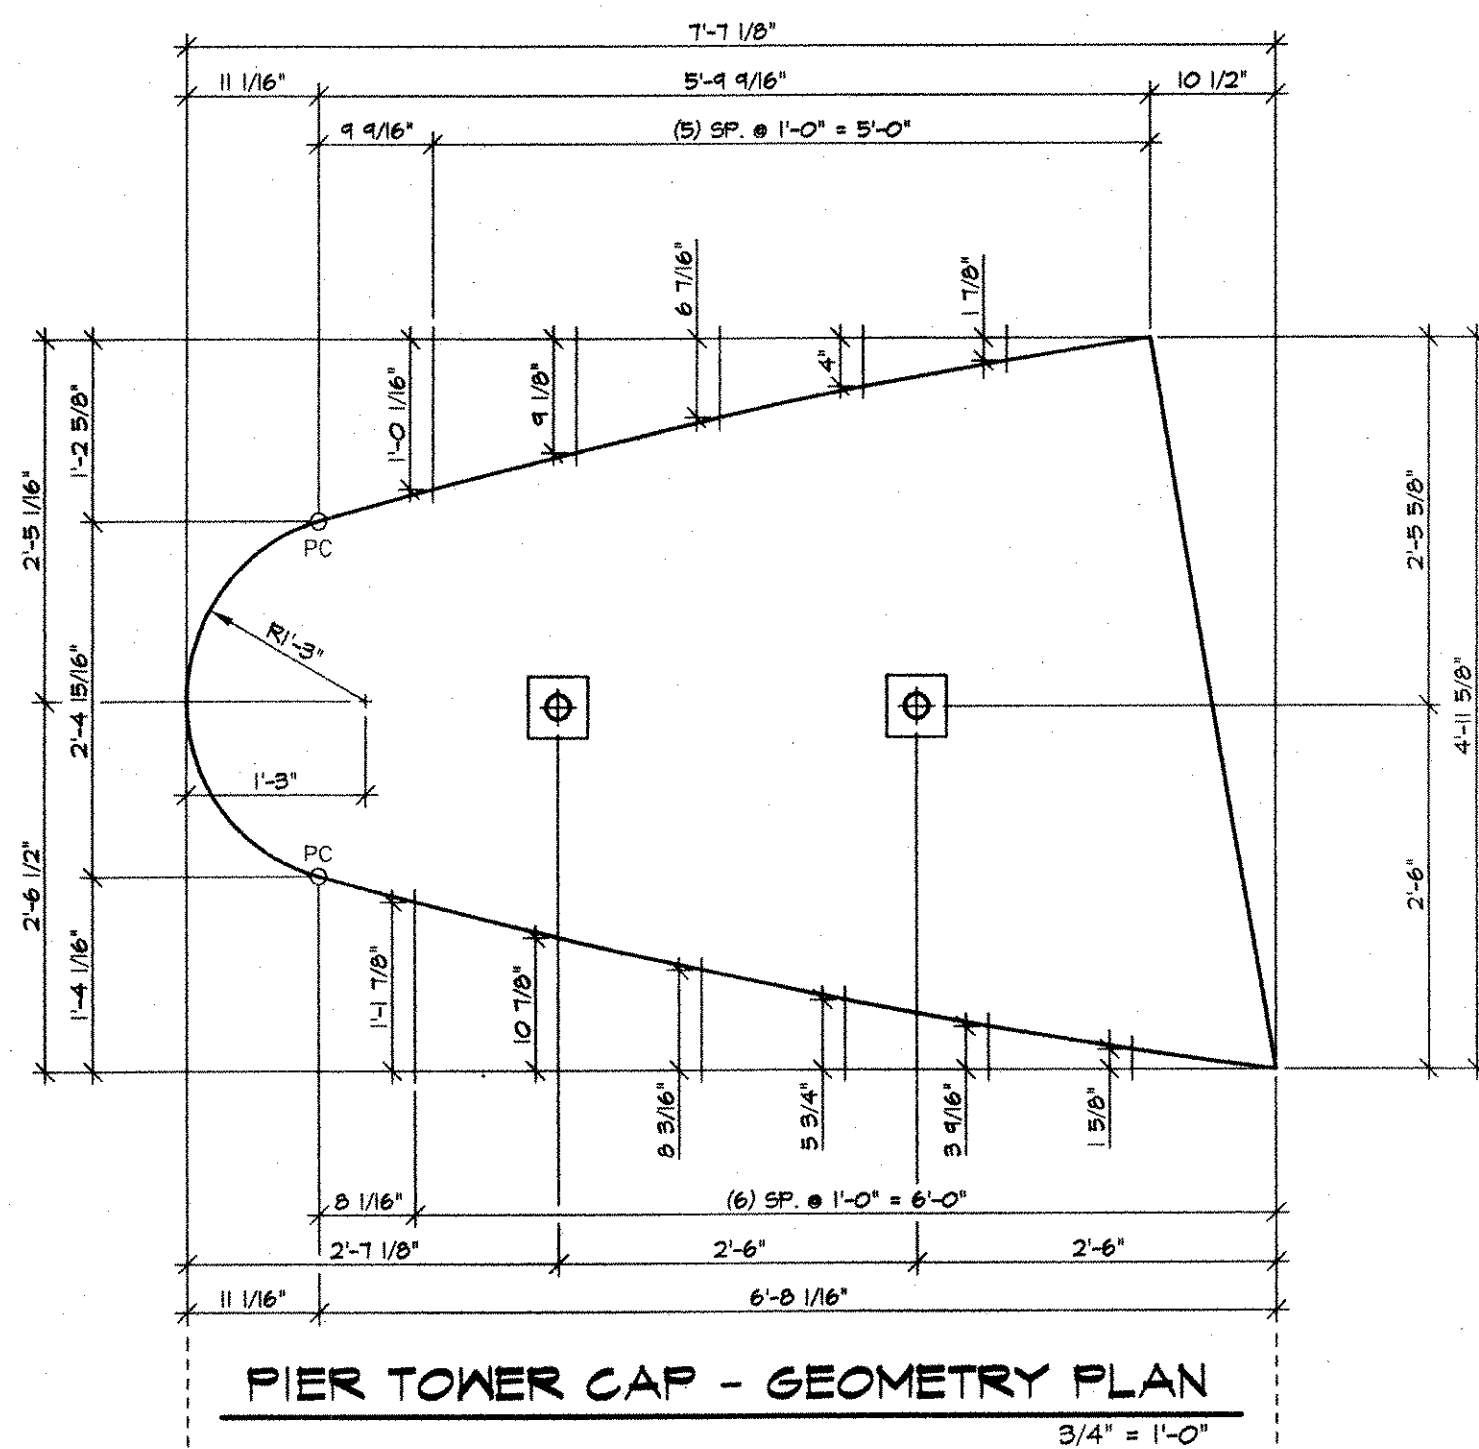

RECEIVED
OK'D BY WMS OK'D BY _____
APR 26 2001
RESUBMIT _____ APPROVED ☒
BY CPW DATE 5/24/01

SHOP NOTE:
Pci = 5,000 PSI (MIN.) @ STRIPPING
fc = 5,000 PSI (MIN.) @ 28 DAYS

MARK: **R-C3** QTY.: **1** WT./TONS: **1.56** CU. YDS.: **0.77**

MATERIALS LIST				
ITEM	MARK	QTY.	DESCRIPTION	REMARKS
1	EM-1	2	E WASHER 1/2"x3"x3" (AASHTO 103, 6R. 96) W/ (1) 1/2" HOLE (GALV.)	FOR ERECTION
2	EM-2	2	1 1/4"ø x 1'-4" ANCHOR BOLT (GALV.) (ASTM A307, 6R. C)	FOR ERECTION
3	EM-3	2	1 1/4" HEAVY HEX NUT (GALV.)	FOR ERECTION
4	L-1	4	1T x 4 3/4" SWIFT LIFT LIFTERS (DAYTON)	
5				
6				
7				
8				
9				
10				

NOTES:
1. ALL SURFACES OF THE PRECAST CAPS (EXCLUDING FORM FACE) SHALL BE GIVEN A RUBBED FINISH PER VAOT STD. SPECIFICATIONS SUB-SECTION 501.16(a)2.
2. ALL EDGES OF PRECAST CAPS SHALL BE FABRICATED TO BE VERTICAL IN THE FINAL ERECTED POSITION.

DRAWN: B.M. LOPEZ
DESIGNED: E.J. BROD
CHECKED: _____
APPROVED: _____

J.P. CARRARA & SONS INC.
Precast & Prestress Manufacturer
2464 CASE ST., MIDDLEBURY, VERMONT 05753
Phone: (802) 388-6361
Fax: (802) 388-8010
Double-Tees Hollow-Core Plank Flat Panels

BECK & BELLUCCI, INC.
10 SALISBURY ROAD, PO BOX 429
FRANKLIN, NEW HAMPSHIRE 03235

Project Name:
ROYALTON BRIDGE
BRZ 1444 (22)
ROYALTON, VERMONT
PIER TOWER CAP DETAILS

SCALE: **NOTED** JOB #: **23111-00**
DATE: **2-20-01** SHEET #: **PC3**

NO.	DATE	REVISION
1	4-3-01	REVISED FOR APPROVAL