
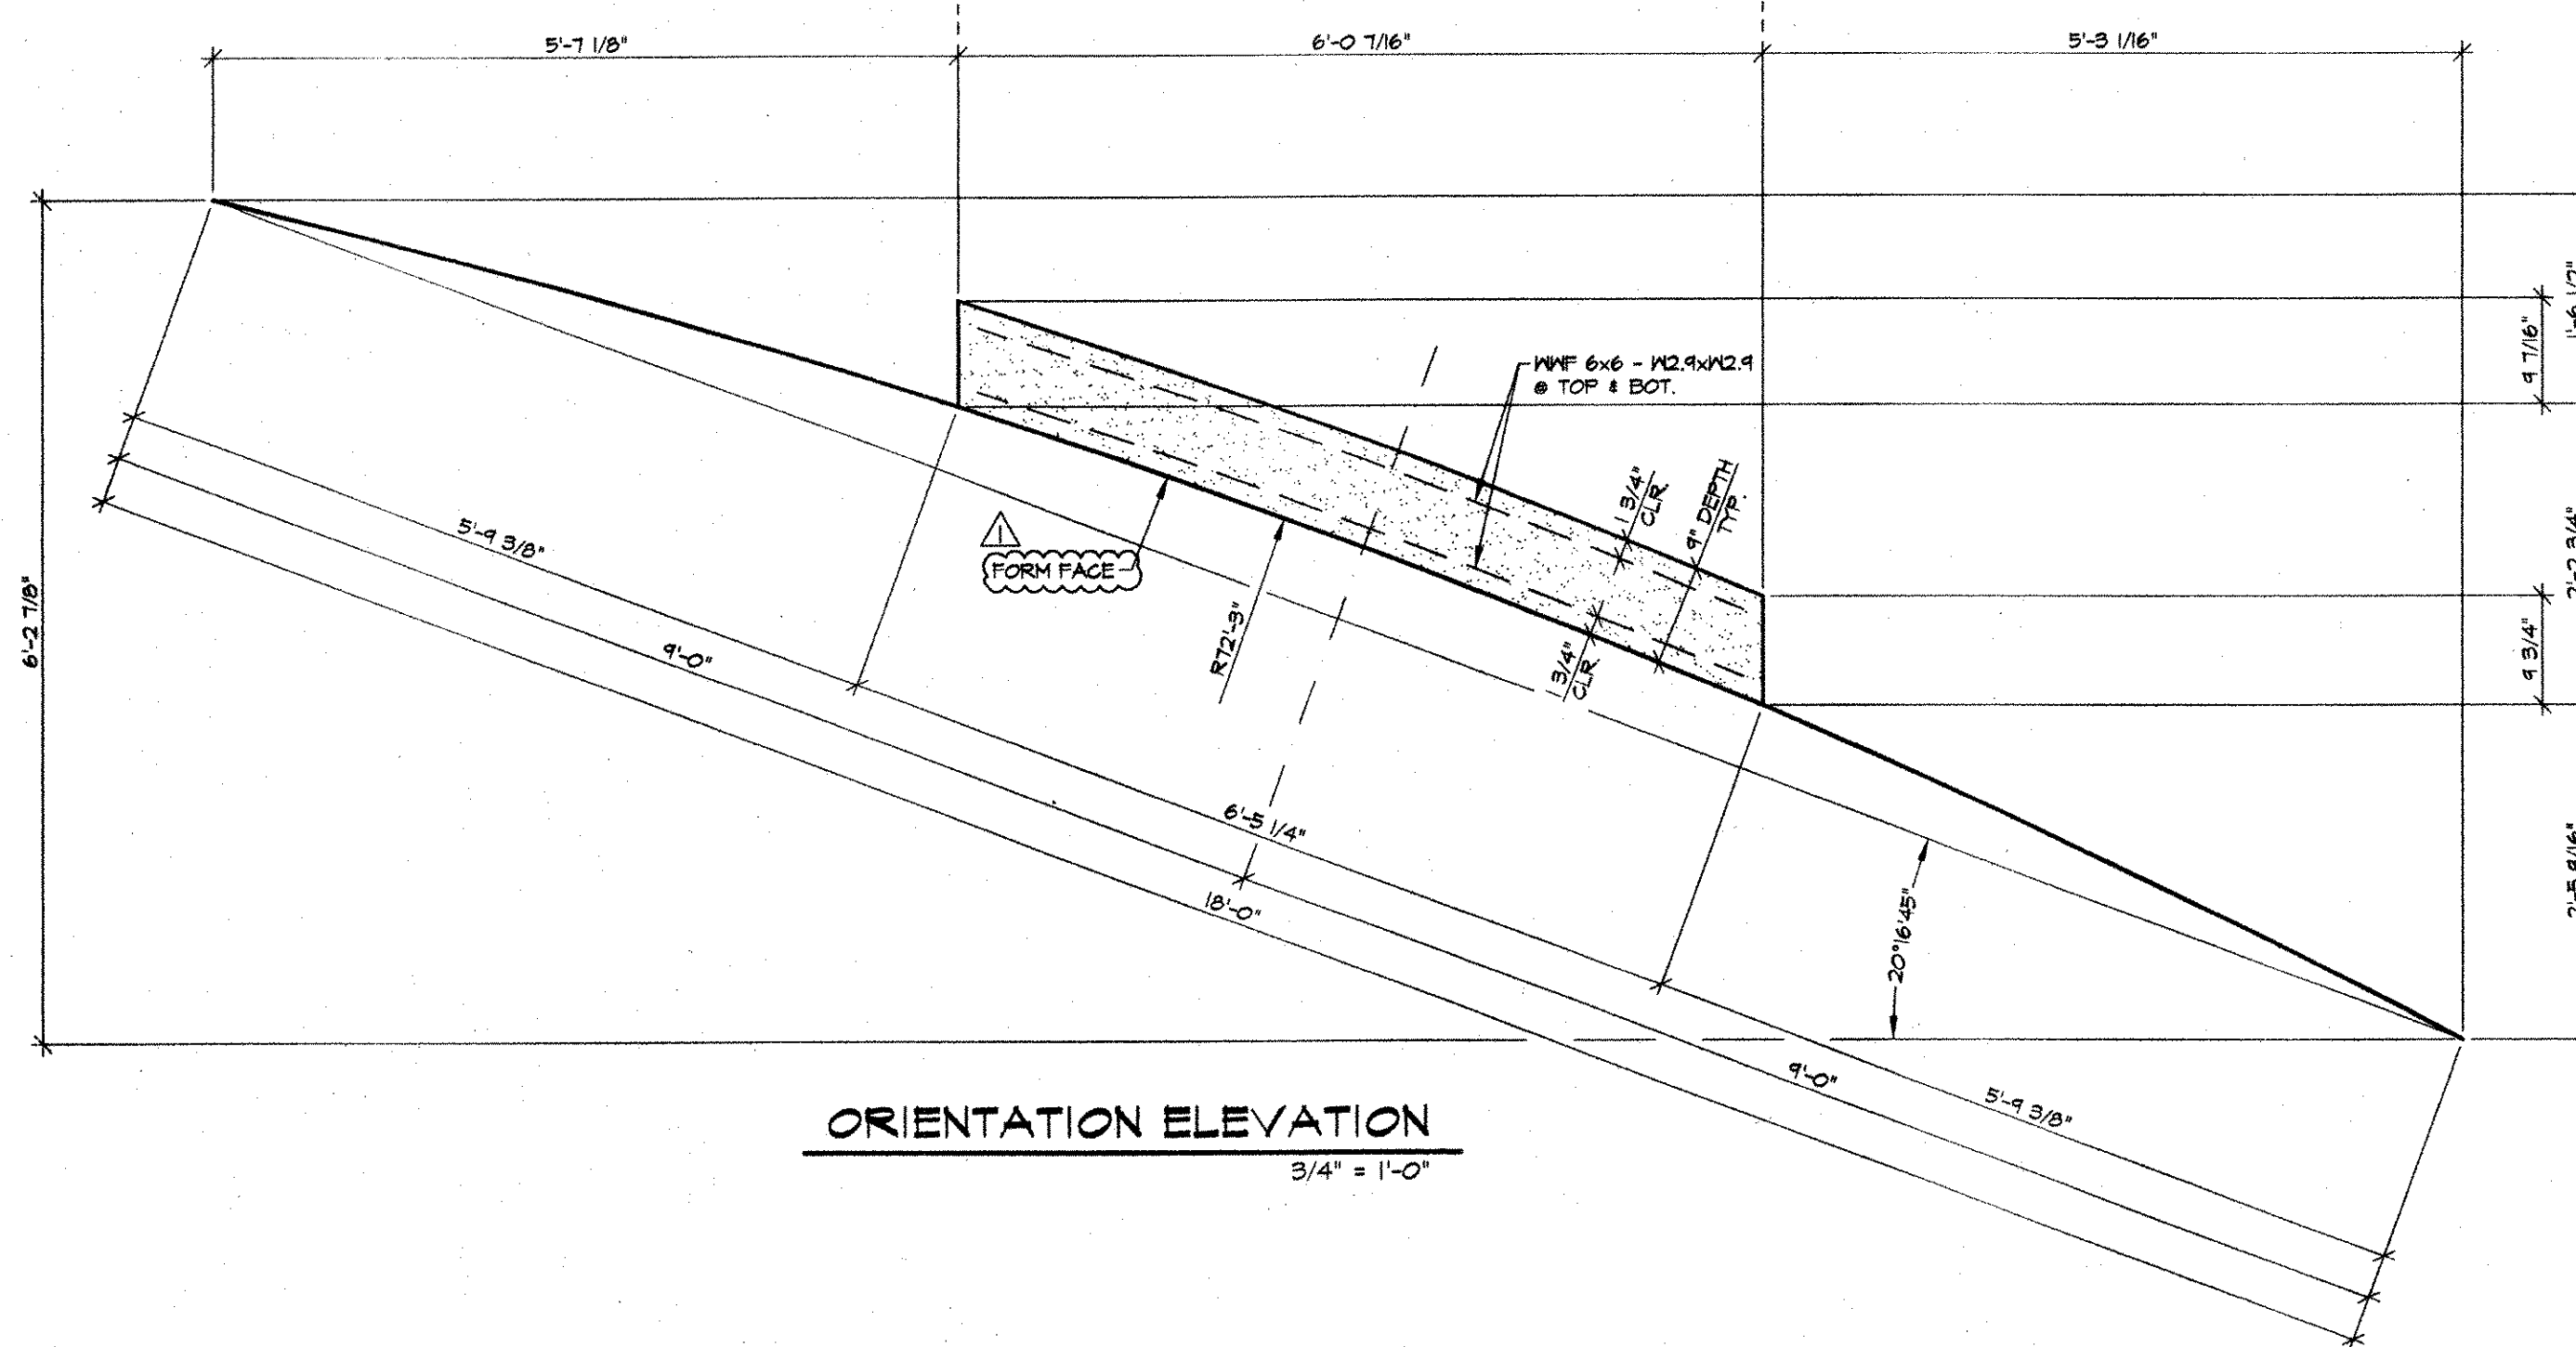
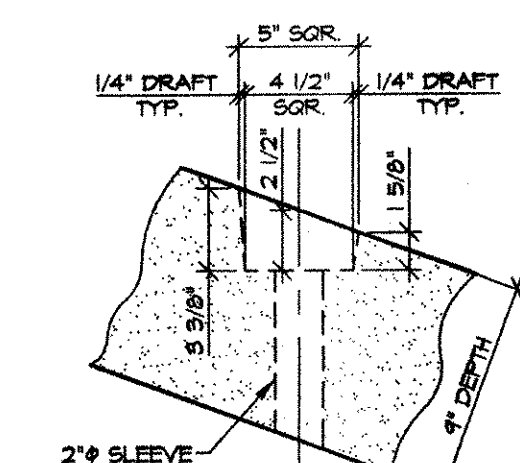
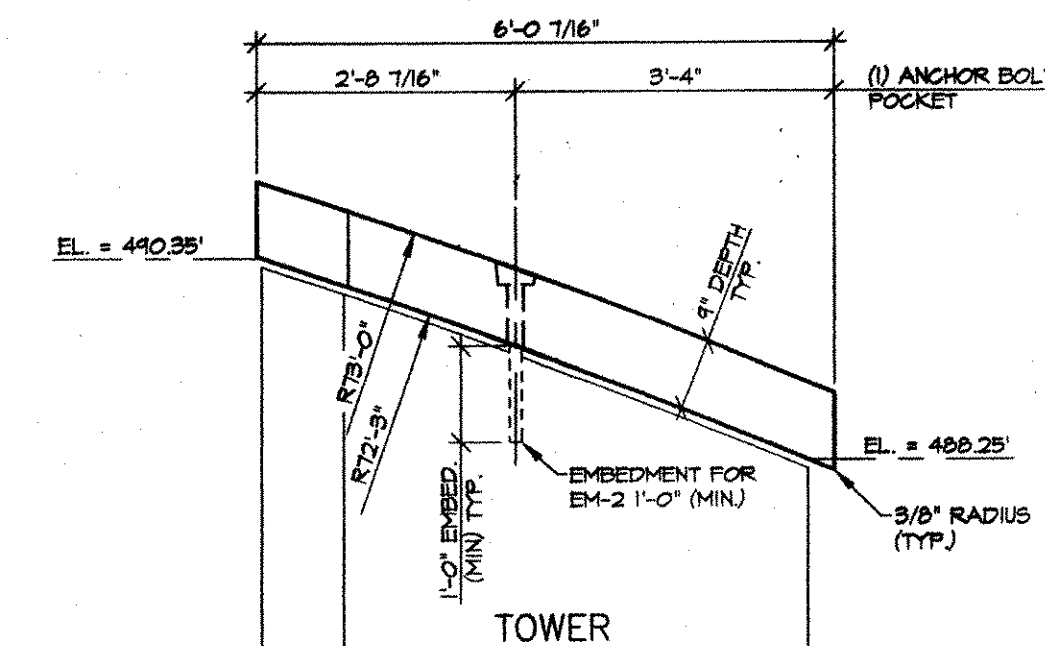
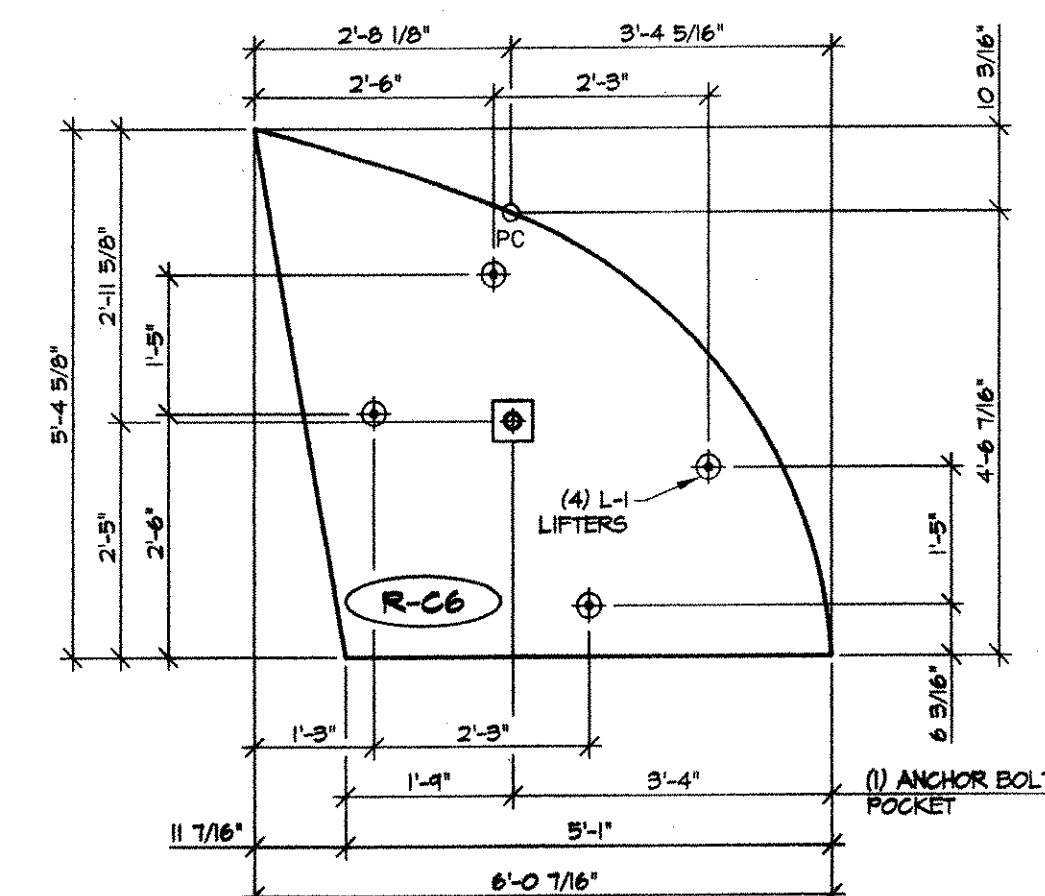


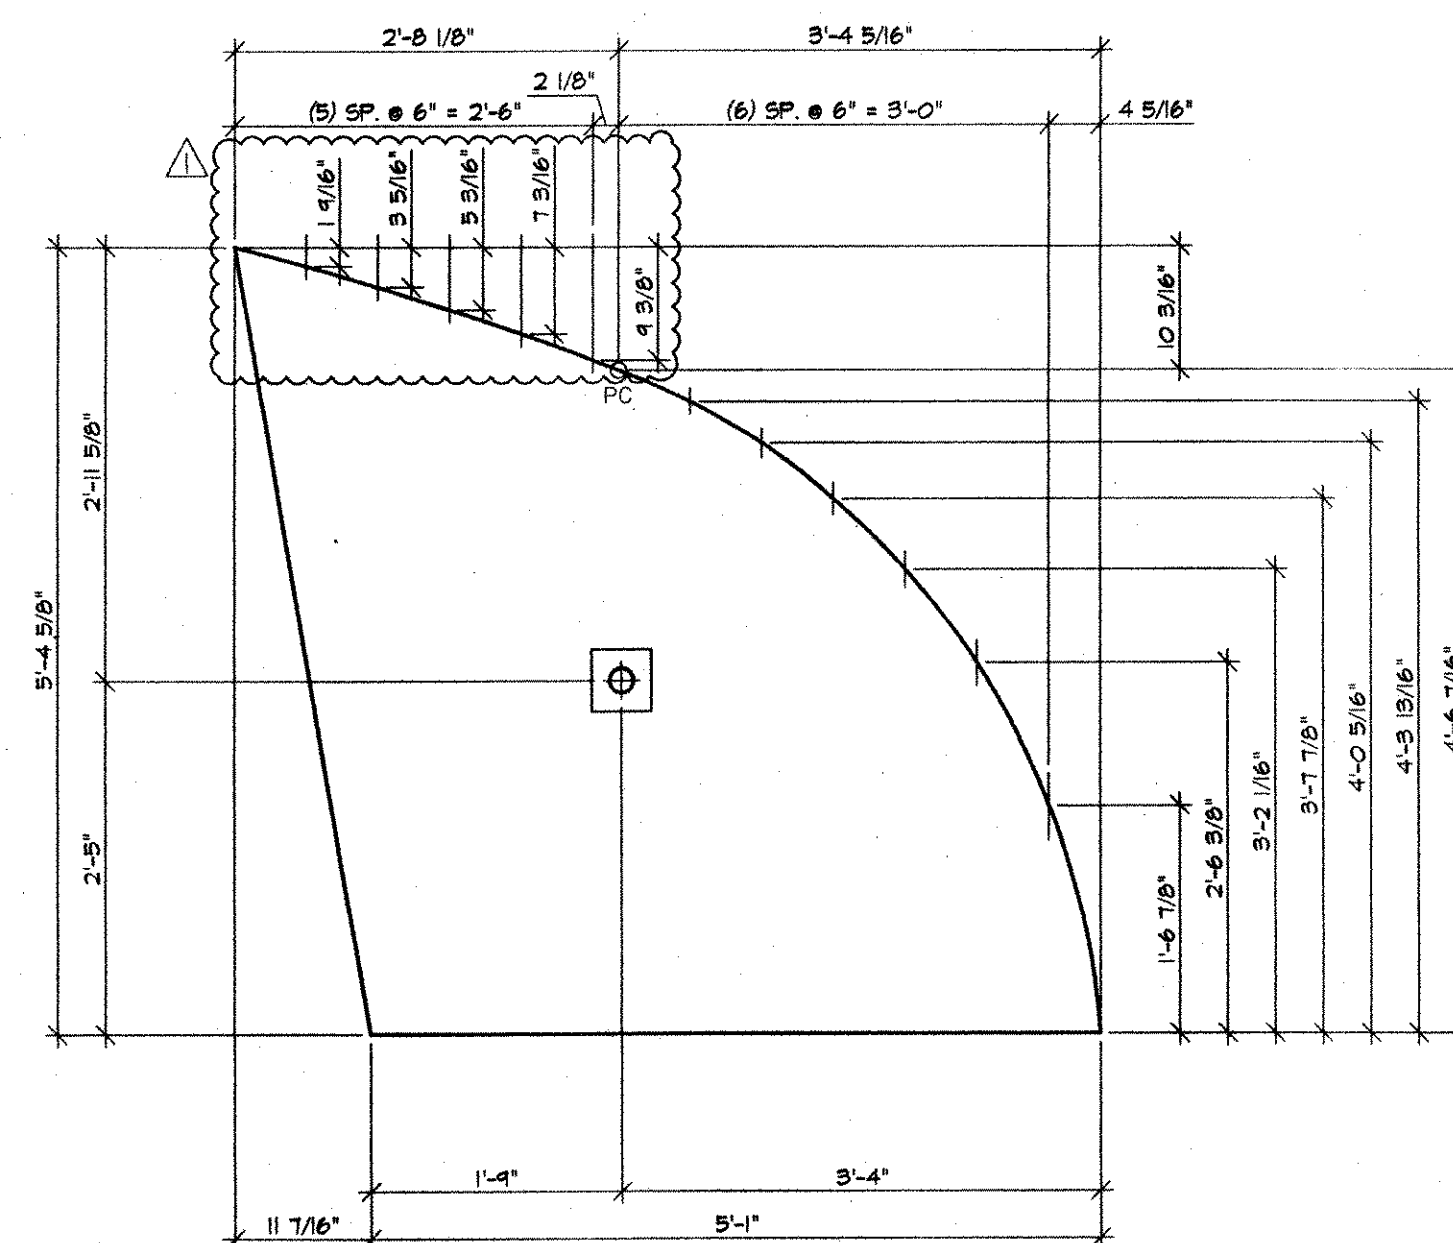

RECEIVED
CK'D BY was OK'D BY _____
APR 26 2001
RESUBMIT _____ APPROVED ☒
BY OW DATE 5/29/01

SHOP NOTE:
f'c = 3,000 PSI (MIN.) @ STRIPPING
f'c = 5,000 PSI (MIN.) @ 28 DAYS

MARK: R-C6	QTY.: 1	WT./TONS: 1.17	CU. YDS.: 0.58
-------------------	----------------	-----------------------	-----------------------

ITEM	MARK	QTY.	DESCRIPTION	REMARKS
1	EM-1	1	1/2" WASHER 1/2"x3"x3/8" (AASHTO 163, GR. 36) PV (1) 1 1/2" HOLE (GALV.)	FOR ERECTION
2	EM-2	1	1 1/4" Ø x 1'-4" ANCHOR BOLT (GALV.) (ASTM A307, GR. C)	FOR ERECTION
3	EM-3	1	1 1/4" HEAVY HEX NUT (GALV.)	FOR ERECTION
4	L-1	4	1T x 4 3/4" SWIFT LIFT LIFTERS (DAYTON)	
5				
6				
7				
8				
9				
10				

NOTES:

1. ALL SURFACES OF THE PRECAST CAPS (EXCLUDING FORM FACE) SHALL BE GIVEN A RUBBED FINISH PER VAOT STD. SPECIFICATIONS SUB-SECTION 501.16(a)2.
2. ALL EDGES OF PRECAST CAPS SHALL BE FABRICATED TO BE VERTICAL IN THE FINAL ERECTED POSITION.

--	--	