




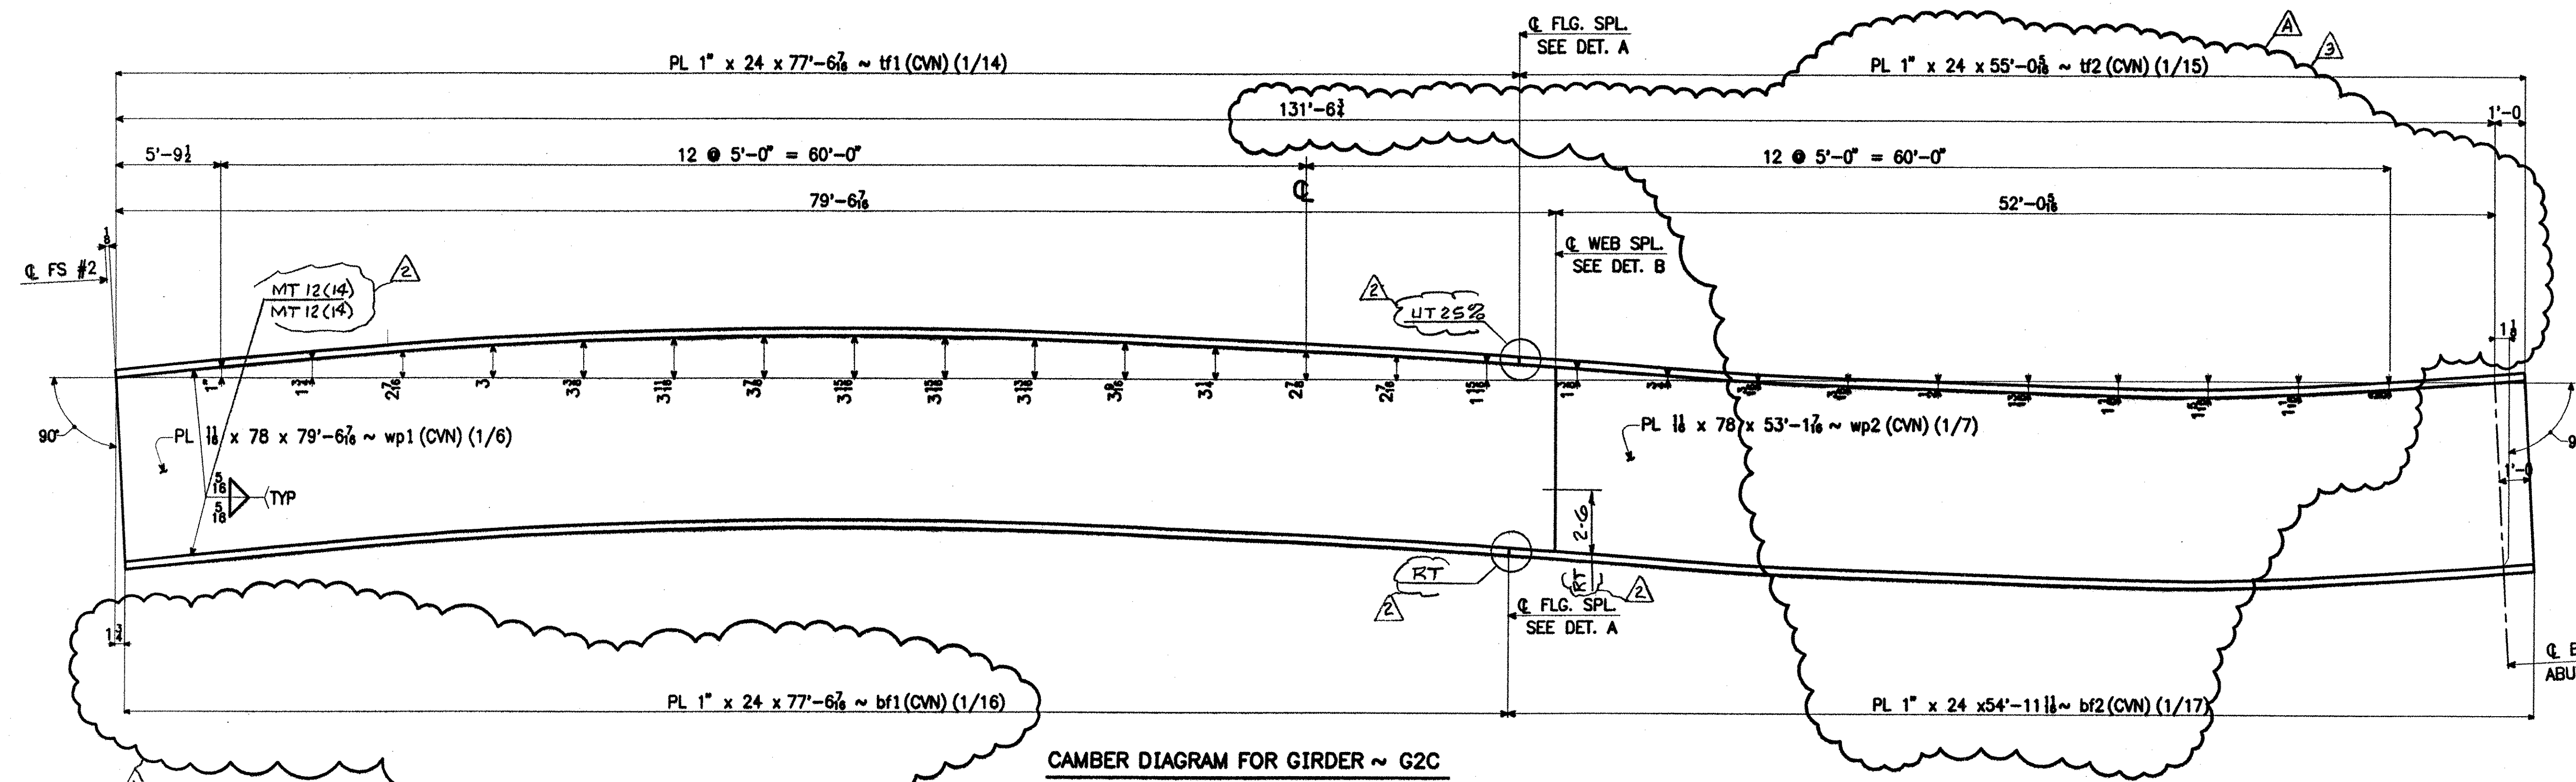


CAMBER DIAGRAM FOR GIRDER ~ G2C

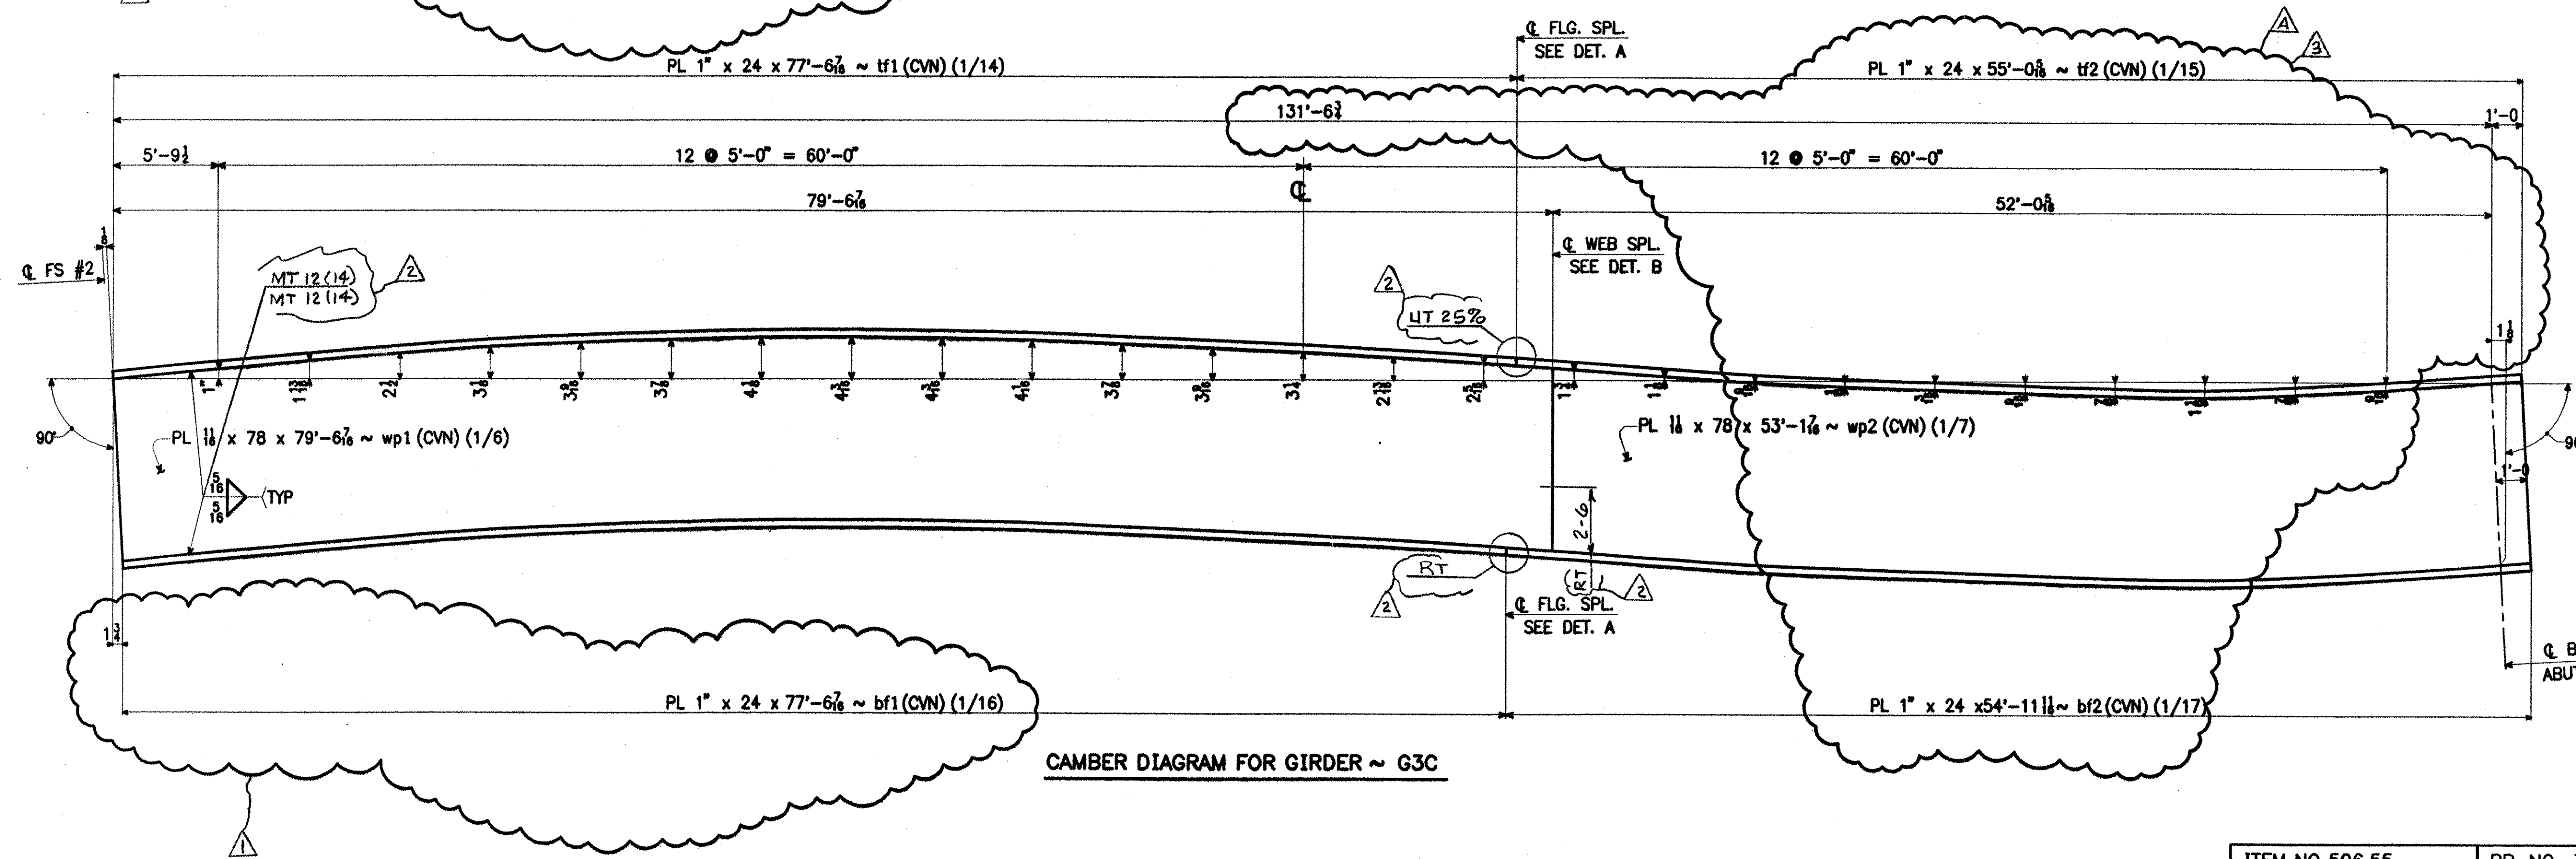

CAMBER DIAGRAM FOR GIRDER ~ G3C

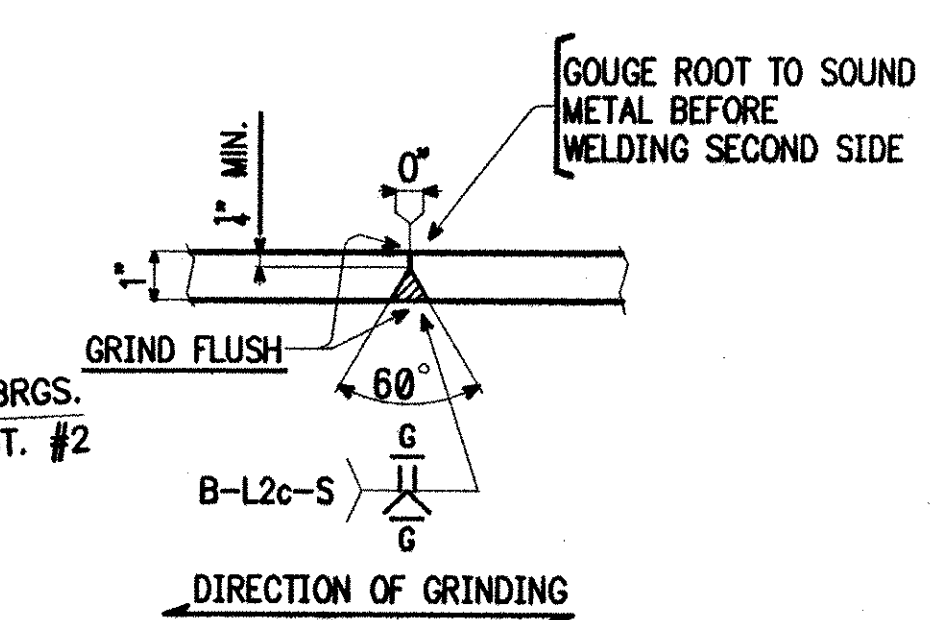

FLANGE SPLICE DETAIL A

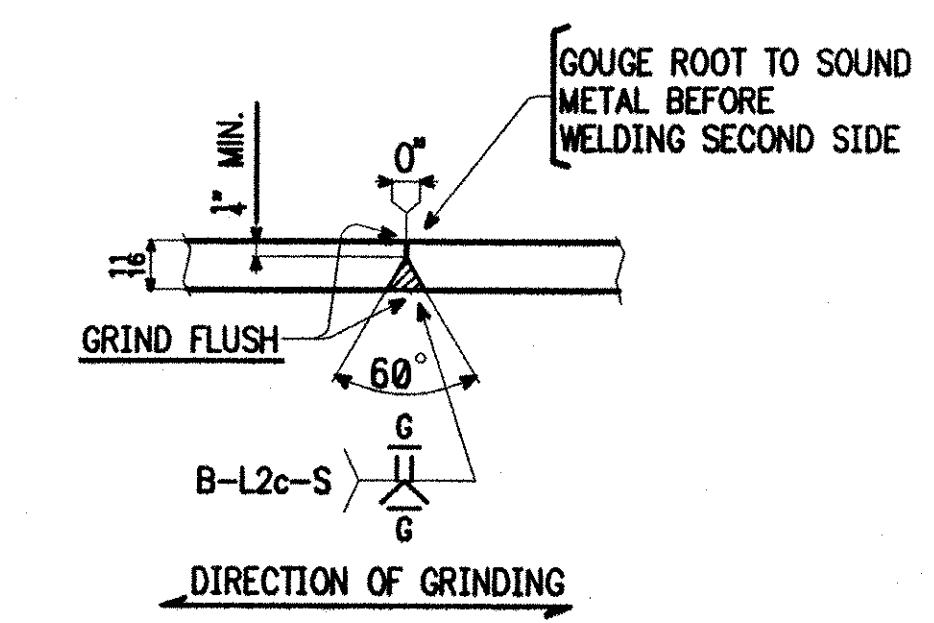

WEB SPLICE DETAIL B

- NOTES:**
1. MATERIAL: ASTM A709-50W
 2. CVN DENOTES CHARPY V-NOTCH TESTING REQUIRED.

- ③ FLG & WEB 12-17-01 AV
- ② NDT 8-23-01 JCM
- ① APPL COMMENTS 8-22-01 AV
- ④ APPL COMMENTS 6-21-01 AV

ITEM NO. 506.55	BR. NO. 3	PROJ. NO. BRZ 1444(22)
TITLE: CAMBER DIAGRAMS		
APPROVED: 9-5-01	National Eastern Corporation Plainville, Connecticut JOB: T.H. 1 OVER THE WHITE RIVER ROYALTON, VERMONT CUSTOMER: BECK & BELLUCCI, INC. DESIGNER: VERMONT AGENCY OF TRANSPORTATION	
PRINT DIST.		
5 1-7-01 APPR.		
ORIG. 6-21-01 FAB.		
5 7-13-01 APP		
12 8-23-01 FAB		
5 8-24-01 APP		
12 8-24-01 FAB		
5 12-18-01 APP		
11 12-18-01 FAB		
CHECKED TS 3/01	WORK ORDER NO. 15873	DRAWING NO. 12-4
DRAWN AV 3/01		REV. 3

RECEIVED
CVD BY LJA OK'D BY
DEC 27 2001
RESUBMIT BY CPW APPROVED DATE 1/4/02

FOR APPROVAL
REVISED