


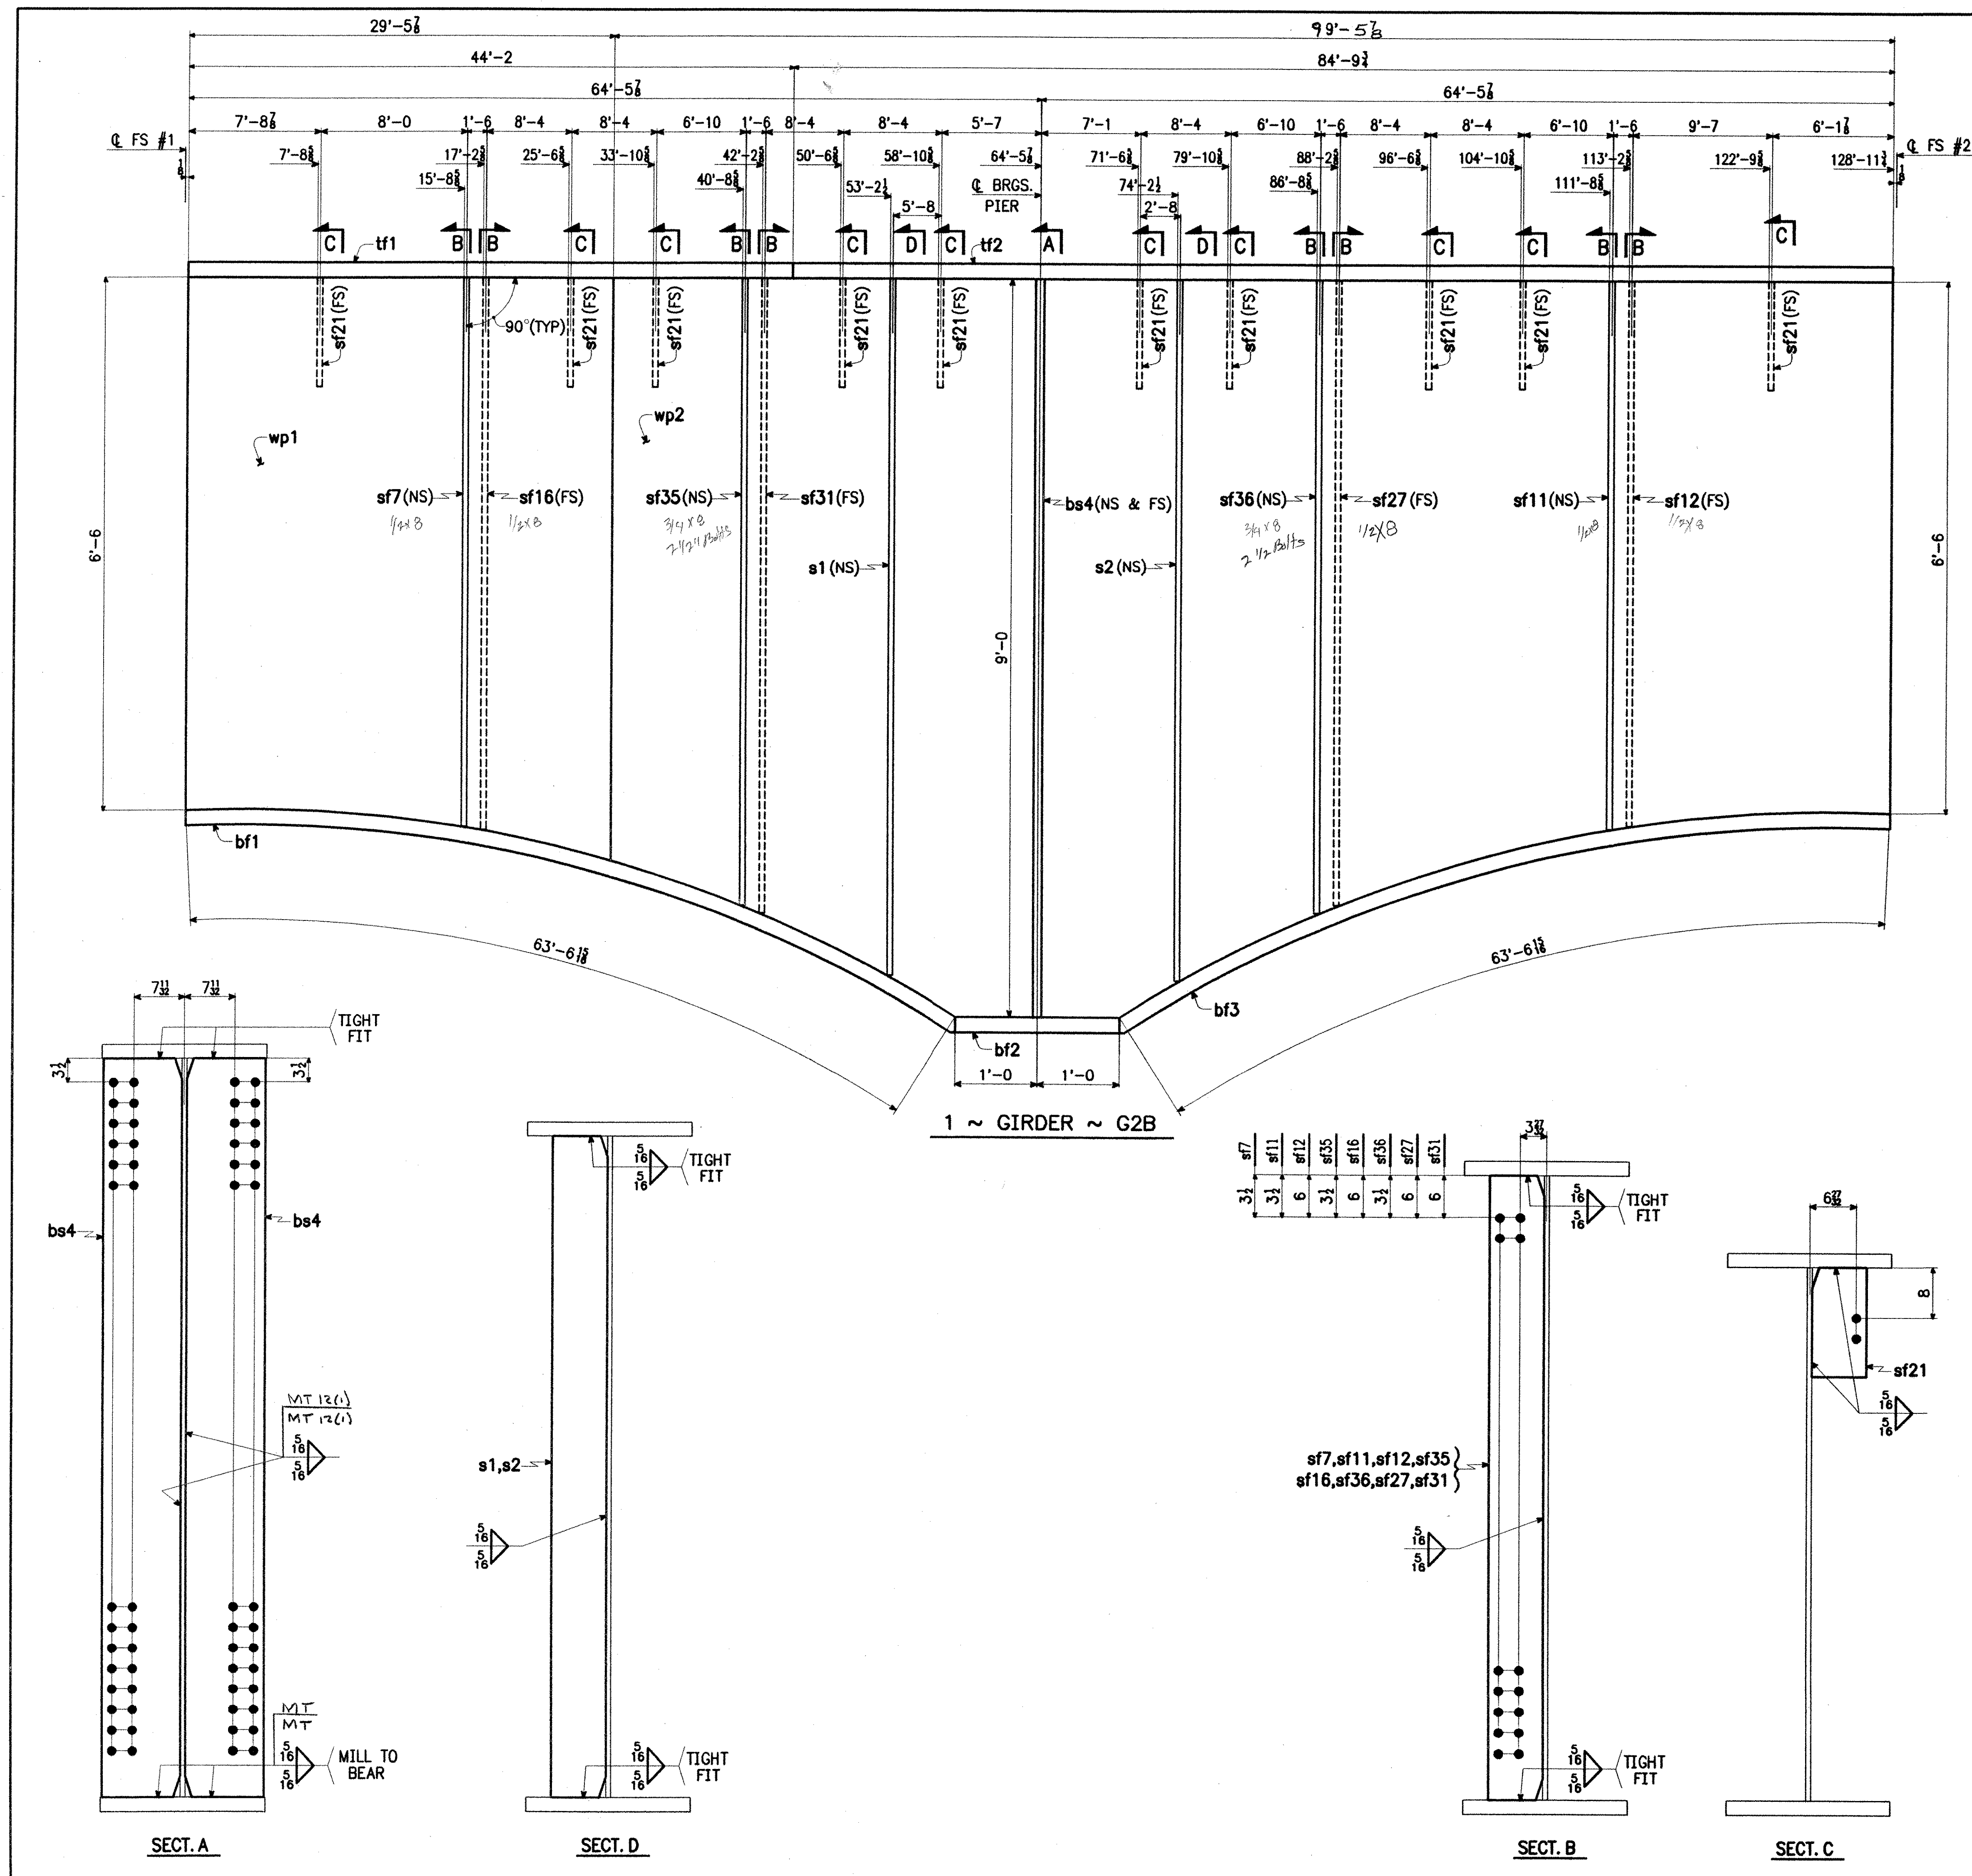

SHIP MARK	BILL OF MATERIAL				WORK ORDER NO.	DRAWING NO.	REV.
	NO.	MARK	SHAPE	LENGTH	15873	12-17	B
					ITEM NO.	WT.	REMARKS
G2B	1		GIRDER				
	1	tf1	PL 2 1/2 x 24	44'-2"	3116	CVN	
	1	tf2	PL 2 1/2 x 24	84'-9 1/2"	15584	CVN	
	1	bf1	PL 2 1/2 x 24	63'-6 1/8"	11682	CVN	
	1	bf2	PL 2 1/2 x 24	2'-0"	368	CVN	
	1	bf3	PL 2 1/2 x 24	63'-6 1/8"	11682	CVN	
	1	wp1	PL 1 1/2 x 82 1/2	29'-5 1/2"		CVN	
	1	wp2	PL 1 1/2 x 108	99'-5 1/2"	26140	CVN	
	2	bs4	PL 1 1/2 x 11 1/2	9'-0"	880	M1E	
	1	sf7	PL 1/2 x 8	6'-6 1/8"	89		
	1	sf11	PL 1/2 x 8	6'-6 1/8"	89		
	1	sf12	PL 1/2 x 8	6'-6 1/8"	89		
	1	sf35	PL 3/4 x 8	7'-4 1/2"	150		
	1	sf16	PL 1/2 x 8	6'-6 1/8"	89		
	1	sf36	PL 3/4 x 8	7'-5 1/2"	152		
	1	sf27	PL 1/2 x 8	7'-4 1/2"	100		
	1	sf31	PL 1/2 x 8	7'-5 1/2"	101		
	10	sf21	PL 1/2 x 8	1'-4"	181		
	1	s1	PL 3/4 x 8	8'-1 1/2"	167		
	1	s2	PL 3/4 x 8	8'-3 1/2"	169		
					75828		

NOTES:

- FOR GENERAL NOTES, SEE SHT. GN1.
- FOR GIRDER CAMBER DIAGRAM, SEE DWG. 12-6.
- FOR GIRDER STANDARD DETAILS, SEE DWG. 12-9.
- FOR FIELD SPLICE DETAIL, SEE DWG. 12-10.

RECEIVED
OK'D BY: *WAS* OK'D BY: _____
AUG 27 2001
RESUBMIT: _____ APPROVED: *CPW*
BY: *CPW* DATE: 8/30/01

STEEL: ASTM	☐ A709-36	☐ A709-50	☒ A709-50W	☐ Unless Noted
WELDING ELECTRODE:	☒ E70	☐ See Welding Proc.	☐ None	☐
HOLES:	☐ 13/16	☒ 15/16	☐ 1 1/16	☐ Unless Noted ☐ As Noted ☐ None
PAIN:	☒ None	☐ Galv. After Fab.	☐ As Noted	☐
SPECIAL PAINT:	☐	☐	☐	☐
SPECIAL CLEANING:	☒ Blast Clean SSPC SP10	☐ None	☐	☐
ITEM NO. 506.55	BR. NO. 3	PROJ. NO. BRZ 1444(22)		
TITLE: GIRDER ~ G2B				
FOR APPROVAL				
APPROVED:	PRINT DIST.			
5	4-7-01	APPR.		
ORIG.		FAB.		
5	2-13-01	APP		
5	2-24-01	APP		
National Eastern Corporation Plainville, Connecticut				
JOB: T.H. 1 OVER THE WHITE RIVER ROYALTON, VERMONT				
CUSTOMER: BECK & BELLUCCI, INC.				
DESIGNER: VERMONT AGENCY OF TRANSPORTATION				
WORK ORDER NO. 15873				
DRAWING NO. 12-17				
REV. B				
CHECKED	TS	3/01		
DRAWN	AV	3/01		