
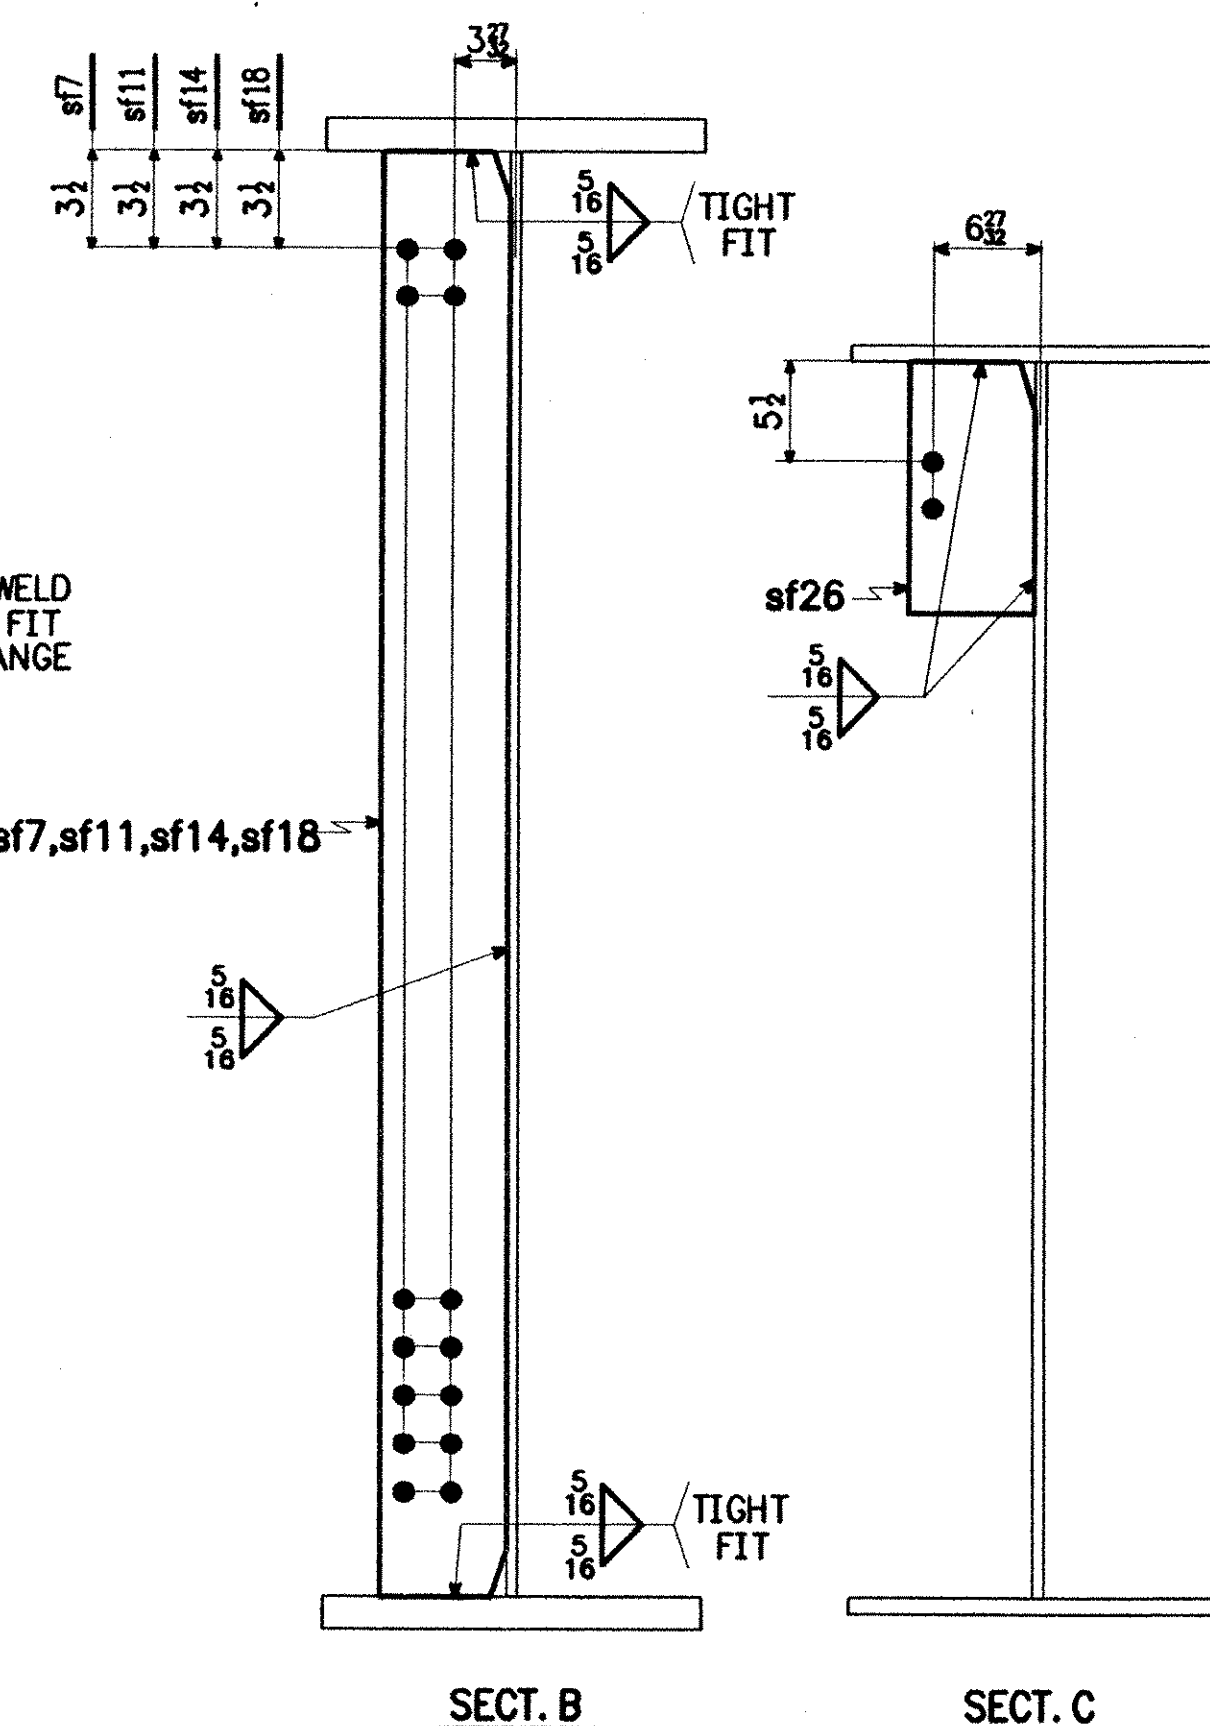
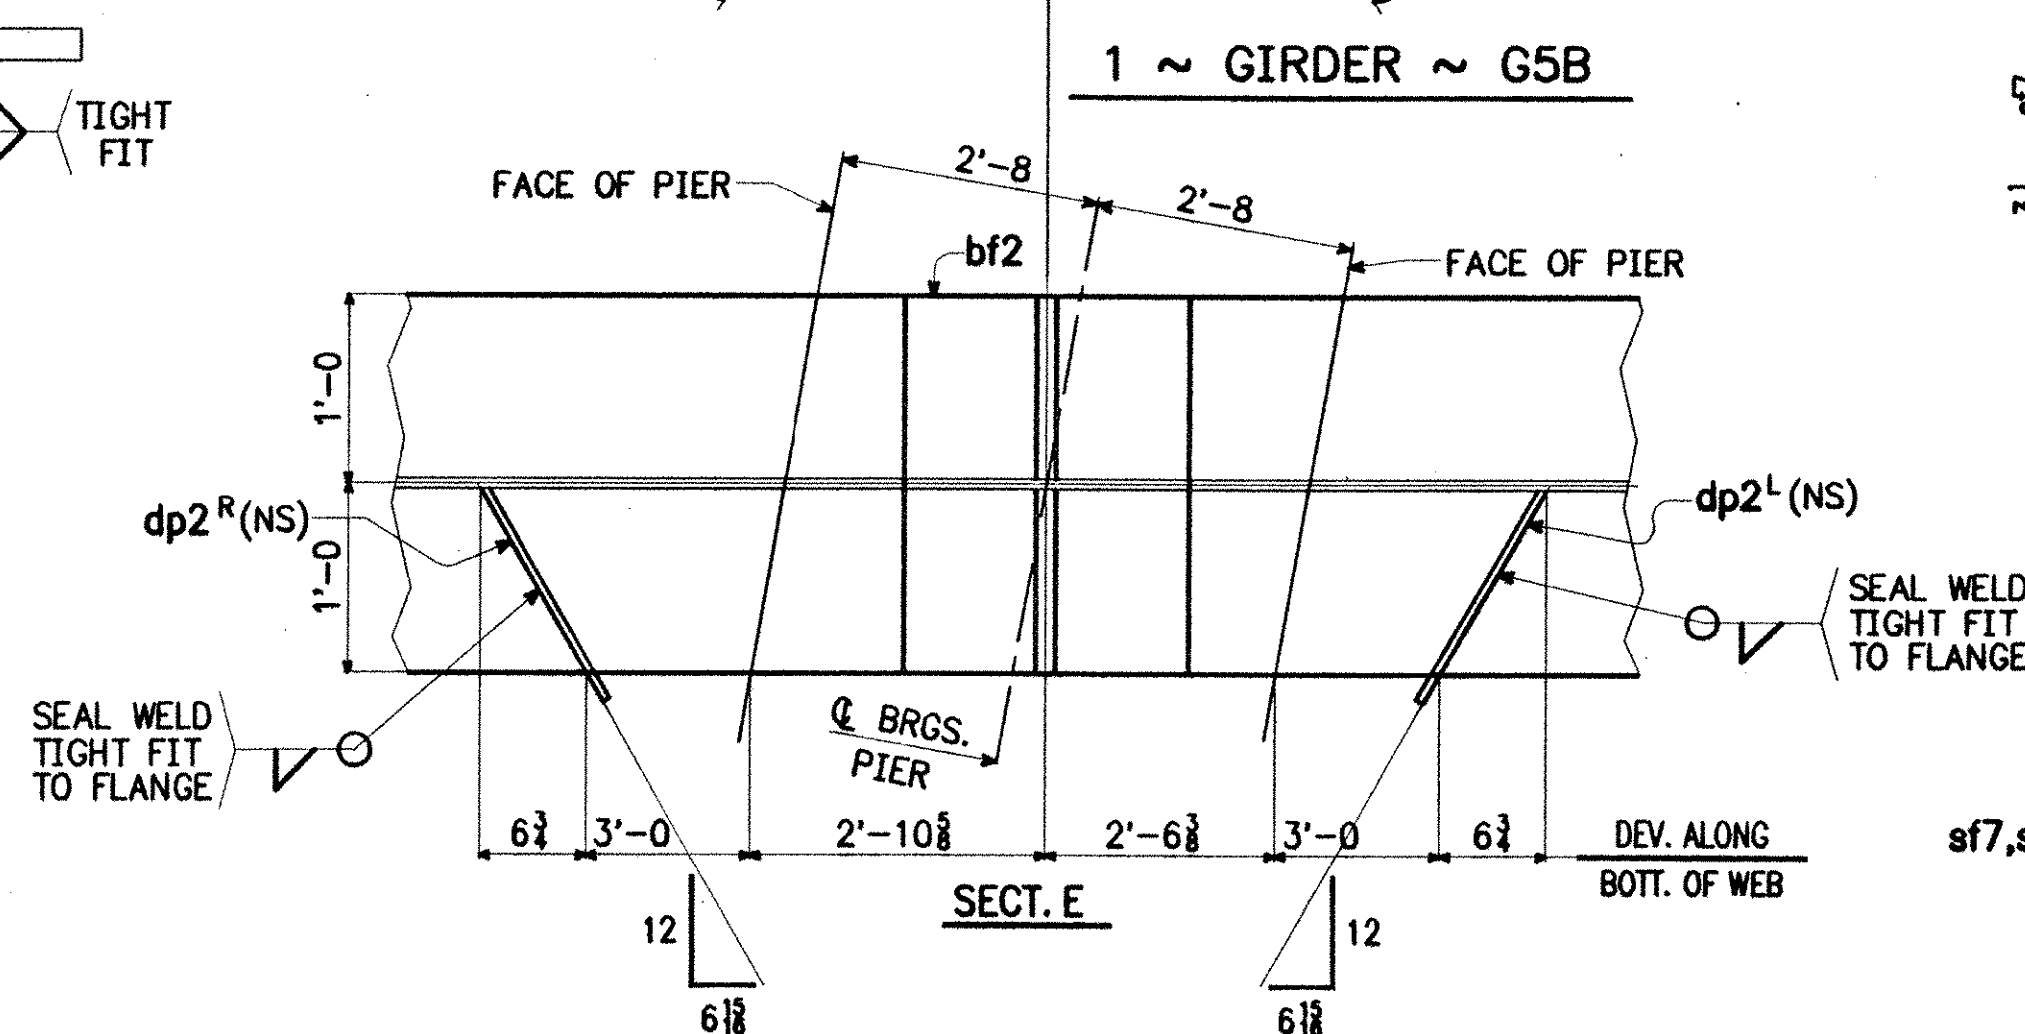
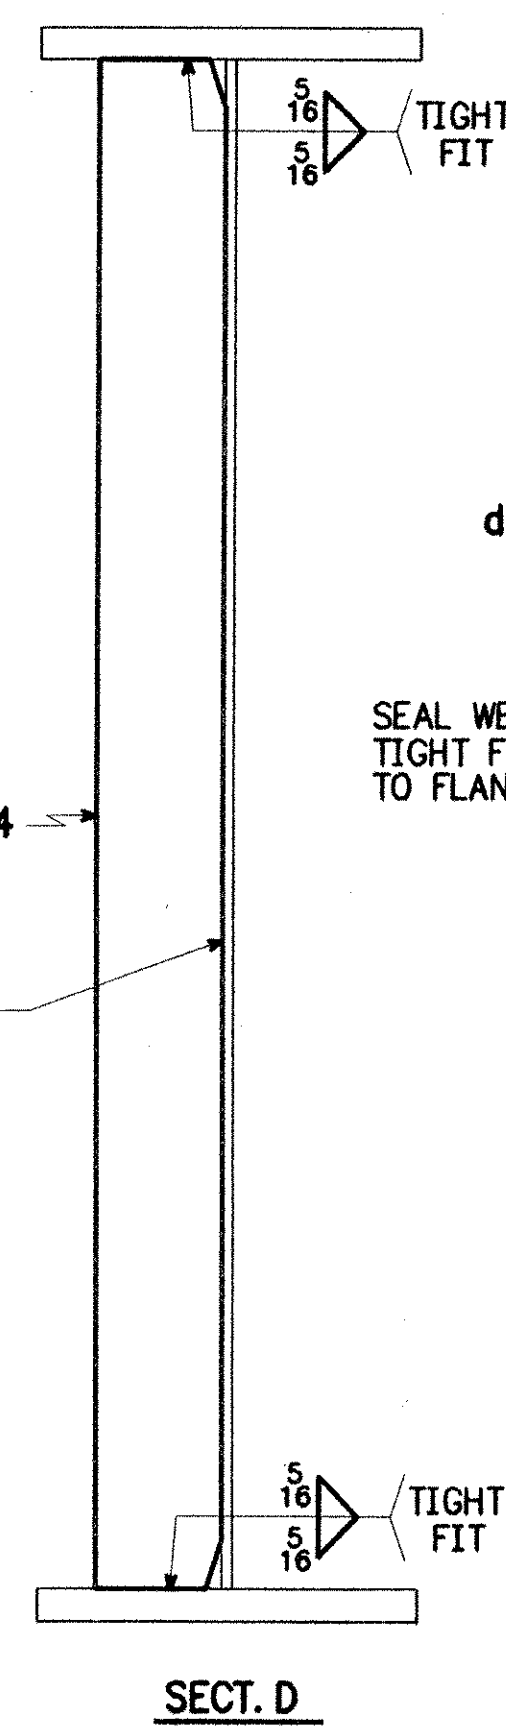
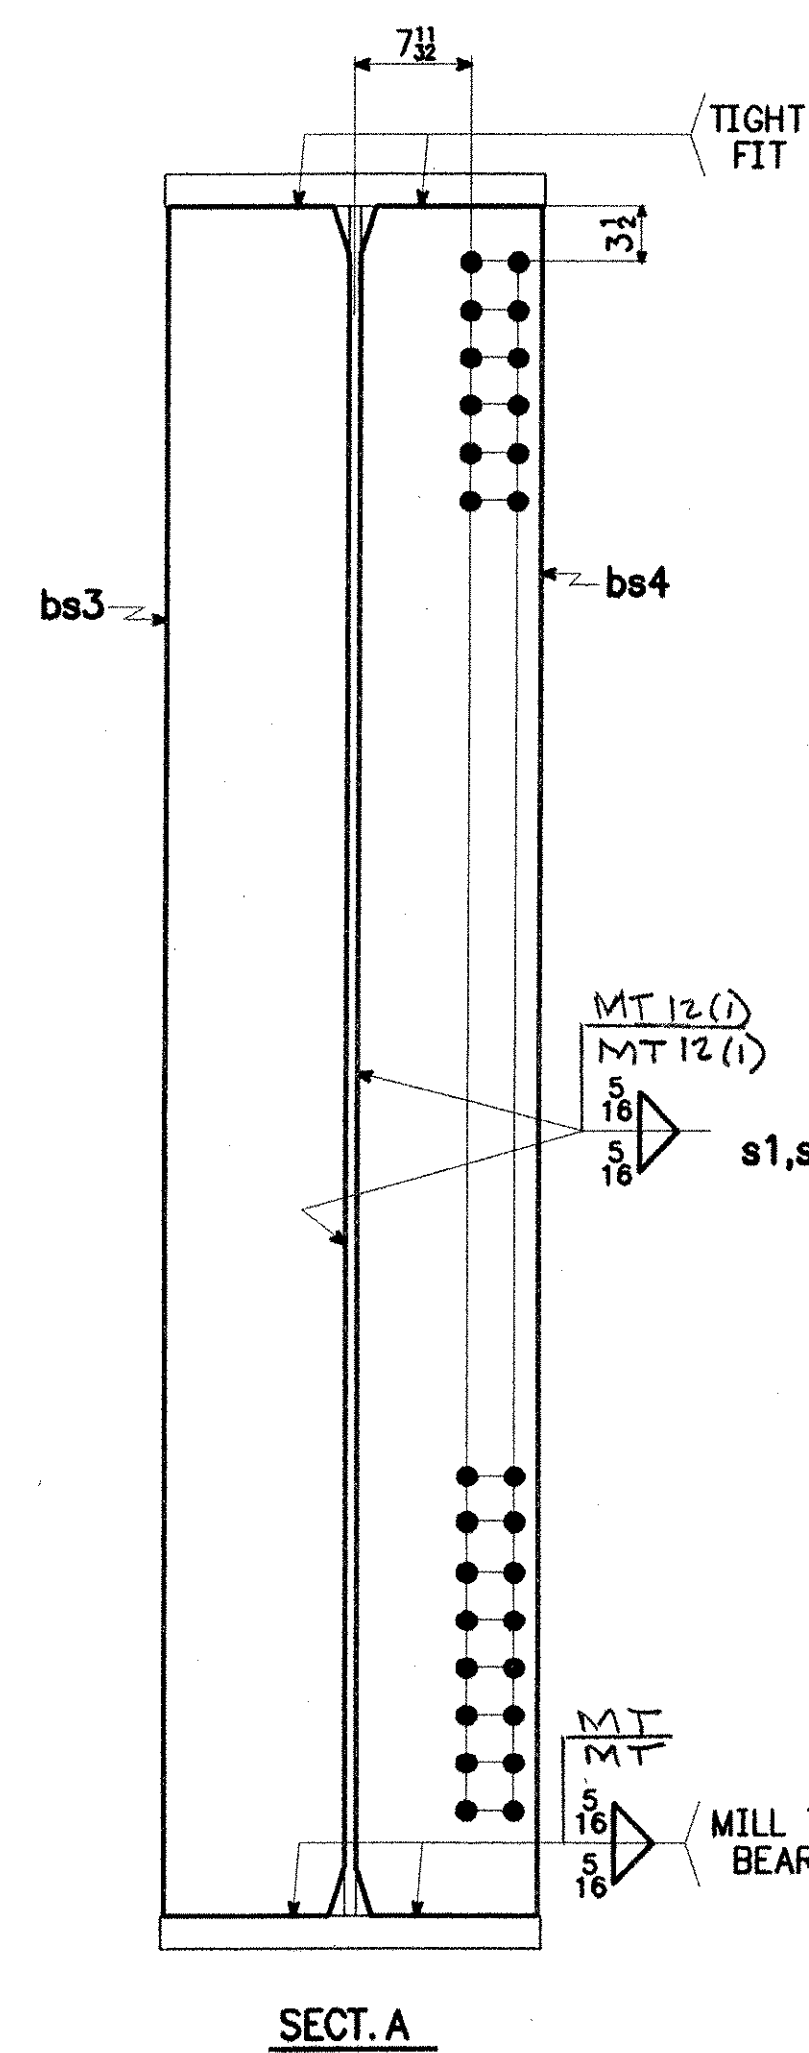


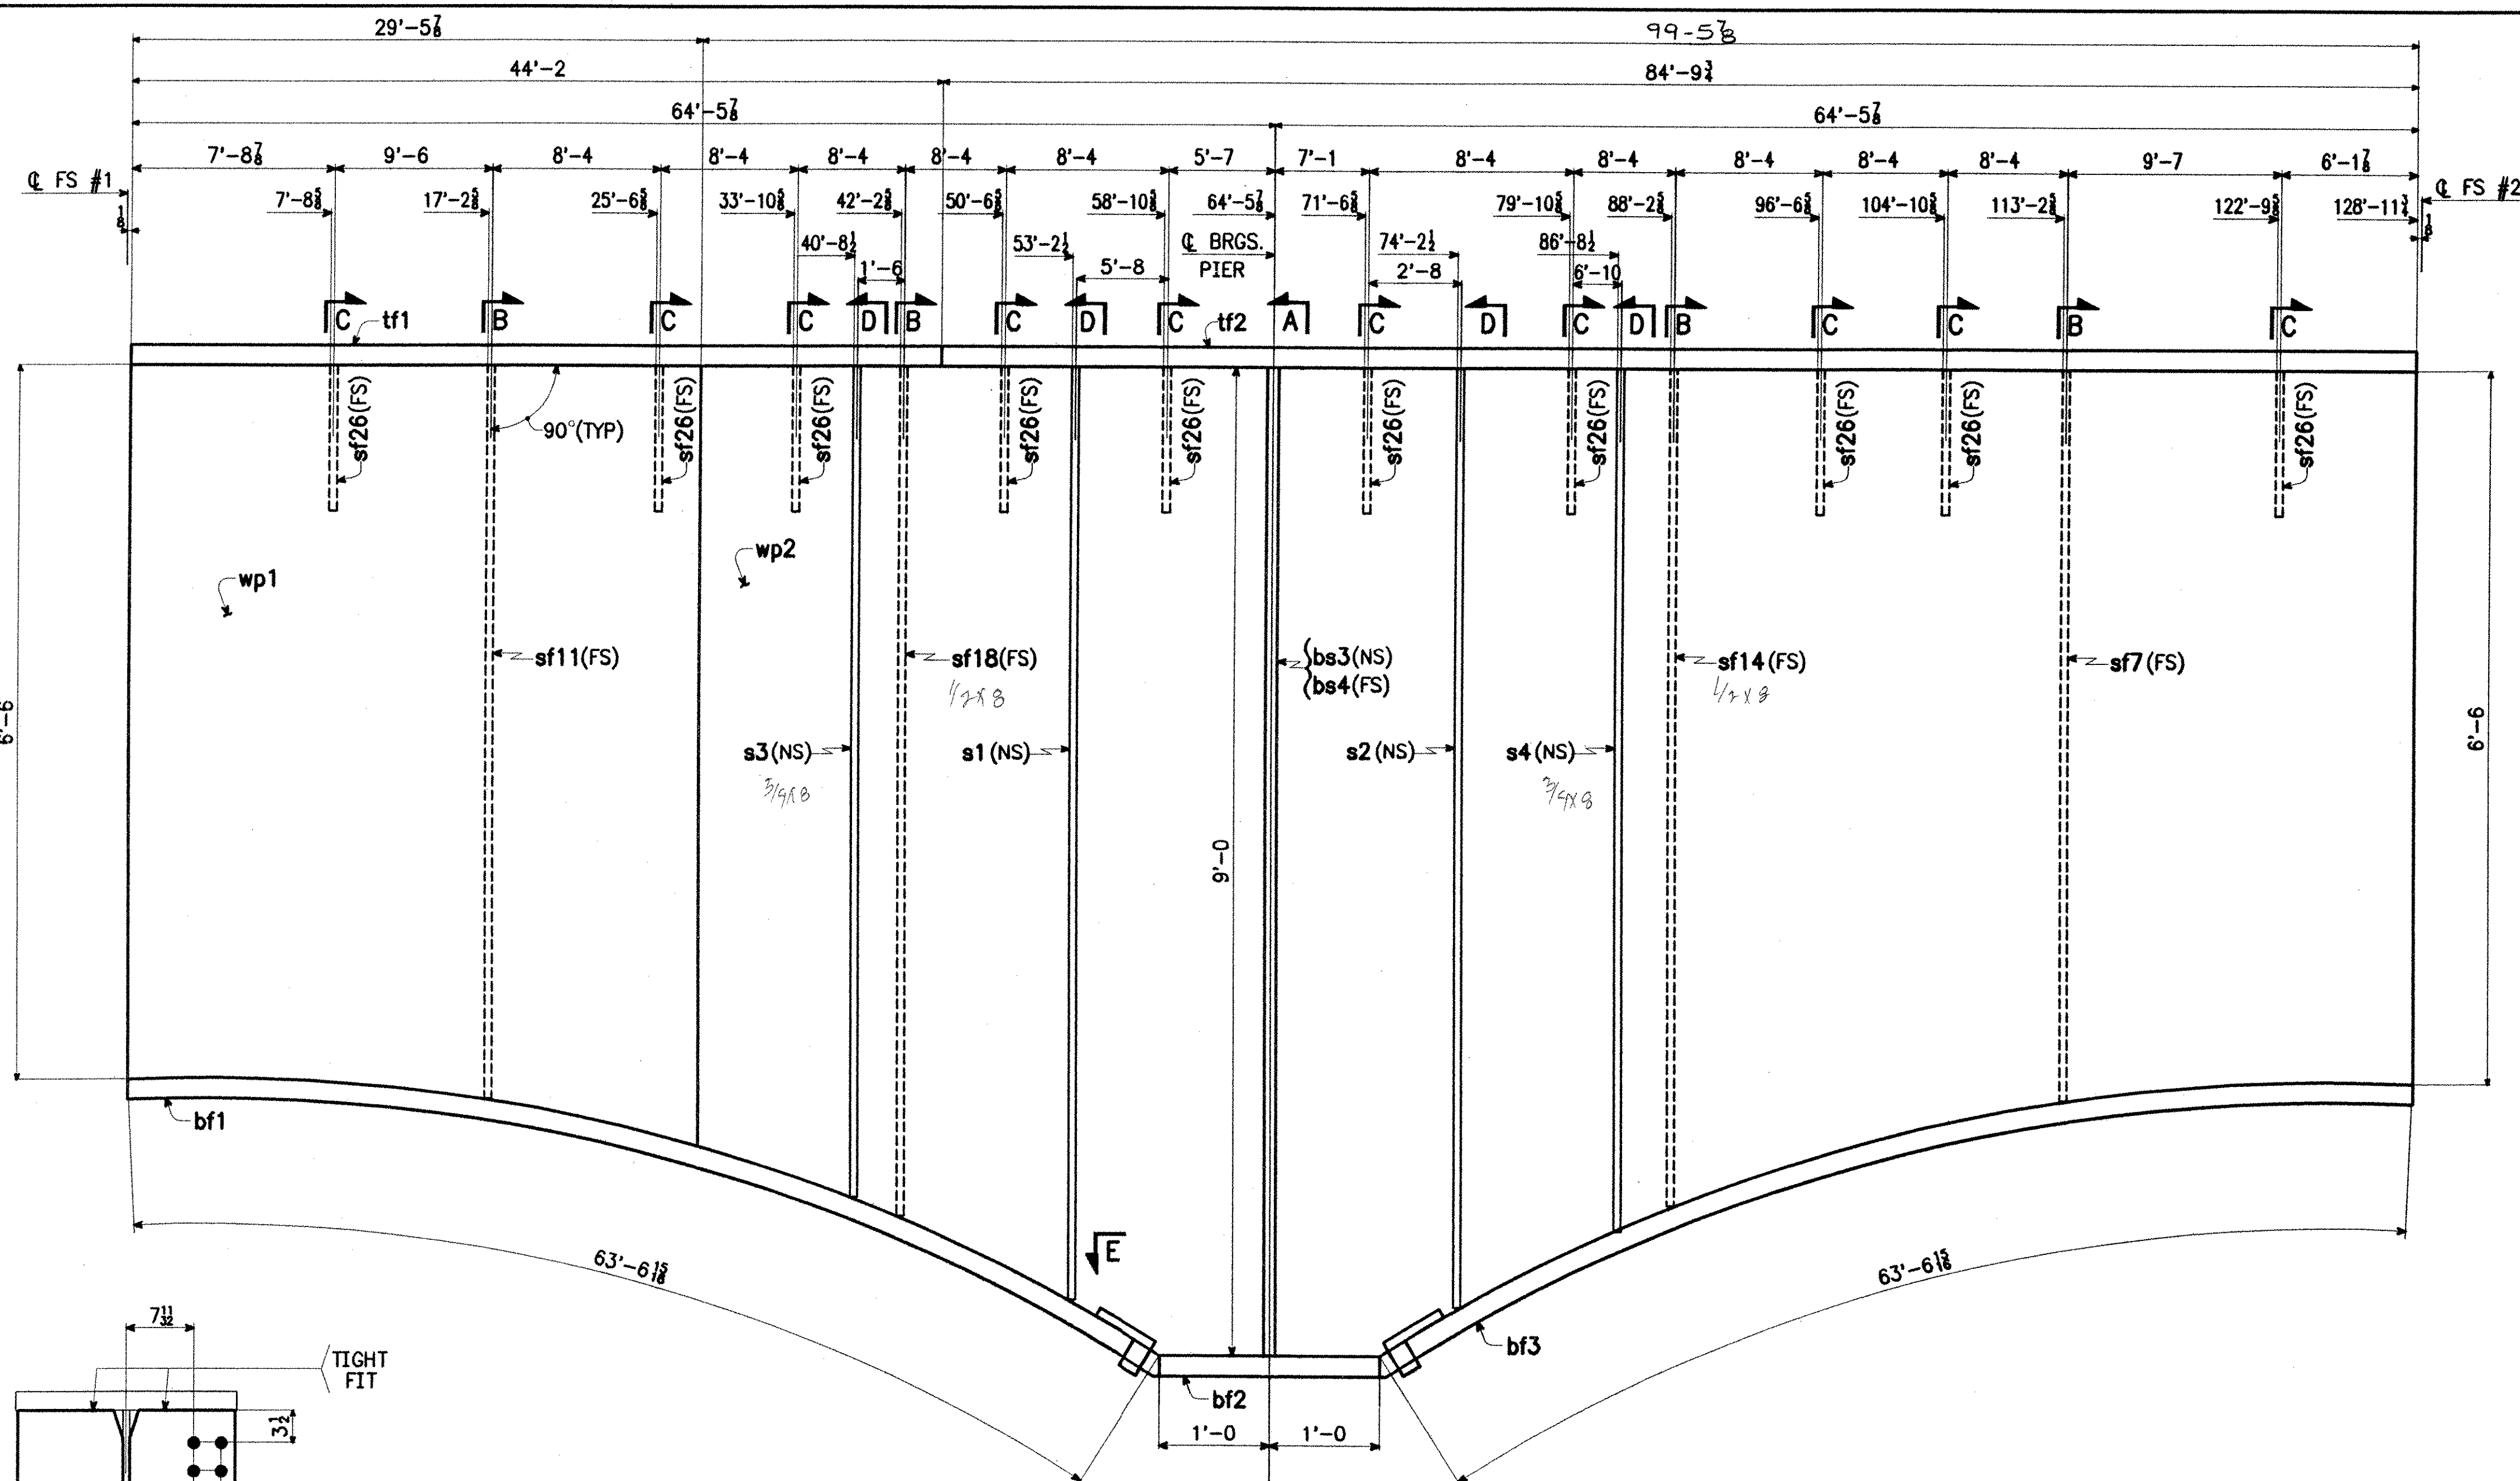

SHIP MARK	BILL OF MATERIAL				WORK ORDER NO.	DRAWING NO.	REV.
	NO.	MARK	SHAPE	LENGTH	ITEM NO.	WT.	REMARKS
G5B	1		GIRDER				
	1	tf1	PL 21 x 24	44'-2	8116	CVN	
	1	tf2	PL 21 x 24	84'-9 1/2	15584	CVN	
	1	bf1	PL 21 x 24	63'-6 1/8	11682	CVN	
	1	bf2	PL 21 x 24	2'-0	368	CVN	
	1	bf3	PL 21 x 24	63'-6 1/8	11682	CVN	
	1	wp1	PL 11/8 x 82 1/2	29'-5 1/8		CVN	
	1	wp2	PL 11/8 x 108	99'-5 1/8	26140	CVN	
	1	bs3	PL 1 1/4 x 11 1/2	9'-0	440	M1E	
	1	bs4	PL 1 1/4 x 11 1/2	9'-0	440	M1E	
	1	sf11	PL 1/2 x 8	6'-6 1/8	89		
	1	sf18	PL 1/2 x 8	7'-5 1/8	101		
	1	sf14	PL 1/2 x 8	7'-4 1/8	100		
	1	sf7	PL 1/2 x 8	6'-6 1/8	89		
	10	sf26	PL 1/2 x 8	1'-4	181		
	1	s1	PL 1/2 x 8	8'-1 1/8	167		
	1	s2	PL 1/2 x 8	8'-3 1/8	169		
	1	s3	PL 1/2 x 8	7'-4 1/8	150		
	1	s4	PL 1/2 x 8	7'-5 1/8	152		
	1	dp2 ^R	PL 1/2 x 4 1/2	1'-3 1/8	5		
	1	dp2 ^L	PL 1/2 x 4 1/2	1'-3 1/8	5		

NOTES:

- FOR GENERAL NOTES, SEE SHT. GN1.
- FOR GIRDER CAMBER DIAGRAM, SEE DWG. 12-8.
- FOR GIRDER STANDARD DETAILS, SEE DWG. 12-9.
- FOR FIELD SPLICE DETAIL, SEE DWG. 12-10.

RECEIVED
OK'D BY WAS OK'D BY _____
AUG 27 2001
RESUBMIT _____ APPROVED _____
BY CAN DATE 8/26/01

STEEL: ASTM ☐ A709-36 ☐ A709-50 ☒ A709-50W ☐ Unless Noted ☐
WELDING ELECTRODE: ☒ E70 ☐ See Welding Proc. ☐ None ☐
HOLES: ☐ 13/16 ☒ 15/16 ☐ 1 1/16 ☐ Unless Noted ☐ As Noted ☐ None ☐
PAINT: ☒ None ☐ Galv. After Fab. ☐ As Noted ☐
SPECIAL PAINT: _____
SPECIAL CLEANING: ☒ Blast Clean SSPC SP10 ☐ None ☐

ITEM NO. 506.55 BR. NO. 3 PROJ. NO. BRZ 1444(22)

TITLE: GIRDER ~ G5B FOR APPROVAL

APPROVED: _____
PRINT DIST. _____
ORIG. 5 4-7-01 APPR. _____
5 7-13-01 APPR. _____
5 8-24-01 APPR. _____
JOB: T.H. 1 OVER THE WHITE RIVER
ROYALTON, VERMONT

NE National Eastern Corporation
Plainville, Connecticut

CUSTOMER: BECK & BELLUCCI, INC.
DESIGNER: VERMONT AGENCY OF TRANSPORTATION

CHECKED TS 3/01
DRAWN AV 3/01
WORK ORDER NO. 15873
DRAWING NO. 12-20
REV. B