


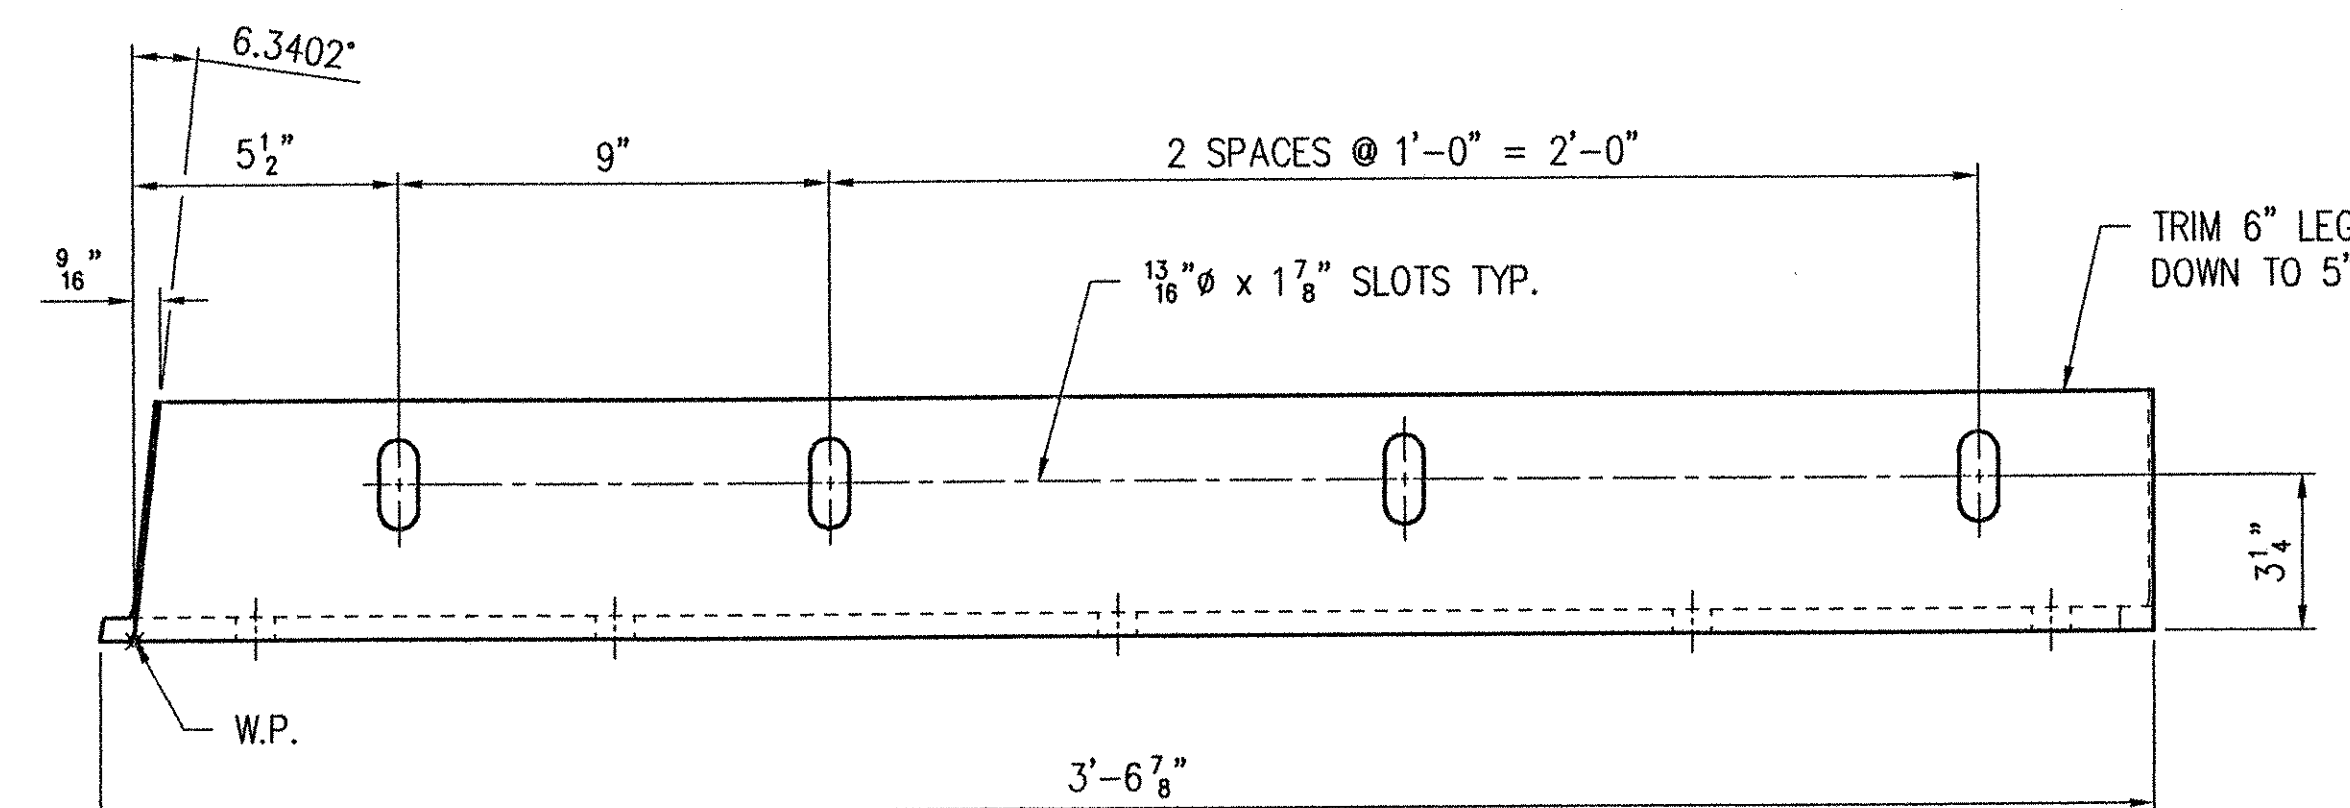
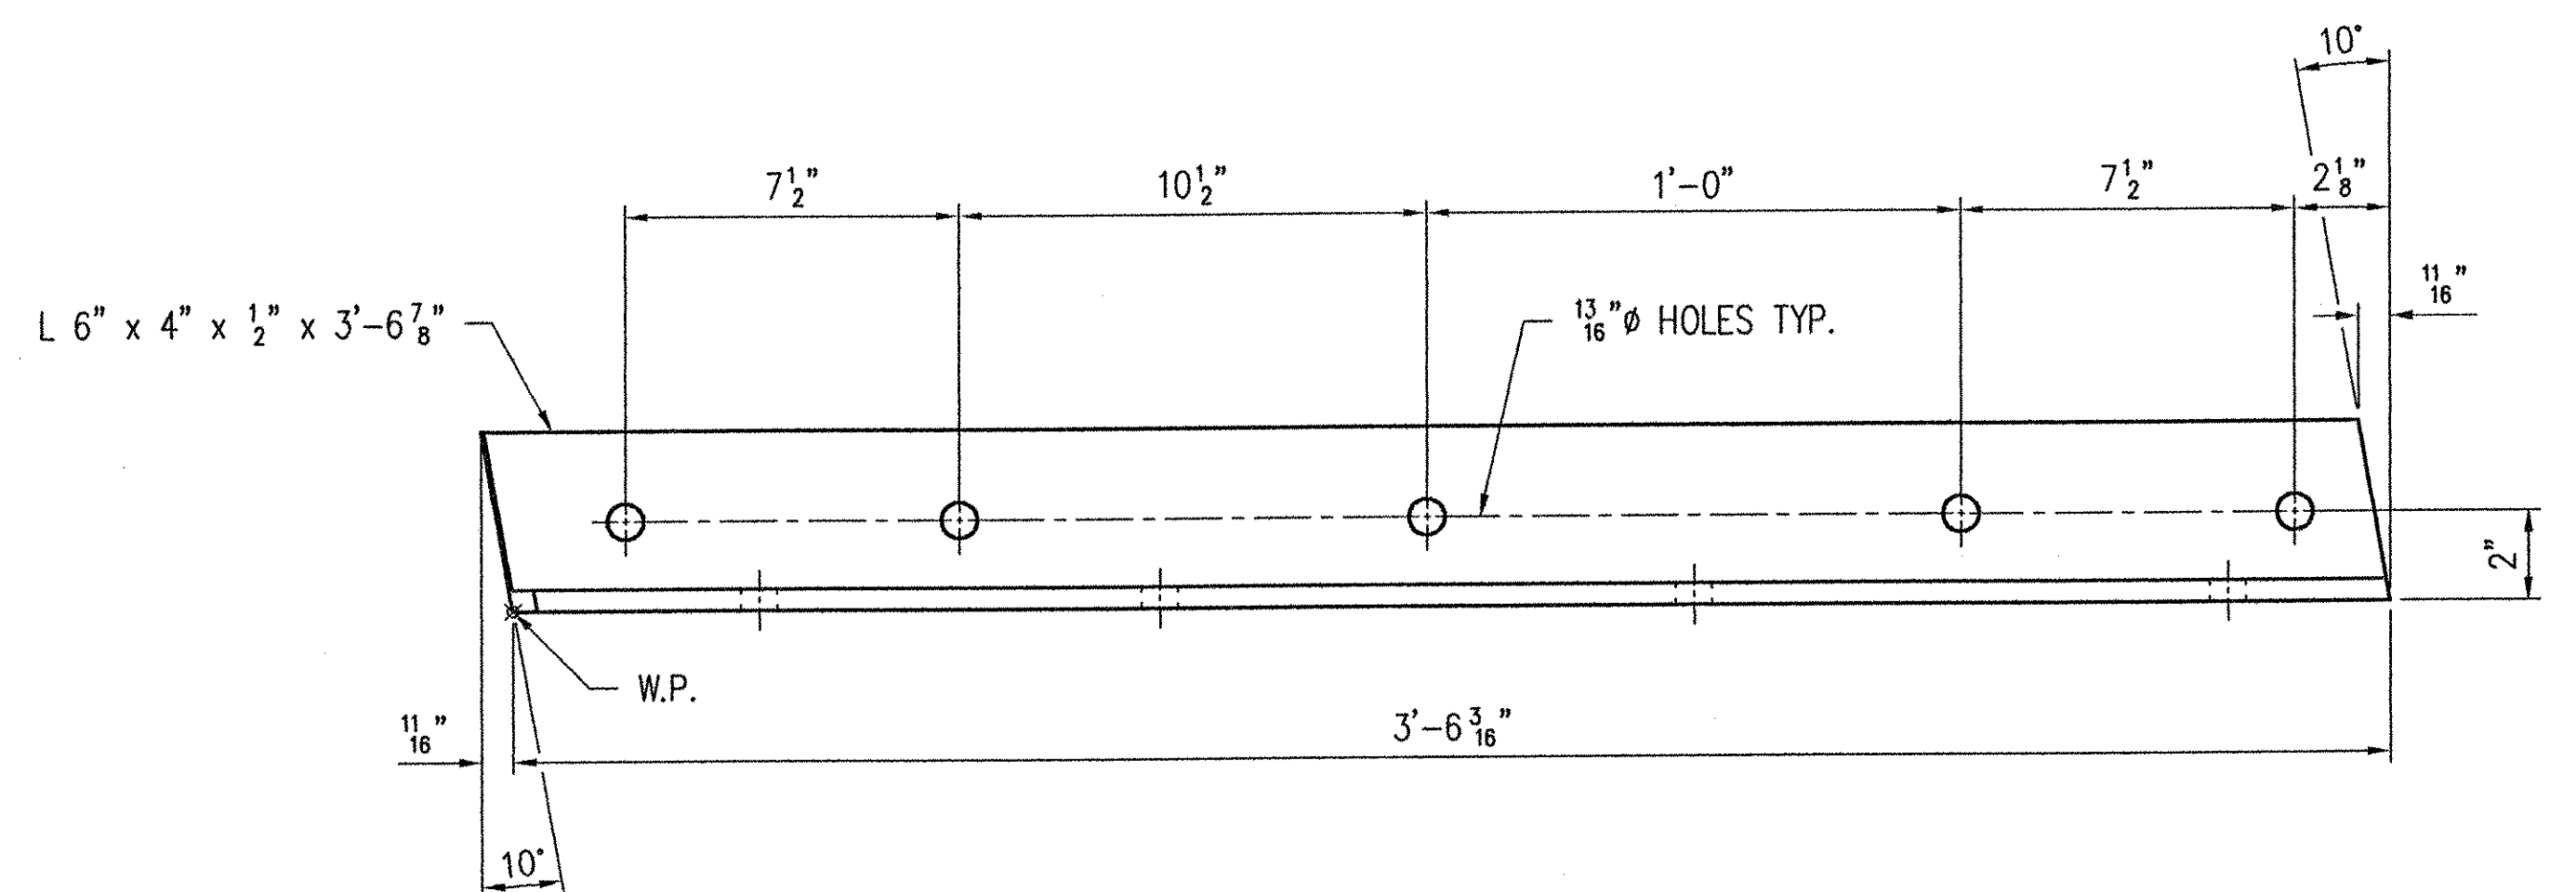
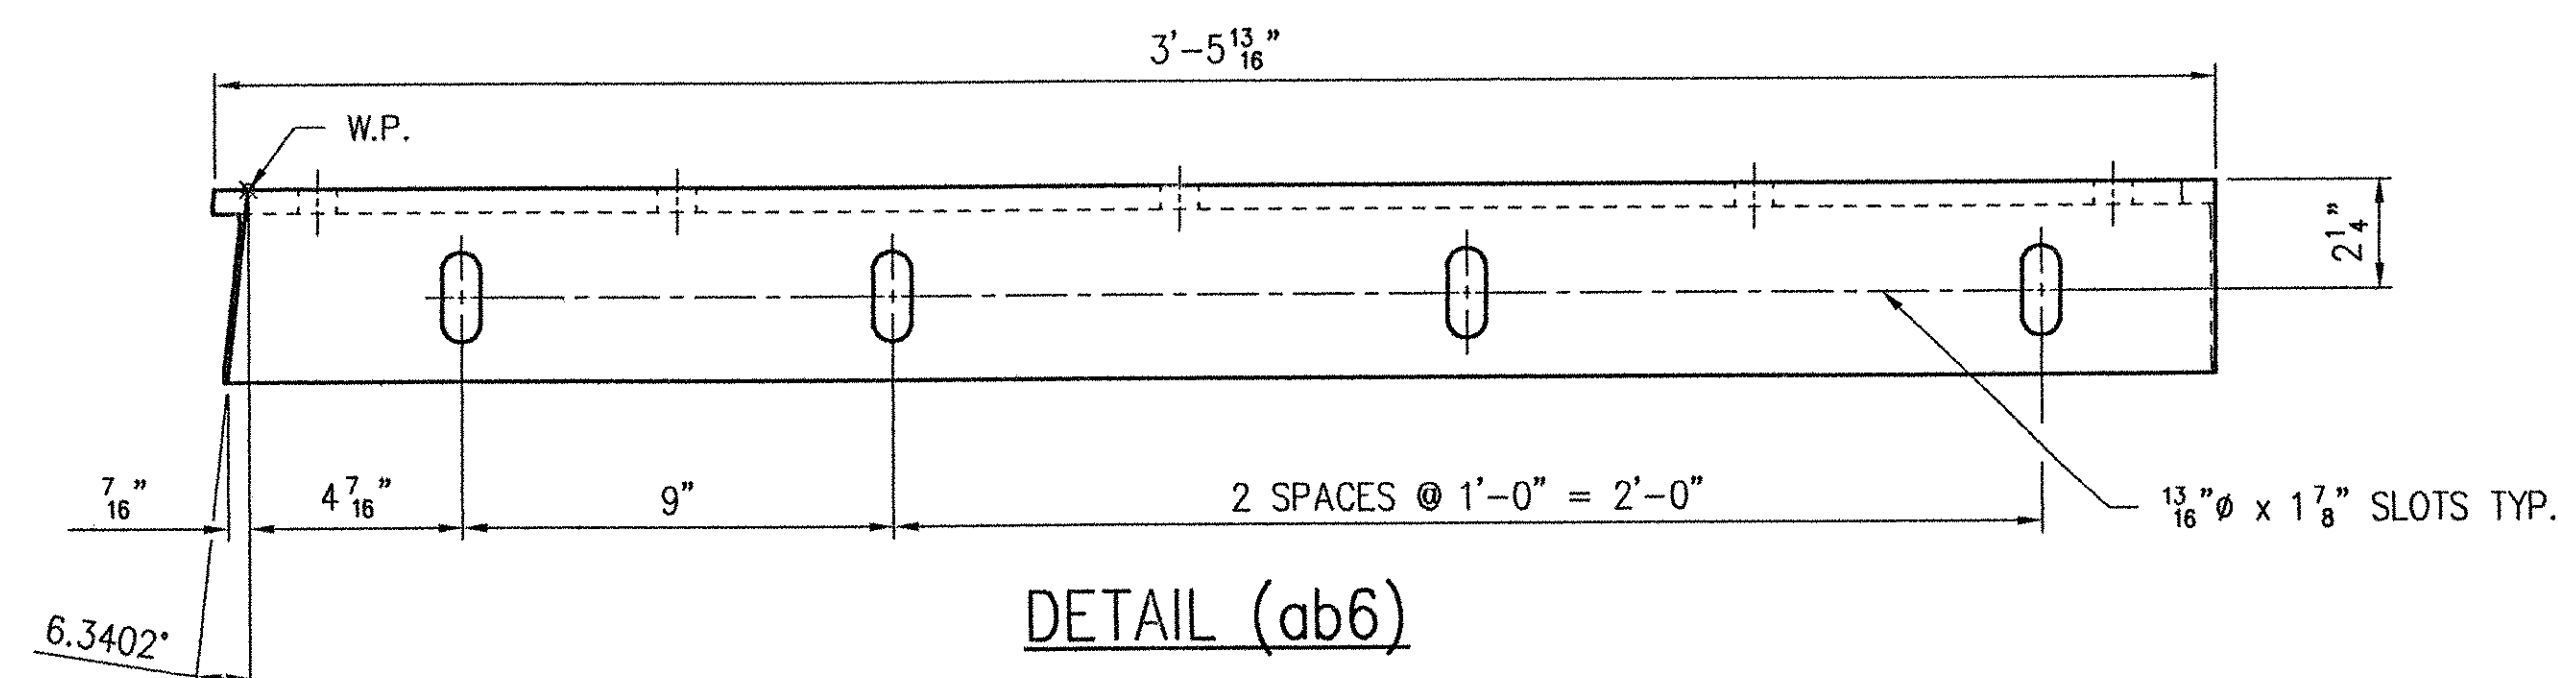
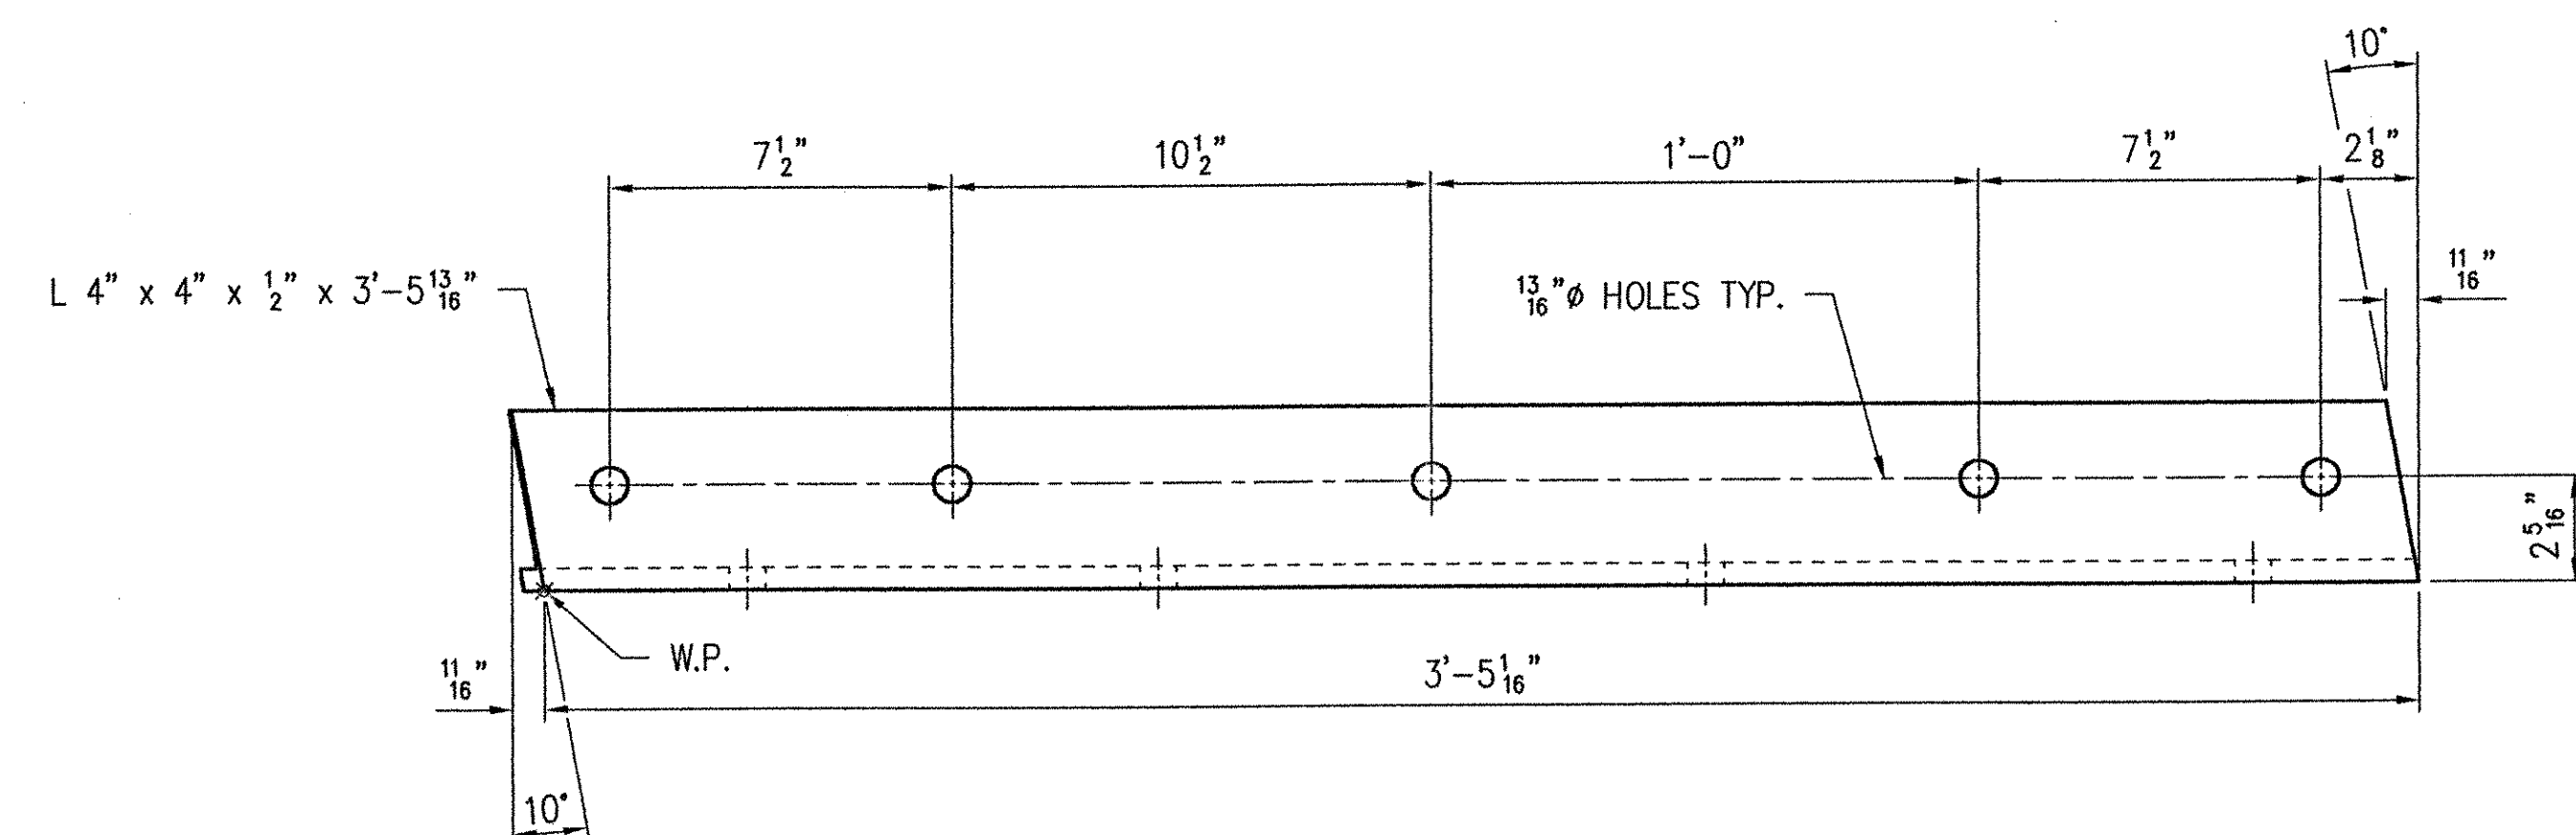
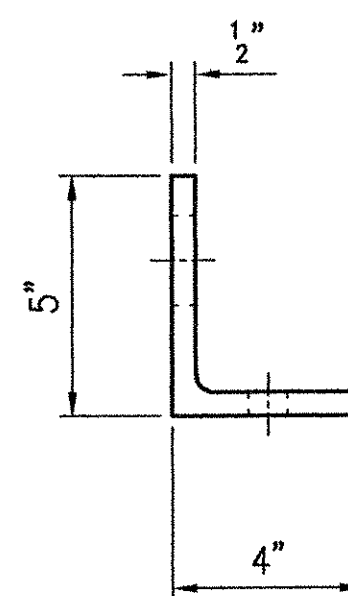


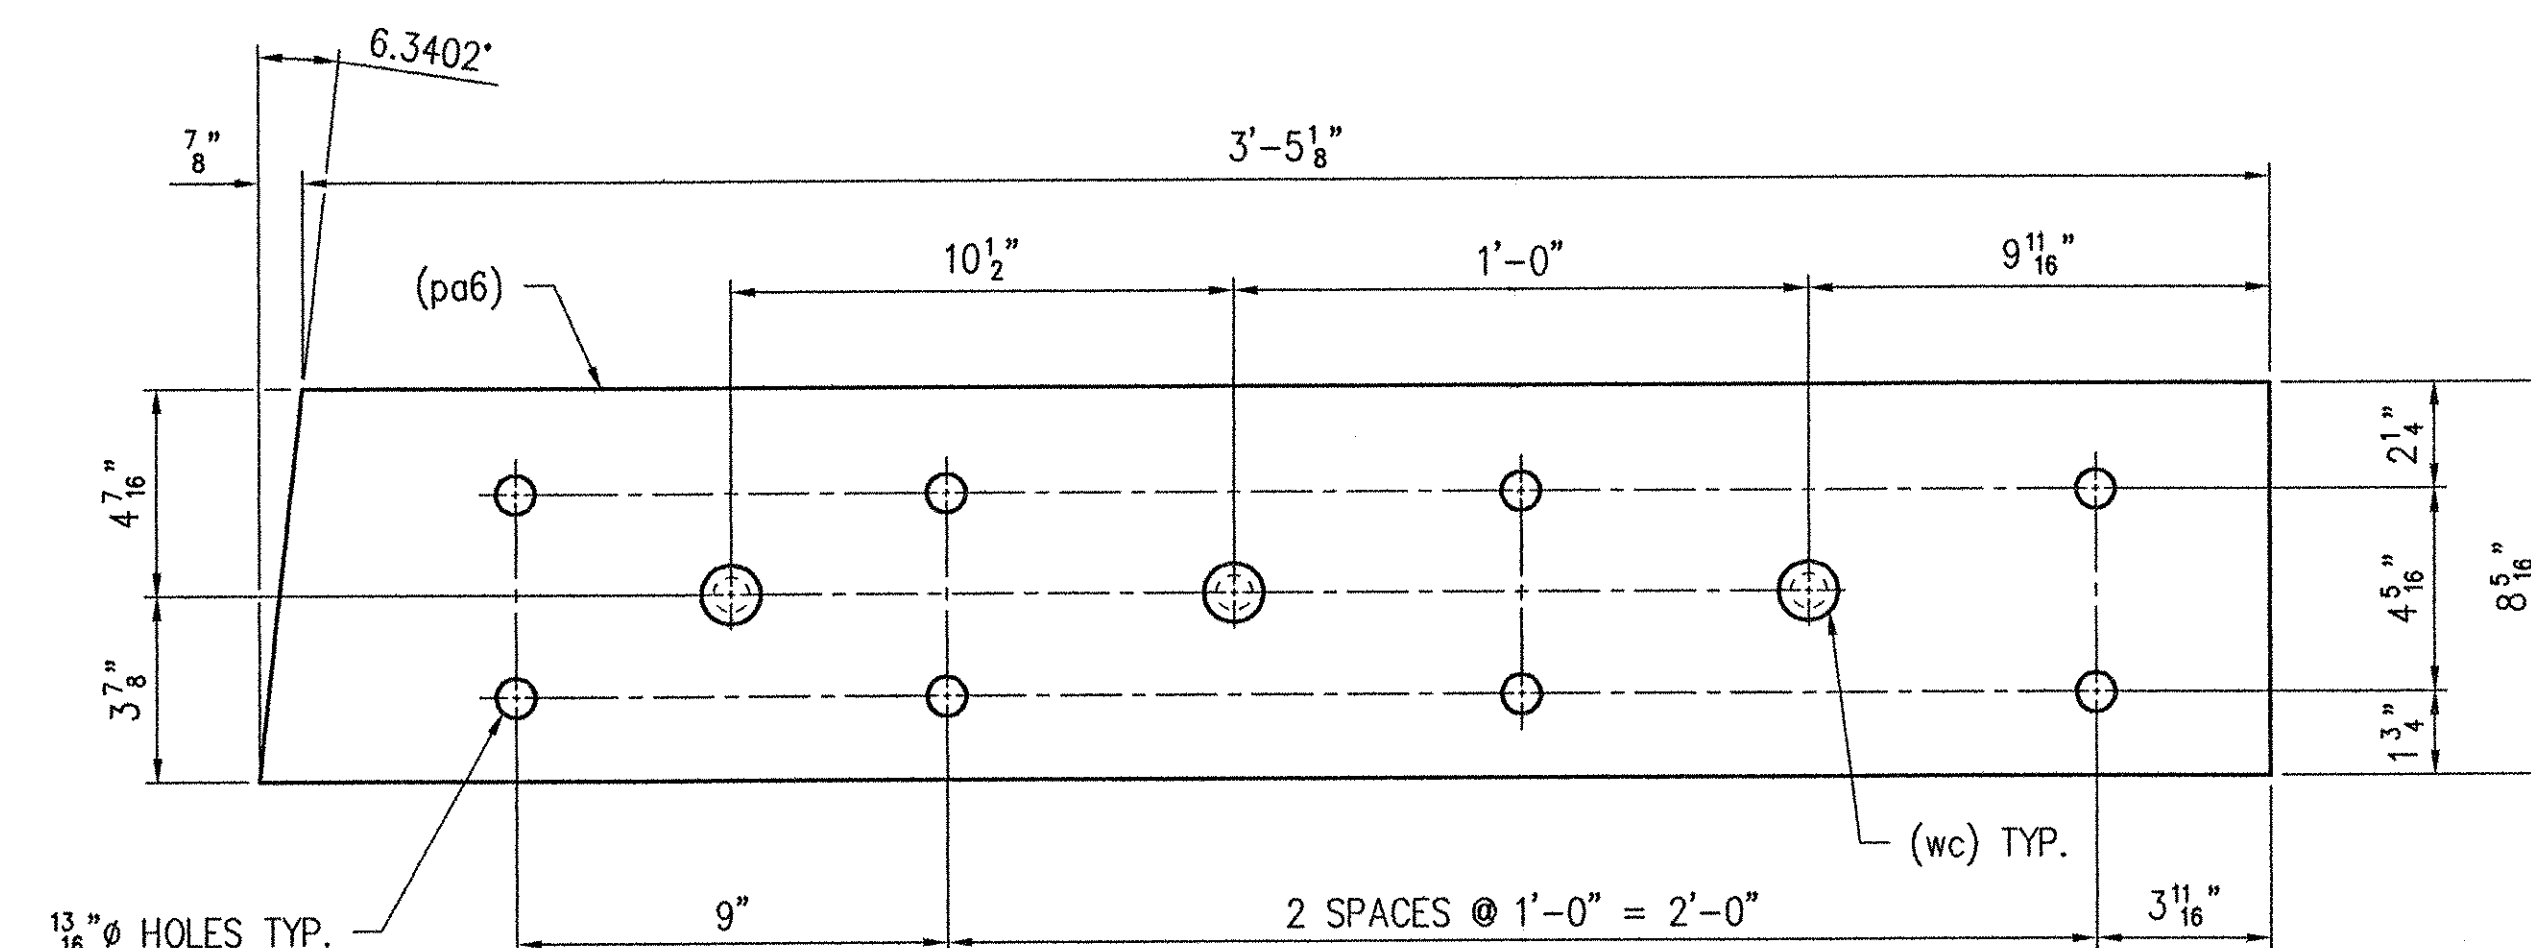

DETAIL (aa6)

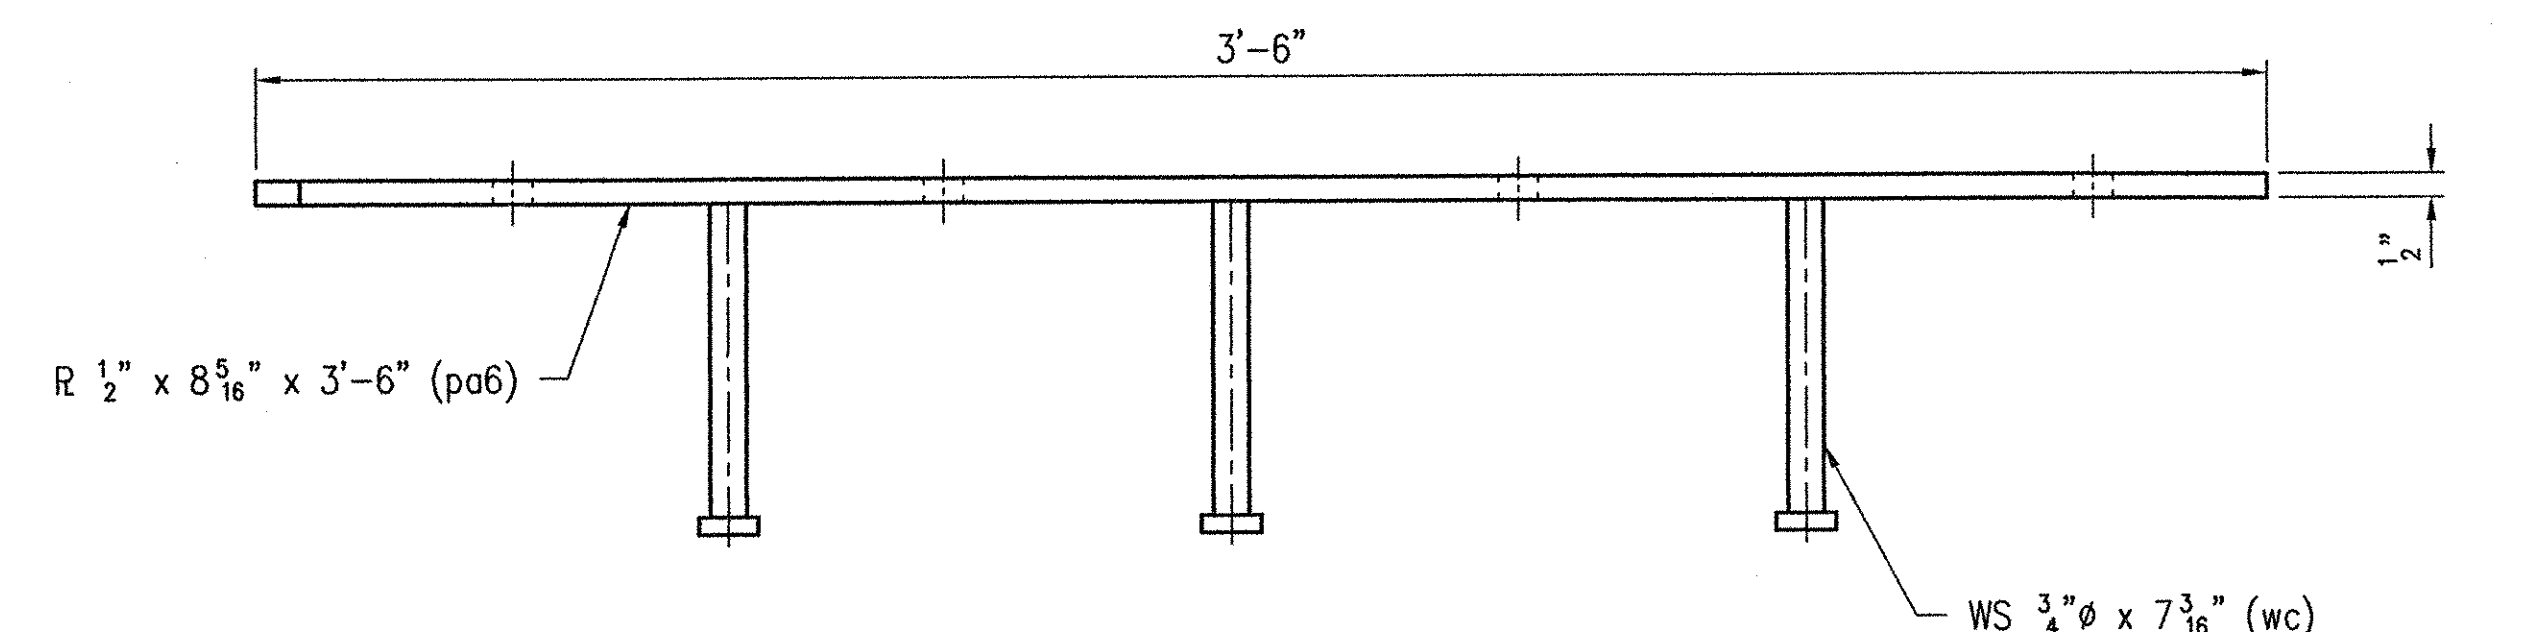

DETAIL (ab6)

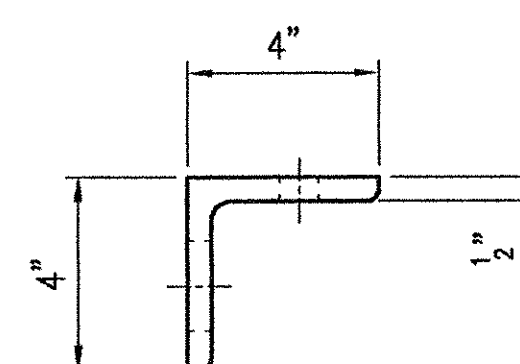

1 - SUB-ASSEMBLY - 6A

SEE SHEET NO. 15 FOR GENERAL NOTES.
WORK THIS SHEET WITH SHEET NO. 3, 4, 5 & 7.

RECEIVED
CHK'D BY 1065 OK'D BY _____
JAN 11 2002
RESUBMIT BY CPW APPROVED ✓ DATE 1/11/02

REV.	DESCRIPTION	DATE	INT.
	ANY AND ALL BACKCHARGES WILL BE REJECTED UNLESS WRITTEN CONSENT IS GIVEN BY LEWIS ENGINEERING COMPANY PRIOR TO ANY WORK PERFORMED FOR OUR ACCOUNT. SUCH REJECTION MEANS THAT INVOICES WILL NOT BE HONORED OR DEDUCTIONS FROM PAYMENT WILL BE CHARGED BACK.		
	 LEWIS ENGINEERING COMPANY 4201 NOREX DRIVE - CHASKA, MINNESOTA 55318 - (952) 368-3000		
	PROJECT	ROYALTON / RTE. NO. TH 1, CL 1 BRIDGE NO. 3	
	STATE PROJECT	AC BRZ 1444(22)	
	FEDERAL PROJECT	-	
	CUSTOMER	BECK & BELLUCCI, INC.	
	LOCATION	WINDSOR COUNTY, VT	
	DESCRIPTION	EXPANSION JOINT DETAILS	
		ABUTMENT NO. 2	
		W.P. chk'd Drawn By JMB Chk'd By TSF Date: 12/5/01	
	LE.C. 6 OF 30	SHEET NO. 6 OF 15	Job. No. : 2034.1042.1