
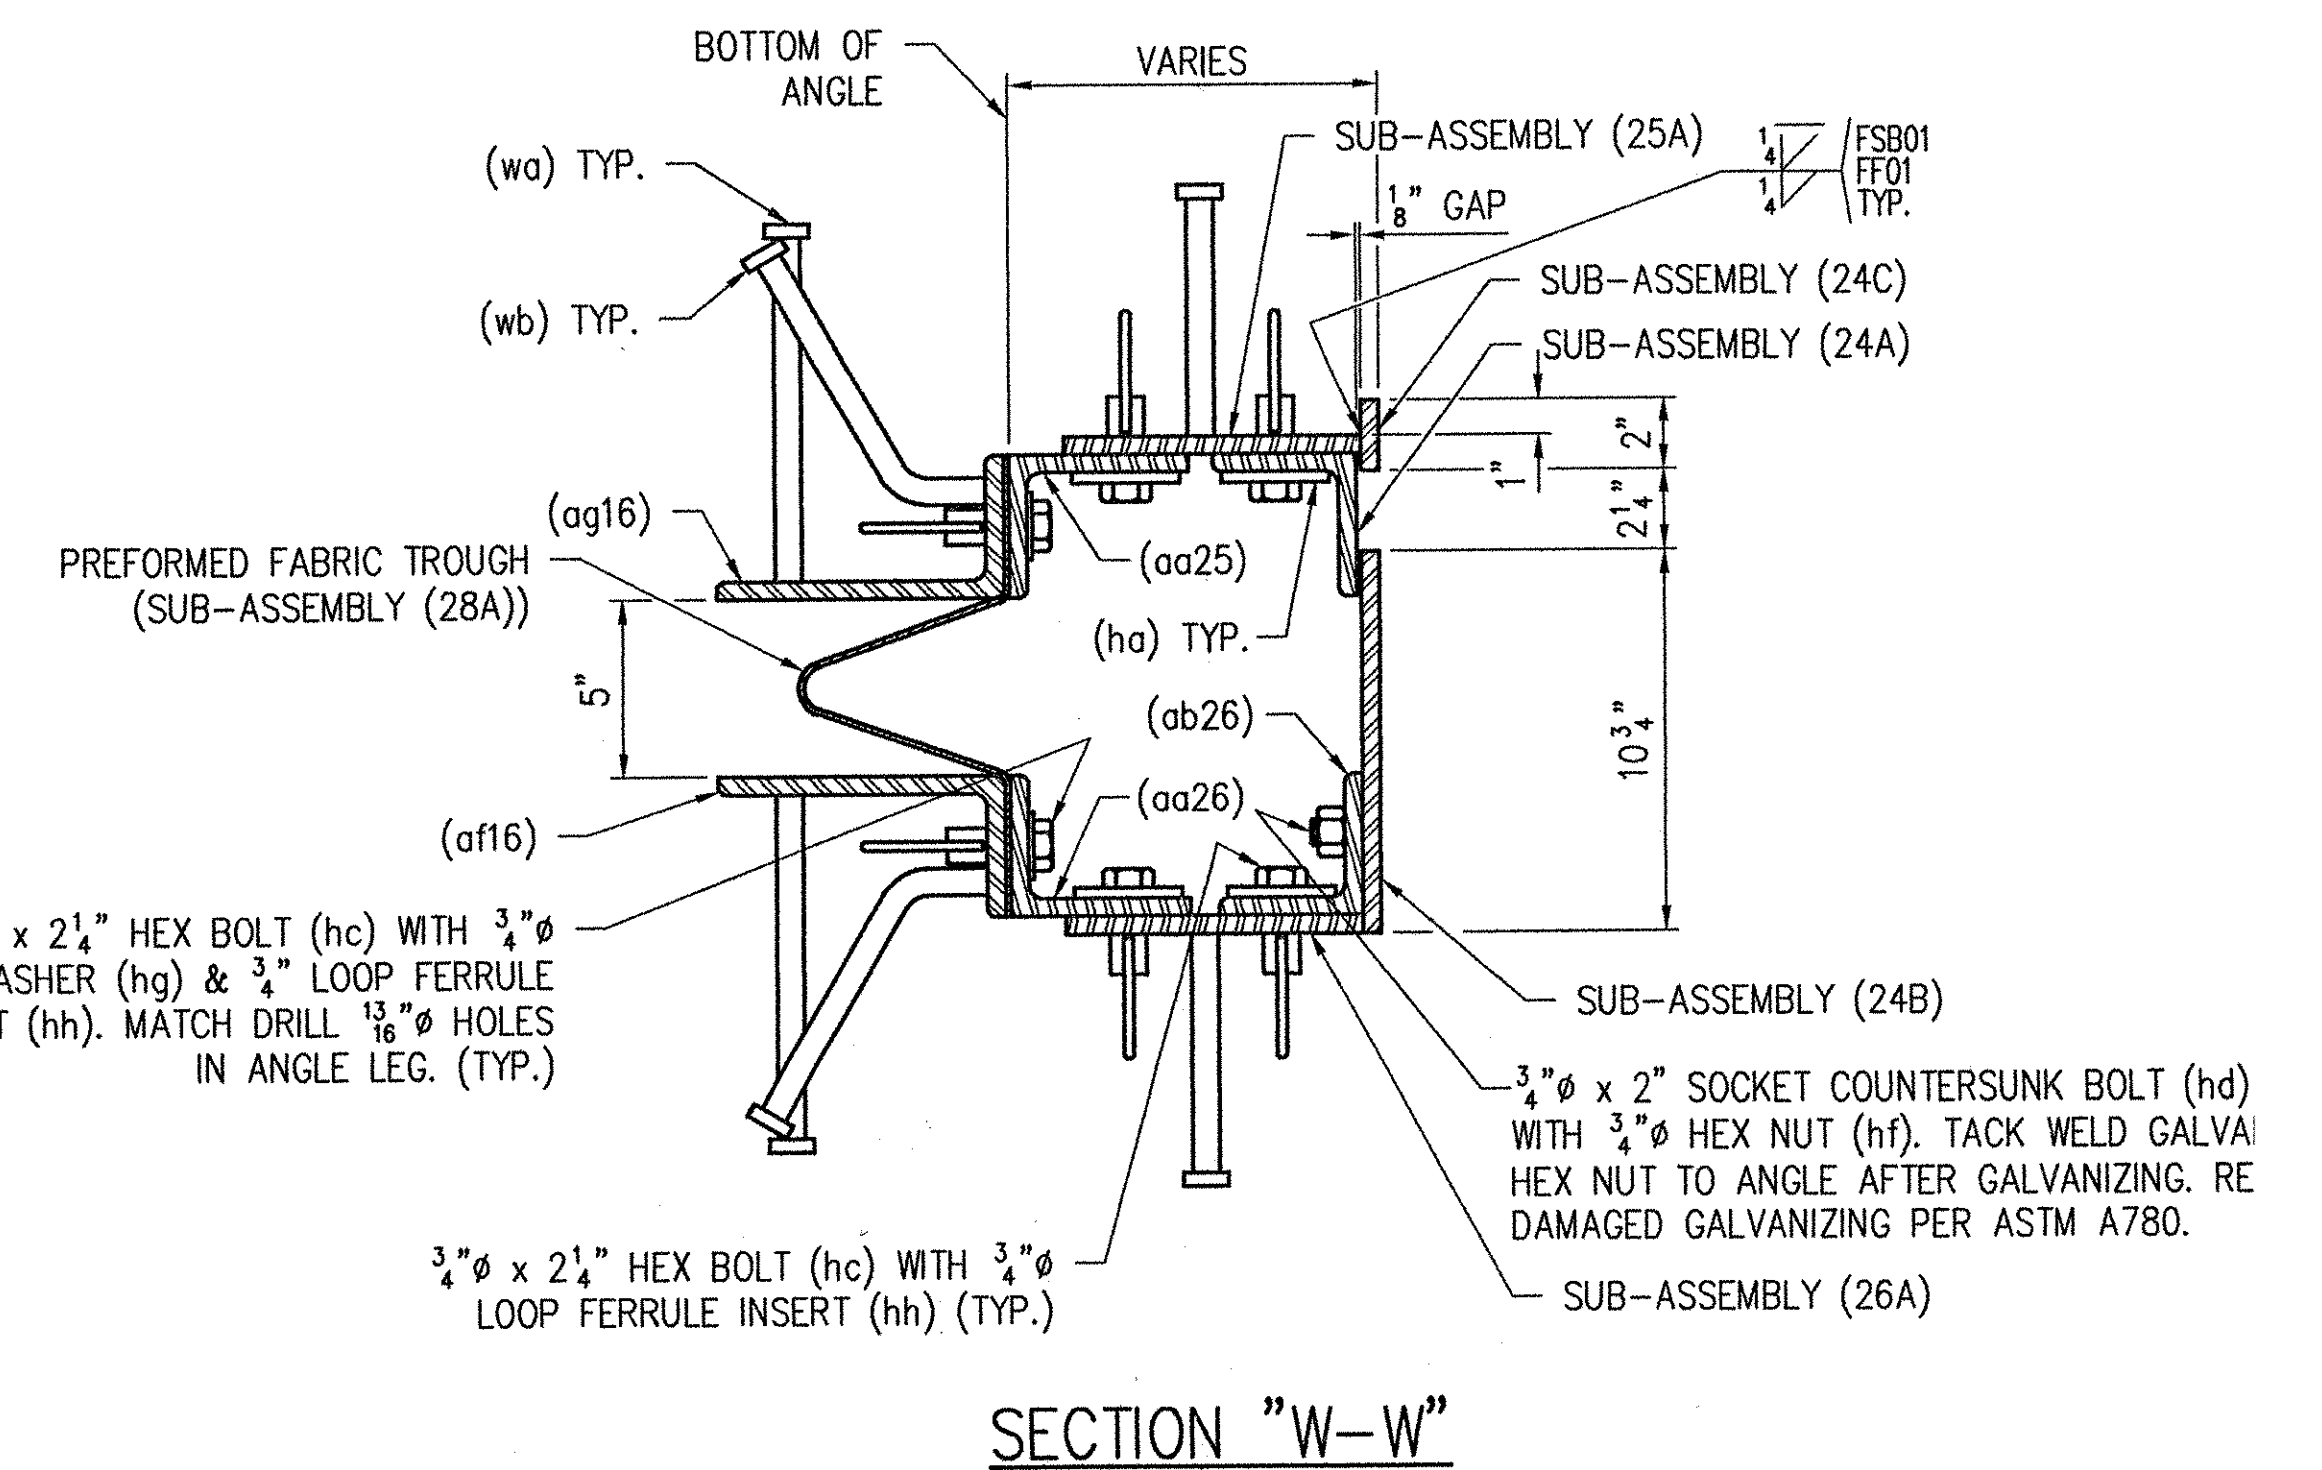
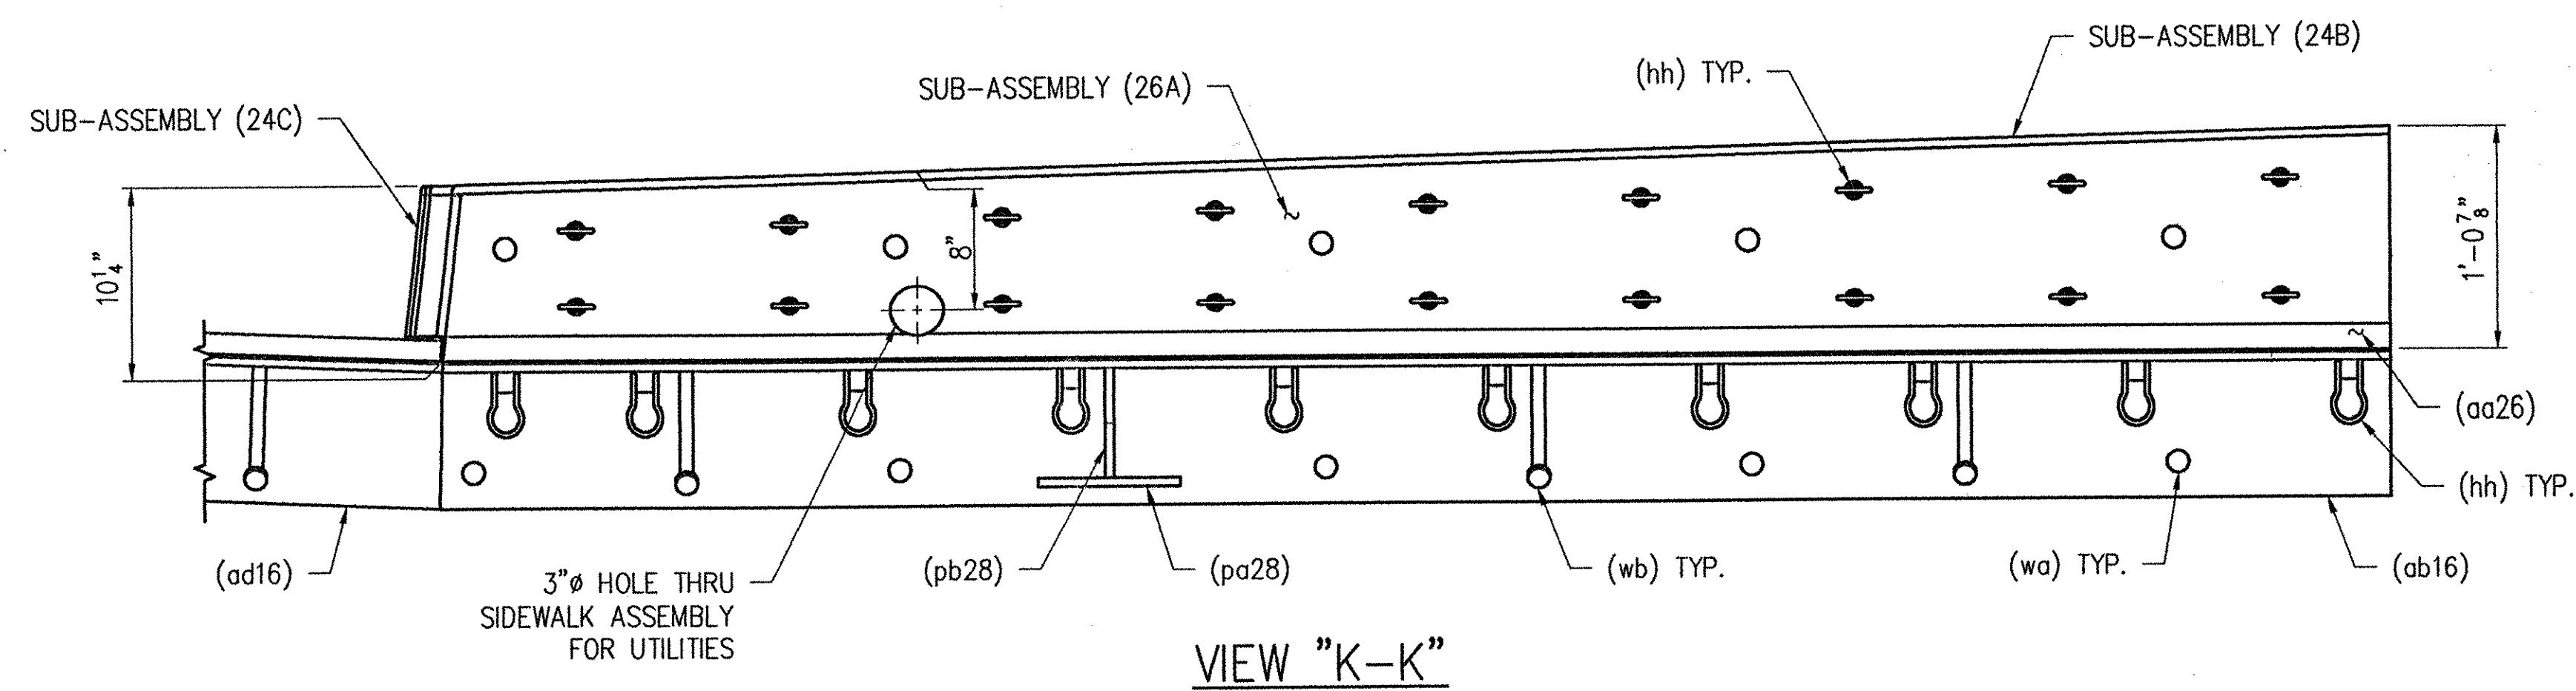
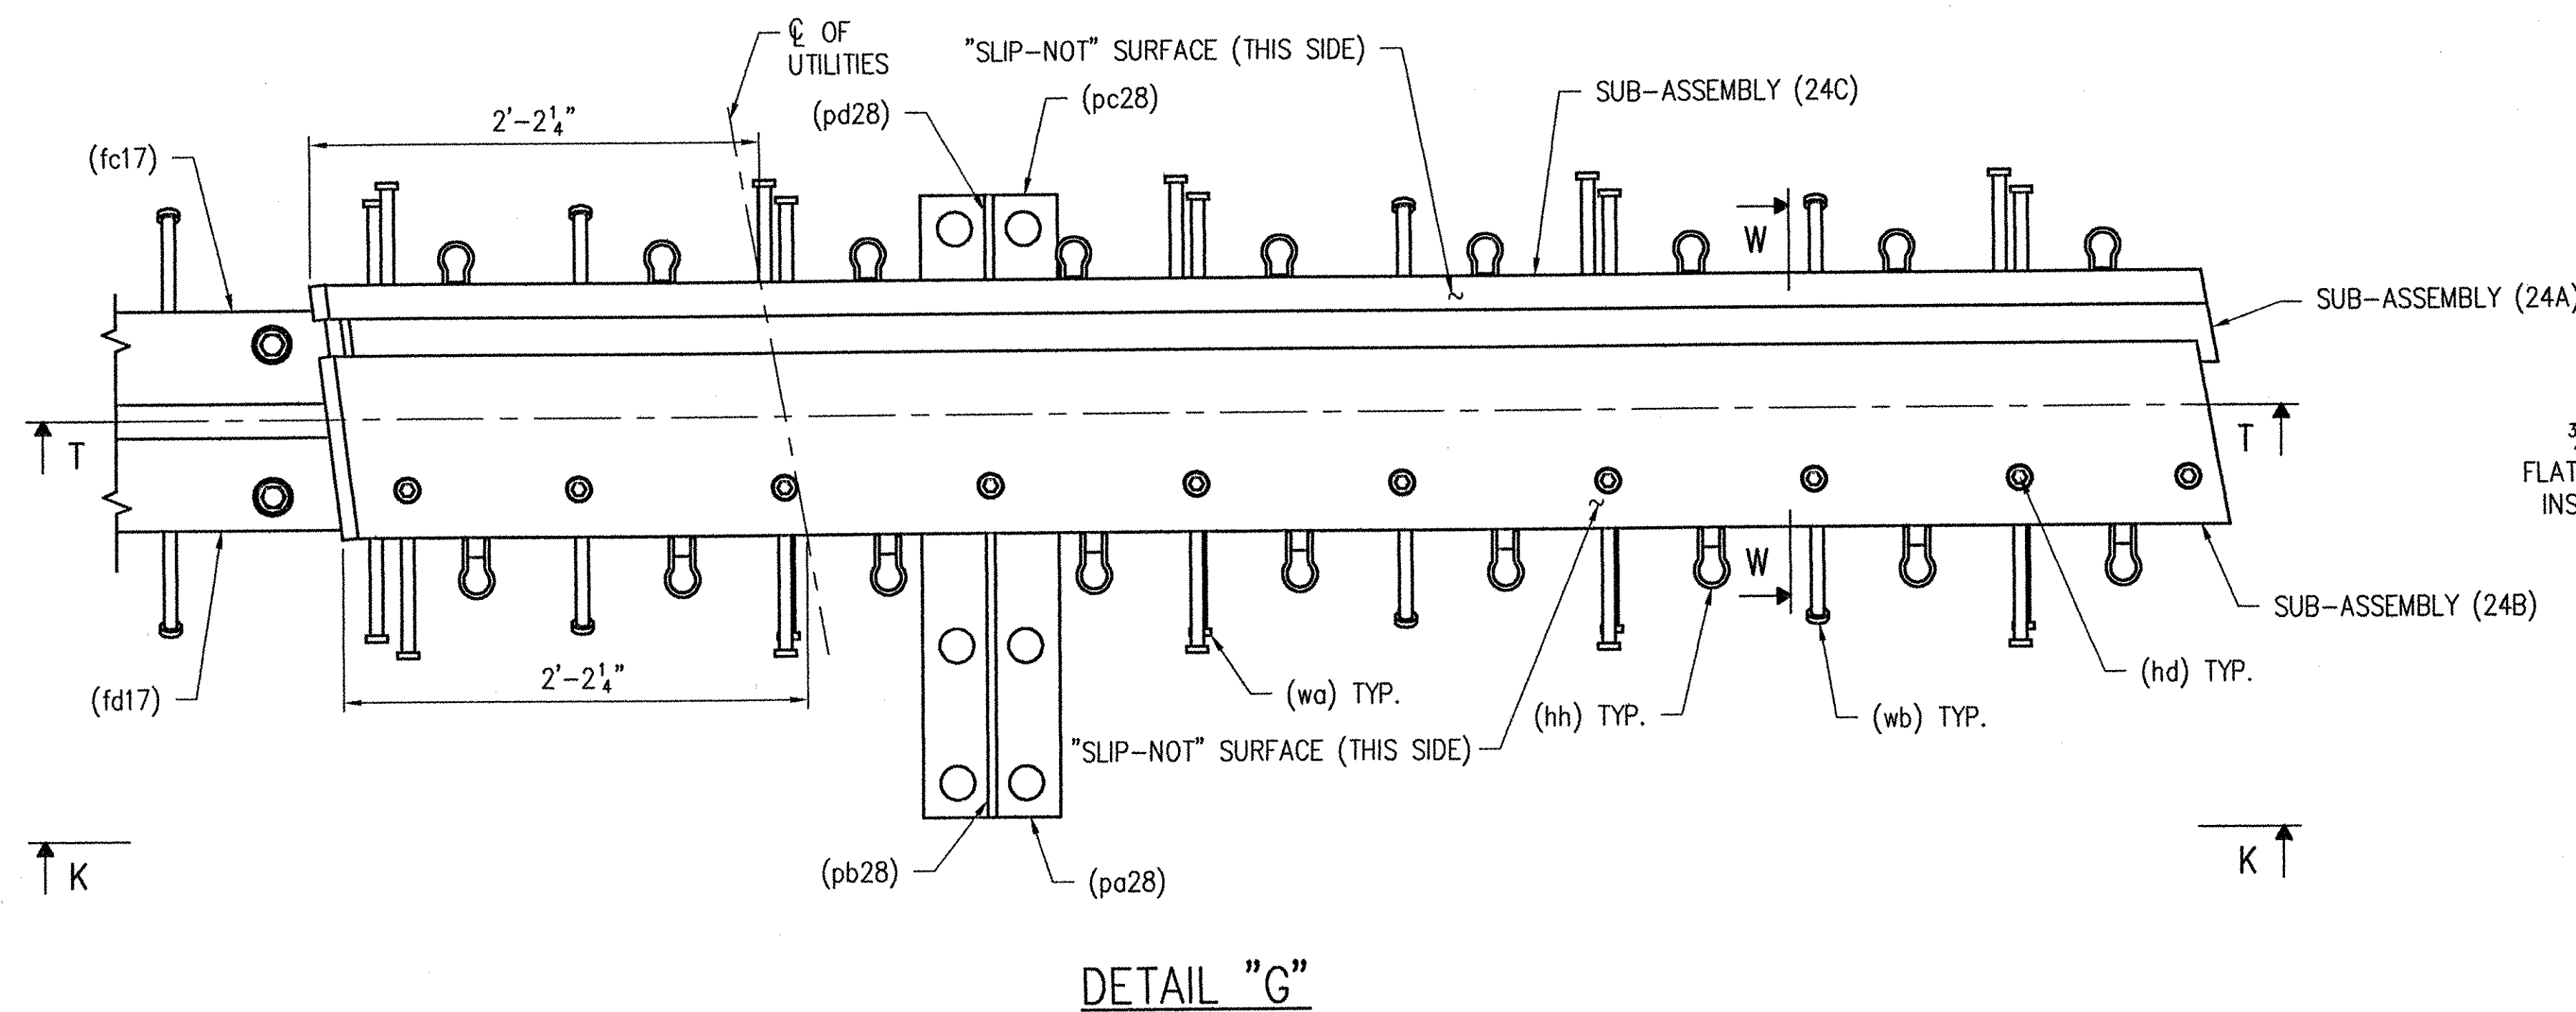


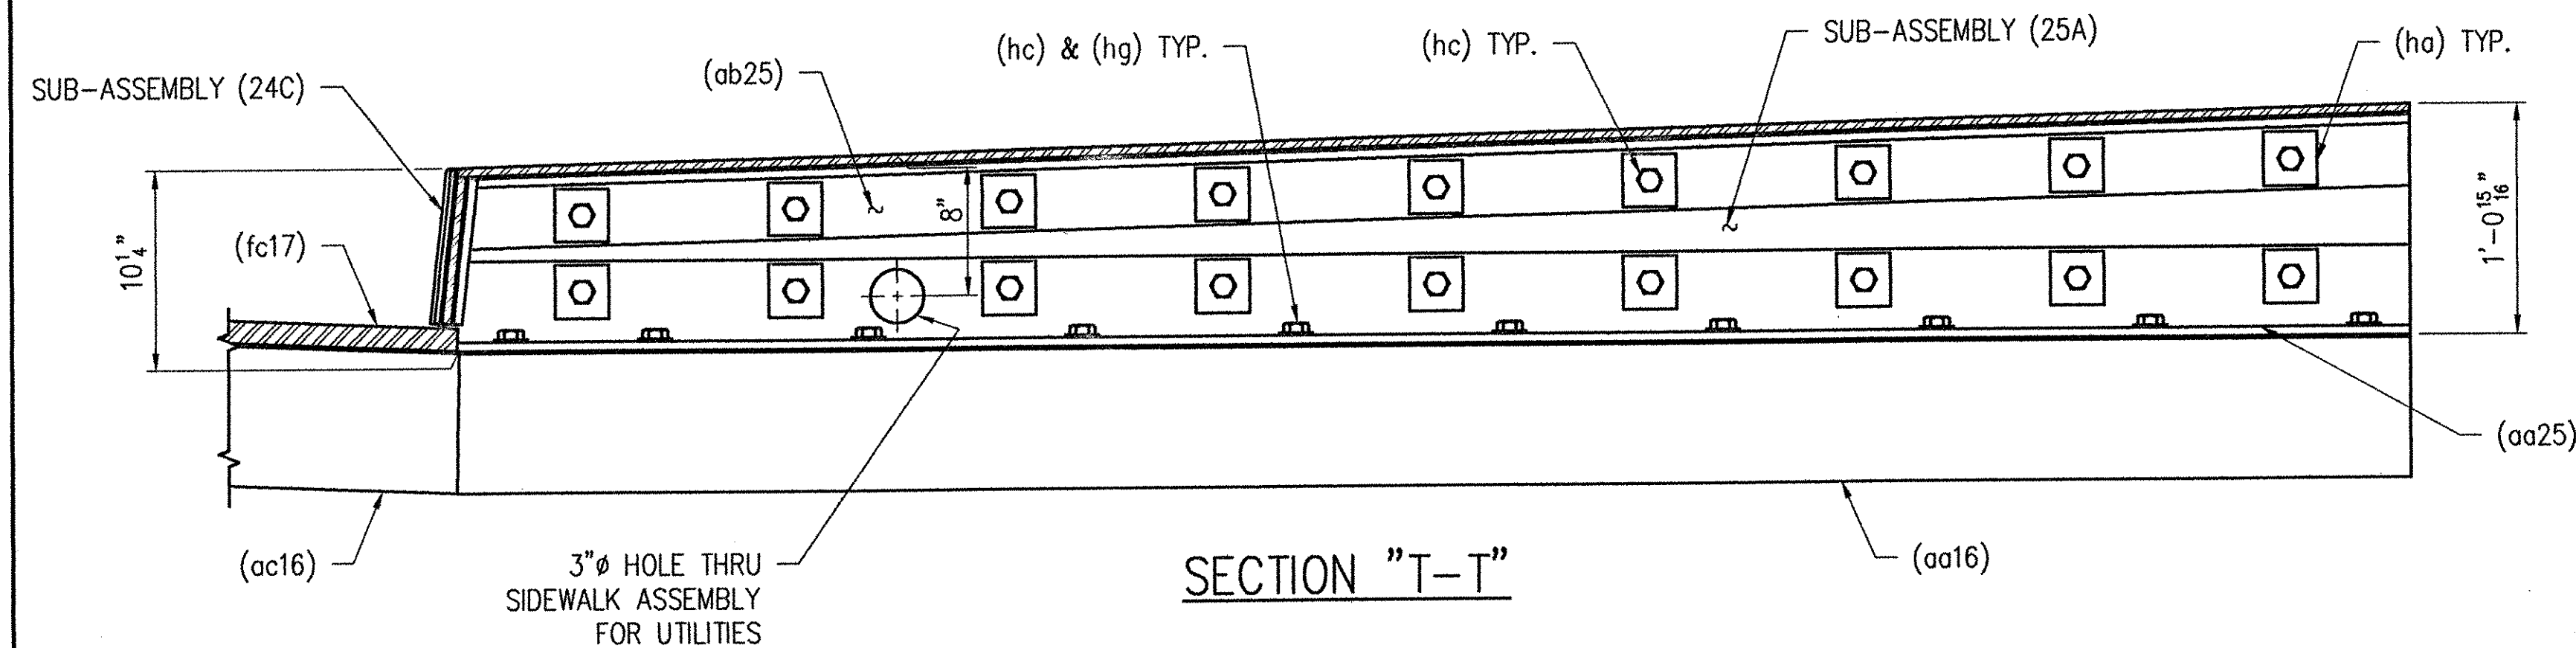

SEE SHEET NO. 30 FOR GENERAL NOTES.
WORK THIS SHEET WITH SHEET NO. 16, 24, 25, 26 & 27.

RECEIVED
CHK'D BY WBS OK'D BY _____
JAN 21 2002
RESUBMIT _____ APPROVED _____
BY OPW DATE 1/24/02

GENERAL REVISION PER APPROVAL		1/11/02
REV.	DESCRIPTION	DATE
ANY AND ALL BACKCHARGES WILL BE REJECTED UNLESS WRITTEN CONSENT IS GIVEN BY LE ENGINEERING COMPANY PRIOR TO ANY WORK PERFORMED FOR OUR ACCOUNT. SUCH REJECT MEANS THAT INVOICES WILL NOT BE HONORED OR DEDUCTIONS FROM PAYMENT WILL BE CHARGED B		
LEWIS ENGINEERING COMPANY 4201 NOREX DRIVE - CHASKA, MINNESOTA 55318 - (952) 368-3000		
SHOP	PROJECT — ROYALTON / RTE. NO. TH 1, CL 1 BRIDGE NO. 3	W.P. chkd Drawn By Chkd. By Date: 12/20
	STATE PROJECT — AC BRZ 1444(22)	
	FEDERAL PROJECT —	
APPROVAL	CUSTOMER — BECK & BELLUCCI, INC.	
	LOCATION — WINDSOR COUNTY, VT	
DIST.	DESCRIPTION — EXPANSION JOINT DETAILS	Job. No. : 2034.10
CUST.	ABUTMENT NO. 1	
FOR	DATE	
PRINTS ISSUED	L.E.C. 23 OF 30	SHEET NO. 8 OF 15