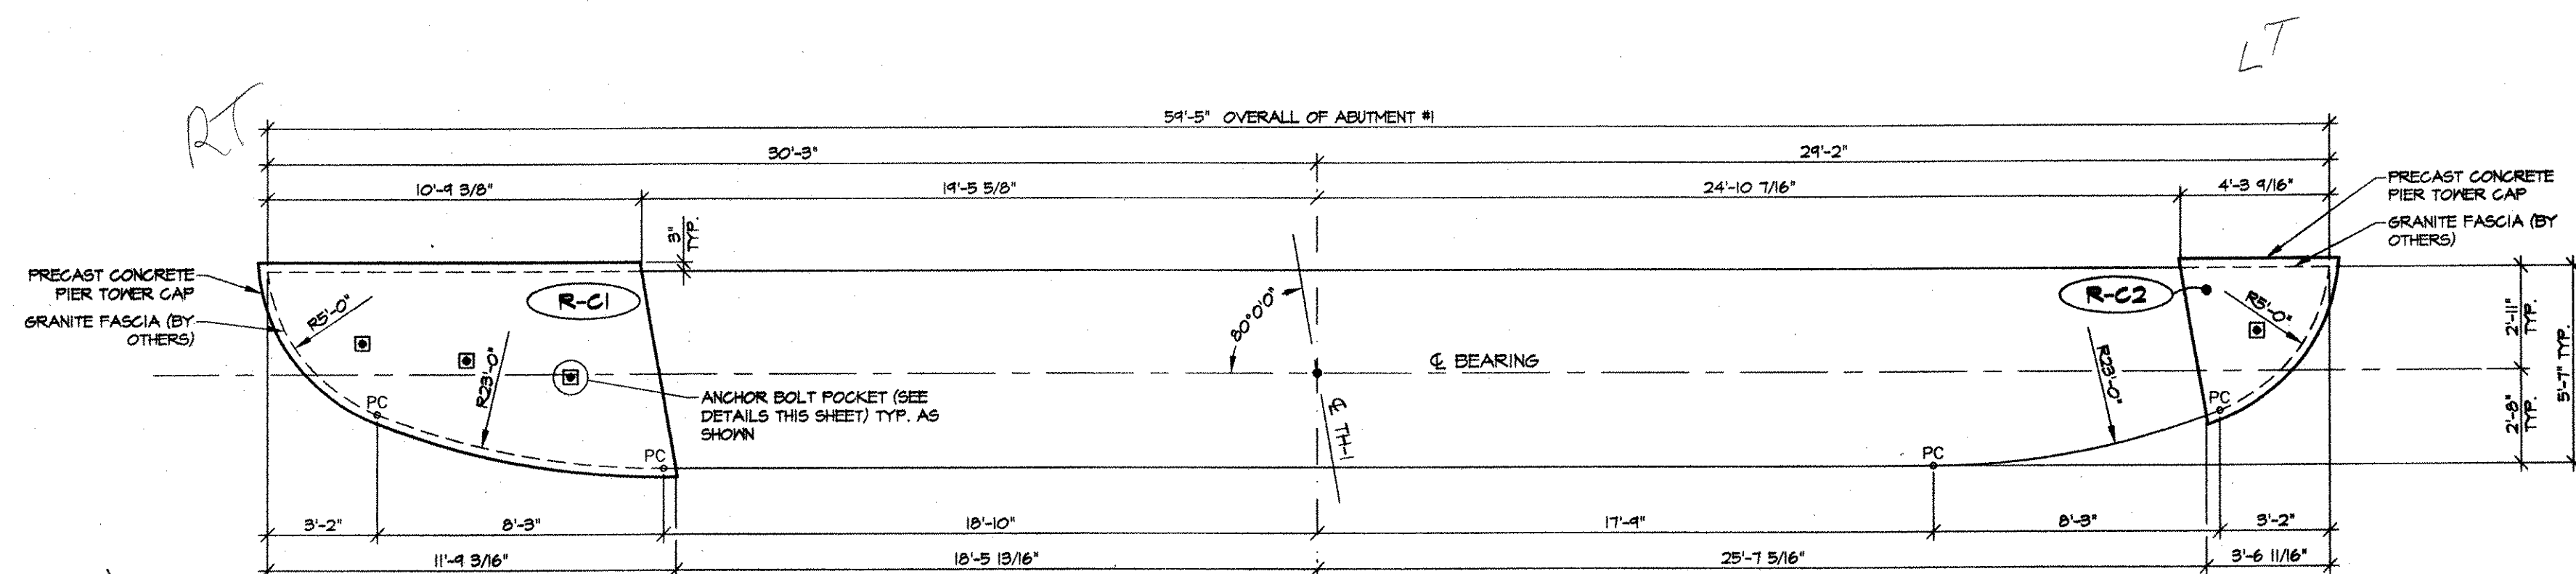
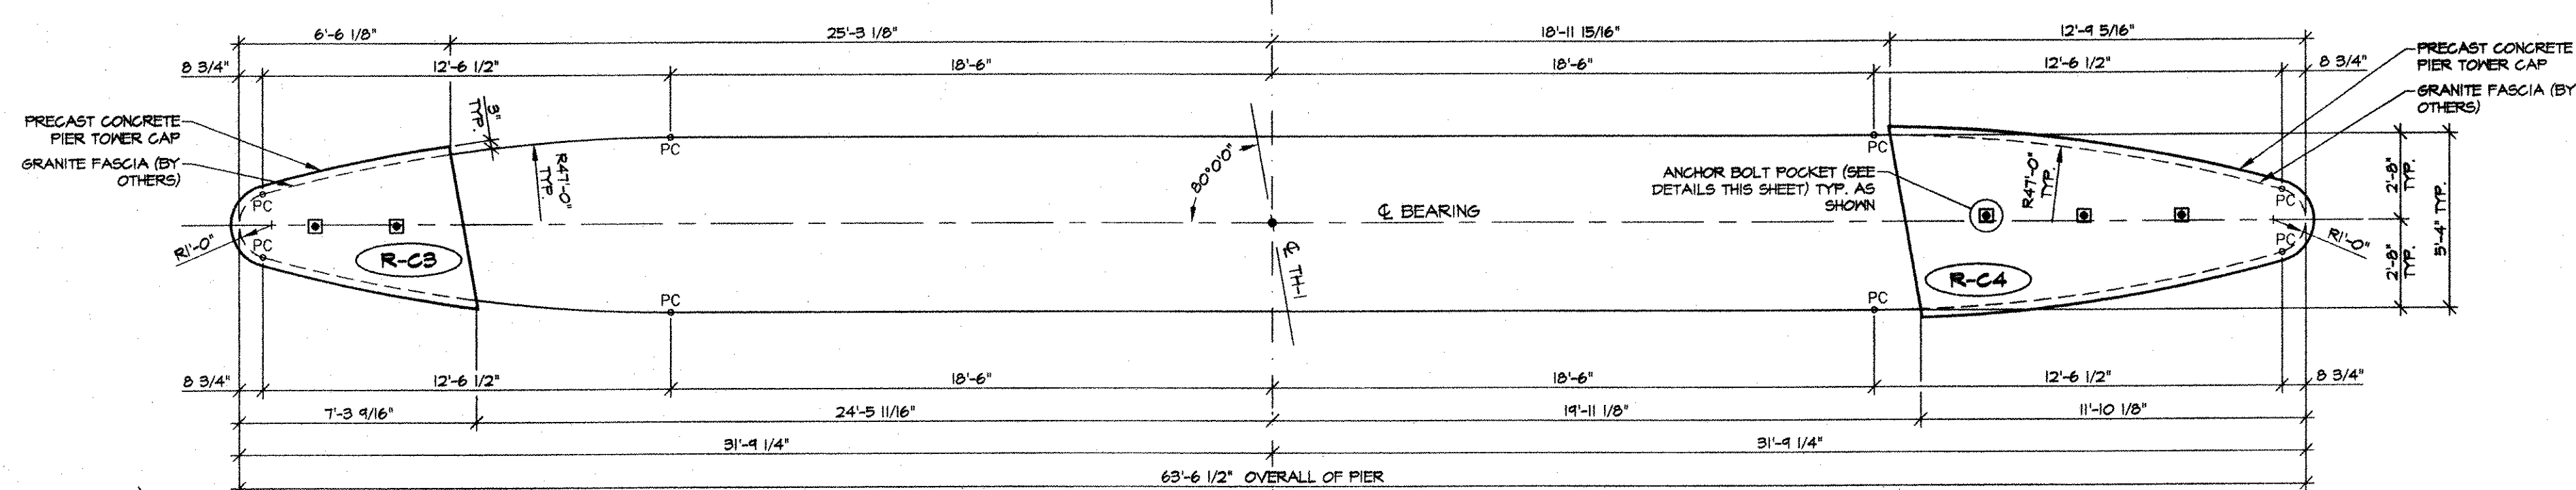
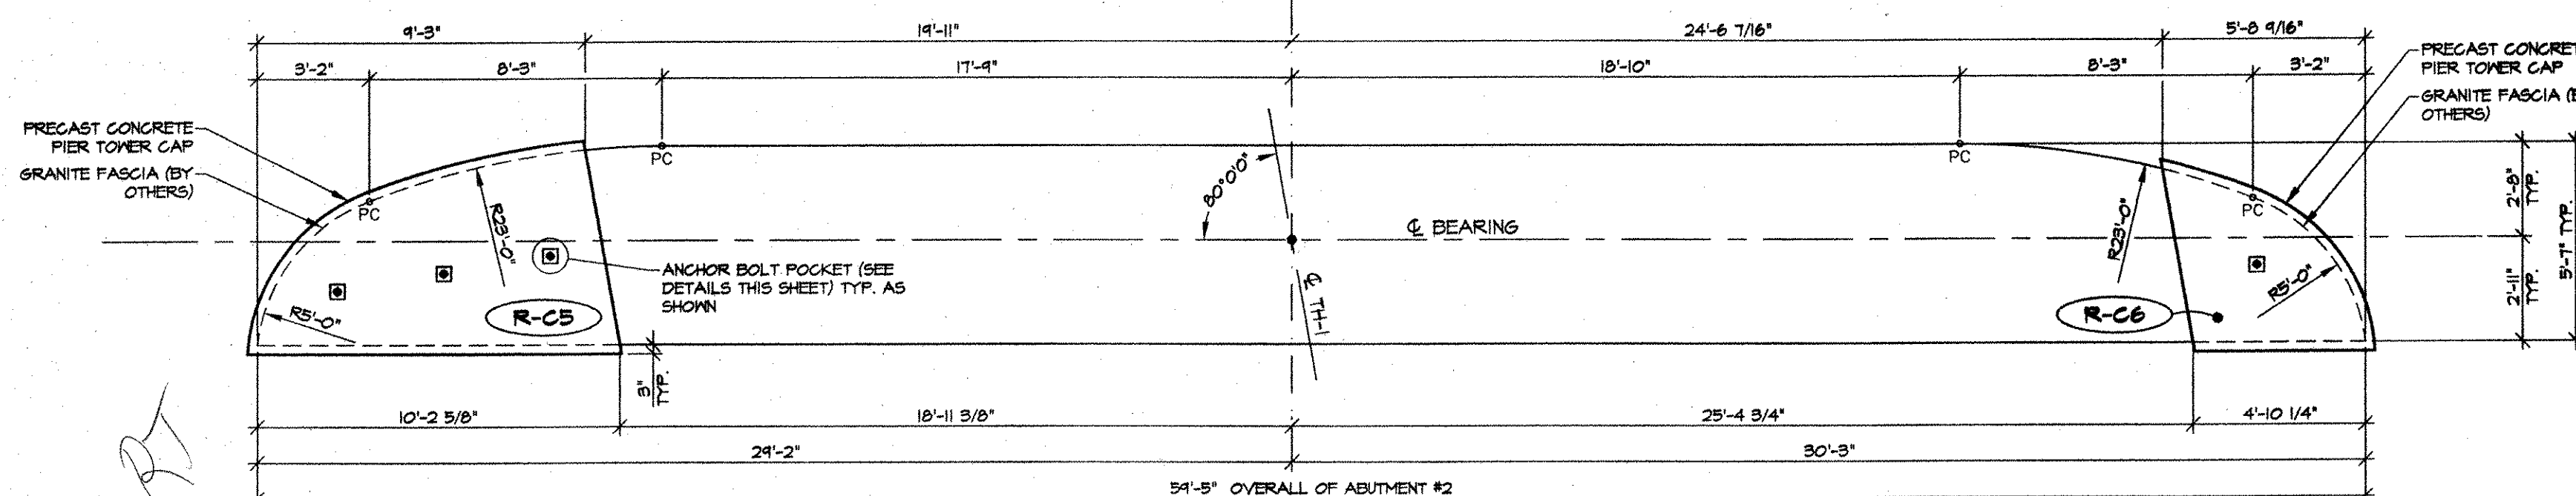






1 PIER TOWER CAP PLAN - ABUTMENT #1  
1/4" = 1'-0"





2 PIER TOWER CAP PLAN - PIER  
1/4" = 1'-0"



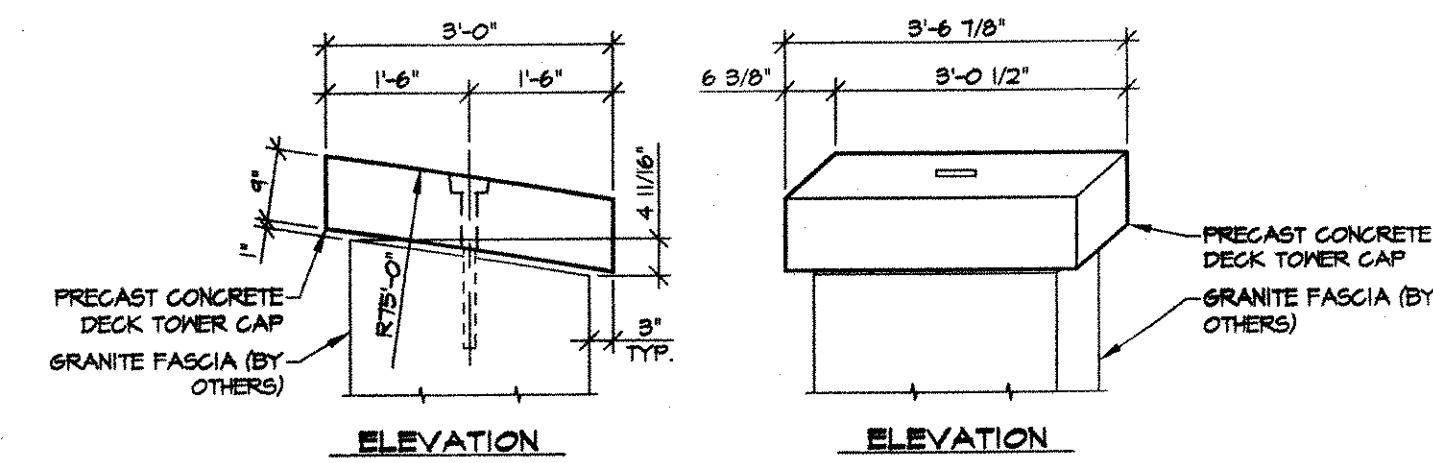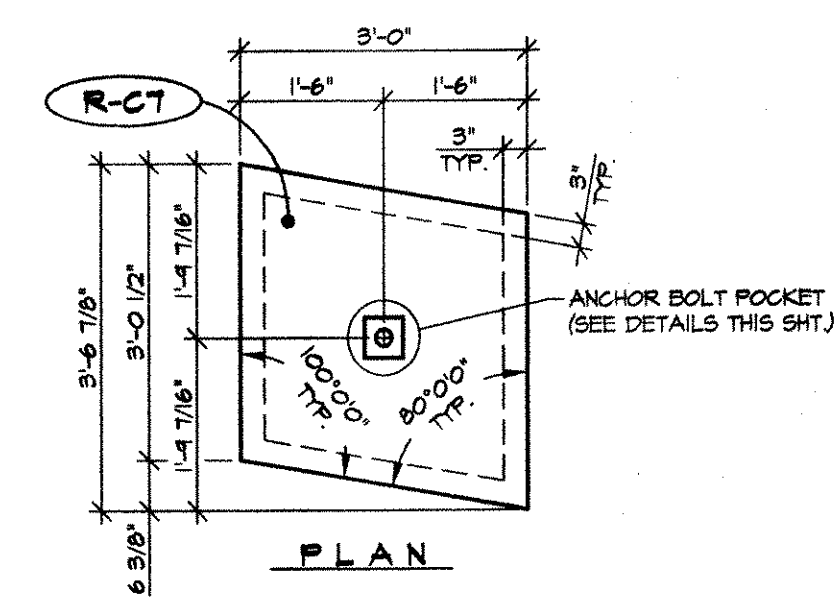3 PIER TOWER CAP PLAN - ABUTMENT #2  
1/4" = 1'-0"



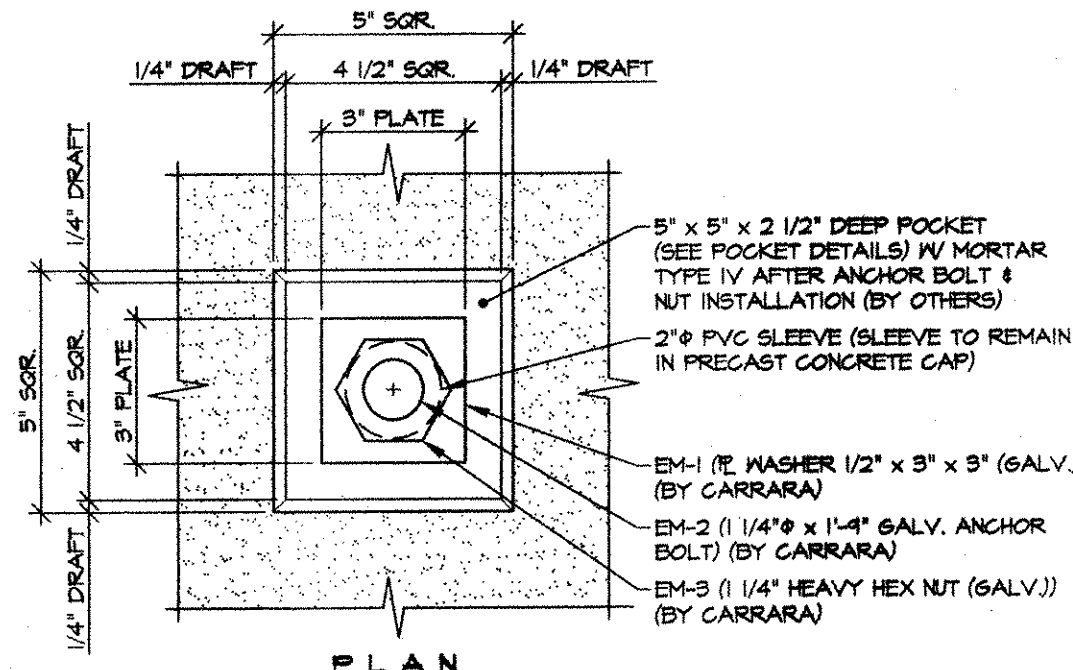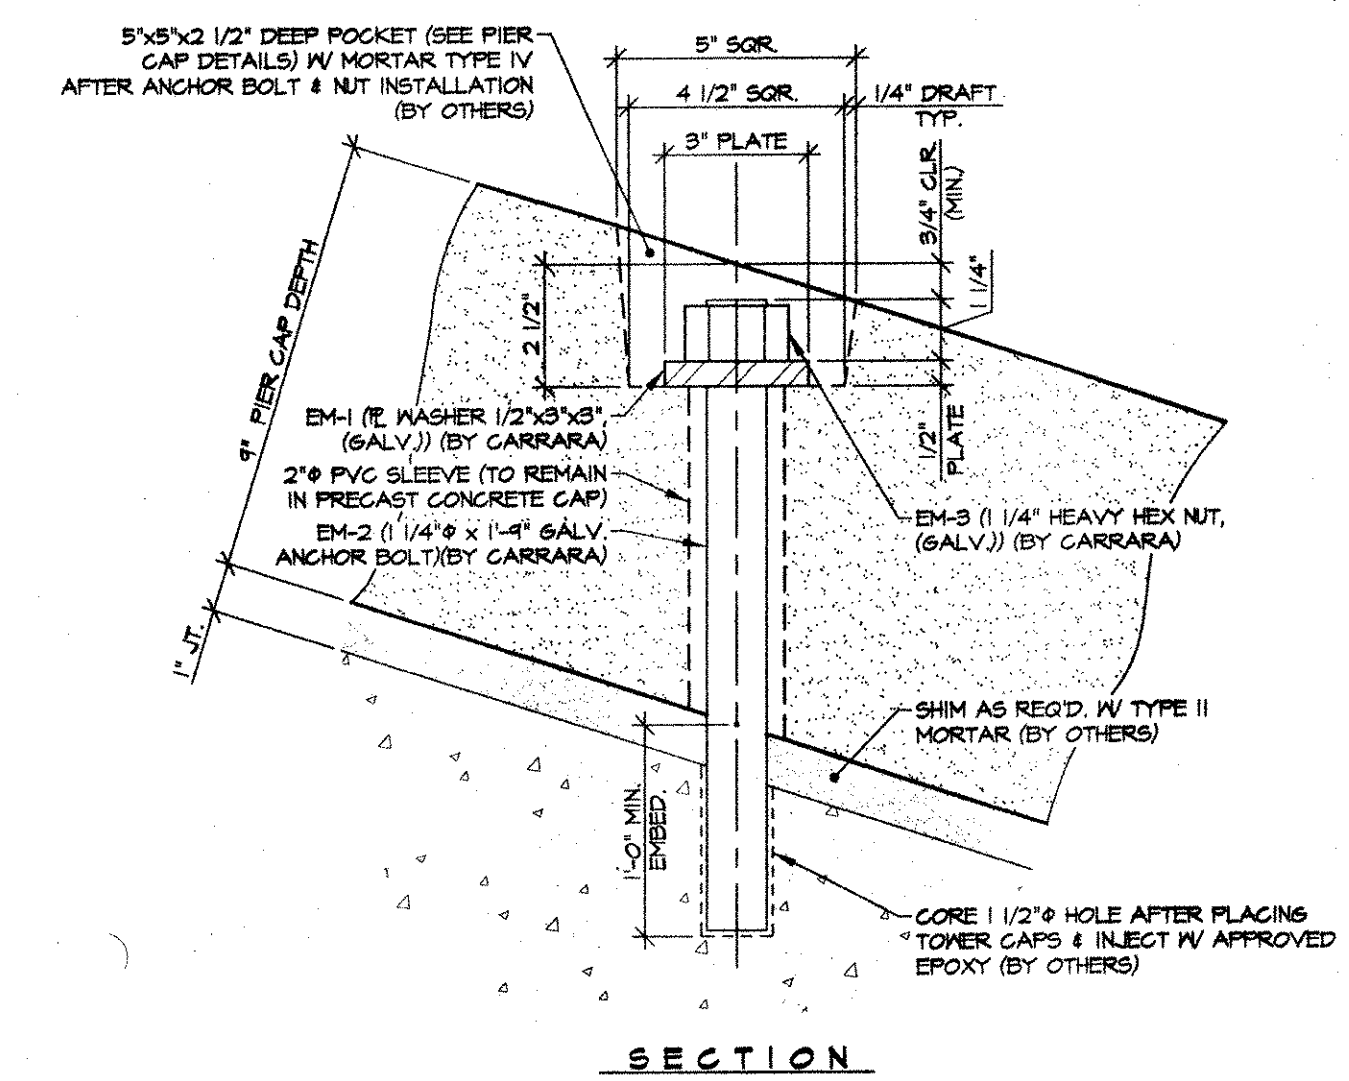4 DECK TOWER CAP  
(AT 6) LOCATIONS 1/2" = 1'-0"



ANCHOR BOLT INSTALLATION DETAIL  
3" = 1'-0"

RECEIVED  
OK'D BY WES OK'D BY \_\_\_\_\_  
APR 26 2001  
RESUBMIT \_\_\_\_\_ APPROVED ✓  
BY CPW DATE 5/2/01

| |
|---|
| |</ |
|---|