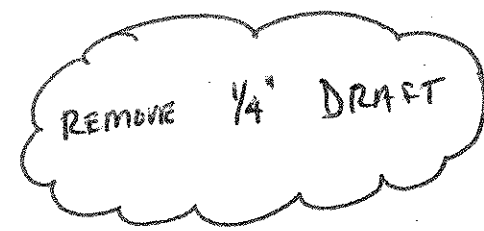
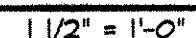
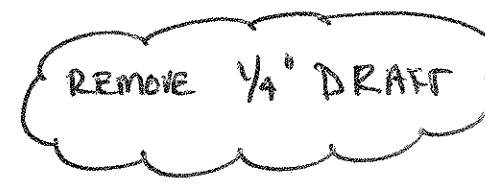


2/12/2


$$I'' = I' - Q$$


APR 26 2001

SUBMIT _____ APPROVED As
CPW DATE 5/29/01

SHOP NOTE:
 f'ci = 3,000 PSI (MIN.) @ STRIPPING
 f'c = 5,000 PSI (MIN.) @ 28 DAYS

MARK: R-C7	QTY.: 6	WT./TONS: 0.52	CU. YDS.: 0.26
-------------------	----------------	-----------------------	-----------------------

NOTES:

1. ALL SURFACES OF THE PRECAST CAPS (EXCLUDING FORM FACE) SHALL BE GIVEN A RUBBED FINISH PER VAOT STD. SPECIFICATIONS SUB-SECTION 501.6(a)2.
2. ALL EDGES OF PRECAST CAPS SHALL BE FABRICATED TO BE VERTICAL IN THE FINAL ERECTED POSITION.

DRAWN: B.M. LOPEZ
DESIGNED: E.J. BROD
CHECKED: _____
APPROVED: _____

Precast & Prestress Manufacturer
2464 CASE STR., MIDDLEBURY, VERMONT 05753
Phone: (802) 388-6381
Fax: (802) 388-0010

Double-Tees Hollow-Core Plank Flat Panels

Project Name:	ROYALTON BRIDGE BRZ 1444 (22) ROYALTON, VERMONT
	DECK TOWER CAP DETAILS

SCALE:	JOB #:
NOTED	23111-00
DATE:	SHEET #:
2-20-01	PCT