

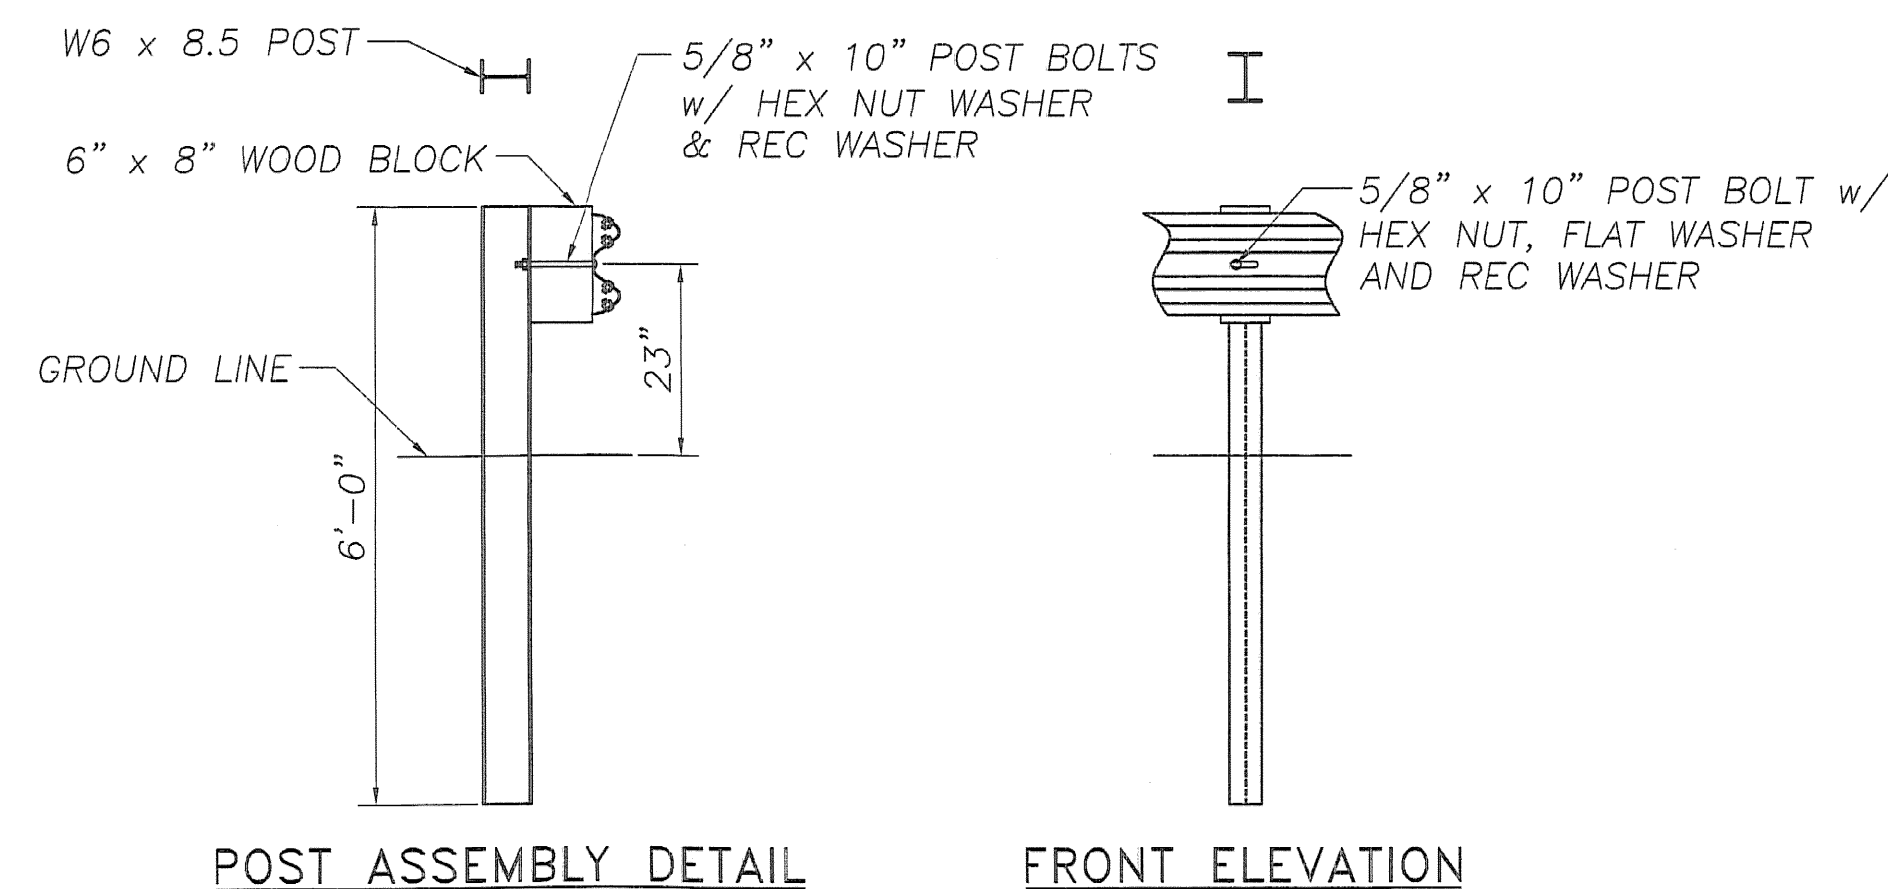
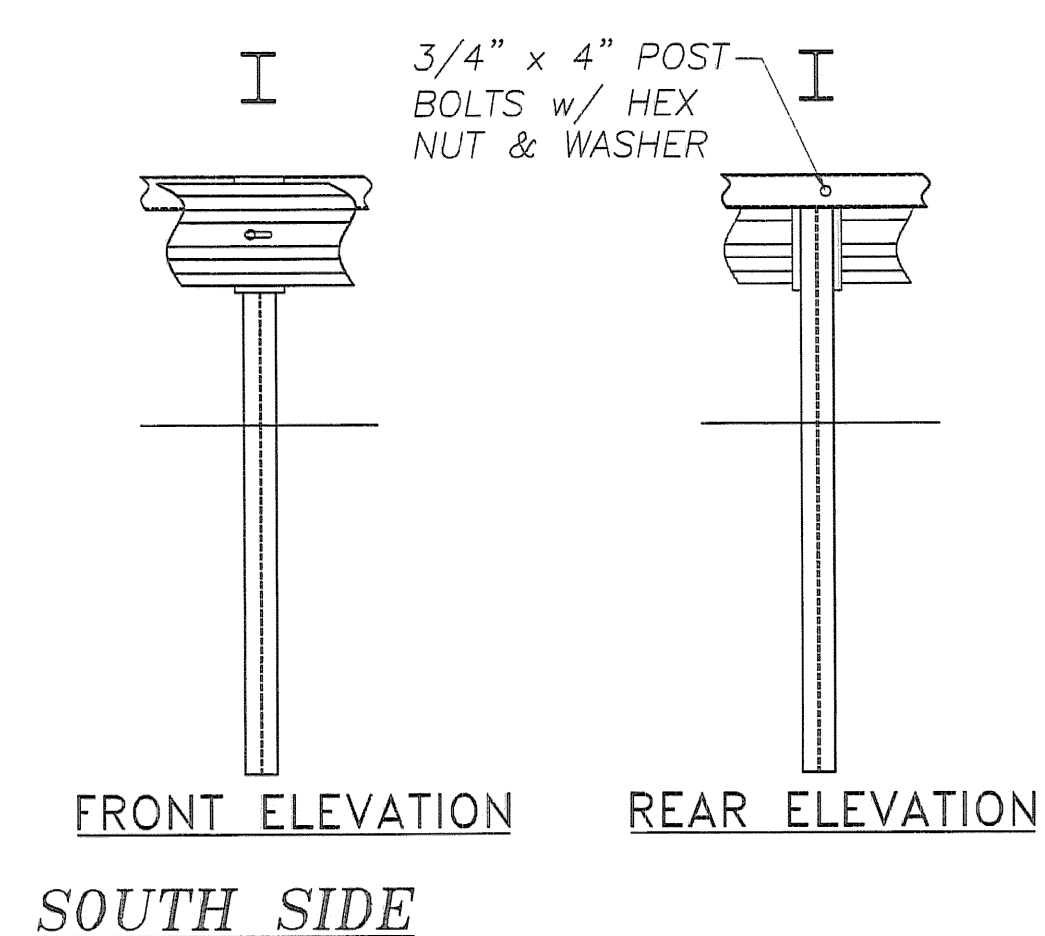
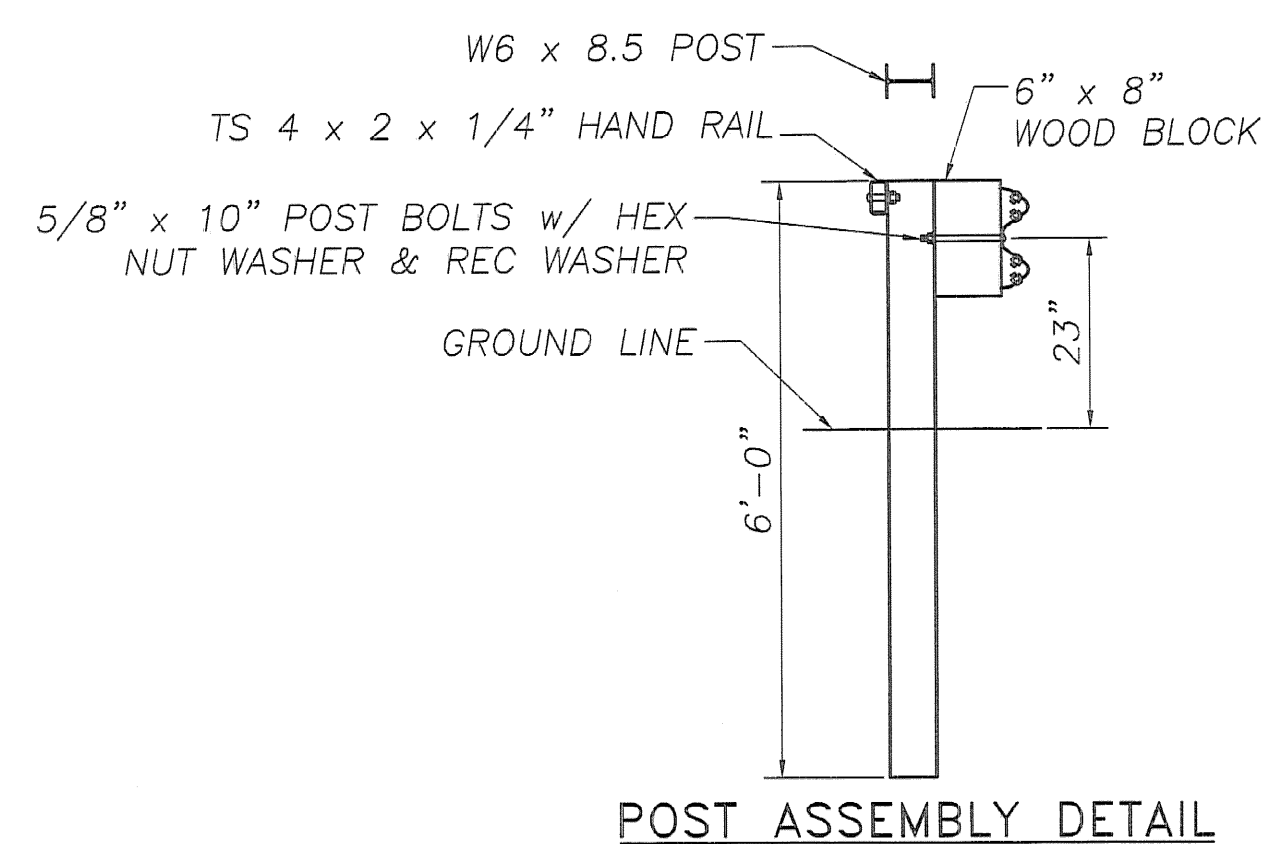
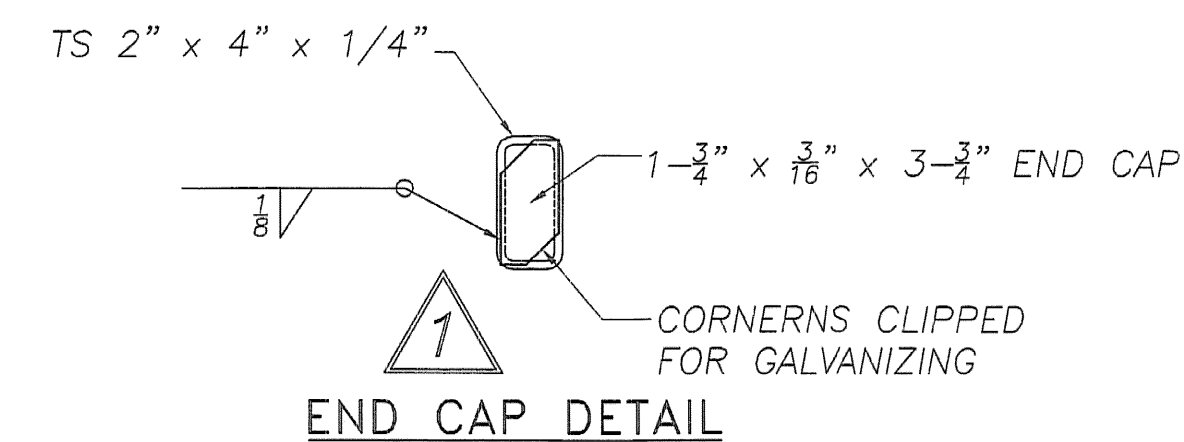
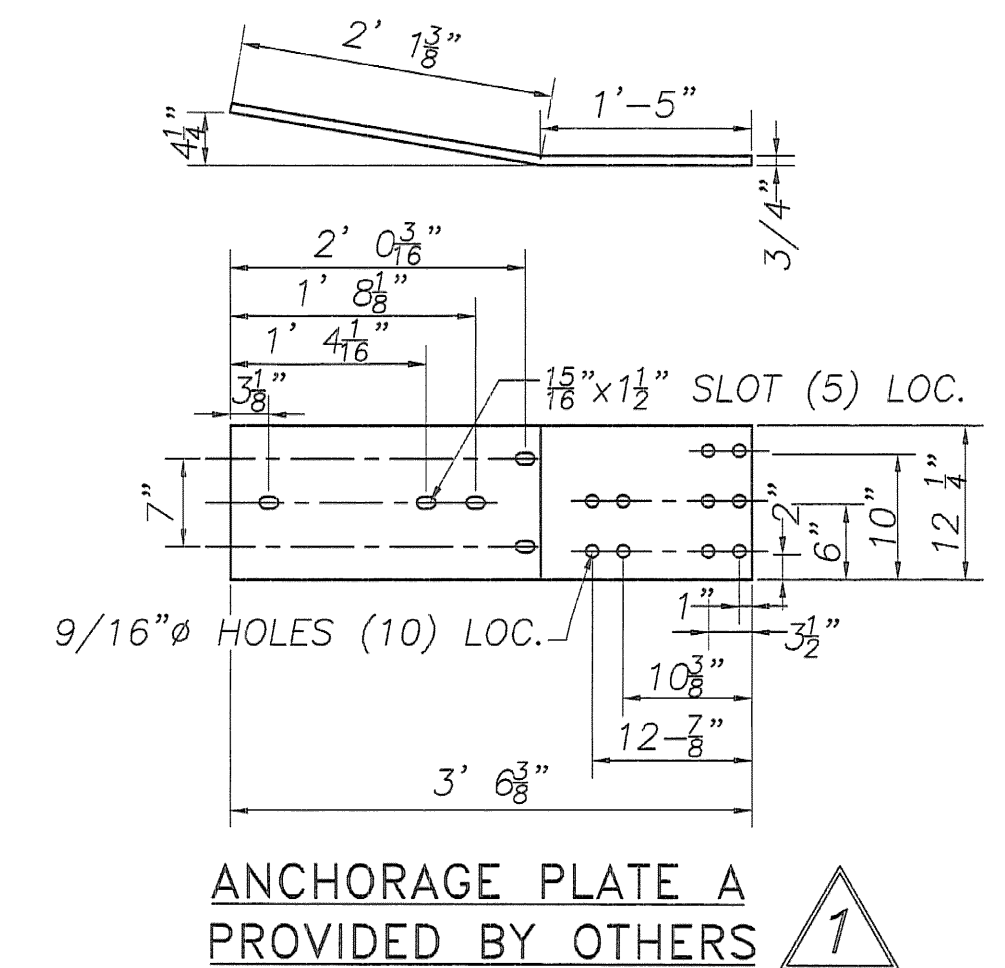
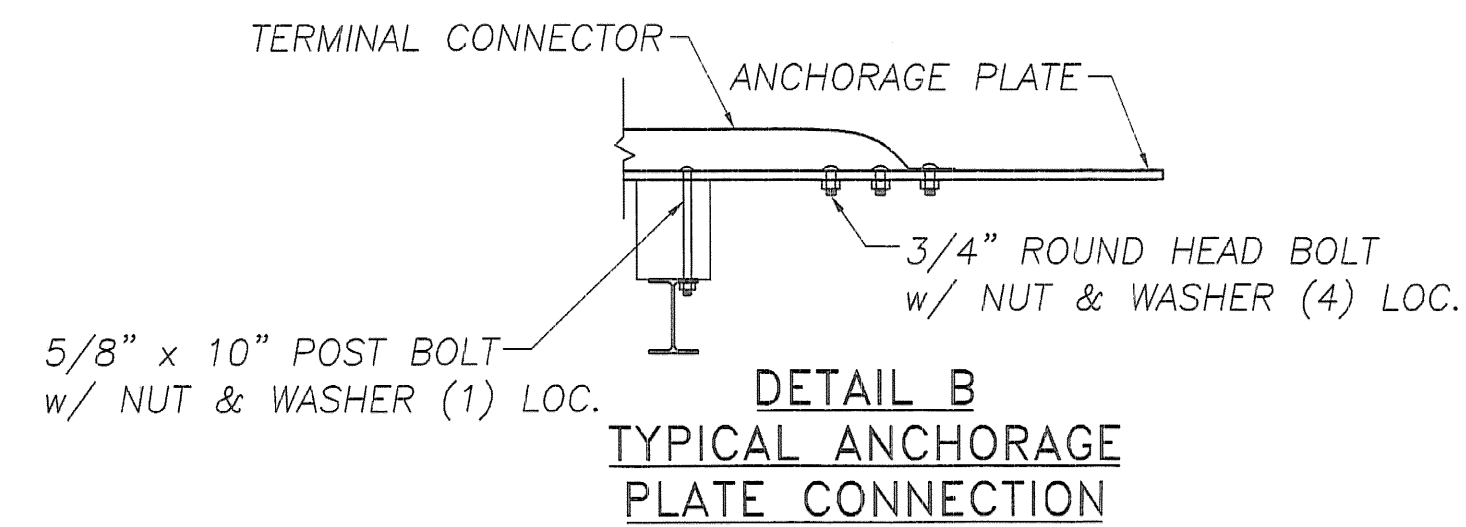
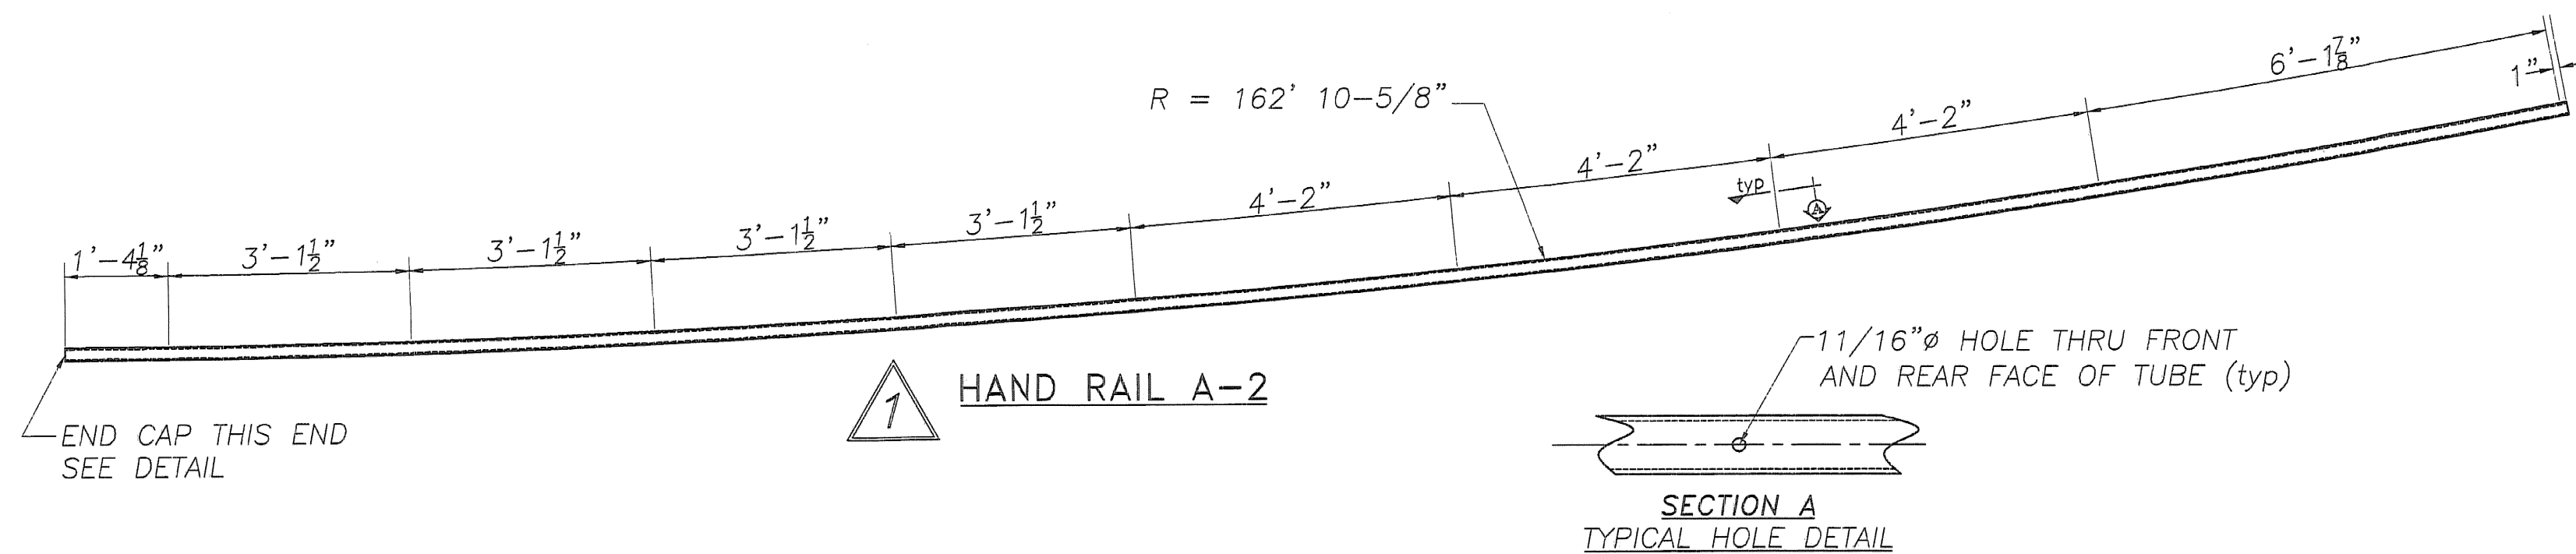
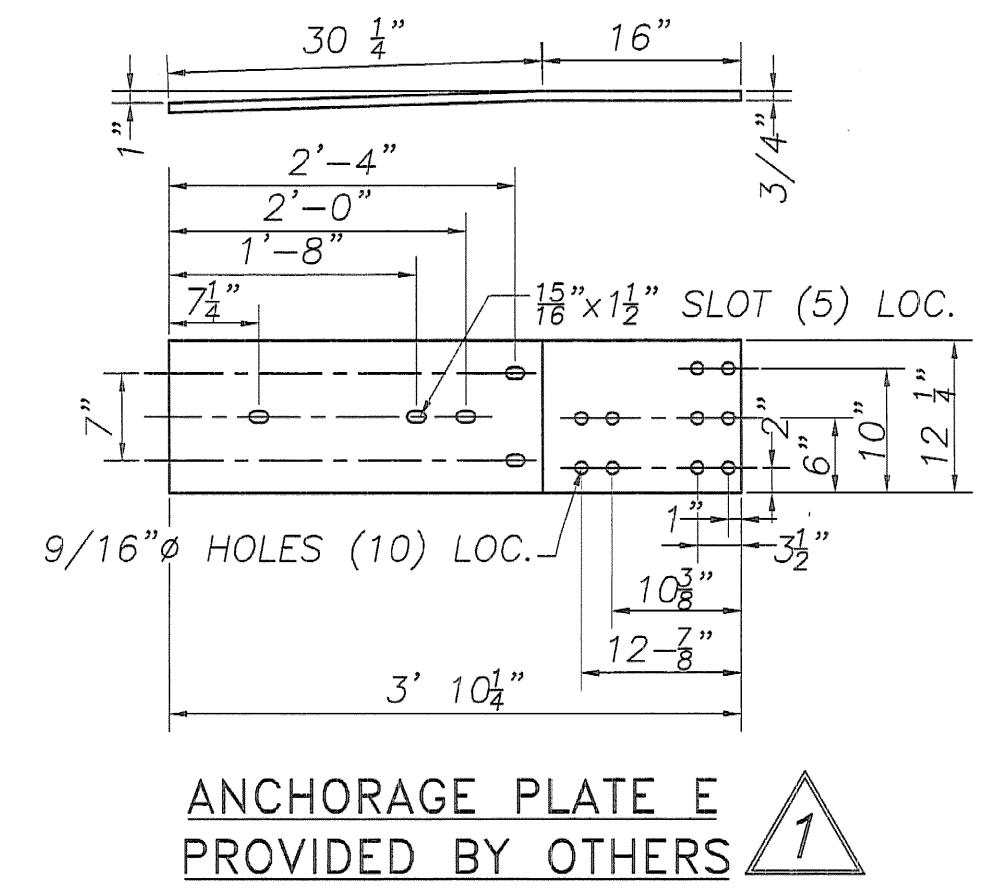
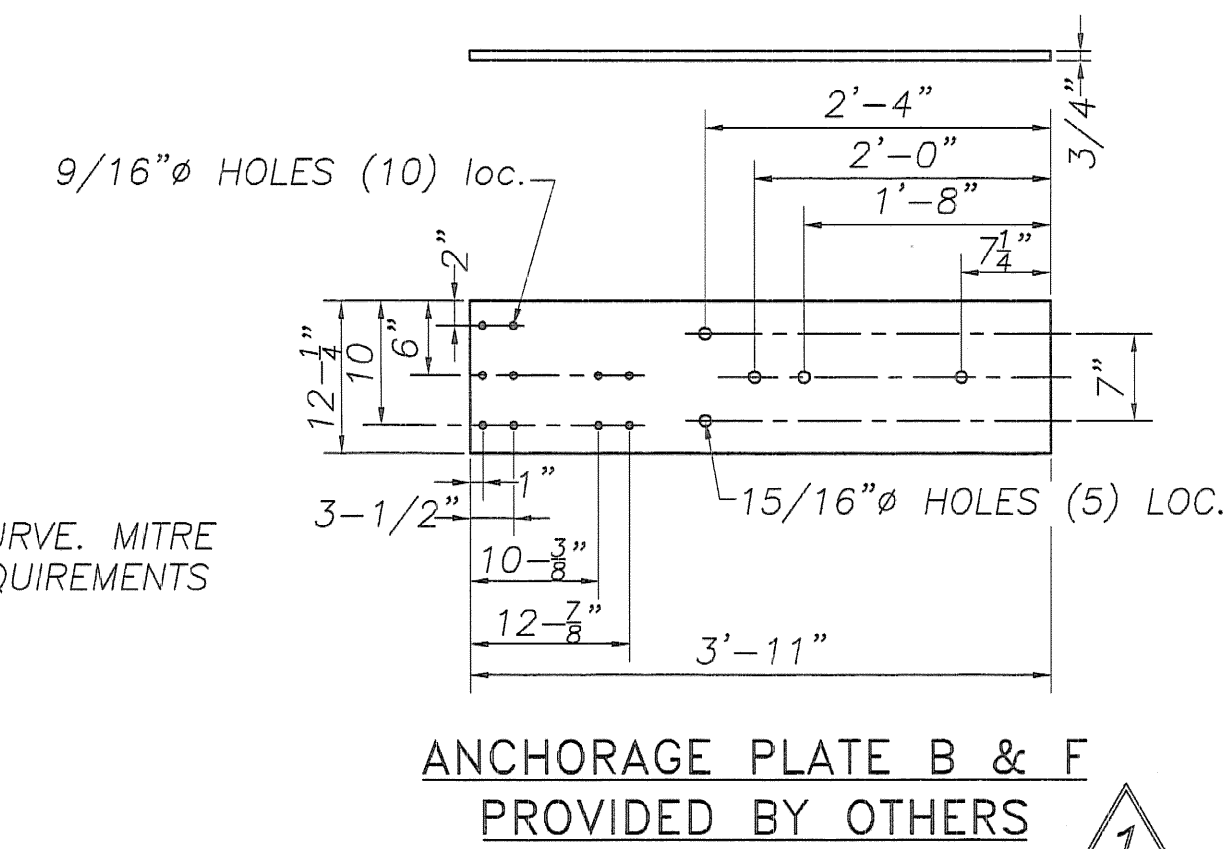
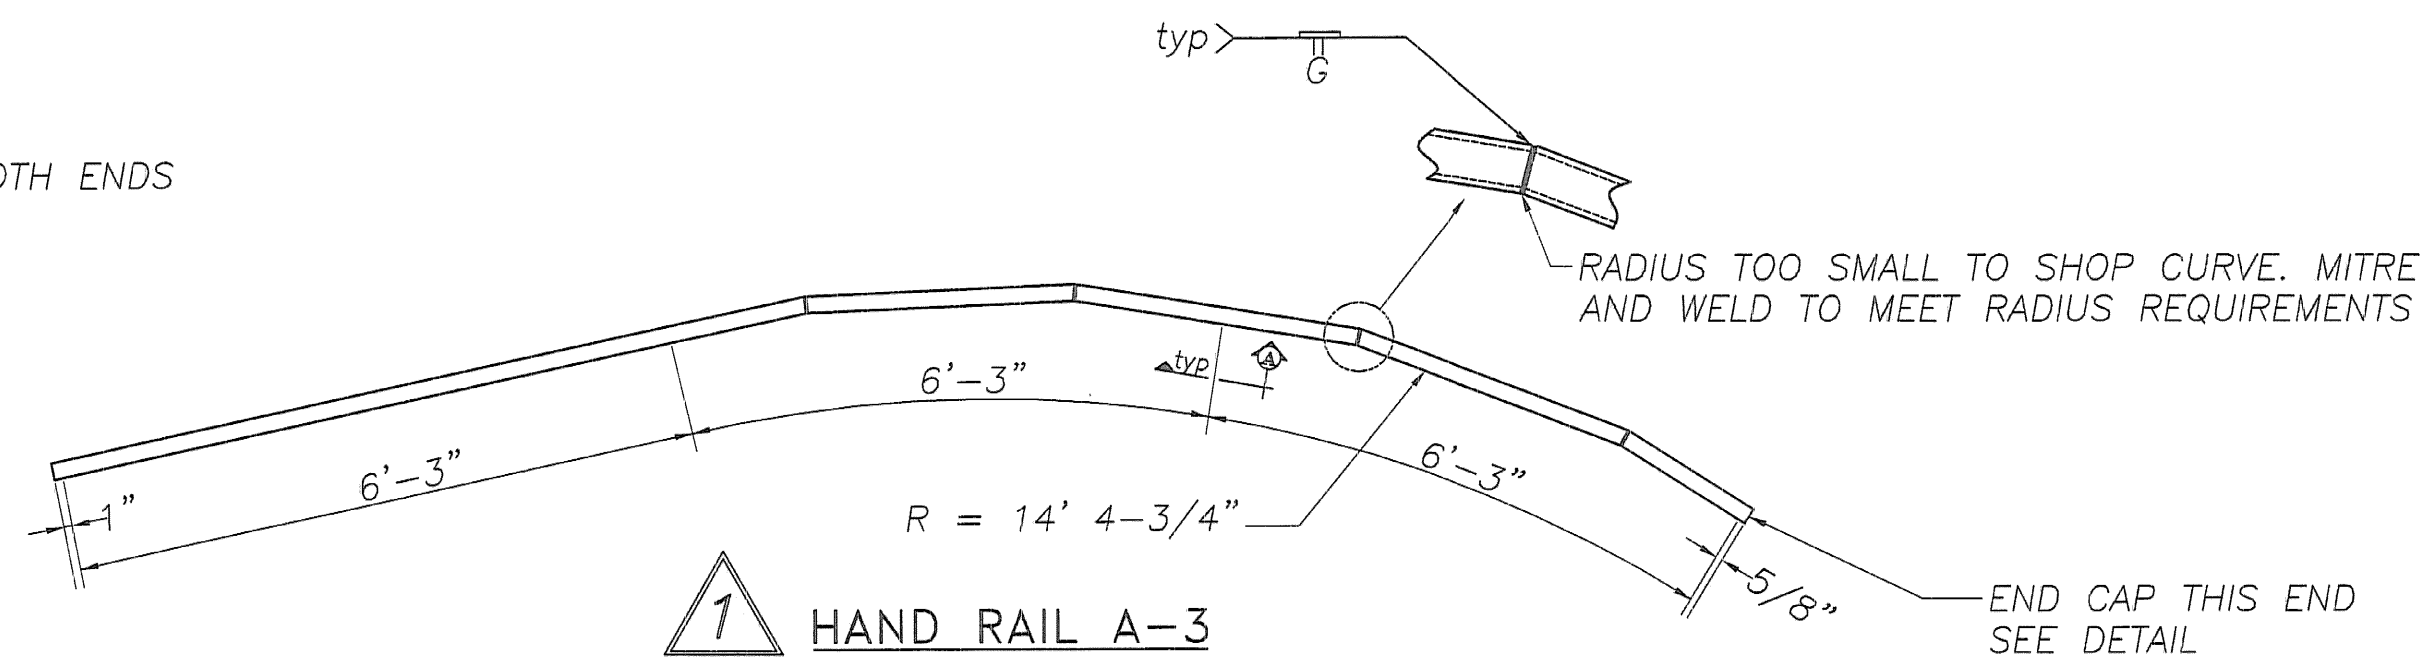


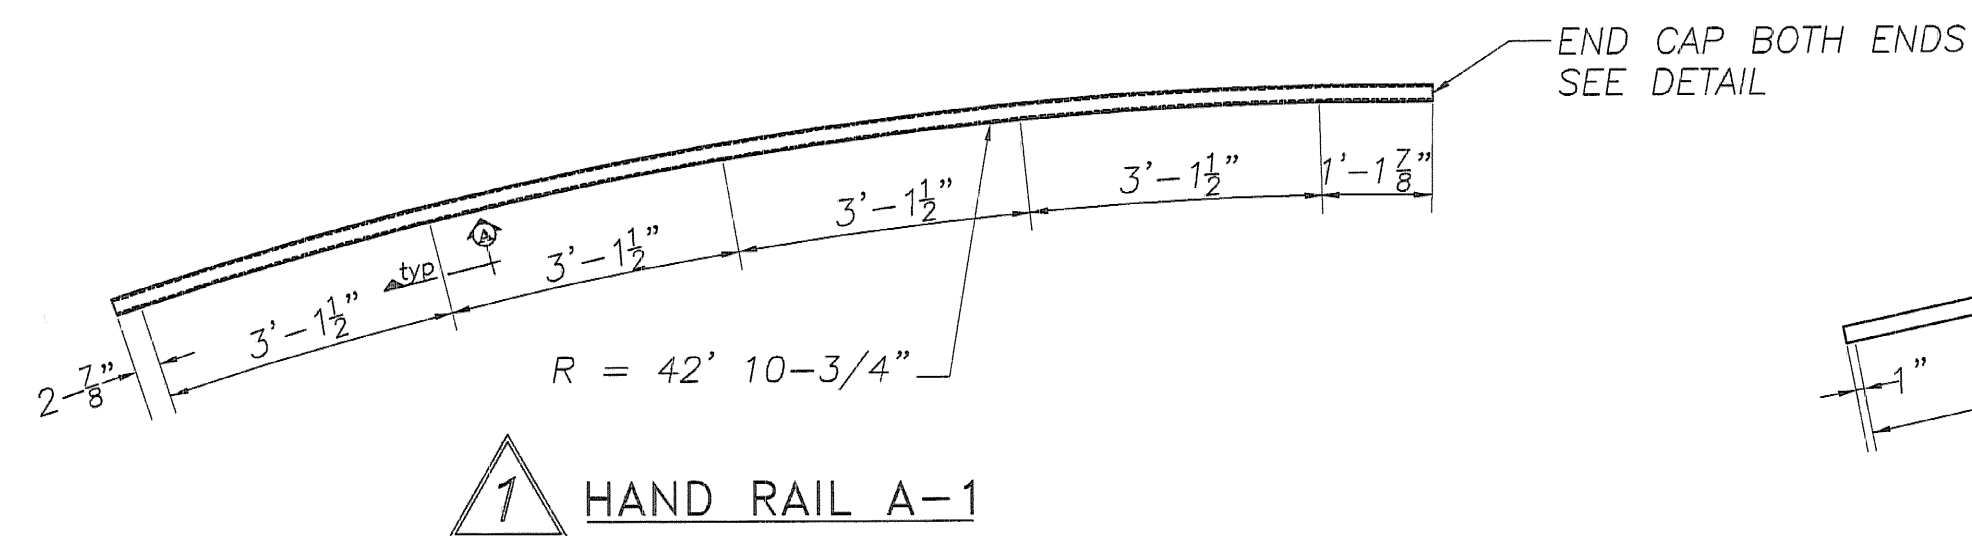

NORTH SIDE

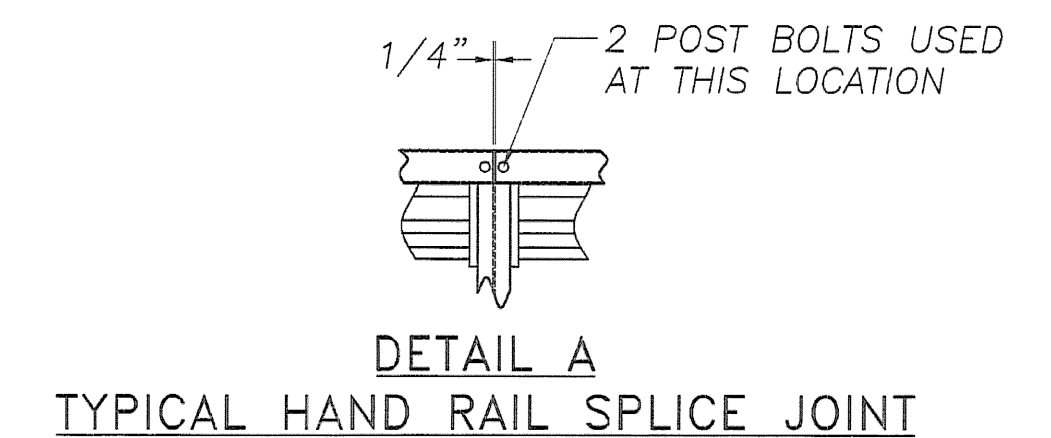

VTrans - PDD

JUL 0 5 2006

Structures Design
Section

RECORD PLANS

REVISIONS		
No.	Remarks	Date
0	submitted for customer approval	4/13/06
1	final copy with a.a.n. corrections	6/16/06

HIGHWAY SAFETY CORP. GLASTONBURY, CT		DRAWN C CRAMER CHECKED DATE 03/20/06 SCALE NTS HSC REFERENCE NO. 1536	
		HEAVY DUTY STEEL BEAM GUARDRAIL MOD 1 w/o HAND RAIL & MOD 2 w/ HAND RAIL TOWN OF JOHNSON COUNTY OF LAMOILLE ROUTE: TH2, BRIDGE NO. 6	
GENERAL CONTRACTOR SUB CONTRACTOR FR LAFAYETTE		SIZE D REVISION 1	SHEET NO. 1 of 1

