


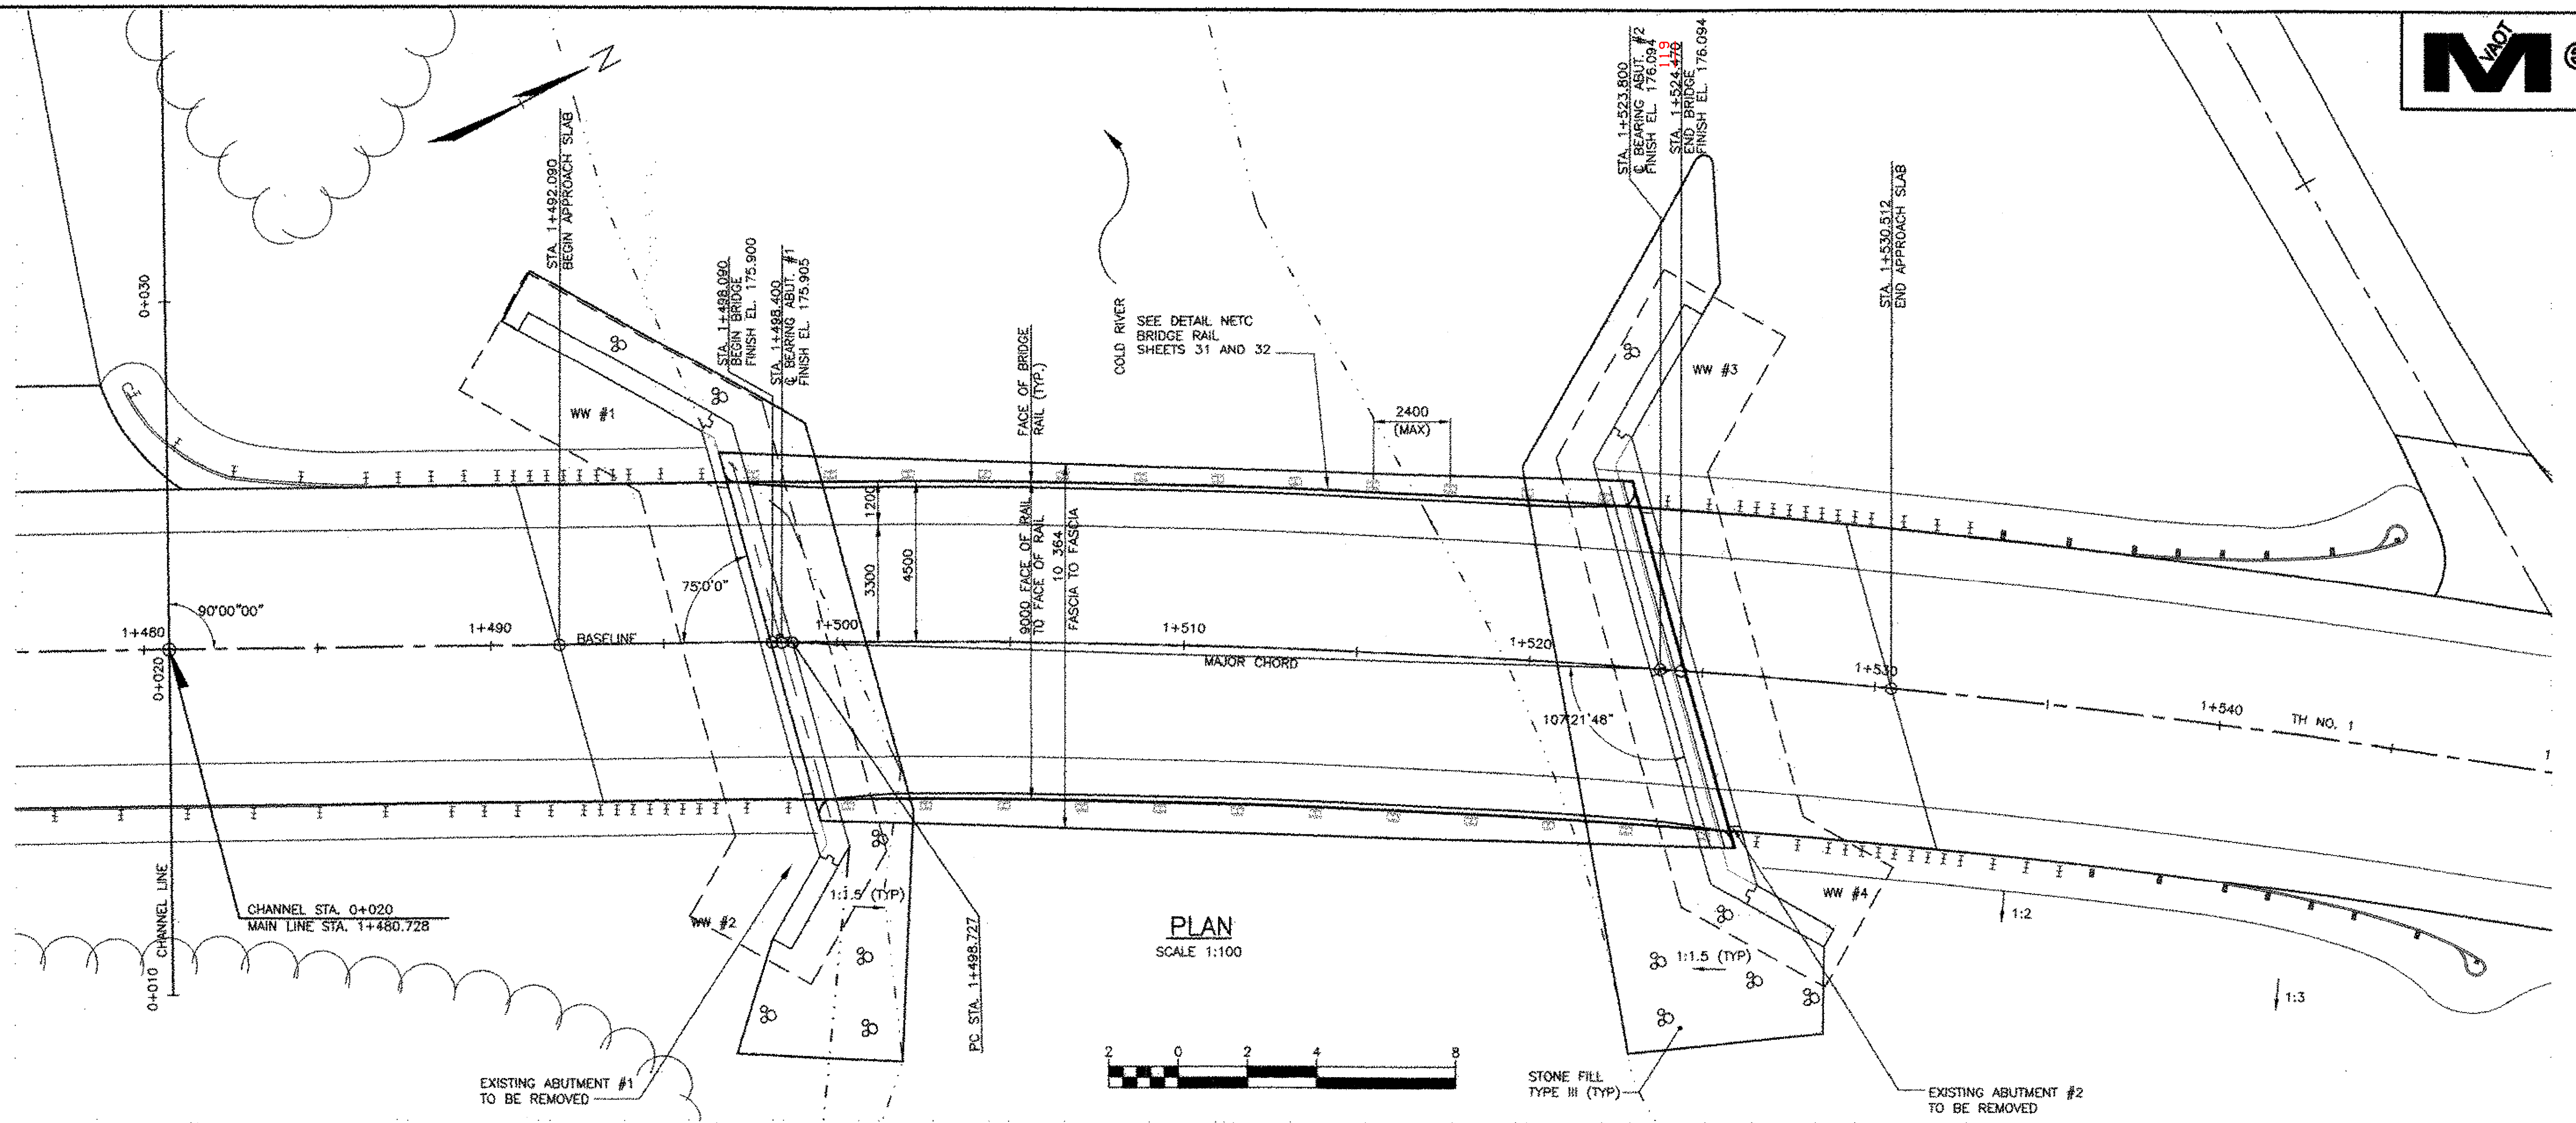


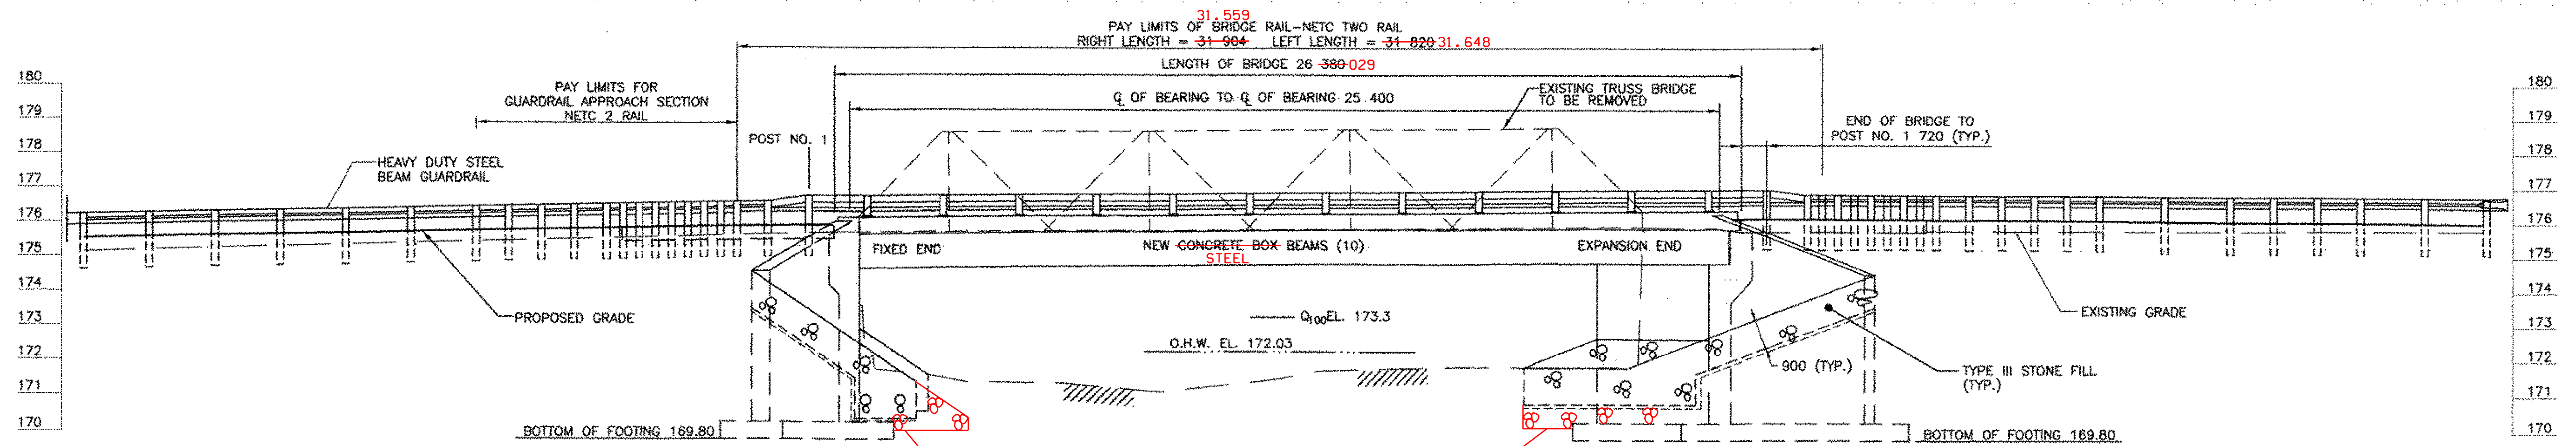

PLAN
SCALE 1:100

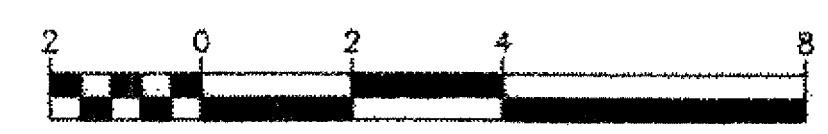

ELEVATION
SCALE HORIZ. 1:100
VERT. 1:100

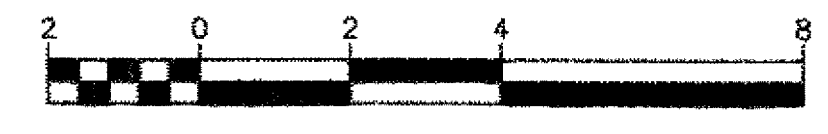

REVISIONS			STATE OF VERMONT AGENCY OF TRANSPORTATION	
NO.	DESCRIPTION	BY & DATE		
			CLARENDON, VERMONT	Bridge No. 14
			TOWN HIGHWAY NO. 1	Log Sta.
				Surv. Sta.
			TOWN HIGHWAY NO. 1 OVER THE COLD RIVER	
			PLAN AND ELEVATION SHEET	
			Designed by: W.S. CHESBROUGH	Drawn by: N.B. DIMICK
			Checked by: K. S. MARSHIA date 05/02	Bridge Design Supervisor J.W. TUCKER date 05/02
			PROJECT CLARENDON	PROJECT NO. BRO 1443(29)
			Bridge Sheet No.	SHEET 15 of 41